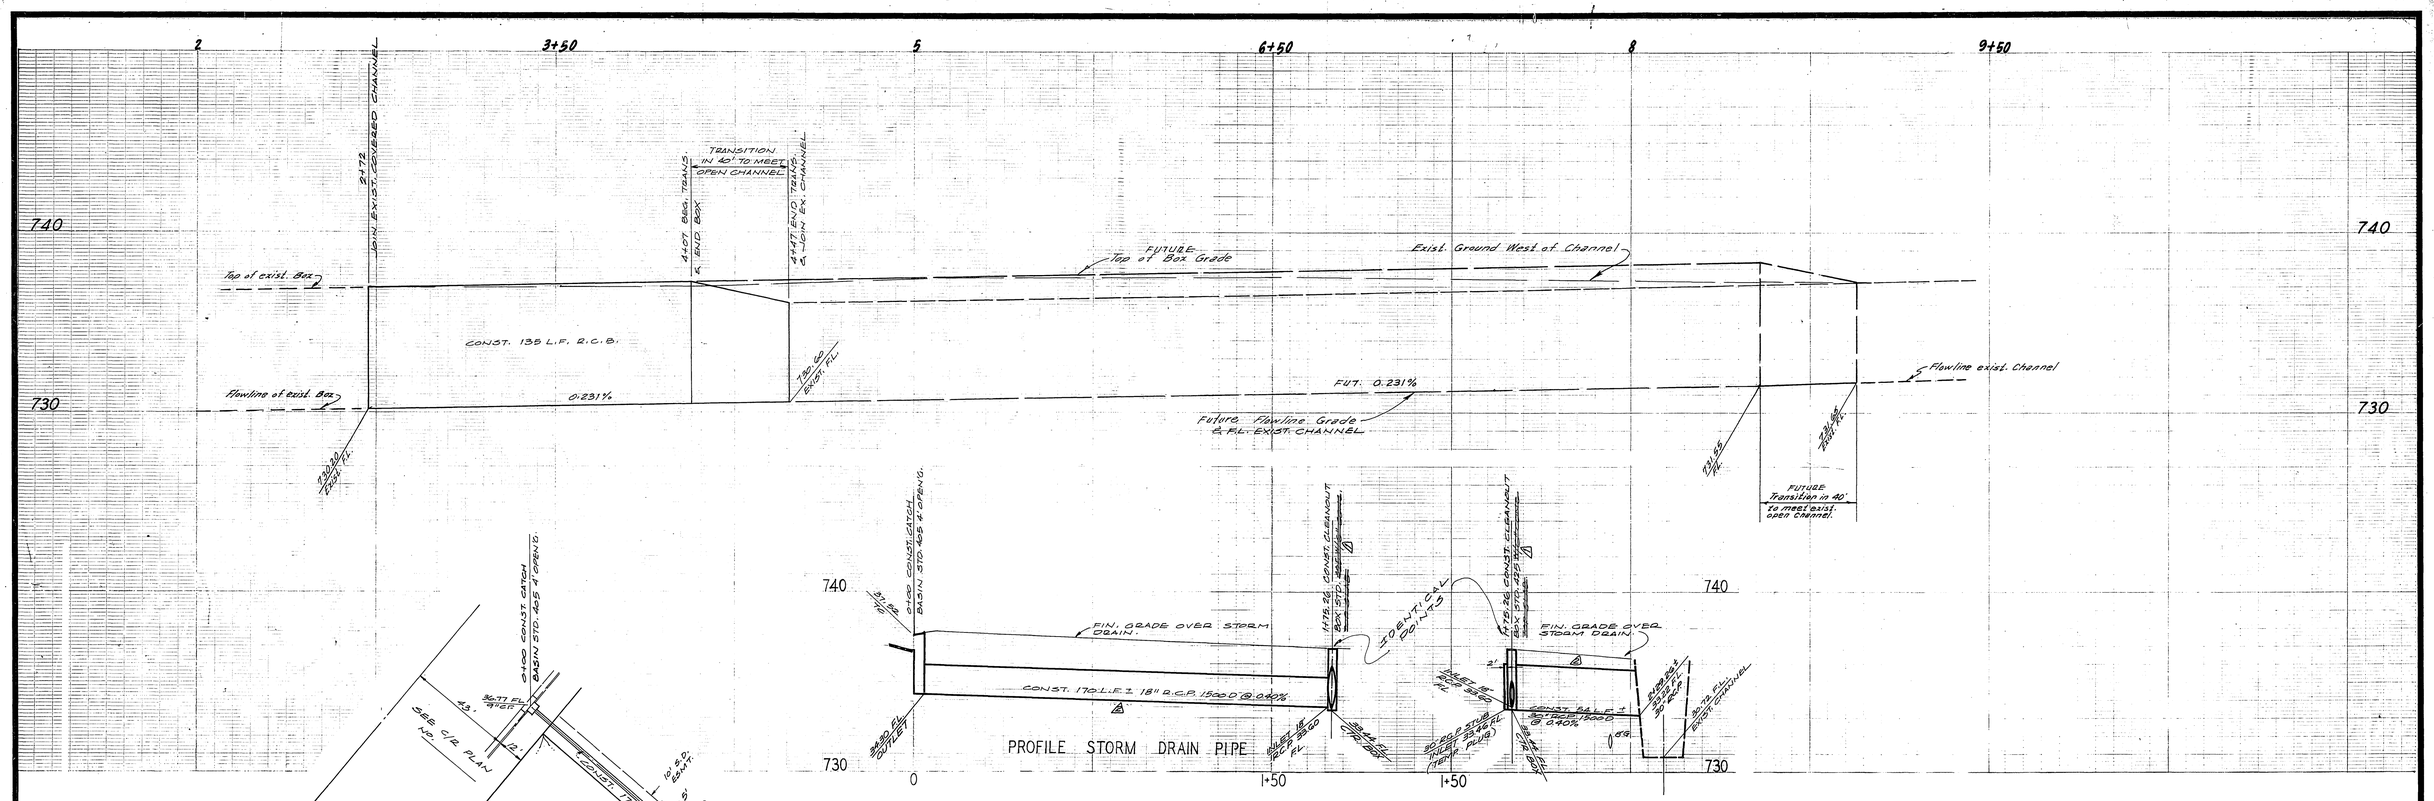

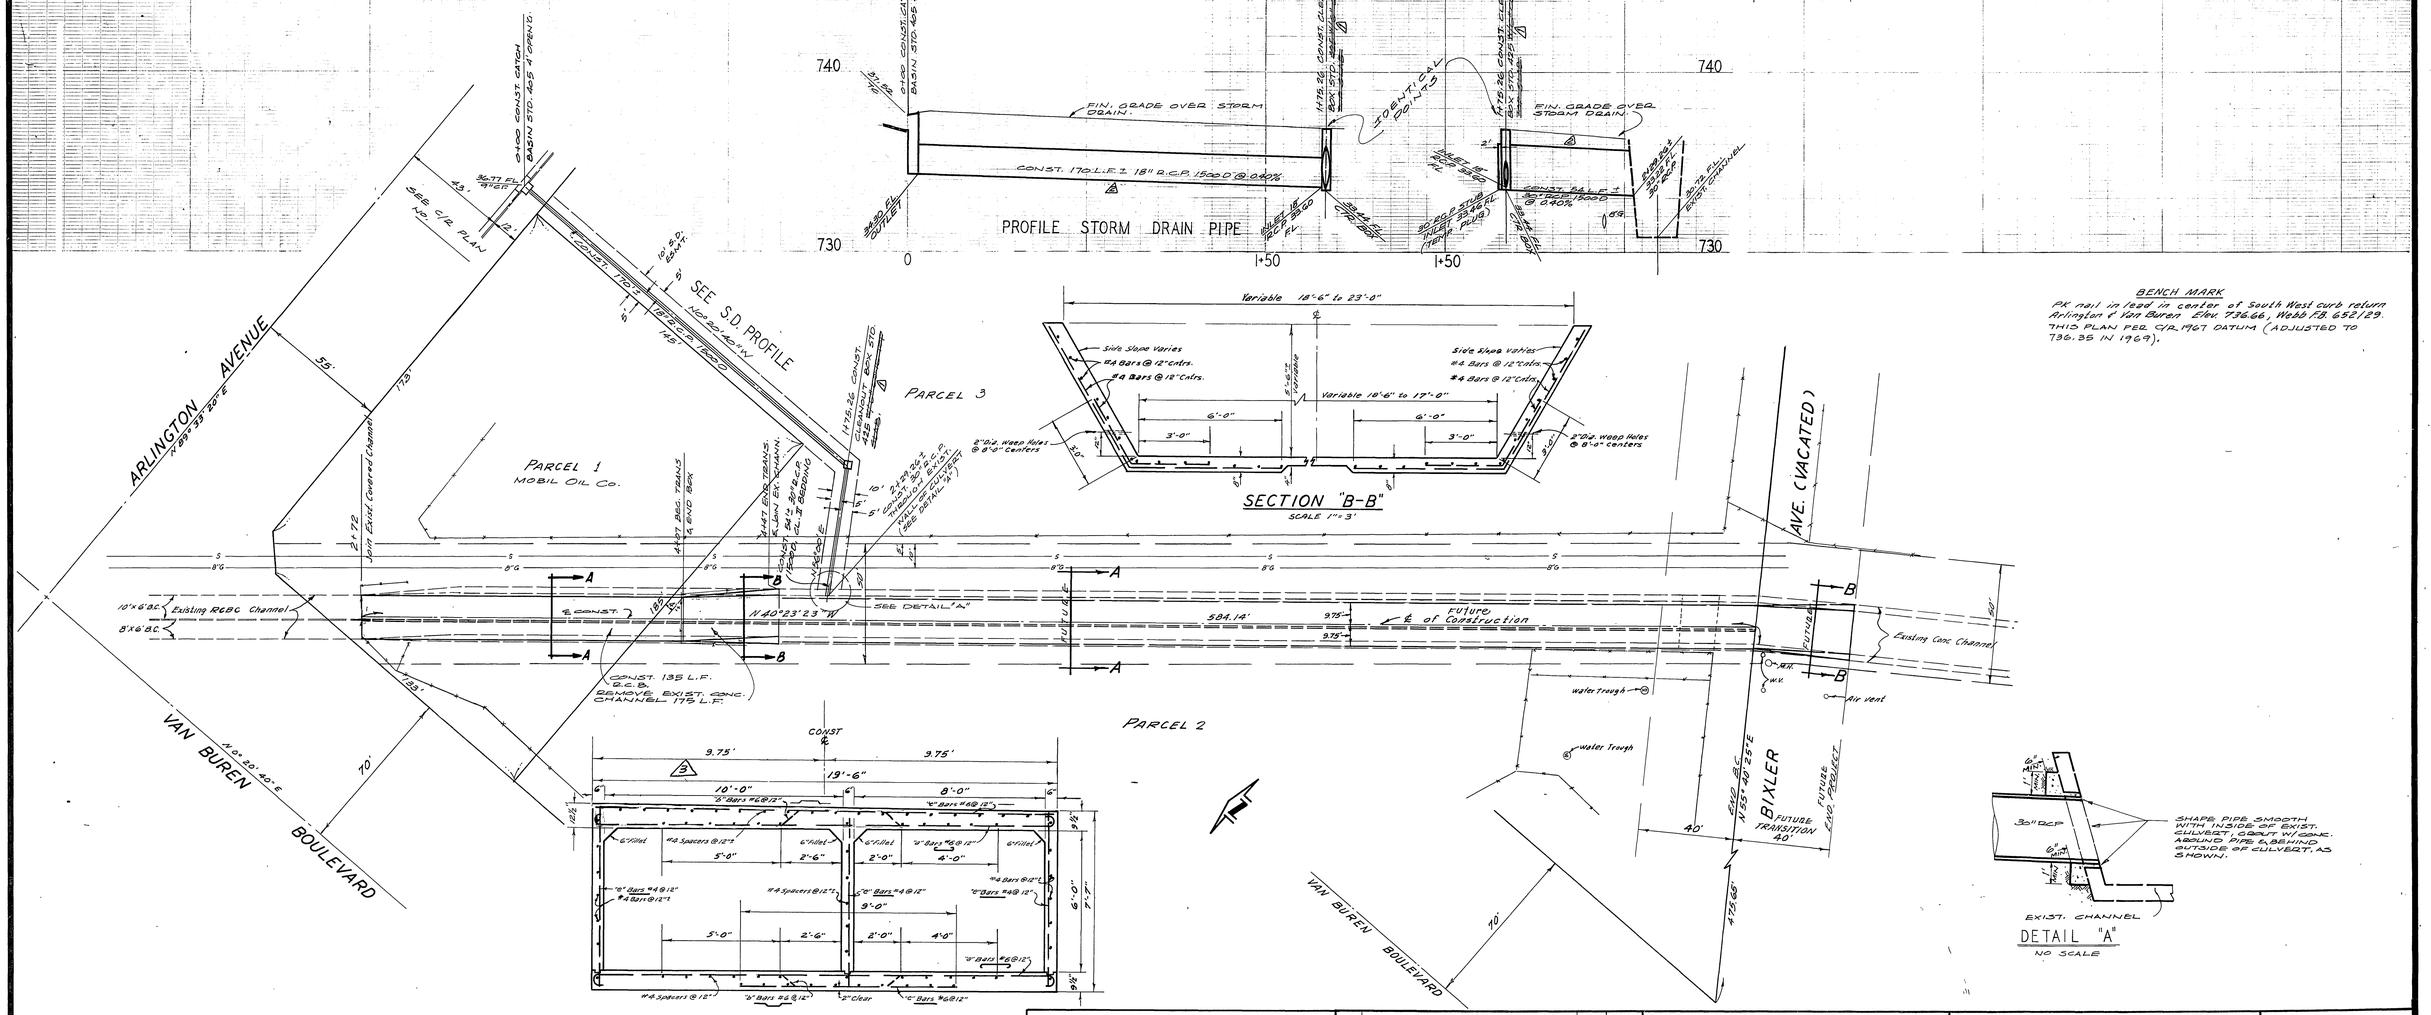

BENCH MARK

PK nail in lead in center of South West curb return Arlington & Van Buren. Elev. 736.66, Webb F.B. 652/29. THIS PLAN PER C/R 1967 DATUM (ADJUSTED TO 736.35 IN 1969).

ALBERT A. WEBB ASSOCIATES
CIVIL ENGINEERS
RIVERSIDE, CALIFORNIA

APPROVED BY D. Wenrott DATE 8-14-68
R E NO. 16056
W.O. 71-111 FOR MOBIL OIL CO. F.B. 652

MARK	REVISIONS	APPR.	DATE
	(column not being const.; so rebar not req.)		12-18-72
A	Removed rebar in Section A-A (Column rebar)		
	~~Wall~~ TOW to raise 8" GRS sump to		
A	Revised sewers on 16 & 30 RCP		11-28-72
A	Revised cleanout at sta 14+75.26		

DESIGNED BY A.W. DRAWN BY BEL CHECKED BY

CITY OF RIVERSIDE, CALIFORNIA
DEPARTMENT OF PUBLIC WORKS

APPROVED BY	BY	DATE
OFFICE ENGINEER		
PARK DEPARTMENT		
TRAFFIC DIVISION		
ASSISTANT CITY ENG.		

APPROVED BY
DIRECTOR OF PUBLIC WORKS
DATE

STORM DRAIN PLAN & PROFILE
SOUTHEAST CORNER
ARLINGTON AVE. & VAN BUREN BLVD.
FOR P.M. 42

HORIZ. SCALE: 1" = 30' VERT. SCALE: 1" = 4'

PROJECT NO. D-227
SHEET 1 OF 1
FILE NO. 71-111-D