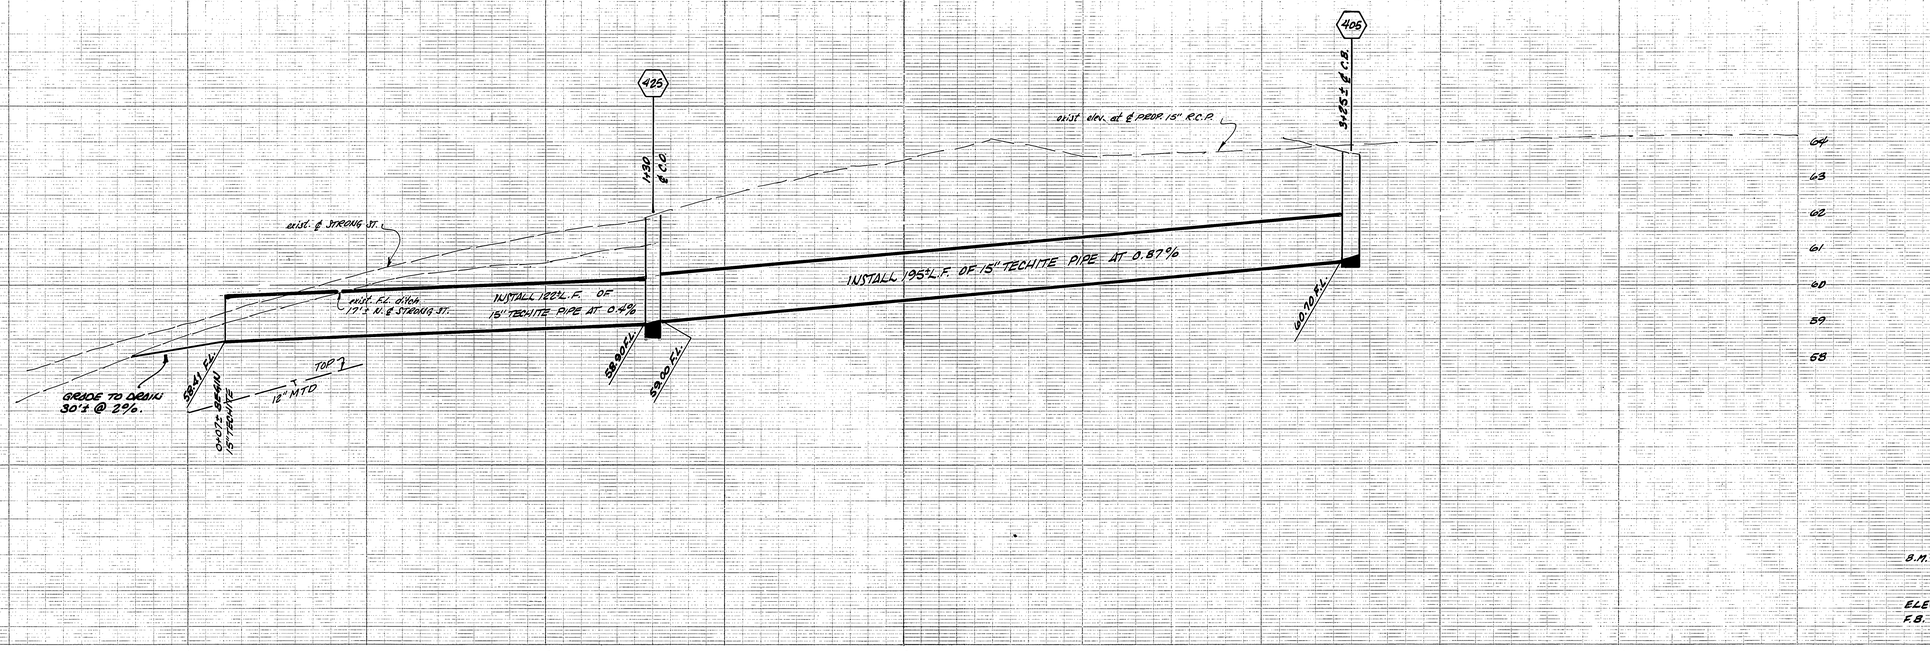

B.M. - SPIKE & LEAD IN N.W. C.E. AT HILLCREST & STRONG ST. PER F.B. 659/28.
ELEV. - 863.05
F.B. - 954/50
949/61

GENERAL CONSTRUCTION NOTES

1. REMOVE EXIST. DRAINAGE OUTLET. EXTEND SIDEWALK TO RIGHT OF WAY LINE.
2. (405) CONSTRUCT CATCH BASIN PER STD. DWG. NO. 405 WITH 4' OPENING.
3. (425) CONSTRUCT CLEANOUT BOX PER STD. DWG. NO. 425. TOP SLAB SHALL BE 6" THICK AND FRAME & COVER SHALL BE PER STD. DWG. NO. 540.

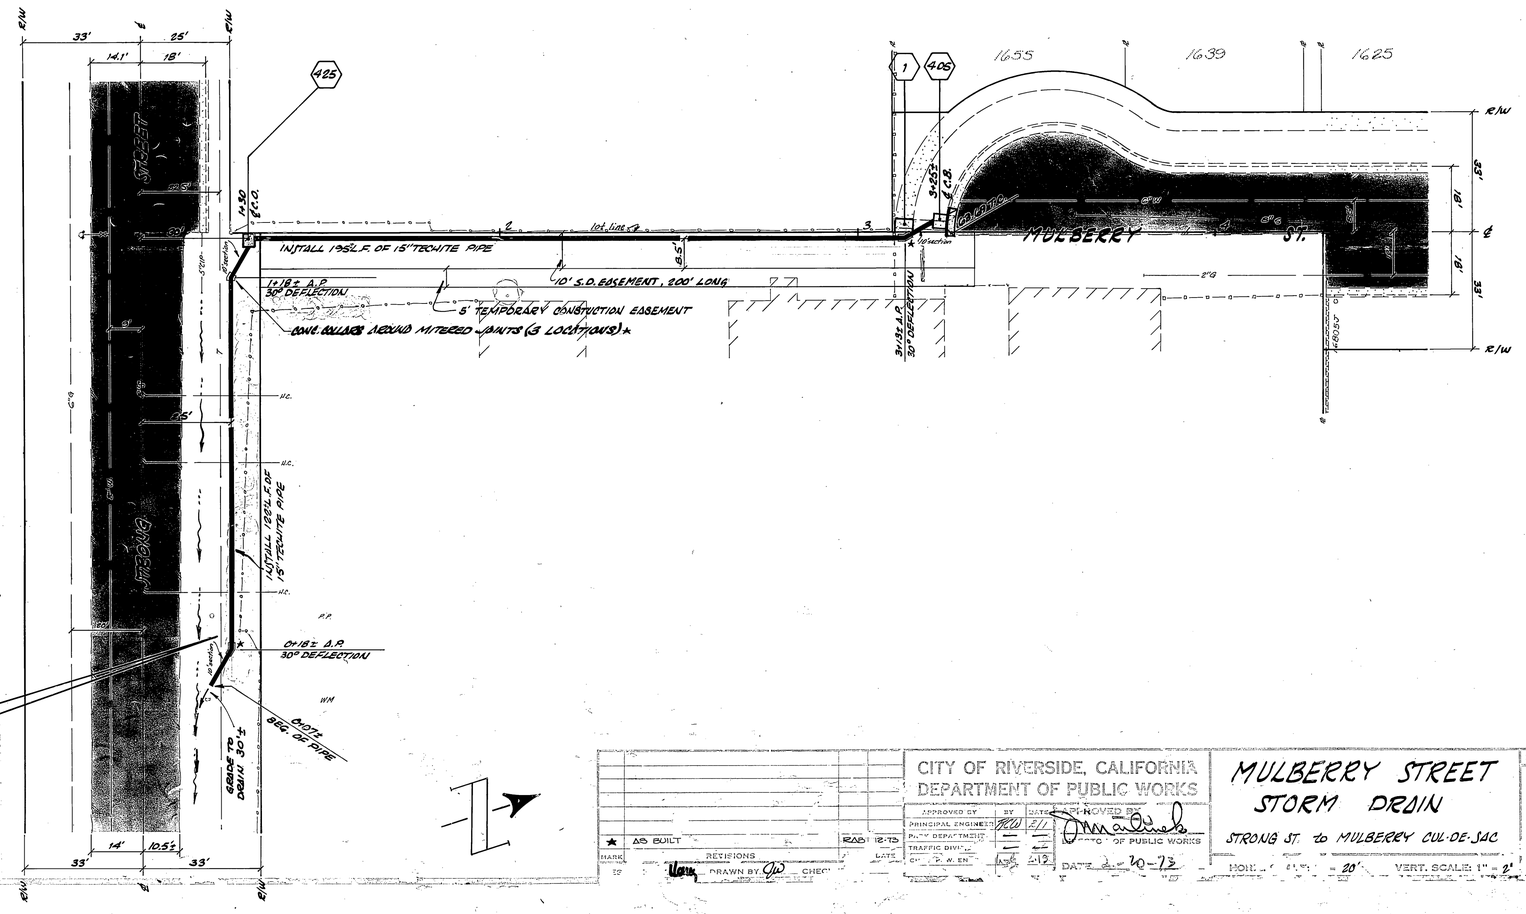

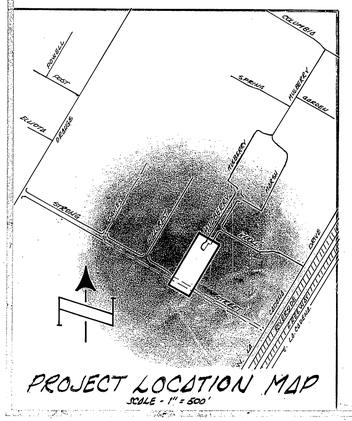

PROJECT LOCATION MAP
SCALE - 1" = 500'

-CAUTION-
PACIFIC TELEPHONE
CABLES UNDERGROUND
BEFORE EXCAVATING
CALL COLLECT:

	7:30 A.M. to 5 P.M.	After Hours & Holidays
Orange County	714-633-0811	714-547-6606
Riverside County	714-684-0071	714-547-6606

MARK	REVISIONS	BY	DATE
★	AS BUILT	RAD	12-73

DRAWN BY: GW CHECKED:

CITY OF RIVERSIDE, CALIFORNIA
DEPARTMENT OF PUBLIC WORKS

	BY	DATE
APPROVED BY		
PRINCIPAL ENGINEER	[illegible]	2/1
PUBLIC WORKS DEPARTMENT		
TRAFFIC DIVISION		
CITY ENGINEER	[illegible]	2-12

APPROVED BY: [signature] DIRECTOR OF PUBLIC WORKS
DATE: 2-20-73

MULBERRY STREET STORM DRAIN

STRONG ST. to MULBERRY CUL-DE-SAC

PROJECT NO. 478

D-234

SHEET 1 OF 1

HORIZ. SCALE: 1" = 20' VERT. SCALE: 1" = 2' FILE NO.