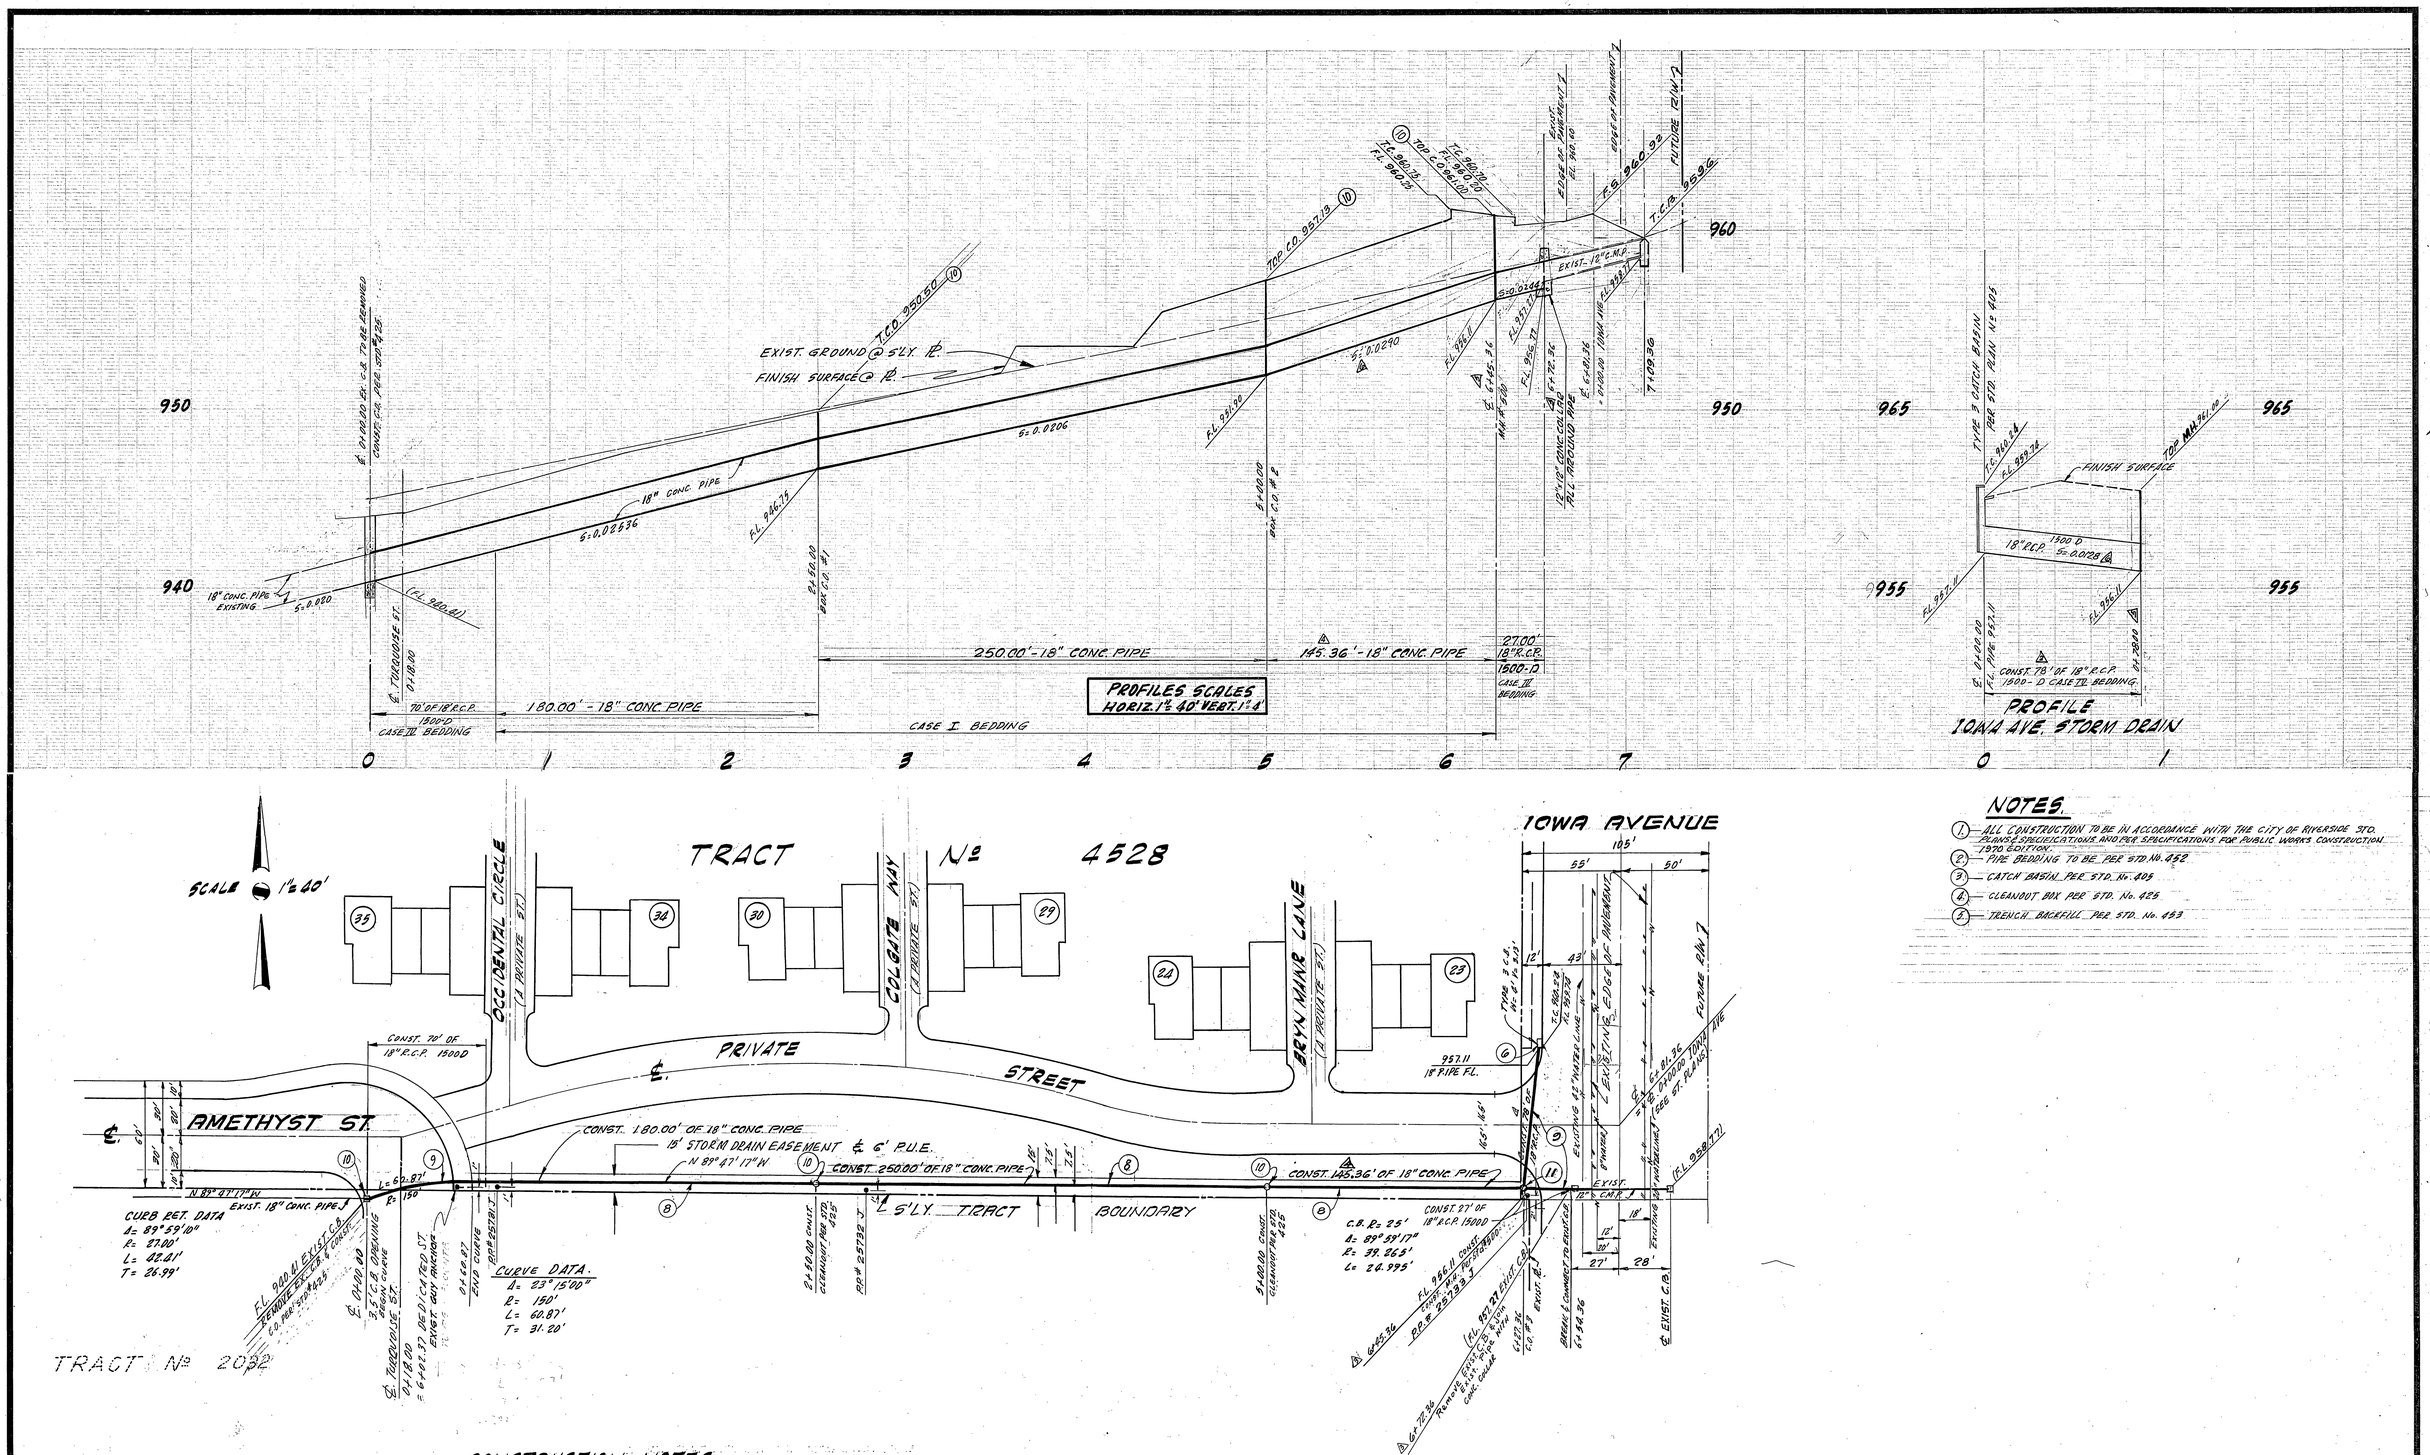

TARIQ M. SHAMMA ASSOCIATES, INC.
2229 E. LINCOLN AVE
ANAHEIM, CALIFORNIA. 92806
Approved _____ R.C.E. 12808 Date 7/11/72
J.N. 72-02

Field correction changes

MARK	REVISIONS	APPR.	DATE
1	Transposition of Length of 18" RCP		11/14/72
2	Transposition		
3	Added Stationing		11-28-72
4	Correction in Conc. Pipe Length		
5	Corrected Stationing		
6	Pipe distance changes Slop		

DESIGNED BY ____ DRAWN BY ____ CHECKED BY ____

CITY OF RIVERSIDE, CALIFORNIA
DEPARTMENT OF PUBLIC WORKS

APPROVED BY	BY	DATE
OFFICE ENGINEER		
PARK DEPARTMENT		
TRAFFIC DIVISION		
ASSISTANT CITY ENG.		10-30

APPROVED BY _____ DIRECTOR OF PUBLIC WORKS
DATE 10-31-72

STORM DRAIN PLAN
TRACT Nº 4528
0+00.00 TO 6+81.26
STORM DRAIN PLAN & PROFILES FROM 0+00.00 TO STA. 0+18.00 TORQUOISE ST. TO 6+81.26 IOWA

INDEXED R.R.
PROJECT NO. 72-02
D-238
SHEET 1 OF 1
HORIZ. SCALE: 1" = VERT. SCALE: 1" =
FILE NO.