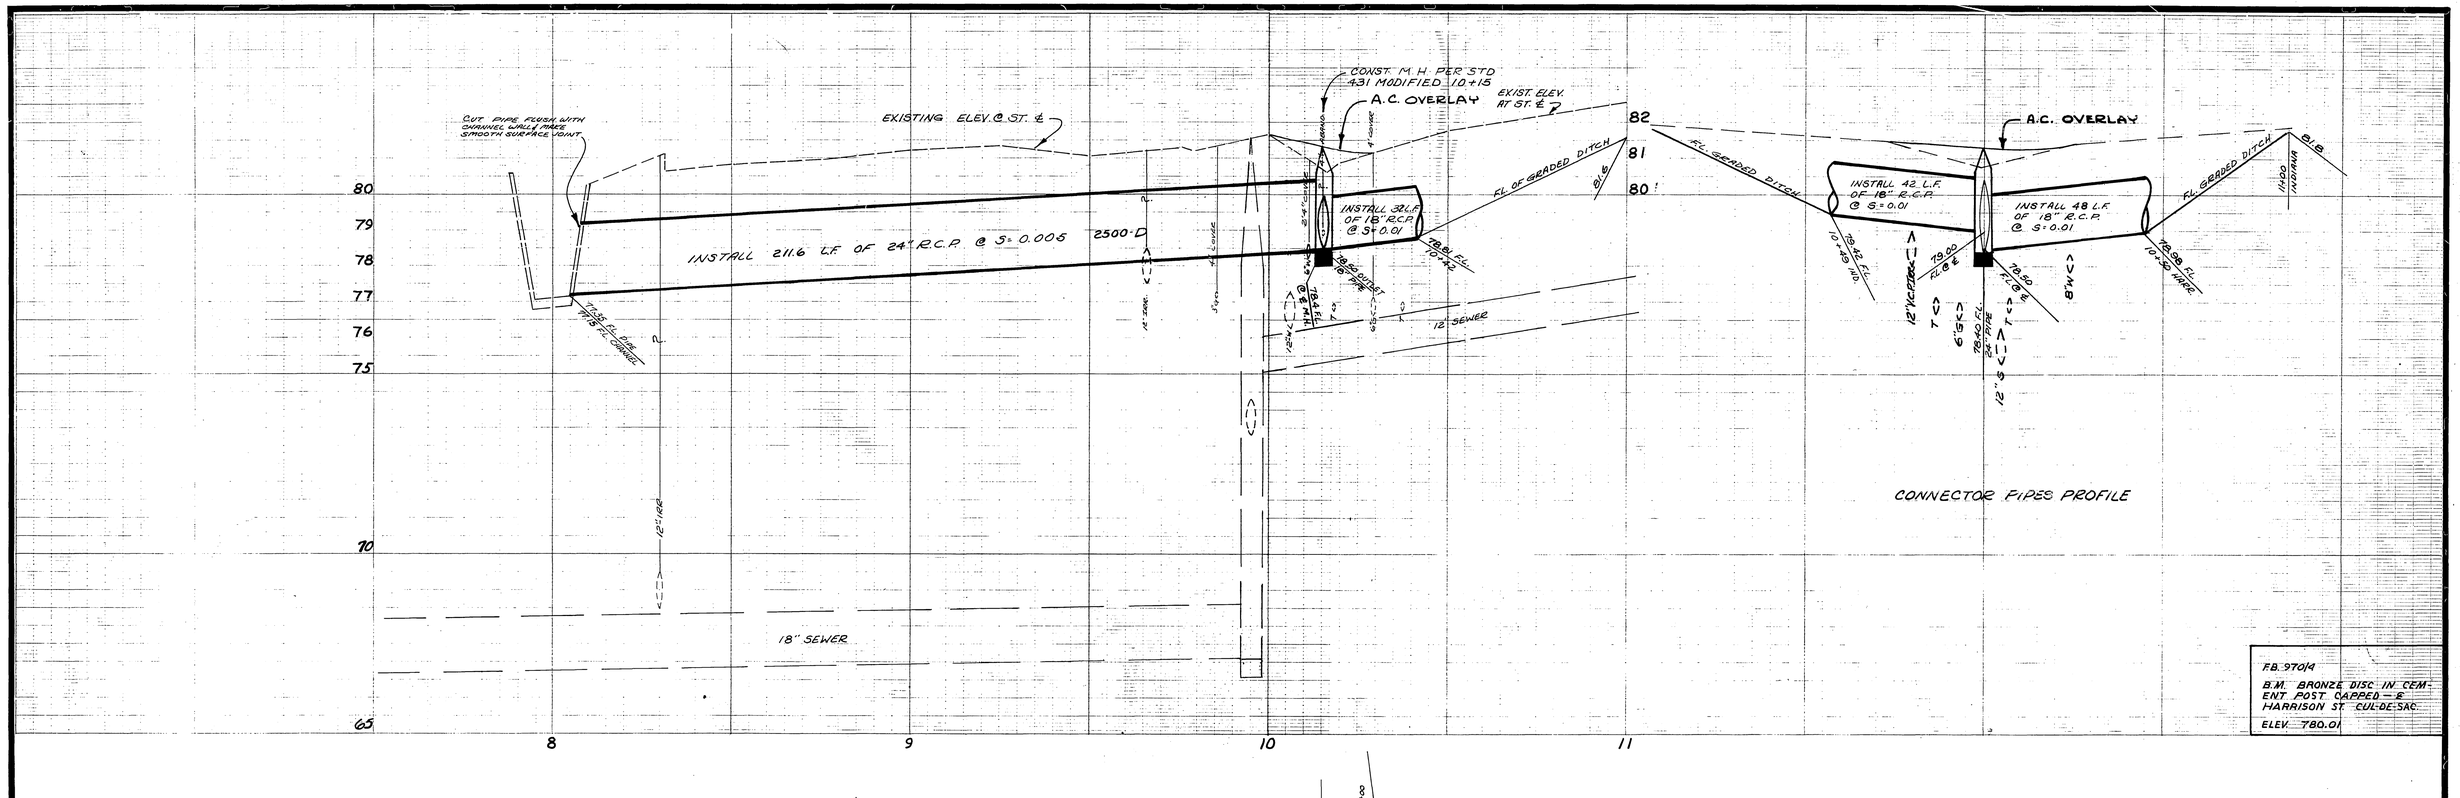

GENERAL CONSTRUCTION NOTES

1. EXACT DEPTH OF UNDERGROUND UTILITIES MARKED: ARE UNKNOWN. THE LOCATIONS AND DEPTHS SHOWN ON THE PLAN ARE FROM UTILITY RECORDS. THE CONTRACTOR IS REQUIRED TO TAKE DUE PRECAUTIONARY MEASURES TO LOCATE AND PROTECT ALL UNDERGROUND FACILITIES.
2. CONTRACTOR SHALL RESTORE AT HIS OWN EXPENSE ANY CURB AND GUTTER, GUARD RAILS, FENCES, OR OTHER IMPROVEMENTS REMOVED OR DAMAGED BY CONSTRUCTION.
3. TRENCH BACKFILL AND RESURFACING SHALL BE PER STD. 453. 6" FULL DEPTH A.C. SHALL BE USED.
4. CASE I BEDDING SHALL BE USED PER STD. 452.
5. OVERLAY TO LIMITS & ELEVATIONS SHOWN ON PLAN.

-CAUTION-
PACIFIC TELEPHONE
CABLES UNDERGROUND
BEFORE EXCAVATING
CALL COLLECT:
7:30 A.M. to 5 P.M. — After Hours & Holidays
Orange County 714-633-0811 714-547-6606
Riverside County 714-684-0071 714-547-6606

MARK	REVISIONS	APPR.	DATE
★	AS BUILT	RAB	12-73

DESIGNED BY S.J.B. DRAWN BY BDM CHECKED BY

CITY OF RIVERSIDE, CALIFORNIA
DEPARTMENT OF PUBLIC WORKS

APPROVED BY	BY	DATE
PRINCIPAL ENGINEER		
PARK DEPARTMENT		
TRAFFIC DIVISION		
CHIEF P. W. ENGR.		

APPROVED BY
DIRECTOR OF PUBLIC WORKS
DATE 71

HARRISON STREET
STORM DRAIN
From Indiana Ave. to Freeway
HORIZ. SCALE: 1" = 20' VERT. SCALE: 1" = 2'

PROJECT NO.
D-248
SHEET 1 OF 1
FILE NO.