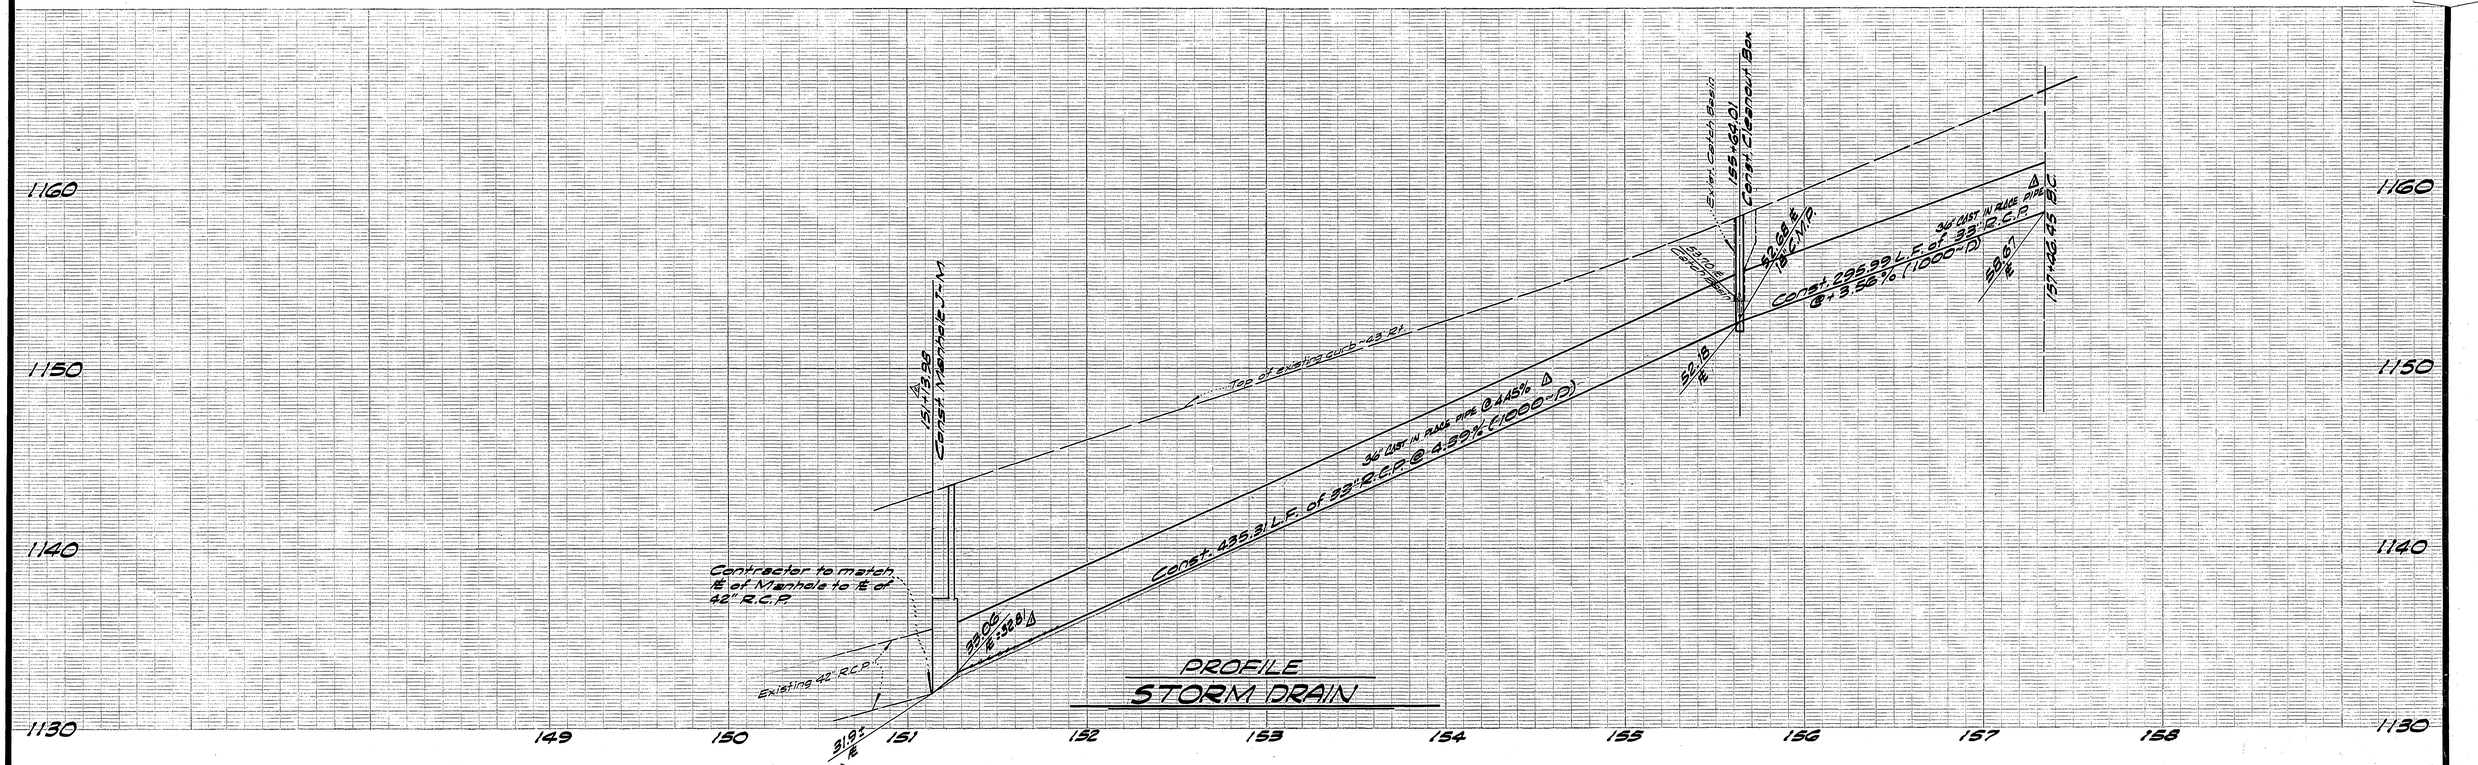

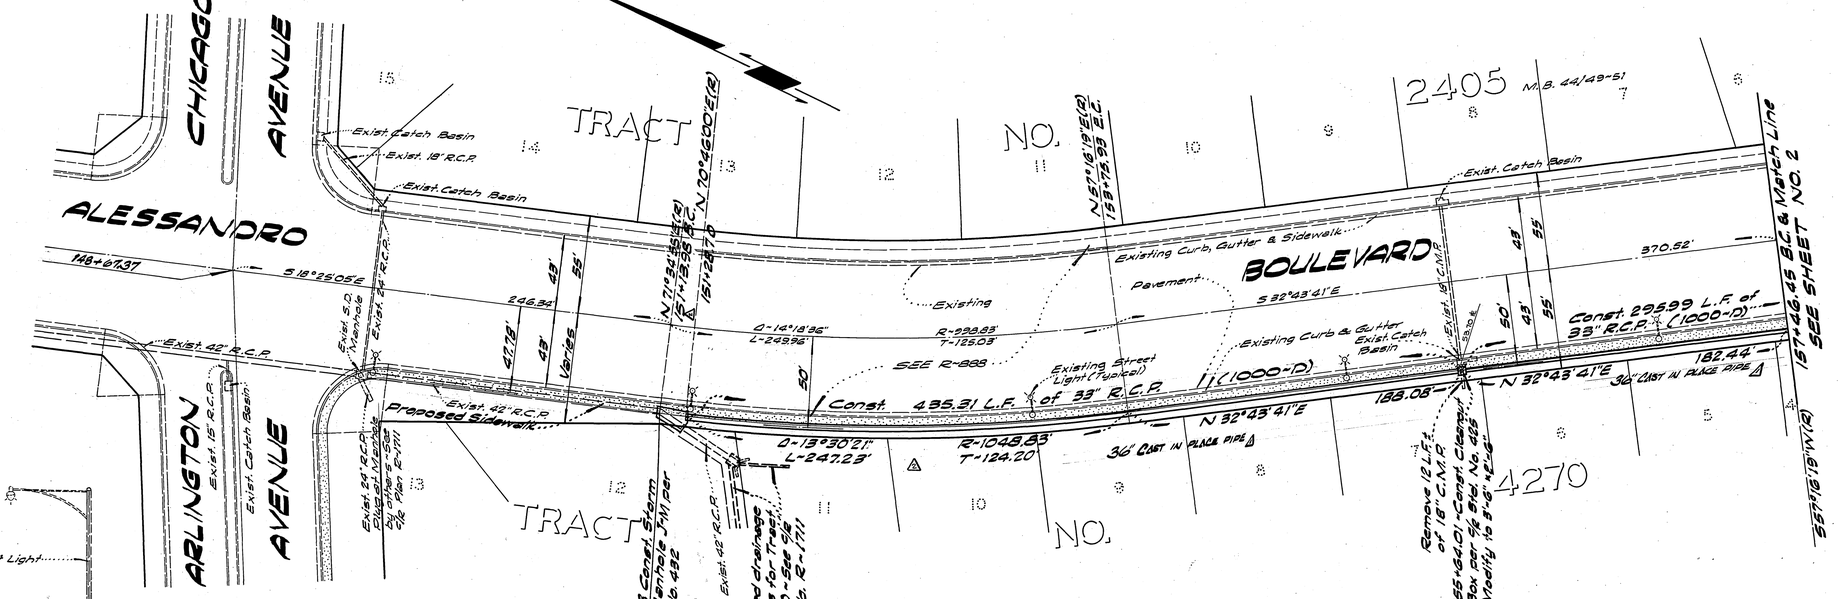

PLAN
STORM DRAIN

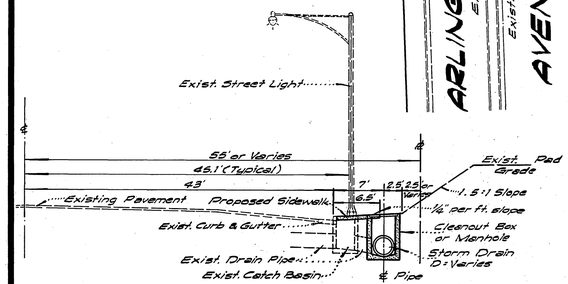

TYPICAL SECTION
ALESSANDRO BOULEVARD
NO SCALE

Station 151+13.76
Manhole J-M Dimensions
D_1 = 2.75' A=26°44'50"
D_2 = 3.50' C=15.39'
B = 3.50' E=14.98'
L=15.40'

Elevation "S" = 31.9± (To be determined at time of Construction)
Elevation "R" = 32.3± (To be determined at time of Construction)

BENCH MARK:
City of Riverside B.M. No. 67-C-R.R. Nail in Curb Return @ S.E. Corner of Chicago Avenue, Arlington Avenue and Alessandro Boulevard.
Elevation 1156.542

GENERAL NOTES:

1. It shall be the responsibility of the Contractor to clear the Right of Way in accordance with the provisions of Law as it affects each utility including irrigation lines and appurtenances and at no cost to the City.
2. Construction shall be in accordance with the City of Riverside, Department of Public Works, Standard Drawings and the Standard Specifications for Public Works Construction, 1973 Edition.

MARK	REVISIONS	APPR.	DATE
Δ	CHANGED TYPE AND SIZE OF PIPES REQUIRED BY CONTRACTOR	RWJ	11/13/73
Δ	REV. REC. STA. & CURVE DATA per L.A.W. 11-20-73 Add 10 ERROR IN ORIGINAL CALCS.	RWJ	11/26/73

DESIGNED BY P.H. DRAWN BY P.H. CHECKED BY [illegible]

L A Wamicott
6/11/73
16056

CITY OF RIVERSIDE, CALIFORNIA
DEPARTMENT OF PUBLIC WORKS

	BY	DATE
APPROVED BY OFFICE ENGINEER	RWJ	3/16/72
PARK DEPARTMENT	—	—
TRAFFIC DIVISION	—	—
ASSISTANT CITY ENG.	[illegible]	9-28-73

APPROVED BY [illegible]
DIRECTOR OF PUBLIC WORKS
DATE 9-28-73

STORM DRAIN PLAN & PROFILE
ALESSANDRO BLVD.
TRACT NO. 4270
HORIZ. SCALE: 1" = 40' VERT. SCALE: 1" = 4'

INDEXED MAP
PROJECT NO. 71-56
D-261
SHEET 1 OF 3
FILE NO. 71-56-D

PROFILE
STORM DRAIN

PLAN
STORM DRAIN

BENCH MARK:
City of Riverside B.M. No. 67-C - P.K. Nell in Curb Return @ S.E. Corner of Chicago Avenue, Arlington Avenue and Alessandro Boulevard.
Elevation 1136.542

L.A. Wanniscoff
6/11/73
18056

* "AS BUILT" RNB 4-74

MARK	REVISIONS	APPR.	DATE
△	CHANGED TYPE AND SIZE OF PIPES, REQUESTED BY CONTRACTOR	[illegible]	11/9/73

DESIGNED BY R.H. DRAWN BY R.H. CHECKED BY [illegible]

CITY OF RIVERSIDE, CALIFORNIA
DEPARTMENT OF PUBLIC WORKS

APPROVED BY	BY	DATE
OFFICE ENGINEER	[illegible]	9/16/73
PARK DEPARTMENT	—	—
TRAFFIC DIVISION	—	—
ASSISTANT CITY ENG.	[illegible]	9.28

APPROVED BY [illegible]
DIRECTOR OF PUBLIC WORKS
DATE 9-28-73

STORM DRAIN PLAN & PROFILE
ALESSANDRO BLVD.
TRACT NO. 4270

HORIZ. SCALE: 1" = 40' VERT. SCALE: 1" = 4'

INDEXED: RM
PROJECT NO. 71-56
D-261
SHEET 2 OF 3
FILE NO. 71-56-1D

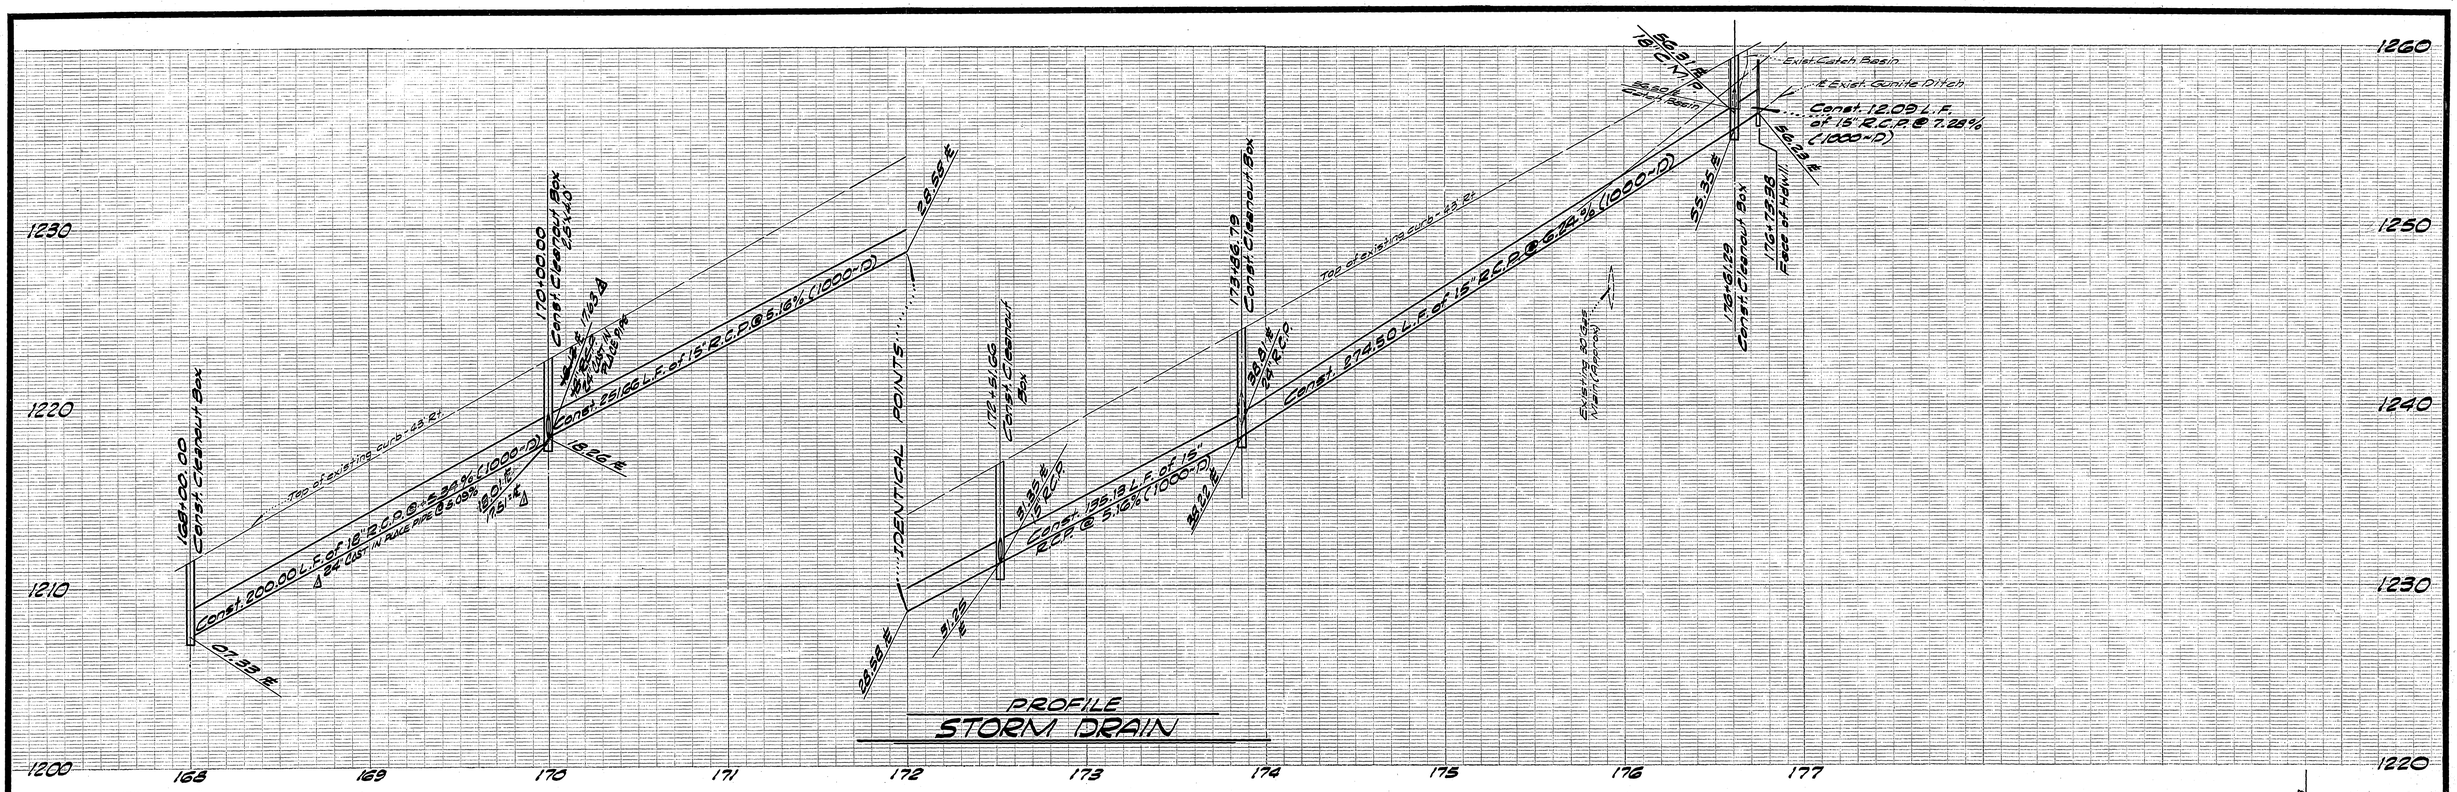

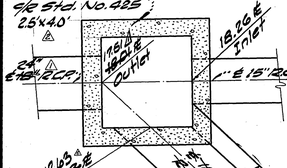

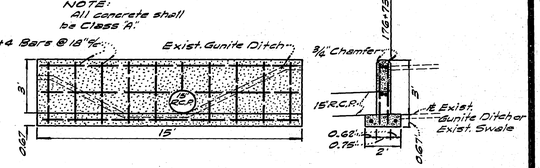

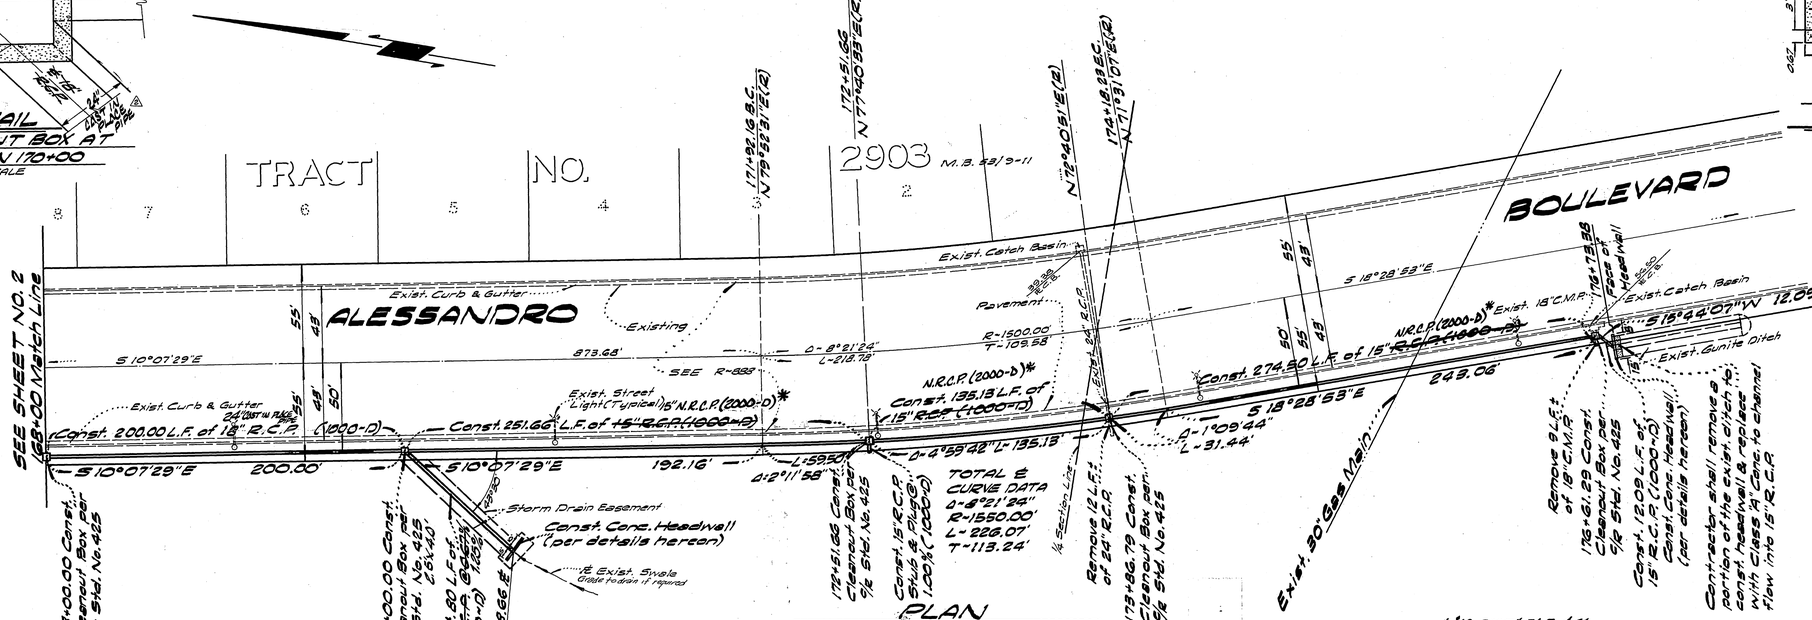

* "AS BUILT" R.A.B. 4-7-14

ALBERT A. WEBB ASSOCIATES
L.A. Wanniello
6/11/73
16056

MARK	REVISIONS	APPR.	DATE
1	CHANGED TYPE AND SIZE OF PIPES SUBJECTED TO CONTRACTOR	RAW	11/13/73
2	CHANGED TYPE AND SIZE OF PIPE ENCOUNTERED BY CONTRACTOR; NOTED BASE FOR CLEANOUT BOX	RAW	11/27/73

DESIGNED BY R.H. DRAWN BY R.H. CHECKED BY [illegible]

CITY OF RIVERSIDE, CALIFORNIA
DEPARTMENT OF PUBLIC WORKS

	BY	DATE
APPROVED BY		
OFFICE ENGINEER	RAW	9/6/73
PARK DEPARTMENT	—	—
TRAFFIC DIVISION	—	—
ASSISTANT CITY ENG.	[illegible]	9-28-73

APPROVED BY [signature]
DIRECTOR OF PUBLIC WORKS
DATE 9-28-73

STORM DRAIN PLAN & PROFILE
ALESSANDRO BLVD.
TRACT NO. 4270
HORIZ. SCALE: 1" = 40' VERT. SCALE: 1" = 4'

PROJECT NO. 71-56
D-261
SHEET 3 OF 3
FILE NO. 71-56-D