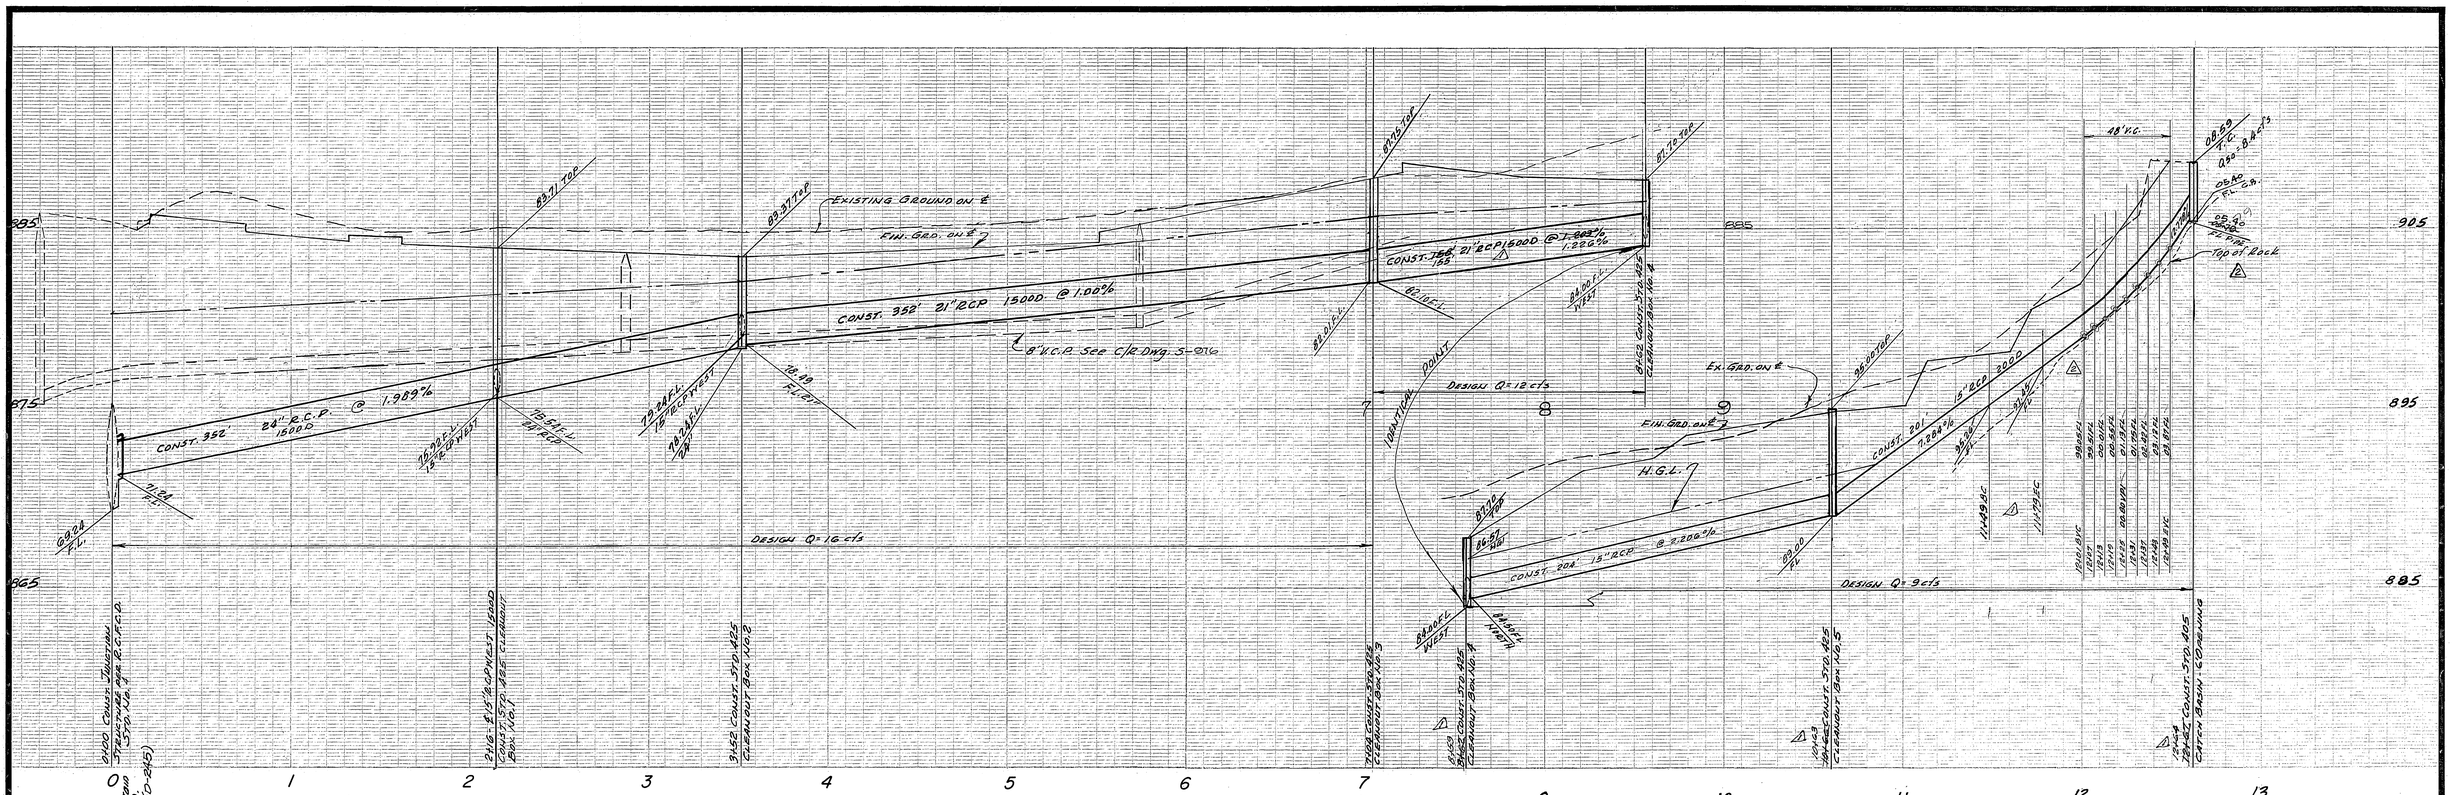

GENERAL NOTES

1. It shall be the responsibility of the Contractor to clear the Right of Way in accordance with the provisions of Law as it affects each utility including irrigation lines and appurtenances and at no cost to the City.
2. Construction shall be in accordance with the City of Riverside Department of Public Works, the Riverside County Flood Control District Standard Drawings, and the Standard Specifications for Public Works Construction, 1973 Edition.
3. Pipe shall be bedded per Case I, Standard Dwg. No. 452.
4. Cleanouts No. 1, thru 4 shall be modified to 2' x 3' inside dimensions and Alhambra Fdy. A-1552 Frame and A-1555 Cover.

BENCH MARK - ELEV. 889.41 No. G-G-H
PK nail and City tag in top of retaining wall on south side of Arlington Ave. 75' ± W'ly. of Horace St. City F.B. 948/17.

RCFCD PERMIT No 10190346

ALBERT A. WEBB ASSOCIATES
CIVIL ENGINEERS
RIVERSIDE, CALIFORNIA
APPROVED BY Ernest H. Webb DATE 4/30/74
R.E. No. 9876
W.O. 75-227 FOR: Sterling Devel. F.B. 1012

MARK	REVISIONS	APPR.	DATE
2	Revised Storm Drain Grade to avoid rock (Detail) ENW	RW	3/15/76
1	Relocated Storm Drain to avoid 2:1 Slope along Property Line ENW	RW	2/10/76

DESIGNED BY REC DRAWN BY ____ CHECKED BY [illegible]

CITY OF RIVERSIDE, CALIFORNIA
PUBLIC WORKS DEPARTMENT

APPROVED BY	BY	DATE
PRINCIPAL ENGINEER	RW	11/13
PARK DEPARTMENT	—	—
TRAFFIC DIVISION	—	—
CHIEF PUB. WKS. ENGR.		

APPROVED BY William D. Gardner
DIRECTOR OF PUBLIC WORKS
DATE 11/19/75

STORM DRAIN PLAN & PROFILE
EAST END OF DAKOTA AVE. TO ARLINGTON AVENUE
PARCEL MAP NO. 123
SCALE: 1"=40' HORIZ. 1"=4' VERT.

ACCOUNT No.
DRAWING NUMBER
D-270
SHEET 1 OF 1
75-227-D