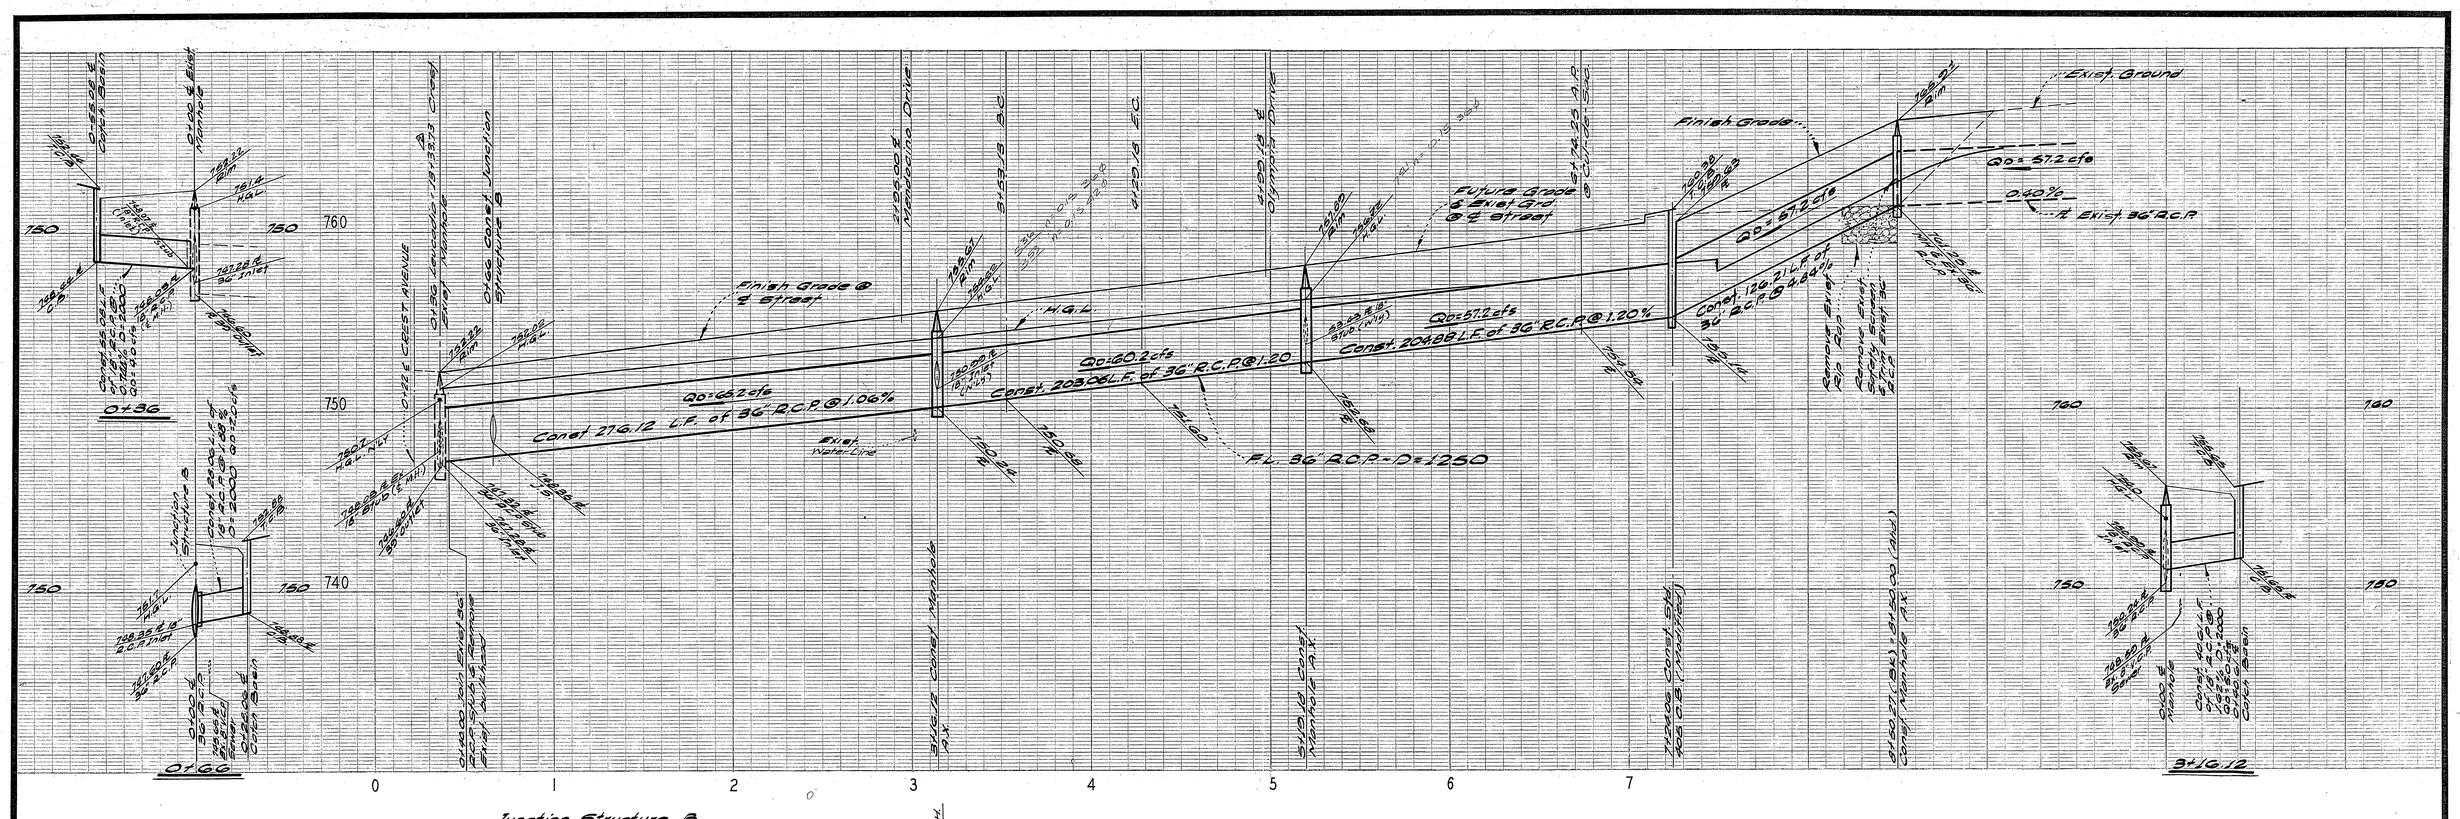

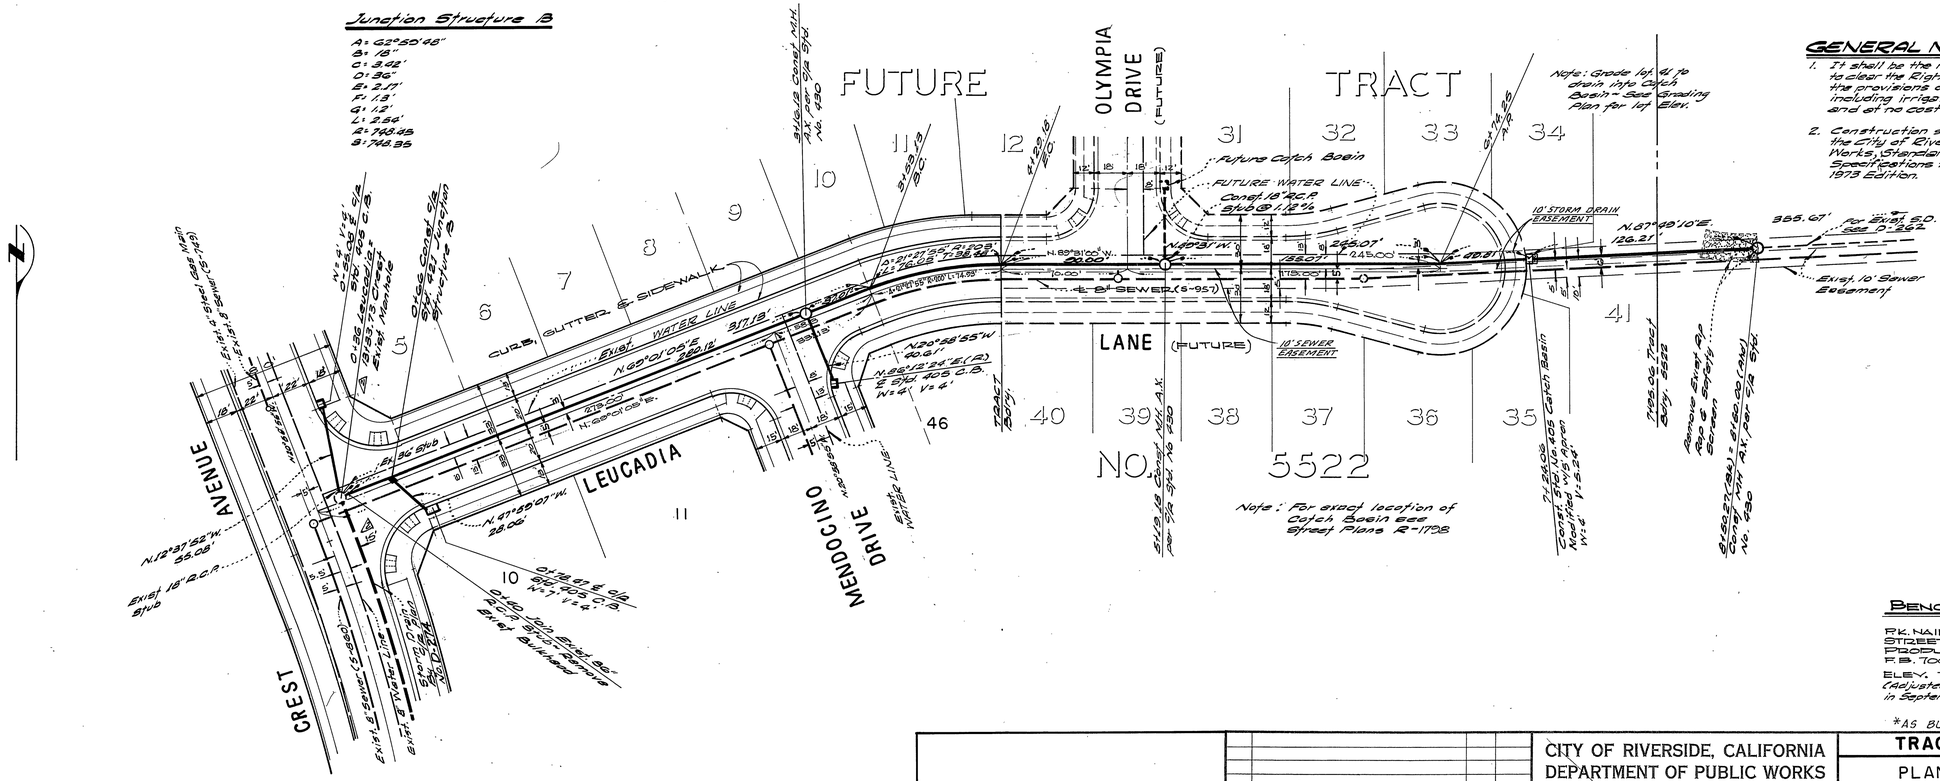

Junction Structure B

A: 62°50'48"
B: 18"
C: 3.02'
D: 36"
E: 2.17'
F: 1.3'
G: 1.2'
L: 2.56'
R: 748.45
S: 748.35

GENERAL NOTES:

1. It shall be the responsibility of the Contractor to clear the Right of Way in accordance with the provisions of Law as it affects each utility including irrigation lines and appurtenances and at no cost to the City.
2. Construction shall be in accordance with the City of Riverside, Department of Public Works, Standard Drawings and the Standard Specifications for Public Works Construction, 1973 Edition.
3. Bedding shall be per City of Riverside Std. No. 452 Case I.
4. PIPE ALTERNATE ~ The contractor may, at his option, substitute concrete cast in place pipe.

BENCH MARK

PK NAIL IN EAST CURB ON TYLER STREET, ON ℄ GAYLORD AVENUE PRODUCED, PER CITY OF RIVERSIDE F.B. 706/1

ELEV. 778.21
(Adjusted to C/R Datum - Elev. 778.09 in September 1973)

*AS BUILT 8-76 KBT

L.D. Wainscott 10-15-74 16056	2 Moved line in Crest 1' West at request of Contractor RC	RW	4/24/75	CITY OF RIVERSIDE, CALIFORNIA DEPARTMENT OF PUBLIC WORKS	TRACT NO. 5522-1
	1 Added Note #4	RW	4/21/75	APPROVED BY / BY / DATE: OFFICE ENGINEER, PARK DEPARTMENT, TRAFFIC DIVISION, ASSISTANT CITY ENG.	PLAN AND PROFILE STORM DRAIN
W.O. 74-212. FOR ANDREWS DEVLOPMENT F.B. 1031	MARK / REVISIONS / APPR. / DATE			APPROVED BY William D. Gardner, DIRECTOR OF PUBLIC WORKS, DATE 12/24/74	HORIZ. SCALE: 1" = 40' VERT. SCALE: 1" = 4'
	DESIGNED BY PH DRAWN BY V.S. CHECKED BY				

PROJECT NO. 73-50

D-276

SHEET 1 OF 1

FILE NO. 74-212-D