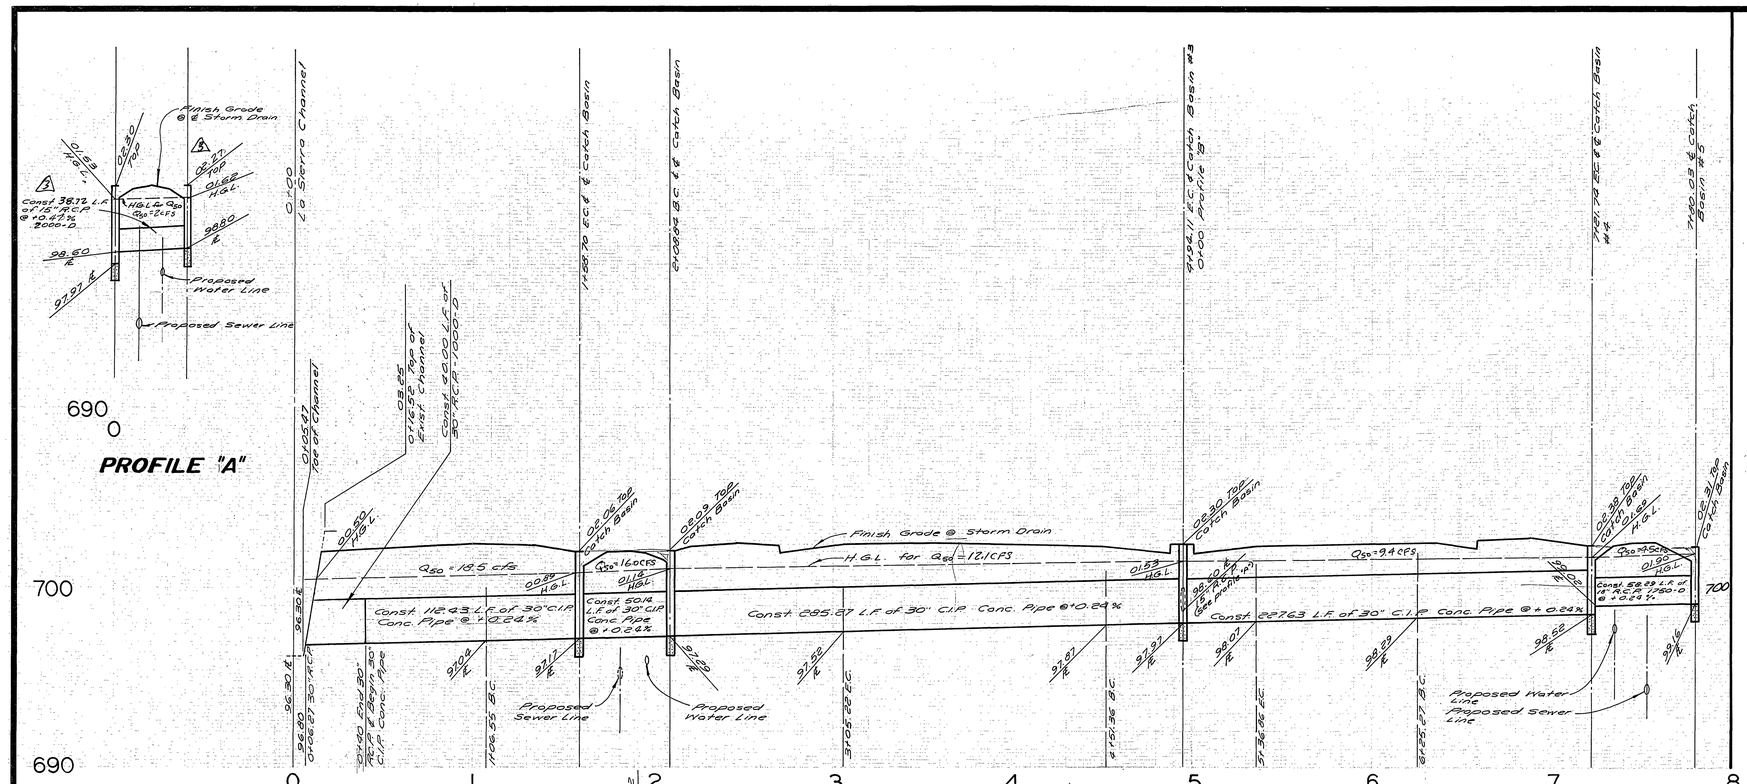

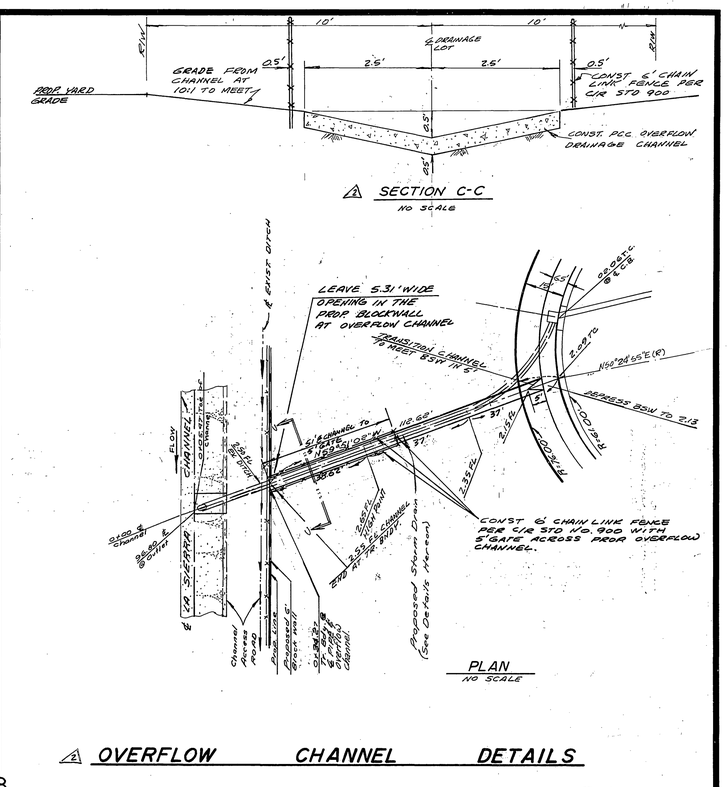

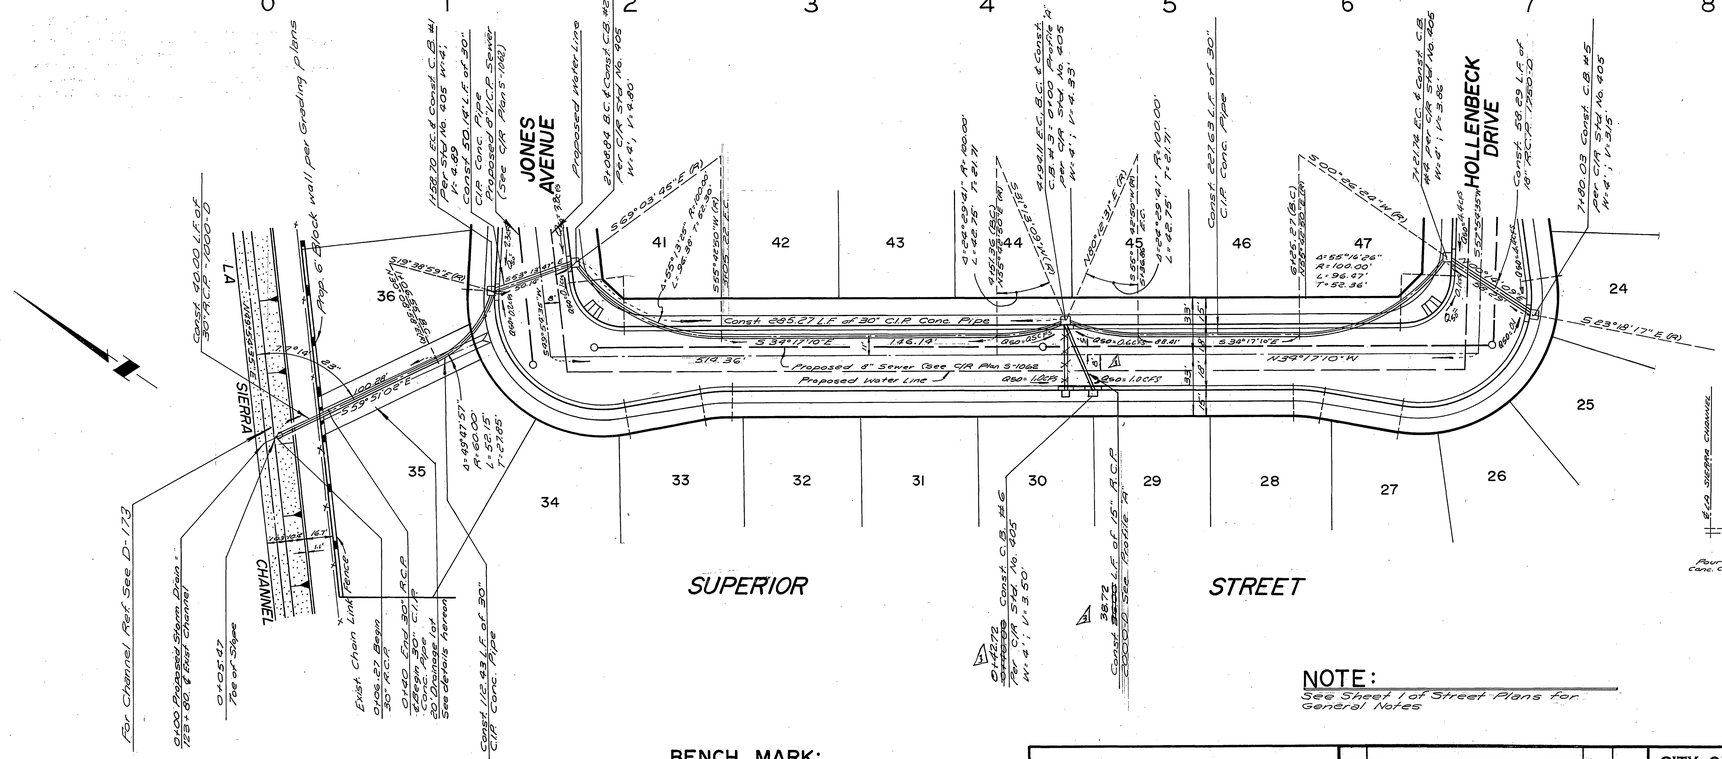

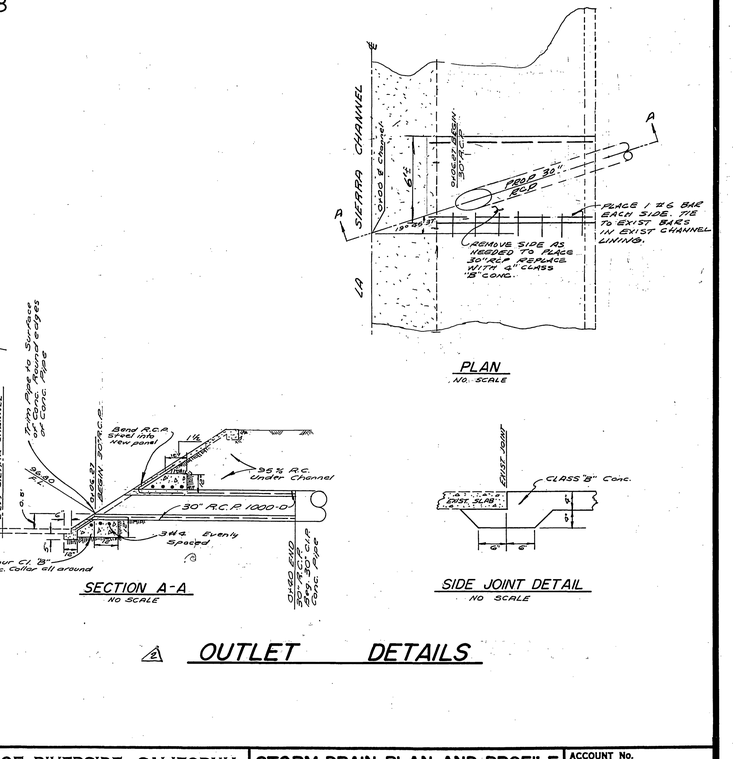

NOTE:
See Sheet 1 of Street Plans for General Notes

BENCH MARK:
No. F2-E - P.K. Nail in N.W. Curb return @ La Sierra Avenue and Pierce Street per City of Riverside F.B. 939/1 Elev. 714.216

ALBERT A. WEBB ASSOCIATES CIVIL ENGINEERS RIVERSIDE, CALIFORNIA APPROVED BY L.D. Winnell DATE 9-2-76 R.E. No. 16056			CITY OF RIVERSIDE, CALIFORNIA PUBLIC WORKS DEPARTMENT		STORM DRAIN PLAN AND PROFILE
	4	REVISED C.B. TO MISS O/W CONC. PER RE 12-13-77		APPROVED BY / BY / DATE	TRACT NO. 6992 SUPERIOR STREET 20' DRAINAGE LOT
	3	GENERAL REVISIONS TO CHANGE OVERFLOW CHANNEL PER RE 12-13-76		PRINCIPAL ENGINEER	APPROVED BY DIRECTOR OF PUBLIC WORKS DATE 12-9-76
				PARK DEPARTMENT	
				TRAFFIC DIVISION	
	1	ADDED GATE CONSTRUCTION NOTE, RE BDM		CHIEF PUB. WKS. ENGR.	SCALE: Horiz 1"=40' - Vert. 1"=4'
	MARK	REVISIONS	APPR. DATE	PLANNING	
W.O. 76-85 FOR: Hollenbeck Dev. Co. F.B. 1039	DESIGNED BY RH DRAWN BY RH/BAB CHECKED BY BDM				

ACCOUNT No.
DRAWING NUMBER D-299
SHEET 1 OF 2
76-85-D

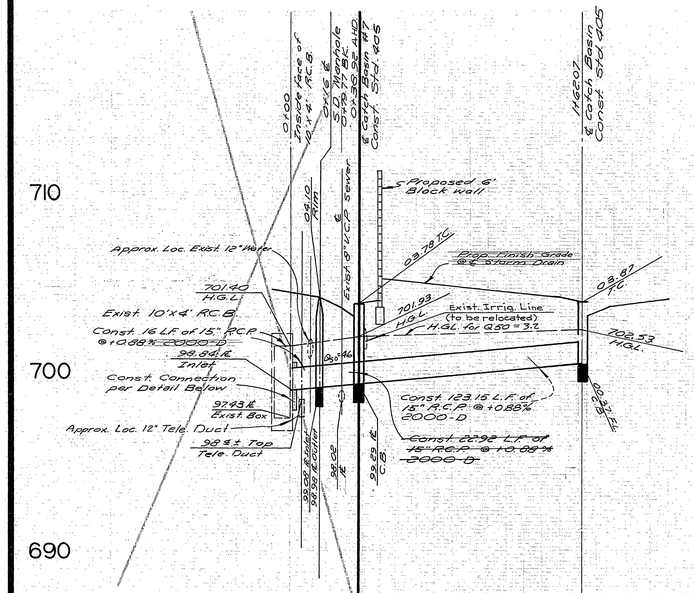

PROFILE "B"

SEE RIGHT FOR REVISED PROFILE TO STA. 0+79.77 BK. = 0+38.92 AHD. 1

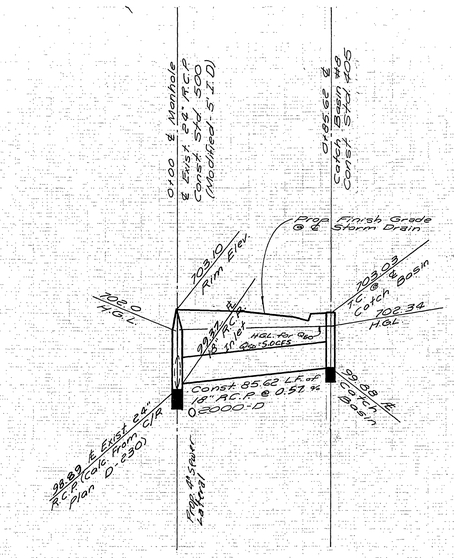

PROFILE "C"

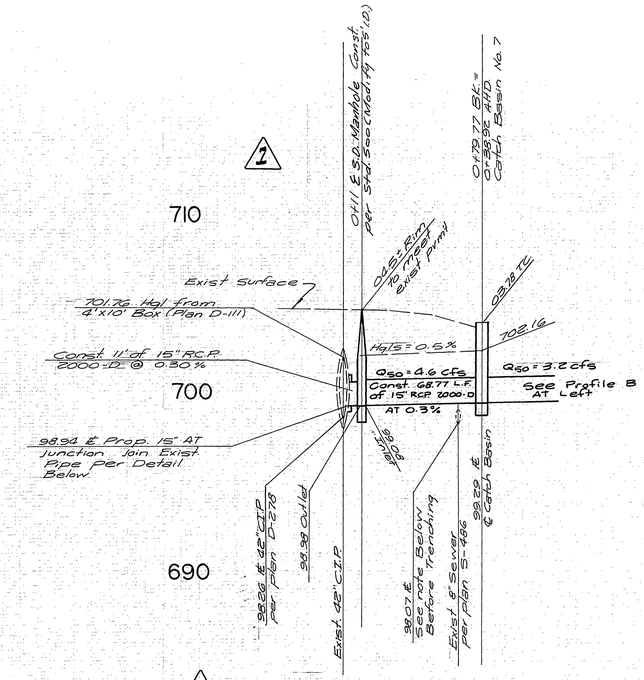

1 PROFILE B (REVISED)

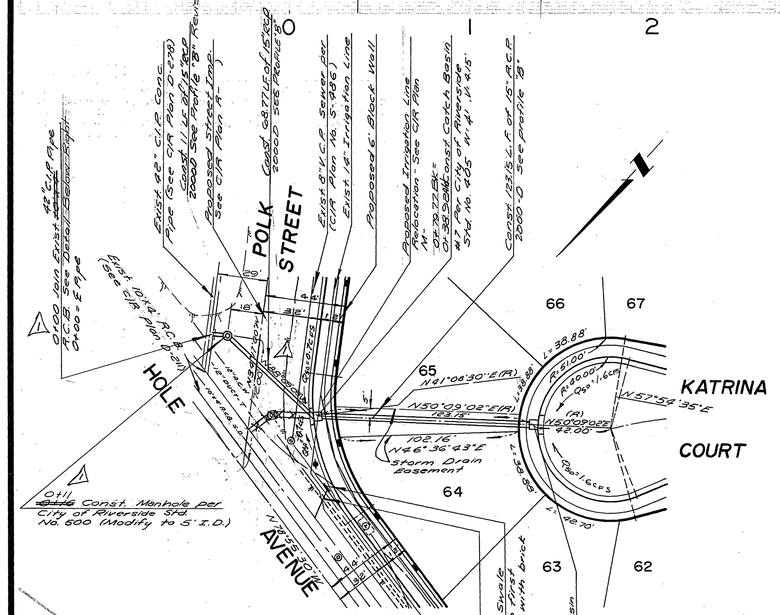

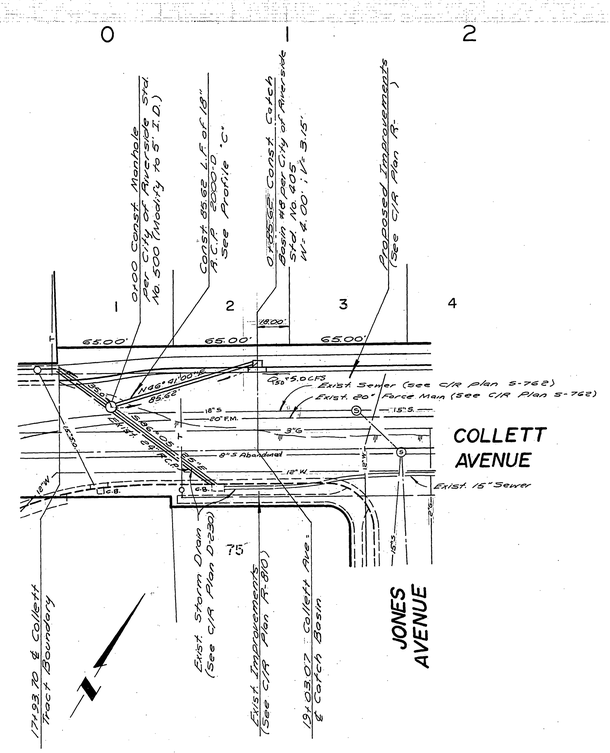

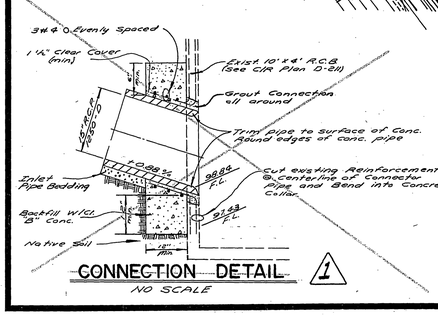

CONNECTION DETAIL 1

NO SCALE

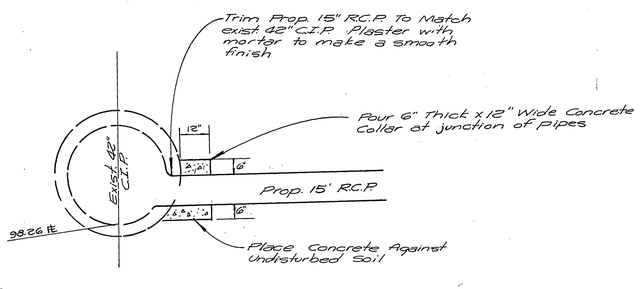

1 CONNECTION DETAIL

NO SCALE

Note:

Prior to Commencing the Storm Drain Construction the Contractor shall expose the existing Pipes and Contact the Engineer at (714) 686-1070, for Verification of the location & Elevation of exist. facilities

BENCH MARK:

No. F8-E - P.K. Nail in N.W. curb return @ La Sierra Avenue and Pierce Street per City of Riverside I.F.B. 8391, Elev. 714.416

ALBERT A. WEBB ASSOCIATES CIVIL ENGINEERS RIVERSIDE, CALIFORNIA APPROVED BY L.D. Hunsaker DATE 9-2-76 R.E. No. 16056	1 General revisions to relocate storm drain to avoid conflict with water line relocation. BDM	PH	12/8/76	CITY OF RIVERSIDE, CALIFORNIA PUBLIC WORKS DEPARTMENT
	MARK / REVISIONS	APPR.	DATE	APPROVED BY / BY / DATE PRINCIPAL ENGINEER / PH / 12/8 PARK DEPARTMENT TRAFFIC DIVISION CHIEF PUB. WKS. ENGR.
W.O. 76-85 FOR: Hollenbeck dev. Co. F.B. 1039	DESIGNED BY PH DRAWN BY PH 7/8 CHECKED BY BDM			APPROVED BY T. Hartbeck DIRECTOR OF PUBLIC WORKS DATE 12-9-76

STORM DRAIN PLAN AND PROFILE

TRACT NO. 6992
KATRINA COURT
COLLETT AVENUE

SCALE: Horiz 1"=40'; Vert 1"=4'

ACCOUNT No.

DRAWING NUMBER D-299

SHEET 2 OF 2

76-85-D