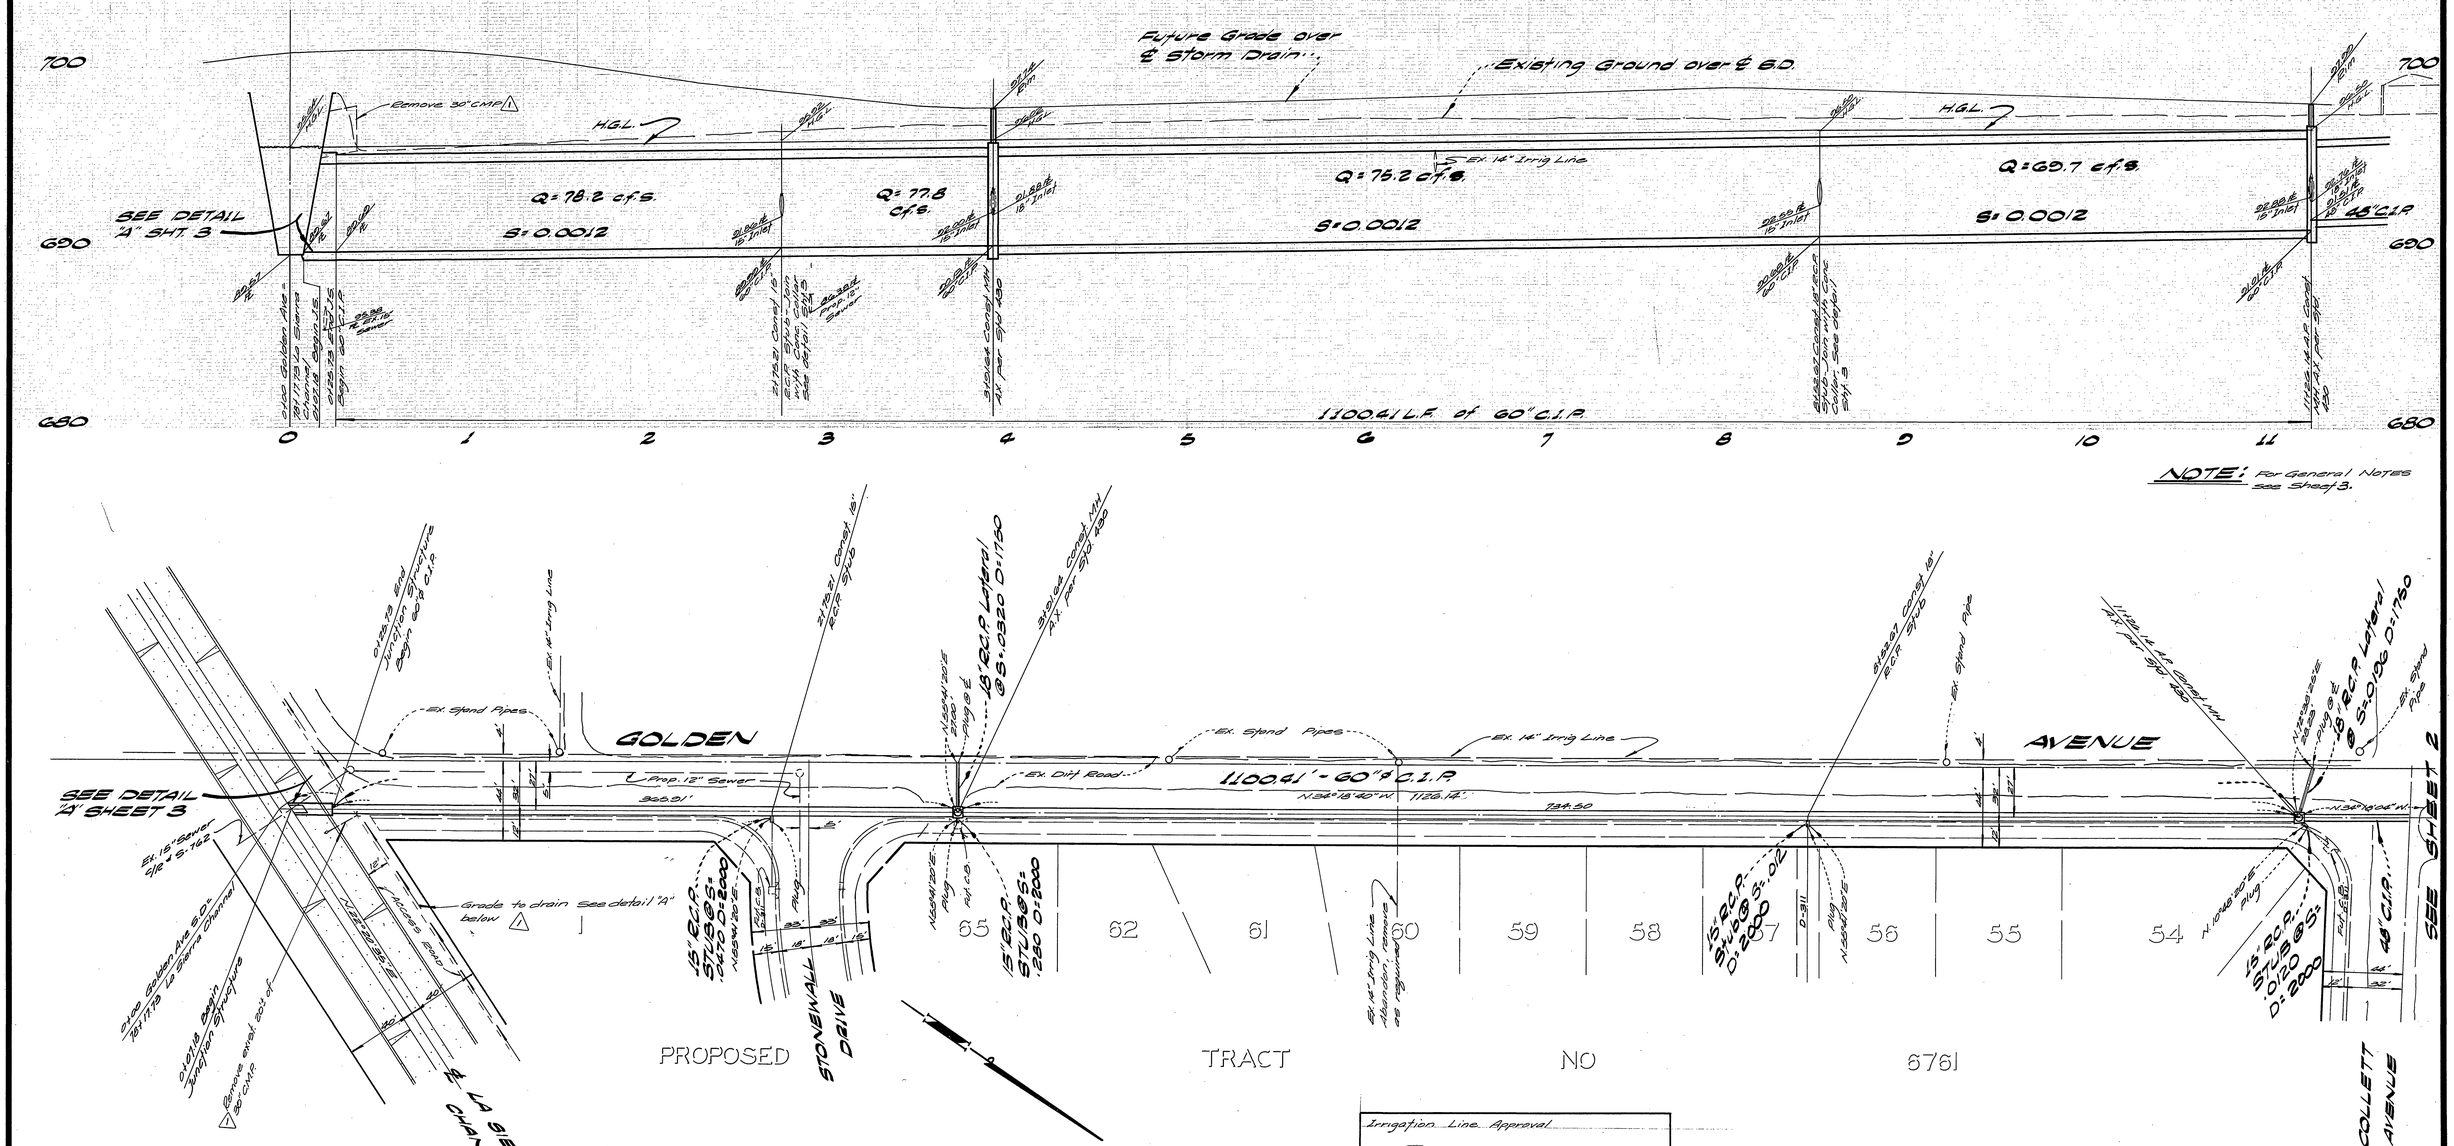


NOTE: For General Notes see Sheet 3.

## BENCH MARK

R&R spike in power pole No. 24589-J at S.E. corner of La Sierra Ave. and Collett Ave. C.R.F.B. 978/5
Elevation: 704.25

Irrigation Line Approval
Fred W. Kingdon 3/24/77
Pacesetter Homes Inc Date

*AS BUILT 8-77 KPT

INDEXED E.T.

ALBERT A. WEBB ASSOCIATES
CIVIL ENGINEERS
RIVERSIDE, CALIFORNIA
APPROVED BY Ernest H. Webb DATE 12/3/76
R.E. No. 9876
W.O. 75-135 FOR: Pacesetter Homes F.B. 1032

| MARK | REVISIONS | APPR. | DATE |
|---|---|---|---|
| 1 | added Grade to drain & C.M.P. removal | RLT | 3/1/77 |

DESIGNED BY LAW DRAWN BY RLT CHECKED BY BDM

CITY OF RIVERSIDE, CALIFORNIA
PUBLIC WORKS DEPARTMENT

| APPROVED BY | BY | DATE |
|---|---|---|
| PRINCIPAL ENGINEER | RLT | 4/26 |
| PARK DEPARTMENT | | |
| TRAFFIC DIVISION | | |
| CHIEF PUB. WKS. ENGR. | | 4-26 |

APPROVED BY
DIRECTOR OF PUBLIC WORKS
DATE 4-26-77

STORM DRAIN PLAN AND PROFILE
Golden Avenue
SCALE: Horiz: 1"=40' Vert: 1"=4'

ACCOUNT No. 09-573-415
DRAWING NUMBER D-312
SHEET 1 OF 3
75-135-D

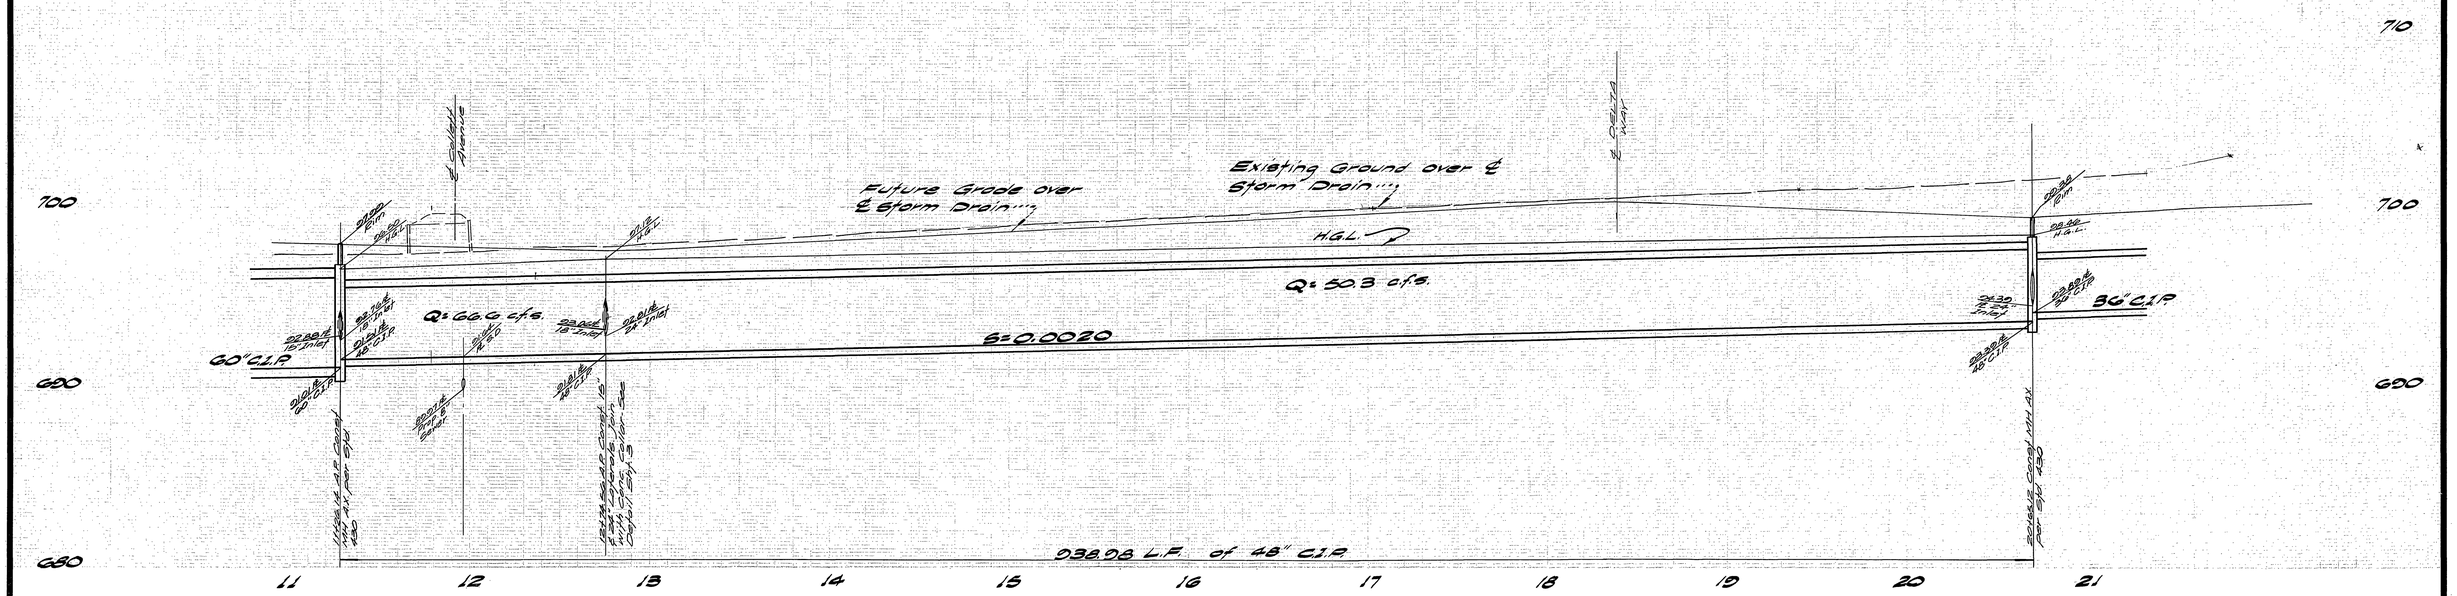


NOTE: For General Notes See Sheet 3.

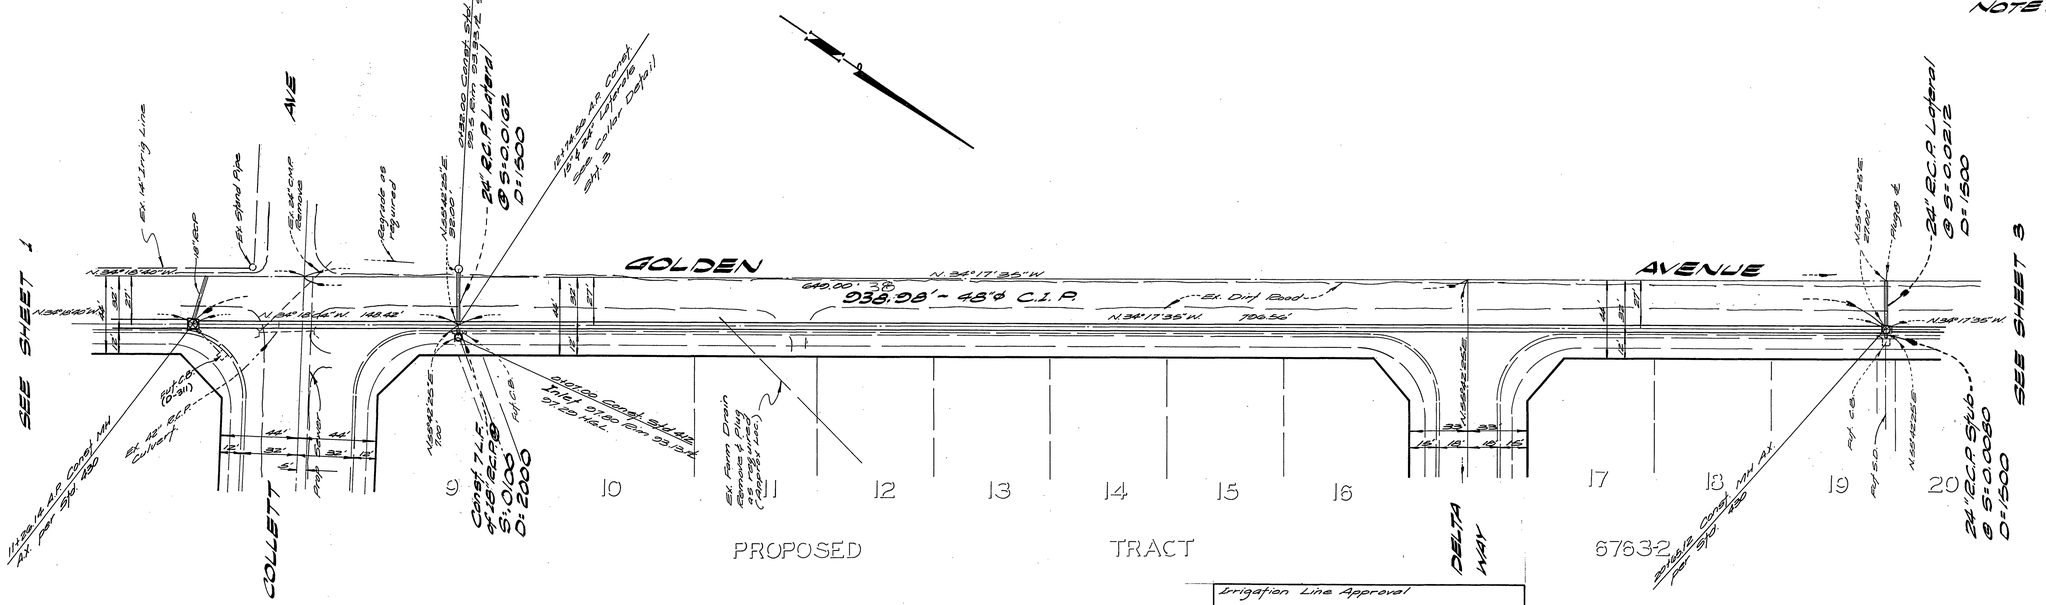


*AS BUILT 8-77 KPT

Irrigation Line Approval

Fred W Kingdon 3/24/77

Pacesetter Homes Inc. Date

**BENCH MARK**

R&R spike in power pole No. 24589 J of S.E. corner La Sierra Ave. and Collett Ave. C.R.F.B. 978/5. Elevation: 704.25

ALBERT A. WEBB ASSOCIATES
CIVIL ENGINEERS
RIVERSIDE, CALIFORNIA

APPROVED BY Emil H Webb DATE 12/3/76

R.E. No. 9876

W.O. 75-135 FOR: Pacesetter Homes F.B. 1032

| MARK | REVISIONS | APPR. | DATE |
|---|---|---|---|

DESIGNED BY LAW DRAWN BY RLT CHECKED BY BDM

CITY OF RIVERSIDE, CALIFORNIA
PUBLIC WORKS DEPARTMENT

| APPROVED BY | BY | DATE |
|---|---|---|
| PRINCIPAL ENGINEER | [illegible] | 4/26 |
| PARK DEPARTMENT | | |
| TRAFFIC DIVISION | | |
| CHIEF PUB. WKS. ENGR. | [illegible] | 4-26 |

APPROVED BY [signature]
DIRECTOR OF PUBLIC WORKS
DATE 4-26-77

STORM DRAIN PLAN AND PROFILE

Golden Avenue

SCALE: Horiz: 1"=40' Vert: 1"=4'

ACCOUNT No. 09-573-415

DRAWING NUMBER D-312

SHEET 2 OF 3

75-135-D

## GENERAL NOTES

1. The private engineer signing these plans is responsible for assuring the accuracy and acceptability of the work hereon. In the event of a discrepancy arising during construction as a result of errors or omissions, the private engineer shall be responsible for determining an acceptable solution and revising the plans for approval by the City.
2. It shall be the responsibility of the contractor to clear the Right-of-Way in accordance with the provisions of law as it affects each utility including irrigation lines and appurtenances and at no cost to the city.
3. Construction shall be in accordance with the City of Riverside Department of Public Works, Standard Drawings, and the Standard Specifications for Public Works Construction, 1976 Edition.
4. All work within R.C.F.C. Right-of-Way to be done in accordance with the City of Riverside Encroachment Permit. Written notice five (5) working days prior to starting work within R.C.F.C. Right-of-Way shall be given.

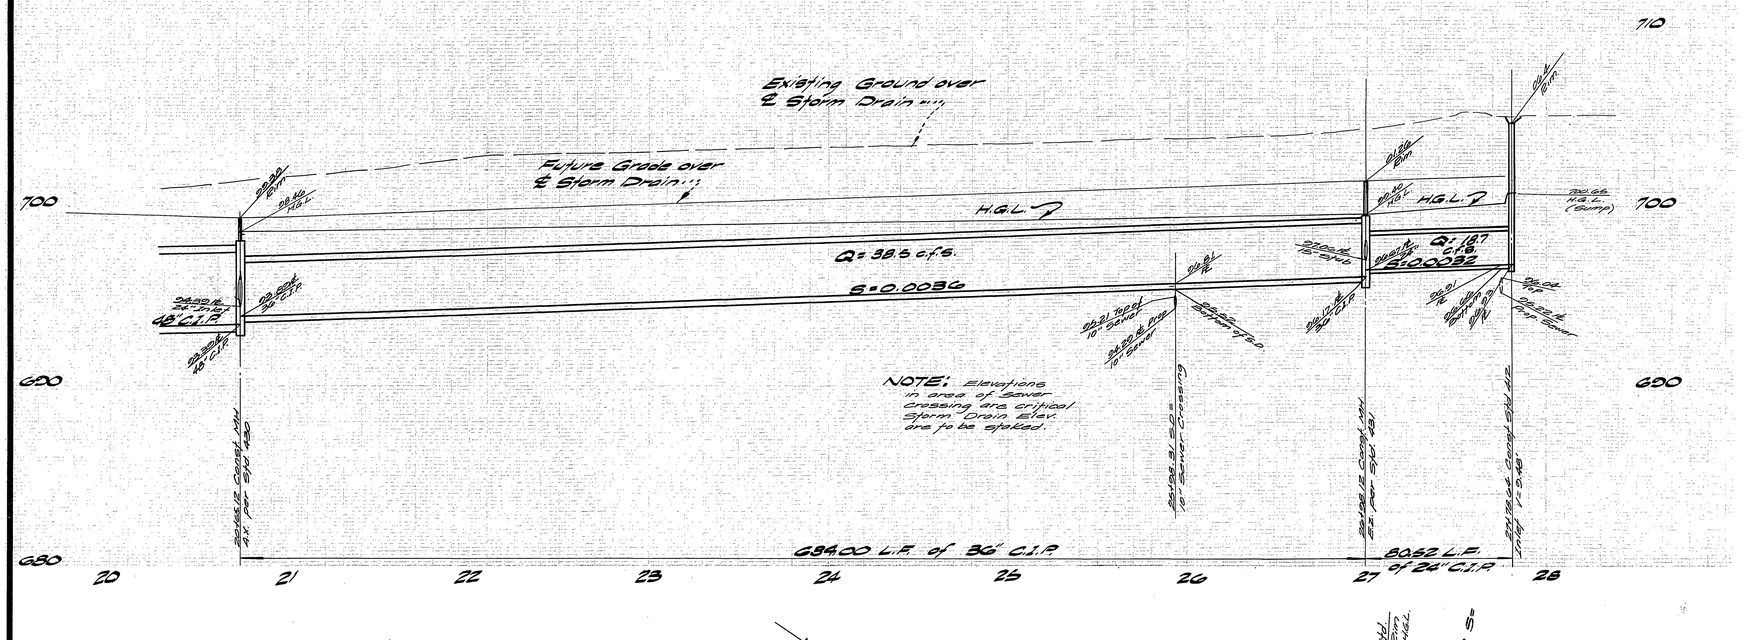


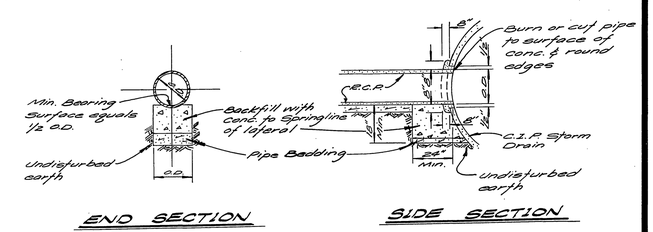


## COLLAR DETAIL

No Scale

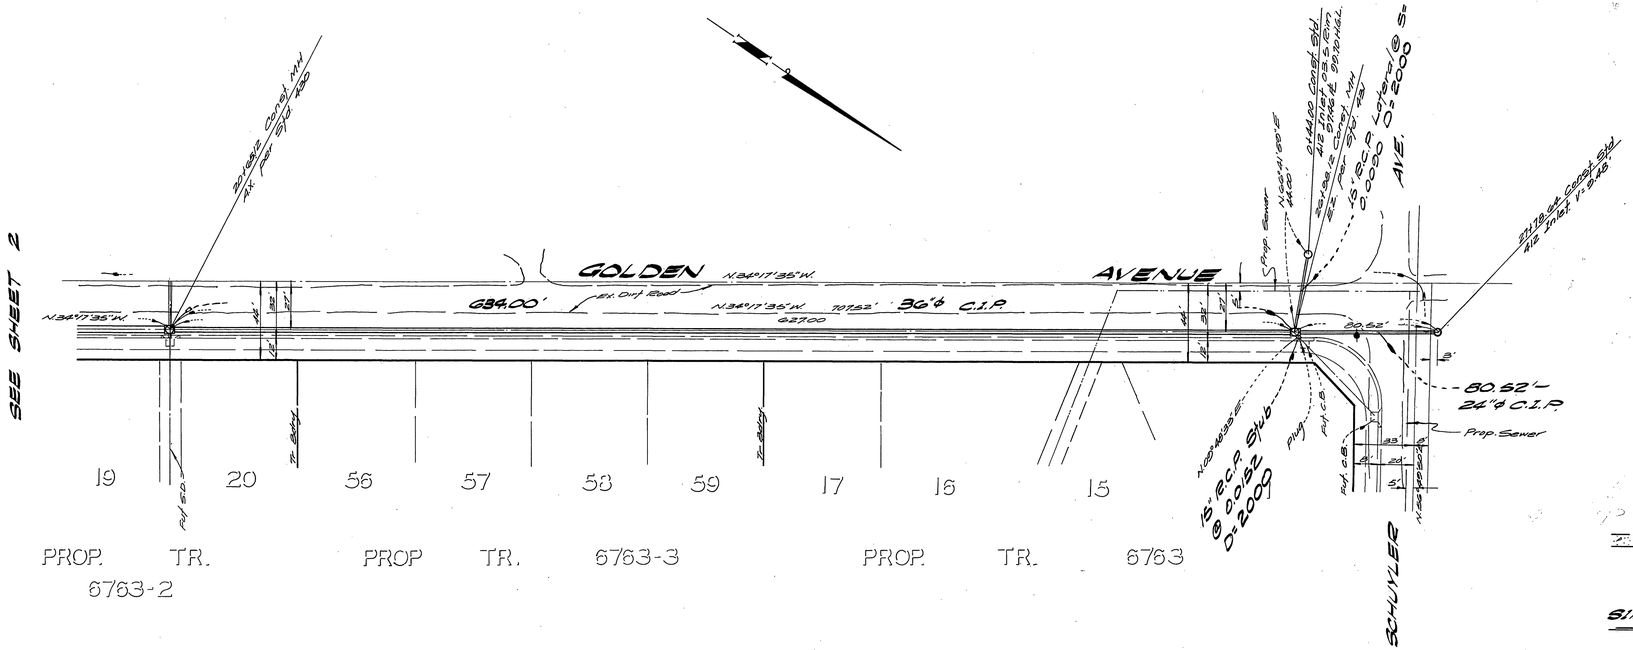


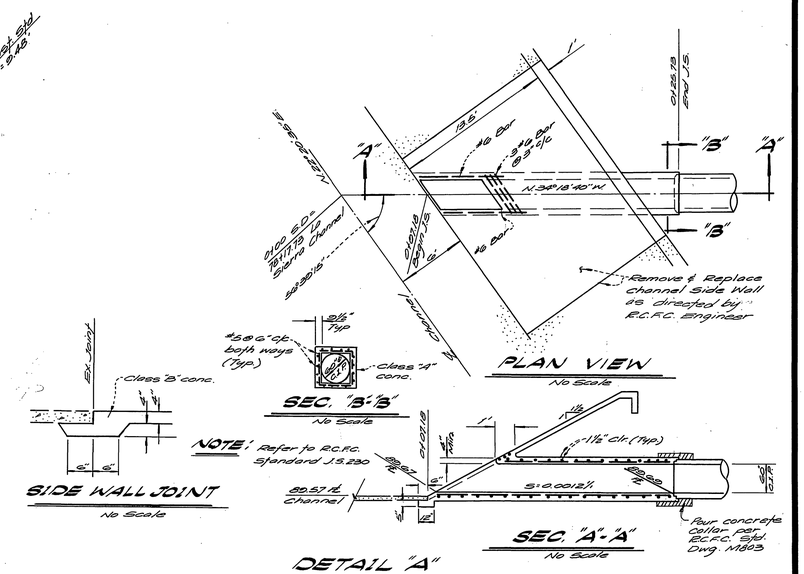


## BENCH MARK


*AS BUILT 8-77 KPT

| | | | |
|---|---|---|---|
| ALBERT A. WEBB ASSOCIATES<br>CIVIL ENGINEERS<br>RIVERSIDE, CALIFORNIA<br>APPROVED BY Scott N. Walls DATE 12/3/76<br>R.E. No. 9876 | MARK / REVISIONS / APPR. / DATE | CITY OF RIVERSIDE, CALIFORNIA<br>PUBLIC WORKS DEPARTMENT | STORM DRAIN PLAN AND PROFILE |
| W.O. 75-135 FOR: Pacesetter Homes F.B. 1032 | DESIGNED BY LAW DRAWN BY SLT CHECKED BY BDM | APPROVED BY / BY / DATE<br>PRINCIPAL ENGINEER / 4/26<br>PARK DEPARTMENT<br>TRAFFIC DIVISION<br>CHIEF PUB. WKS. ENGR. 4-26<br>APPROVED BY<br>DIRECTOR OF PUBLIC WORKS<br>DATE 4-26-77 | Golden Avenue<br>SCALE: Horiz: 1"=40' Vert: 1"=4' |

ACCOUNT No. 09-573-415
DRAWING NUMBER D-312
SHEET 3 OF 3
75-135-D