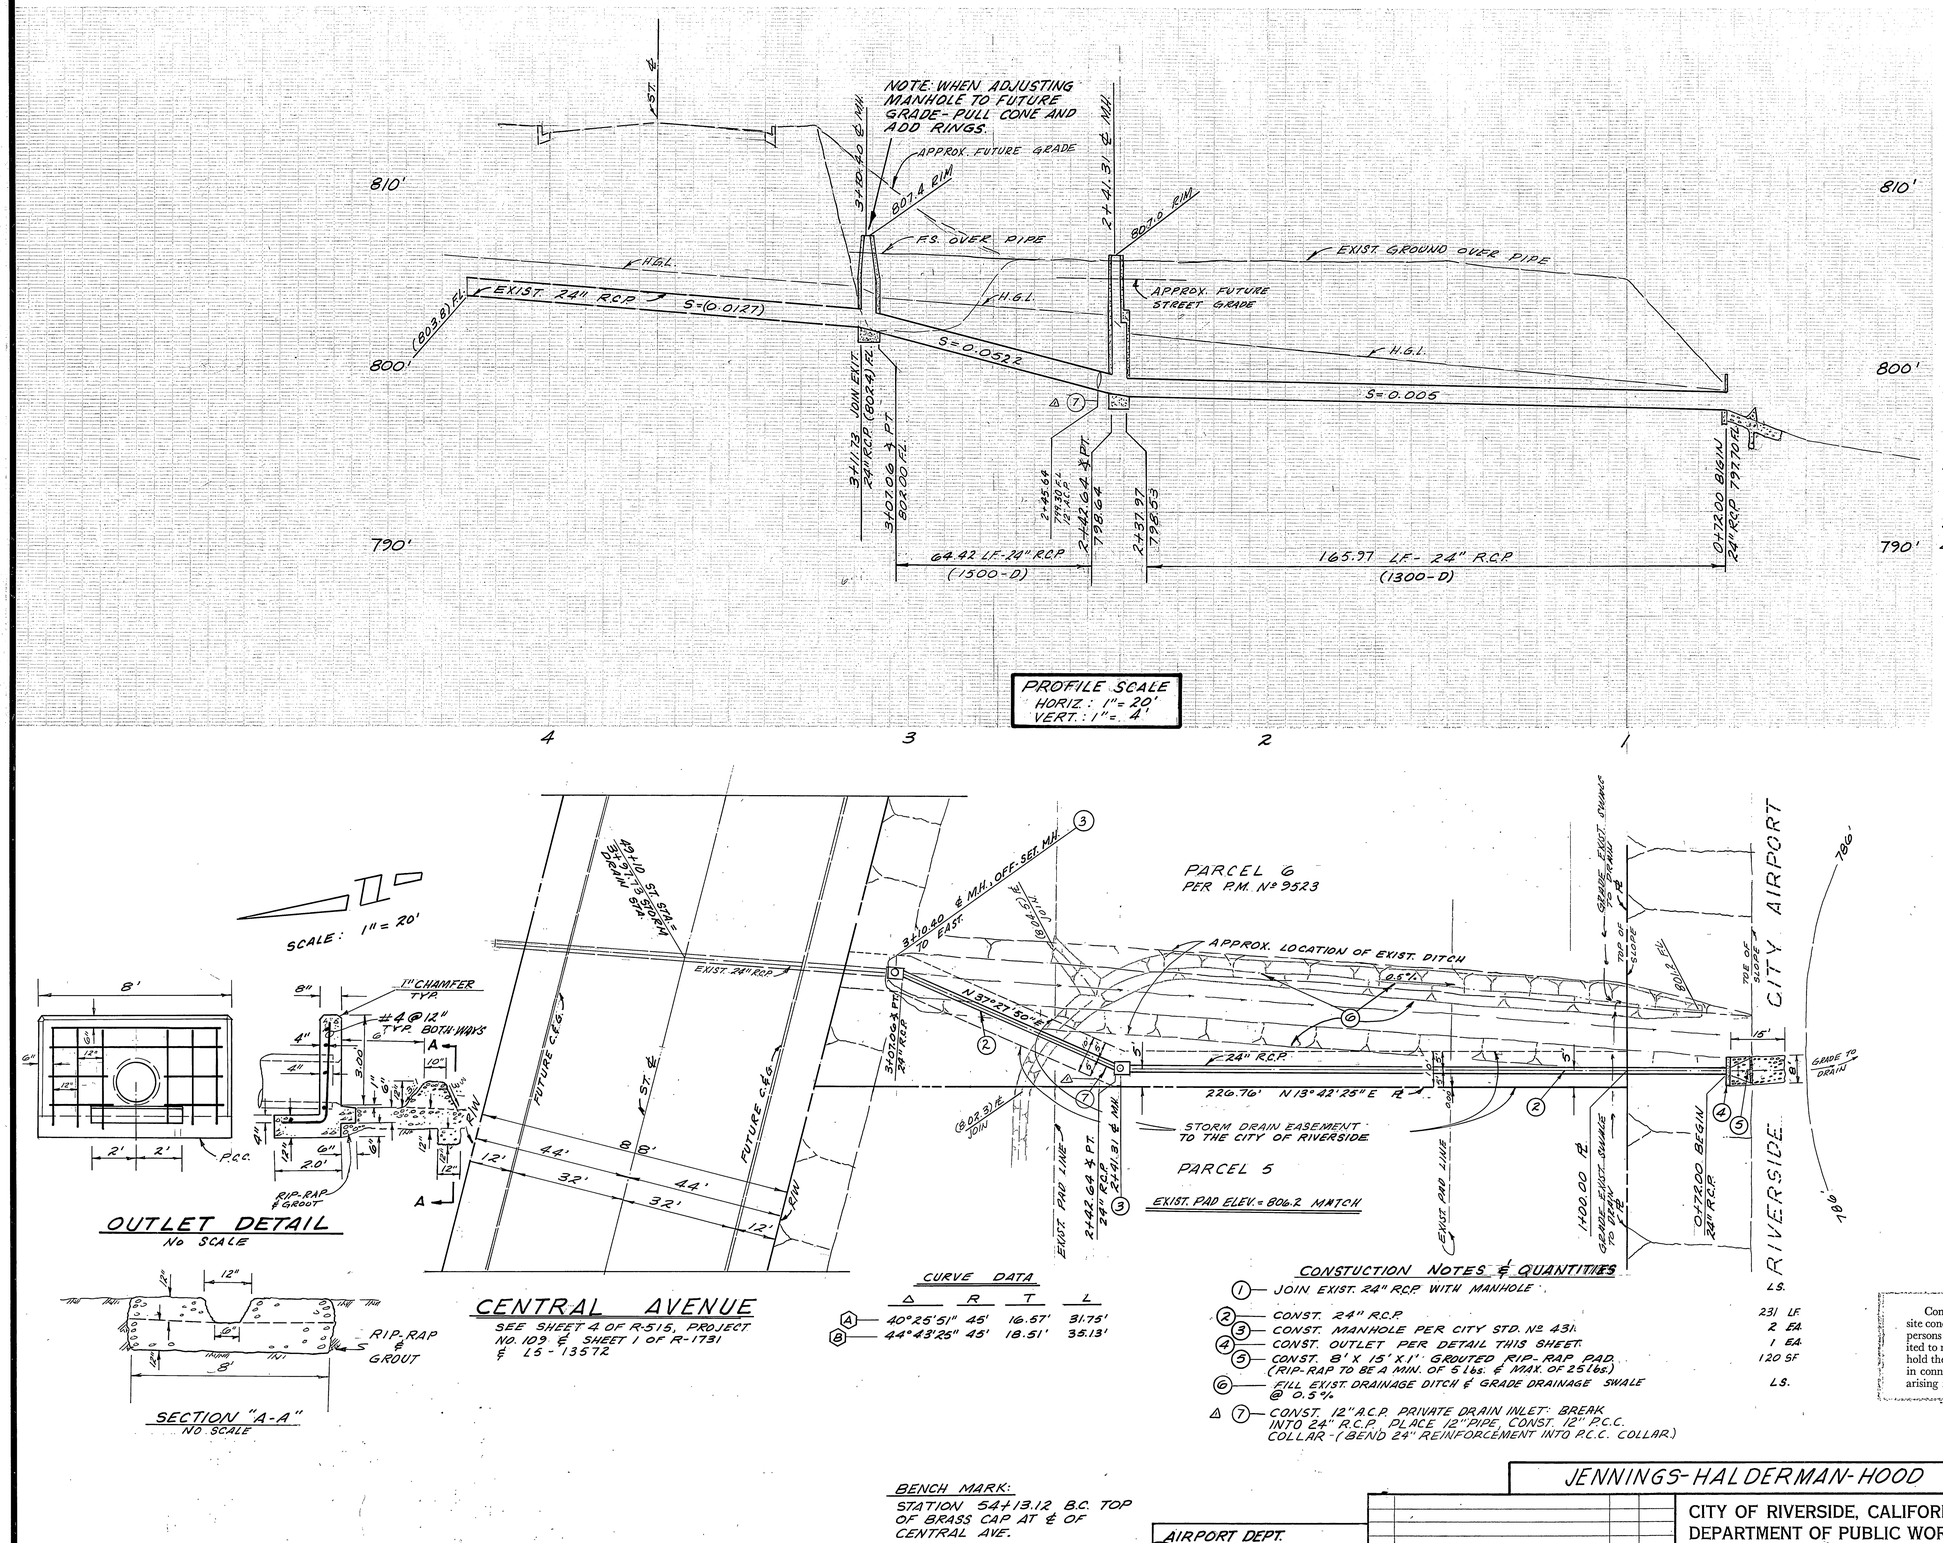

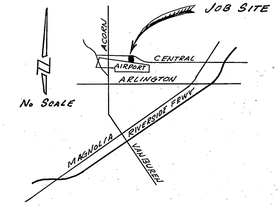

VICINITY MAP

GENERAL NOTES

1. ALL FILL & GRADING OPERATIONS SHALL CONFORM TO THE CITY OF RIVERSIDE SPECIFICATIONS AND THE SPECIFICATIONS CONTAINED ON A GRADING PLAN FOR THIS SITE DATED 12/22/76.
2. ALL MATERIAL FOR DITCH FILL IS STOCK PILED ON SITE. IF MORE MATERIAL IS REQUIRED, BORROW IS AVAILABLE ADJACENT TO SITE. CONTRACTOR SHALL VERIFY ALL EXISTING SITE CONDITIONS, LOCATION OF BORROW AREA, AND AVAILABLE FILL MATERIAL PRIOR TO SUBMITTING BID.
3. LOCATION AND ELEVATION OF EXISTING 24" R.C.P. SHALL BE VERIFIED IN FIELD AT TIME OF CONSTRUCTION.
4. CONSTRUCTION SHALL BE IN ACCORDANCE WITH THE CITY OF RIVERSIDE, DEPARTMENT OF PUBLIC WORKS, STANDARD DRAWINGS, AND THE STANDARD SPECIFICATION FOR PUBLIC WORKS CONSTRUCTION, 1976 EDITION.

CURVE DATA

	Δ	R	T	L
A	40°25'51"	45'	16.57'	31.75'
B	44°43'25"	45'	18.51'	35.13'

CONSTUCTION NOTES & QUANTITIES

1	JOIN EXIST. 24" RCP WITH MANHOLE	LS.
2	CONST. 24" R.C.P.	231 LF
3	CONST. MANHOLE PER CITY STD. Nº 431.	2 EA
4	CONST. OUTLET PER DETAIL THIS SHEET.	1 EA
5	CONST. 8' X 15' X 1' GROUTED RIP-RAP PAD. (RIP-RAP TO BE A MIN. OF 5 lbs. & MAX. OF 25 lbs.)	120 SF
6	FILL EXIST. DRAINAGE DITCH & GRADE DRAINAGE SWALE @ 0.5 %	LS.
Δ 7	CONST. 12" A.C.P. PRIVATE DRAIN INLET: BREAK INTO 24" R.C.P. PLACE 12" PIPE, CONST. 12" P.C.C. COLLAR - (BEND 24" REINFORCEMENT INTO P.C.C. COLLAR.)	

137.97

Contractor agrees that he shall assume sole and complete responsibility for job site conditions during the course of construction of this Project, including safety of all persons and property; that this requirement shall apply continuously and not be limited to normal working hours; and that the Contractor shall defend, indemnify and hold the Owner and the Engineer harmless from any and all liability, real or alleged, in connection with the performance of work on this Project, excepting for liability arising from the sole negligence of the Owner or the Engineer.

*AS BUILT 8-78 KPT

BENCH MARK:
STATION 54+13.12 B.C. TOP OF BRASS CAP AT ℄ OF CENTRAL AVE.
ELEV.= 811.06'

AIRPORT DEPT.
8/22/77
DATE

PREPARED UNDER THE SUPERVISION OF:
LAWRENCE R. WILEZIBIN RCE 19355 6/28/77 DATE

MARK	REVISIONS	APPR.	DATE
Δ	ADDED 12" PRIVATE DRAIN INLET	LRW	1-19-77

DESIGNED BY LRW DRAWN BY O.B.P. CHECKED BY LRW

JENNINGS-HALDERMAN-HOOD 540 NORTH GOLDEN CIRCLE DR., SANTA ANA, CAL. PHONE NO.: 835-3611

CITY OF RIVERSIDE, CALIFORNIA
DEPARTMENT OF PUBLIC WORKS

APPROVED BY	BY	DATE
PRINCIPAL ENGINEER		9/14
PARK DEPARTMENT	—	—
TRAFFIC DIVISION	—	—
CHIEF P. W. ENGR.		

APPROVED BY
DIRECTOR OF PUBLIC WORKS
DATE 9-15-77

EXTENSION OF EXISTING 24" STORM DRAIN, CROSSING CENTRAL AVENUE
1281 FT. EAST OF ~~MARION STREET~~ WILDERNESS
FOR P.M. 9523

PROJECT NO. D-322
SHEET 1 OF 1
FILE NO.
HORIZ. SCALE: 1" = 20' VERT. SCALE: 1" = 4'

JN- 1584