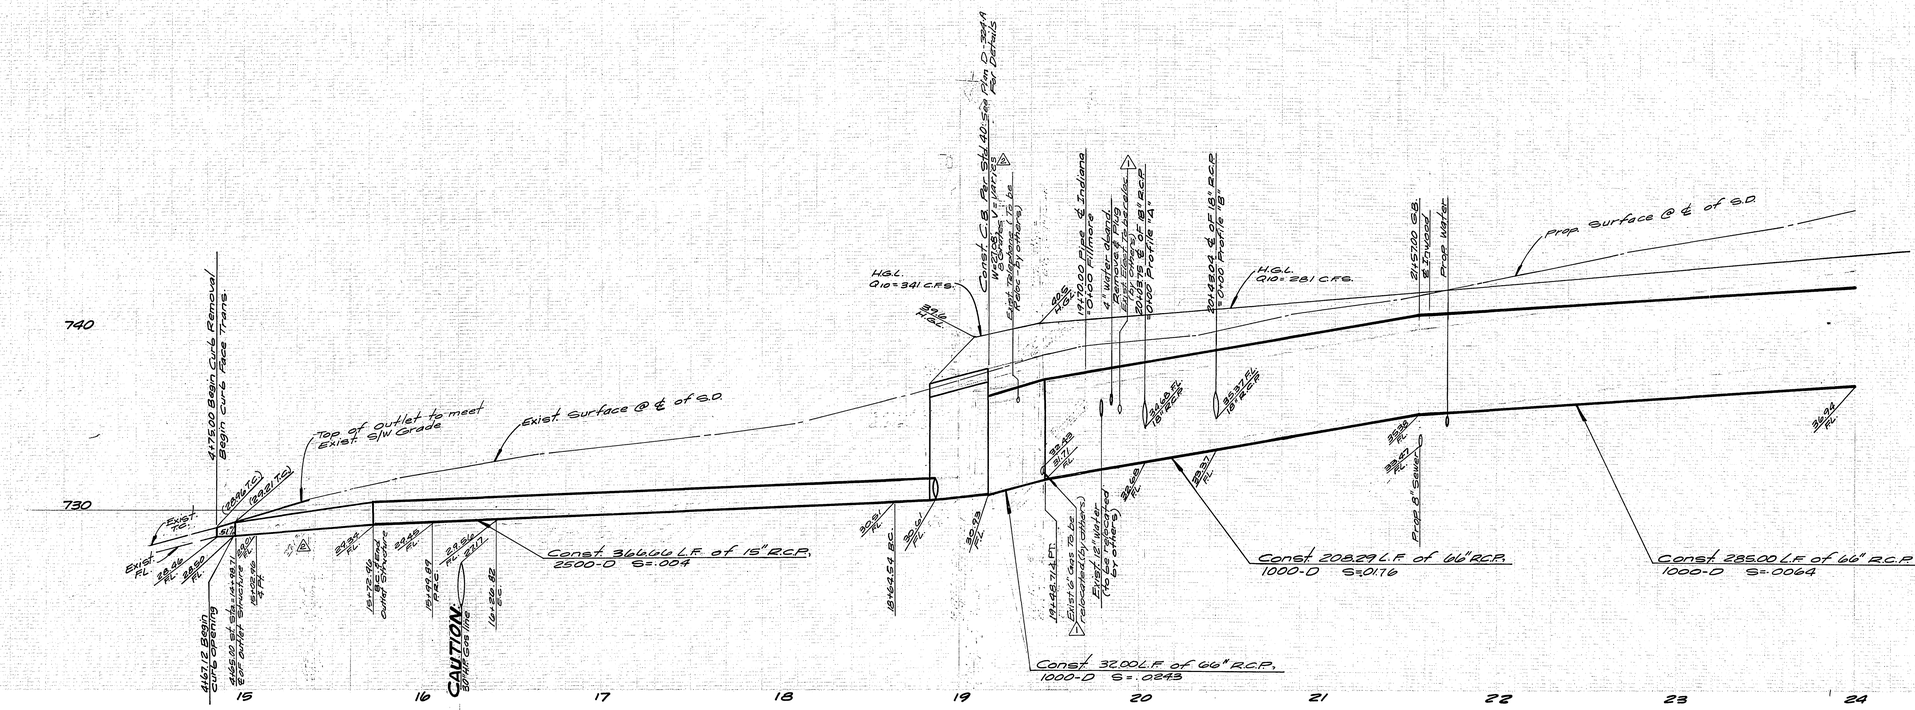
740
730
15
16
17
18
19
20
21
22
23
24
41+75.00 Begin Curb Face Trans.
Begin curb face trans.
Exist. Surface @ ℄ of S.D.
Top of outlet to meet Exist. S/W Grade
Exist. T.C.
Exist. F.L.
Const 366.66 L.F. of 15" R.C.P. 2500-D S=.004
H.G.L. Q10=341 C.F.S.
Exist. 16" Indiana Fillmore
Exist. 4" water aband. Remove & Plug (by others)
Exist. 8" Sewer Abandon (by others)
Exist. 12" Reclaimed Water (by others)
Const 32.00 L.F. of 66" R.C.P. 1000-D S=.0243
Const 208.29 L.F. of 66" R.C.P. 1000-D S=.0176
H.G.L. Q10=281 C.F.S.
Prop. Surface @ ℄ of S.D.
Prop. 8" Sewer
Const 285.00 L.F. of 66" R.C.P. 1000-D S=.0064
CAUTION: 30" H.P. GAS LINE

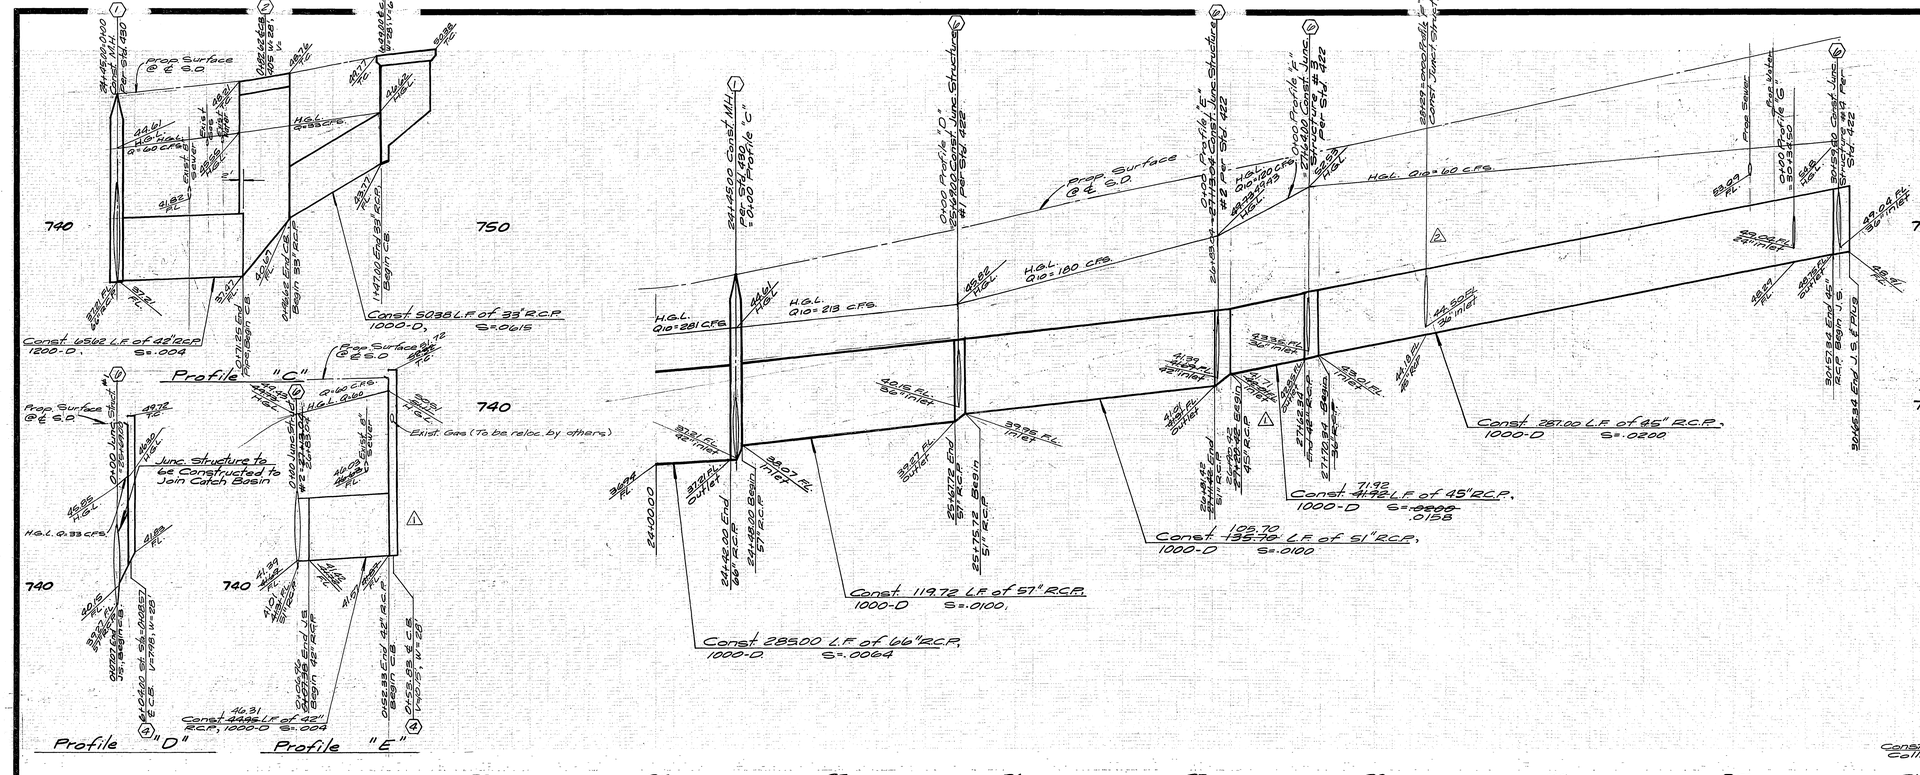

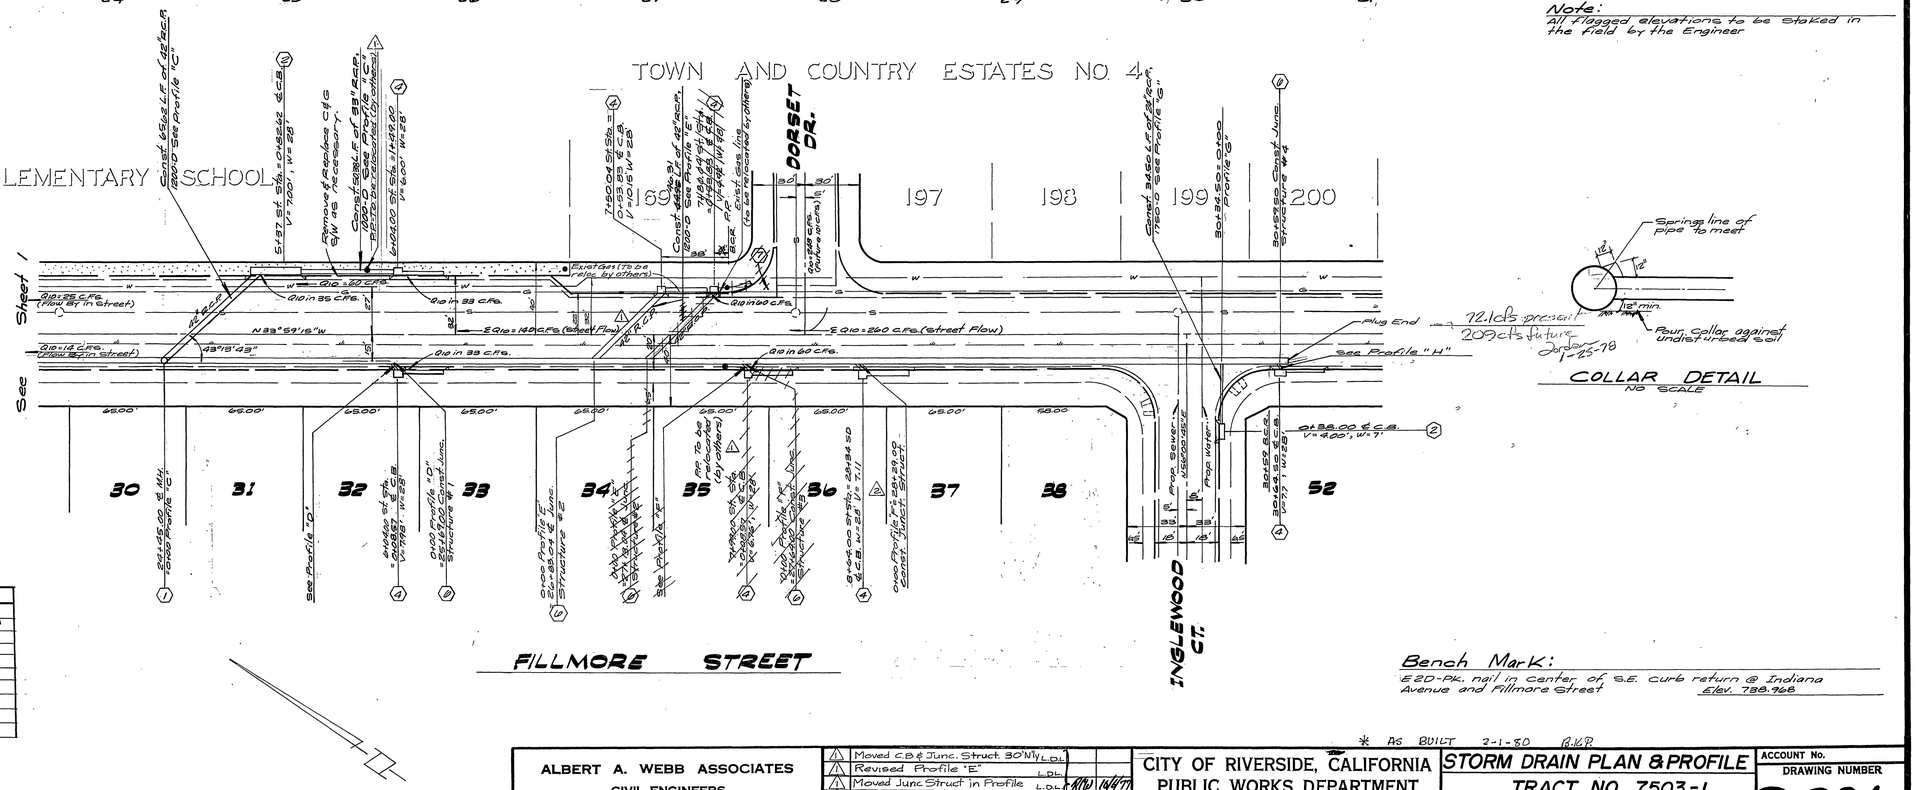

JUNCTION STRUCTURE DATA				
	Jc. #1	Jc. #2	Jc. #3	Jc. #4
A	45°00'00"	45°00'00"	45°00'00"	45°00'00"
B	36"	42"	36"	36"
C	7.07'	6.96'	7.07'	7.07'
D_1	51"	45"	36"	36"
D_2	57"	51"	45"	45"
E	6.72'	7.88'	6.34'	6.34'
L	8.00'	9.00'	8.00'	8.00'
R				
S				

Bench Mark:
E20-Pk. nail in center of S.E. Curb return @ Indiana Avenue and Fillmore Street
Elev. 738.968

Note:
All flagged elevations to be Staked in the field by the Engineer

* AS BUILT 2-1-80 RWR

PUBLIC UTILITIES DEPT. - ELECT.
Out 4-19-77

ALBERT A. WEBB ASSOCIATES
CIVIL ENGINEERS
RIVERSIDE, CALIFORNIA
APPROVED BY [signature] DATE 2/24/77
R.E. No. 27106
W.O. 76-245 FOR: Citation Housing F.B. 1039

MARK	REVISIONS	APPR.	DATE
1	Moved C.B. & Junc. Struct. 30' N'ly	LDL	
2	Revised Profile "E"	LDL	4/19/77
3	Moved Junc. Struct in Profile	LDL	4/19/77
4	Added P.P. relocation Notes	LDL	5-15-78
5	Moved C.B. & Junct. Struct to Cor	LDL	5-15-78

DESIGNED BY L.C. DRAWN BY MCBP CHECKED BY

CITY OF RIVERSIDE, CALIFORNIA
PUBLIC WORKS DEPARTMENT

	BY	DATE
APPROVED BY PRINCIPAL ENGINEER	[signature]	8/31
PARK DEPARTMENT	[signature]	8-29
TRAFFIC DIVISION		
CHIEF PUB. WKS. ENGR.		

APPROVED BY William D. Gardner DIRECTOR OF PUBLIC WORKS
DATE 8/31/77

STORM DRAIN PLAN & PROFILE
TRACT NO. 7503-1
FILLMORE STREET

SCALE: Horiz: 1"=40', Vert: 1"=4'

ACCOUNT No.
DRAWING NUMBER D-324
SHEET 2 OF 2
76-245 D