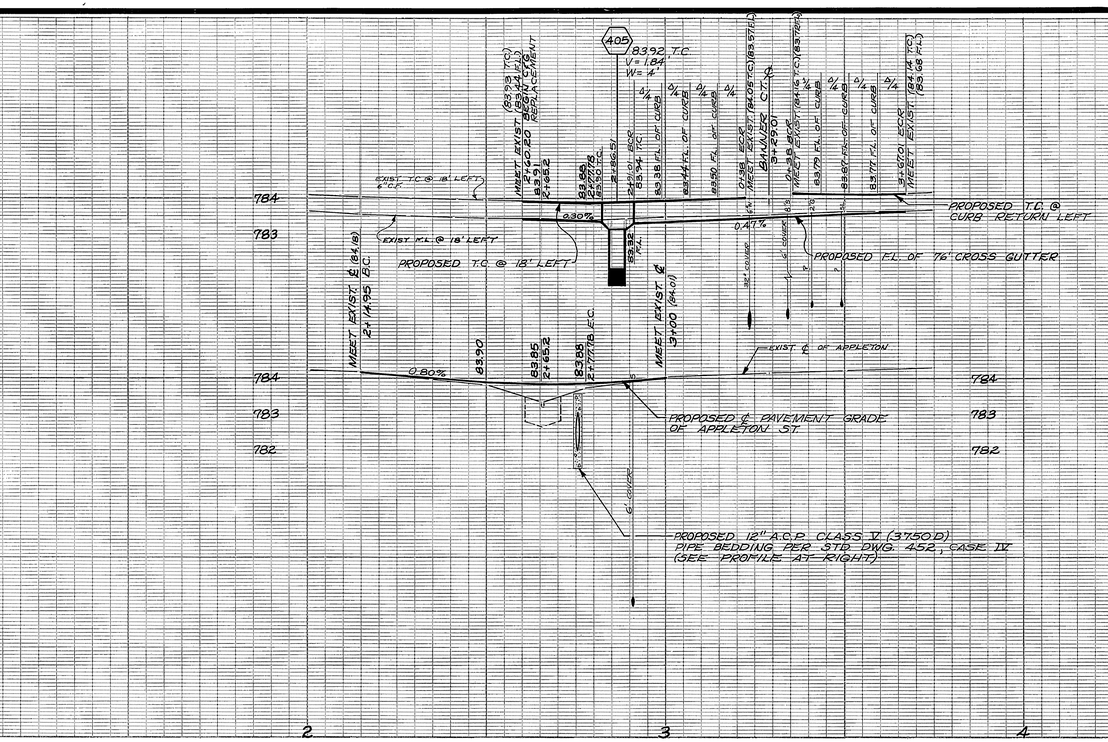

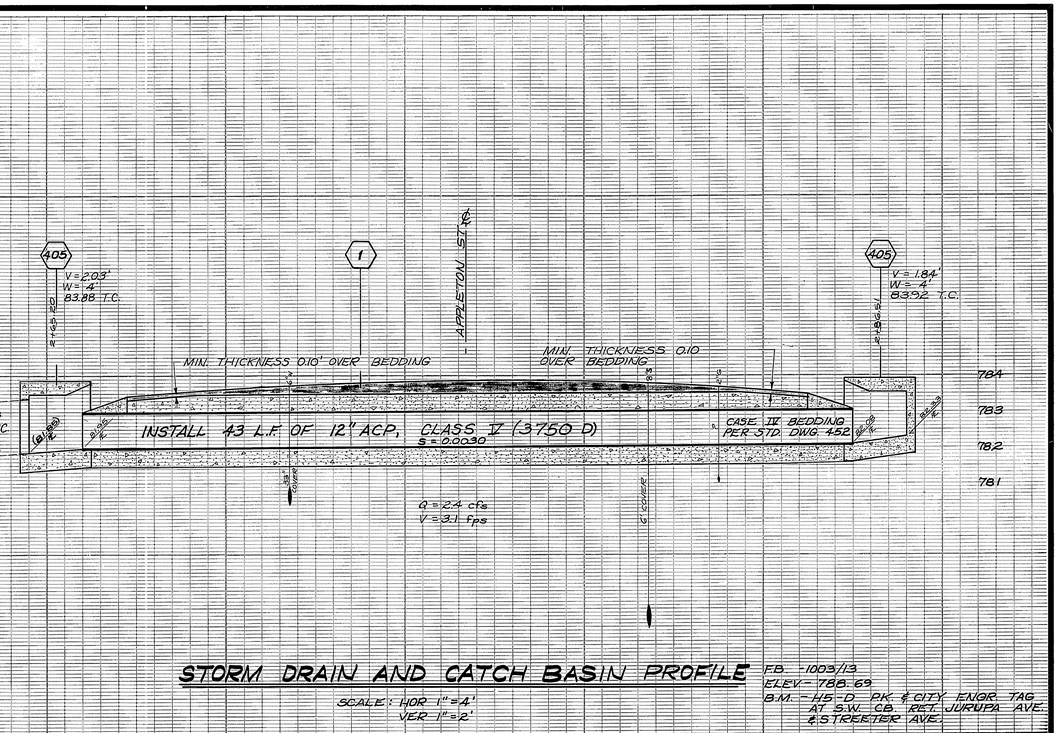

STORM DRAIN AND CATCH BASIN PROFILE

SCALE: HOR 1" = 4'
VER 1" = 2'

FB 1003/13
ELEV = 788.69
B.M. - HS-D P.K. & CITY ENGR. TAG AT S.W. CB. RET. JURUPA AVE. & STREETER AVE.

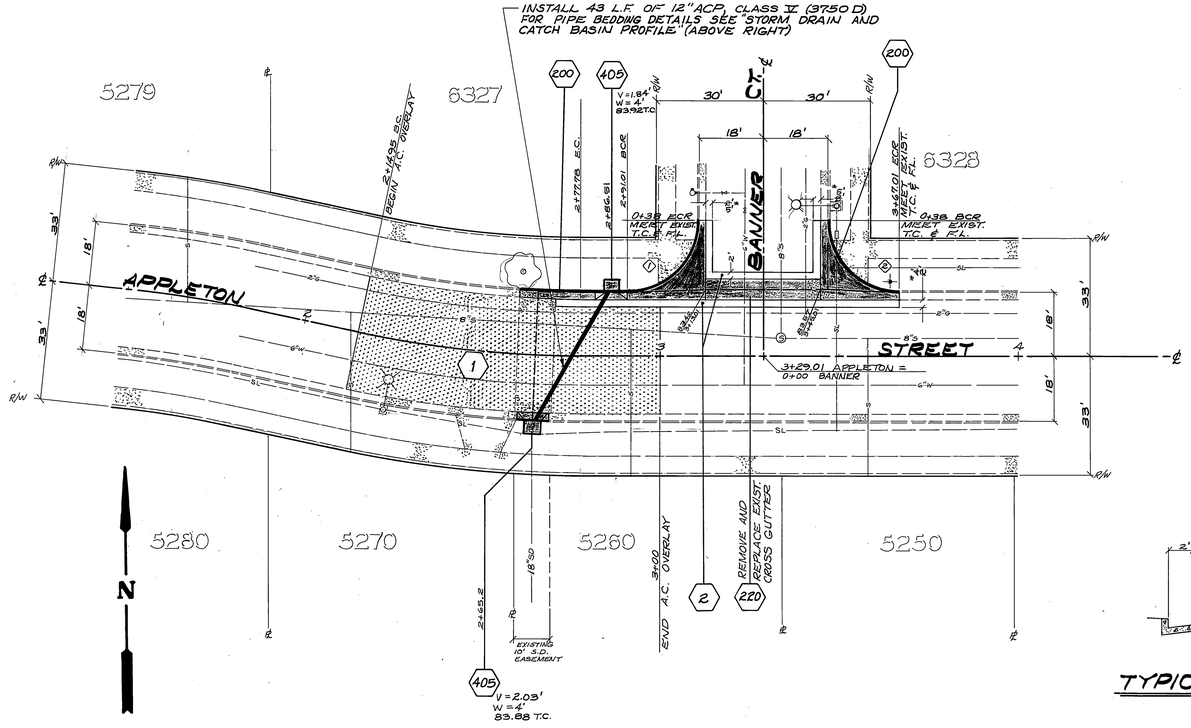

CONSTRUCTION LEGEND

CENTER LINE ——℄——
RIGHT-OF-WAY LINE ——R/W——
SUBDIVISION LOT LINE ——℄——

(1) OVERLAY EXISTING A.C. AND P.C.C. CROSS GUTTER WITH VARIABLE THICKNESS OF A.C..

(2) REMOVE 2' OF A.C. ADJACENT TO NEW CONCRETE AND REPLACE WITH 0.25' MINIMUM A.C. AS DIRECTED BY THE INSPECTOR.

SPECIFIC CONSTRUCTION NOTES

⬢ NUMBERS ABOVE 100 IN A HEXAGON ON THE PLAN REFER TO THE RESPECTIVE STANDARD DRAWING AND SHALL BE CONSTRUCTED ACCORDINGLY.

GENERAL CONSTRUCTION NOTES

(1) TOP OF CURB SHALL MATCH EXISTING SIDEWALK AND SHALL MEET AT SPECIFIED LOCATIONS AS SHOWN ON PLAN.

(2) THE EXISTING CATCH BASIN SHALL BE REMOVED AND REPLACED OR MODIFIED AT THE OPTION OF THE CONTRACTOR AND AS DIRECTED BY THE INSPECTOR.

(3) EXISTING UTILITIES, SHOWN ON PLAN, ARE PLOTTED FROM UTILITY RECORDS. THE CONTRACTOR IS REQUIRED TO TAKE DUE PRECAUTIONARY MEASURES TO LOCATE AND PROTECT ALL UTILITIES WHETHER OR NOT SHOWN ON PLAN. IF THE COVER OF A UTILITY IS KNOWN IT IS SHOWN IN THE PROFILE. UTILITIES SHOWN IN THE PROFILE AS ——T——(UTILITY NAME) INDICATES THAT COVER IS UNKNOWN, HOWEVER THE UTILITY IS NOT EXPECTED TO CONFLICT WITH PROPOSED IMPROVEMENTS.

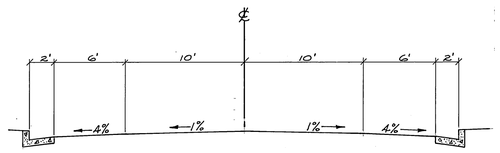

TYPICAL SECTION FOR APPLETON ST.

NO SCALE

SUPERCEDED SEE PLAN D-479 SH 2 OF 2

*AS BUILT 6-1-78 R/M

CURVE DATA

INDEX	R	Δ	T	L
1	20'	90°	20.0	31.42
2	20'	90°	20.0	31.42

MARK	REVISIONS	APPR.	DATE

DESIGNED BY GWS DRAWN BY R/M CHECKED BY RHH

CITY OF RIVERSIDE
PUBLIC WORKS DEPARTMENT

	APPROVED BY	
PRINCIPAL ENGINEER	RHH	11/11
PARK DEPARTMENT	—	—
TRAFFIC DIVISION	—	—
CHIEF P. W. ENGINEER	WLC	11-11

APPROVED BY _____ PUBLIC WORKS DIRECTOR
DATE 11-11-77

Appleton Street Storm Drain

Banner Court to 65' West

ACCOUNT NO. 09-573-410
T.E. D-327
SHEET 1 OF 1
FILE NO.
HORIZ. SCALE: 1" = 20' VERT. SCALE: 1" = 2'