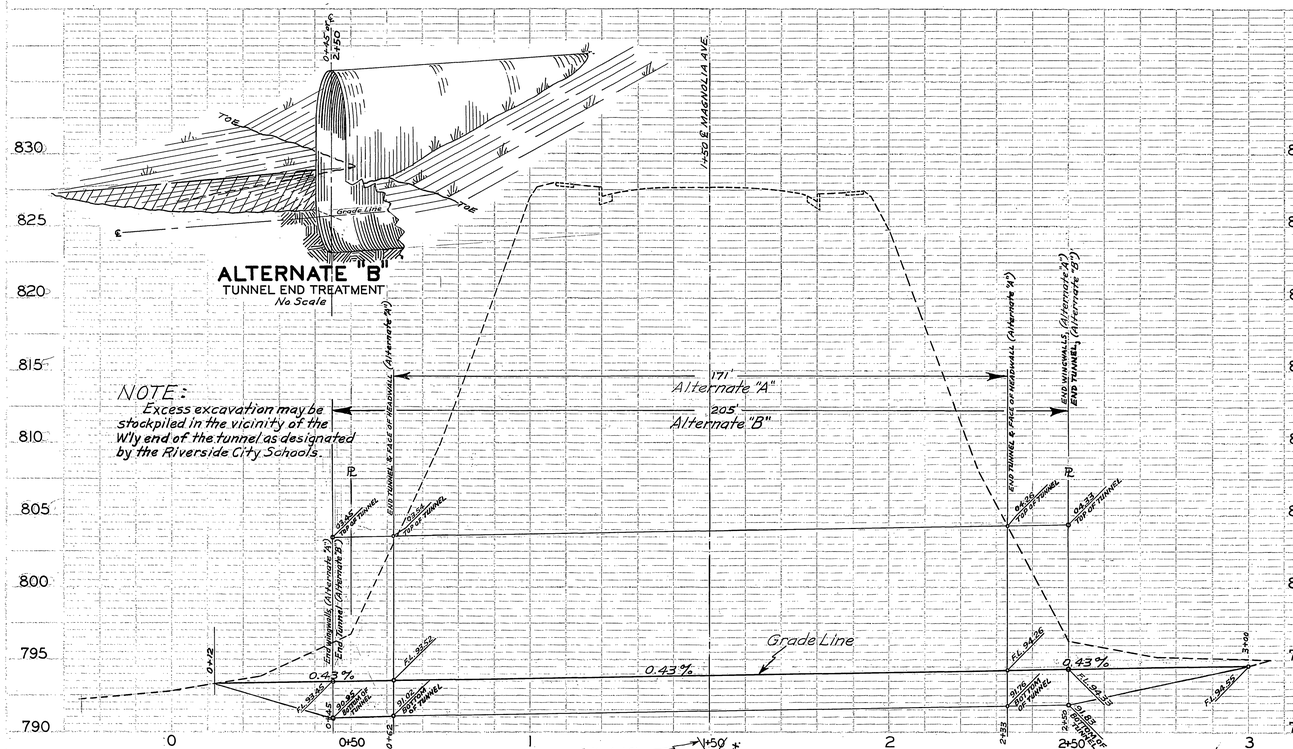

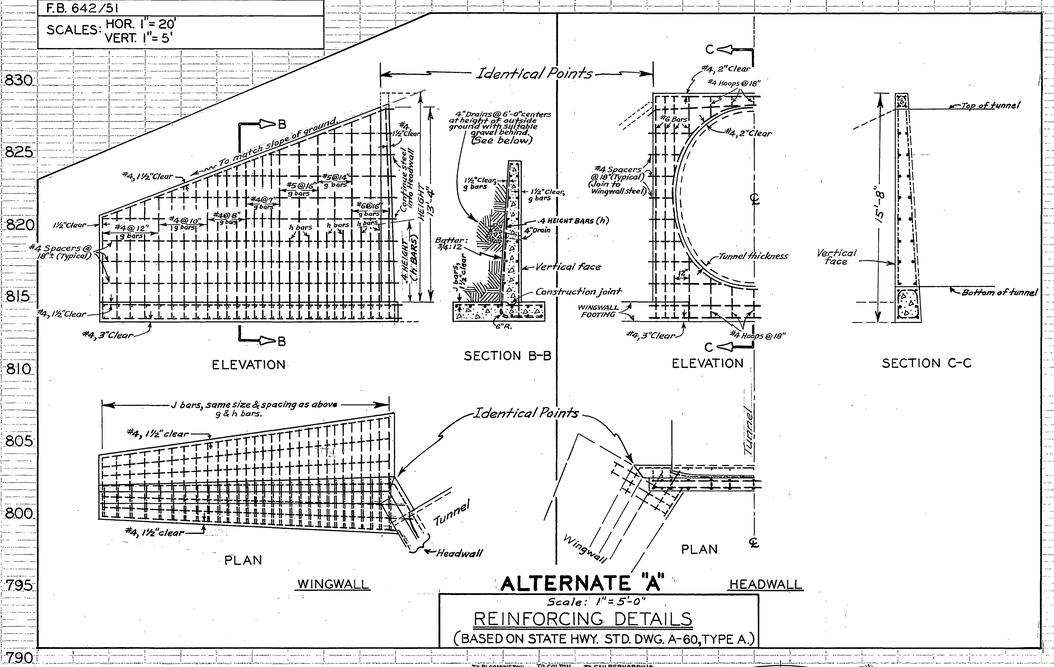

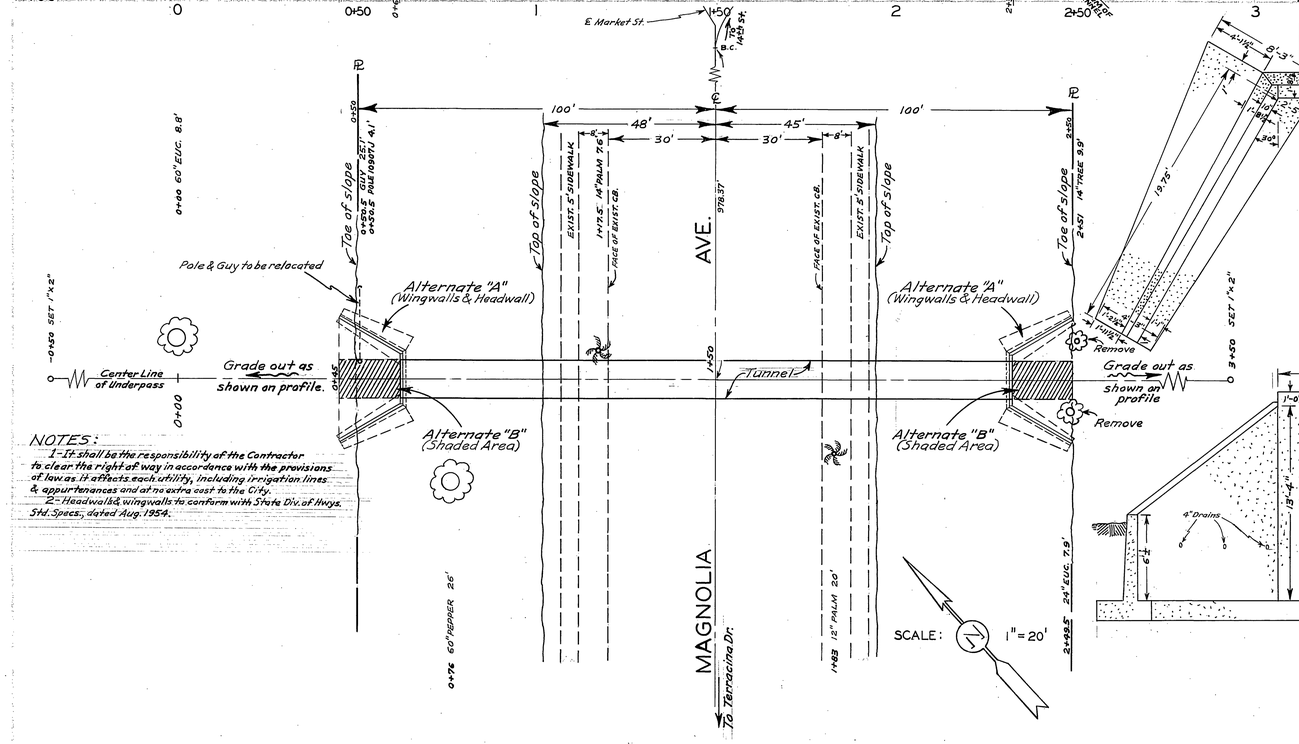

NOTES:
1- It shall be the responsibility of the Contractor to clear the right of way in accordance with the provisions of law as it affects each utility, including irrigation lines & appurtenances and at no extra cost to the City.
2- Headwalls & wingwalls to conform with State Div. of Hwys. Std. Specs., dated Aug. 1954.

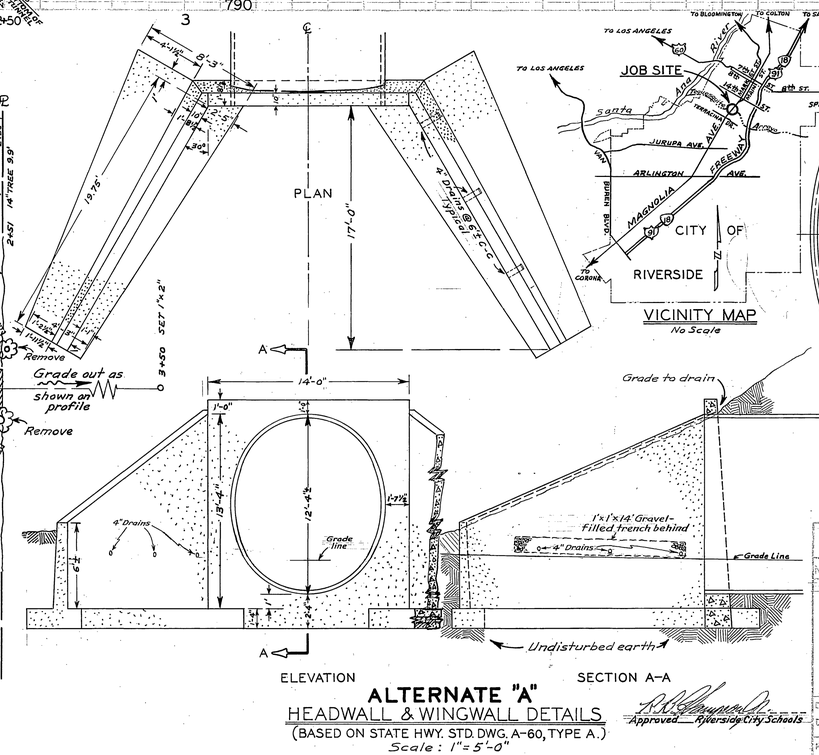

ALTERNATE "A"
HEADWALL & WINGWALL DETAILS
(BASED ON STATE HWY. STD. DWG. A-60, TYPE A.)
Scale: 1"= 5'-0"

Approved Riverside City Schools

VICINITY MAP
No Scale

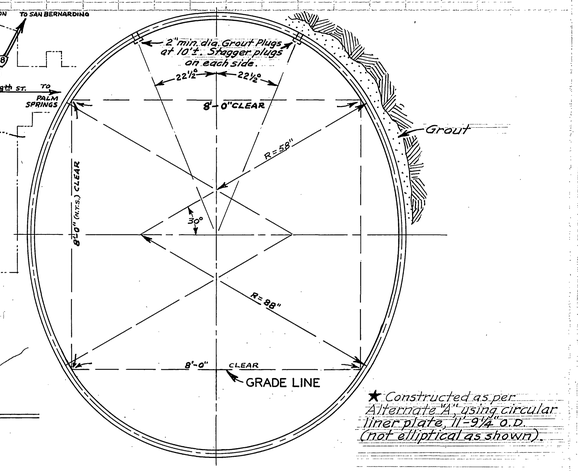

TUNNEL SECTION
Scale: 1"= 2'-0"

★ Constructed as per Alternate "A" using circular liner plate, 11'-9¼" O.D. (not elliptical as shown).

REVISIONS		
MARK	DATE	DESCRIPTION
★	1960	"As Built" H. Ball

CITY OF RIVERSIDE CALIFORNIA
DEPARTMENT OF PUBLIC WORKS

MAGNOLIA AVENUE UNDERPASS
AT POLYTECHNIC HIGH SCHOOL

DESIGNED BY H.B., W.D.G. CHECKED BY wdg
DRAWN BY H. Ball
RECOMMENDED BY Francis F. Lefebvre ASSISTANT CITY ENGINEER
APPROVED BY [signature] DIRECTOR OF PUBLIC WORKS
DATE May 6, 1959

D-35
SHEET 1 OF 1

INDEXED