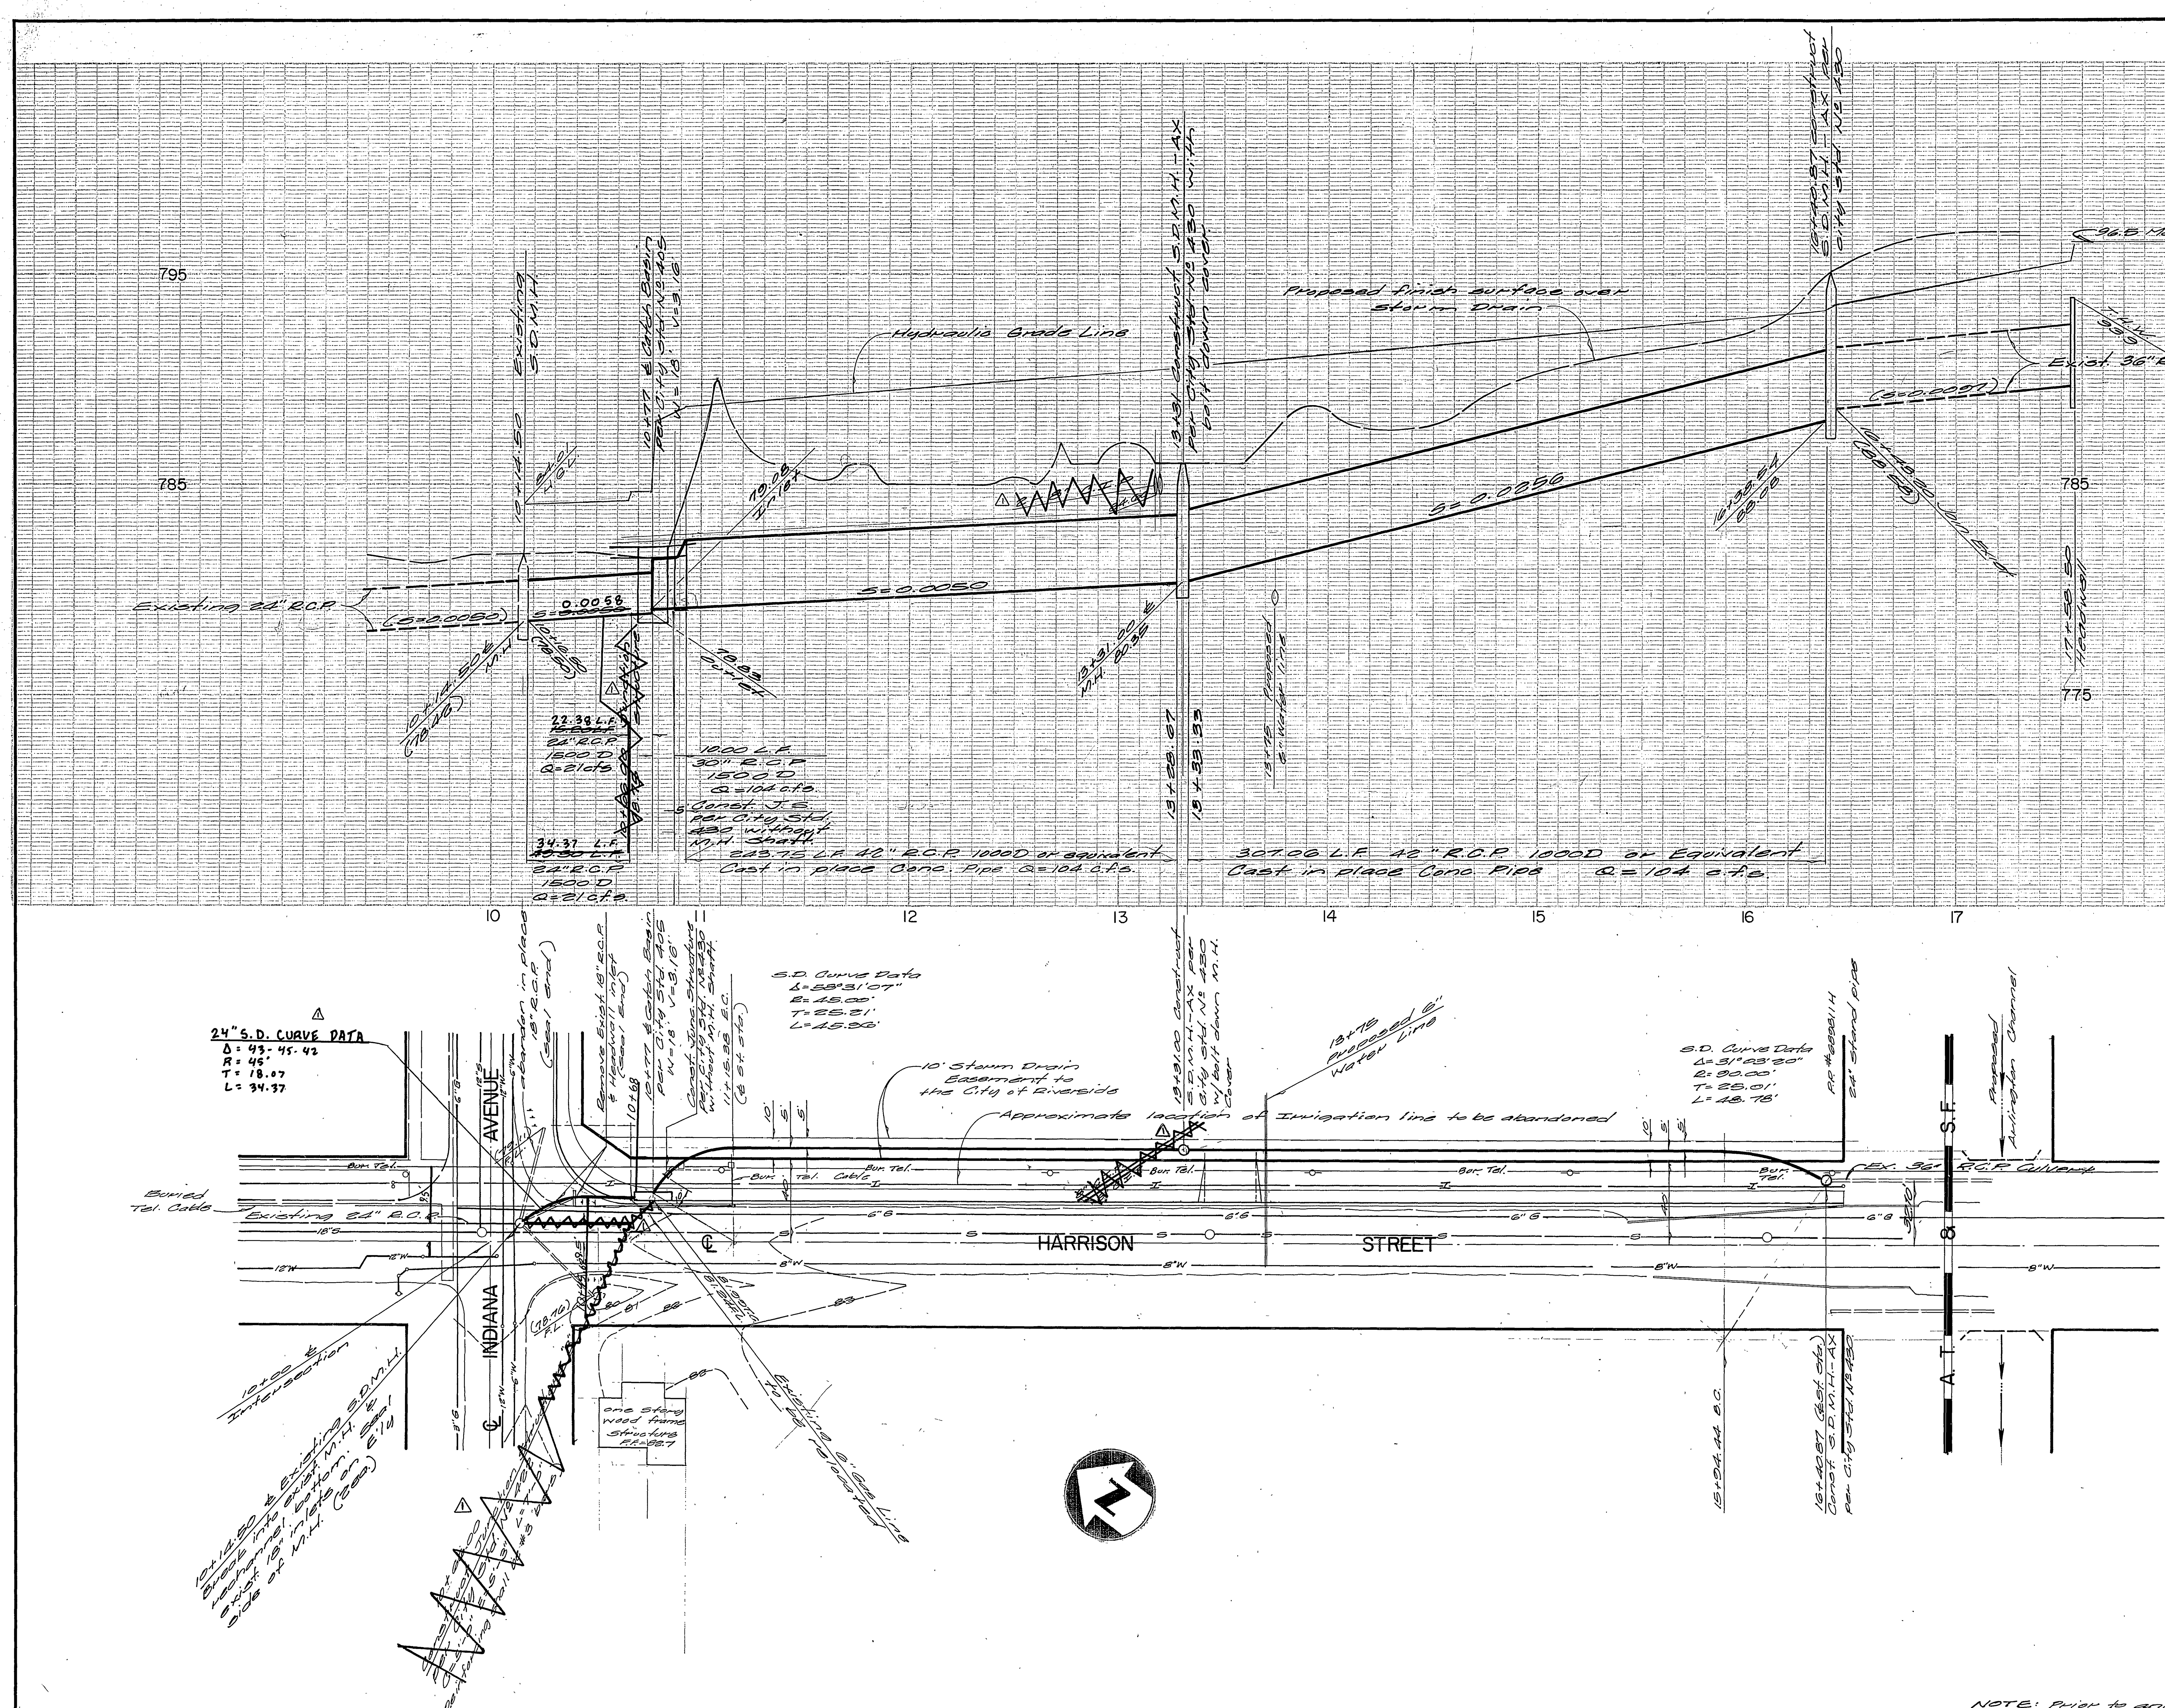

BENCH MARK

B.M. No 601-24-68, Bronze disc in conc. post stamped "Centerline Harrison Street Cul-de-sac" set in metal well on centerline of Harrison Street 137.5' Northwest of Indiana Avenue. Elevation = 780.018

GENERAL NOTES

1. Construction shall be in accordance with the "Standard Specifications for Public Works Construction" 1976 edition and the City of Riverside Standard Drawings.
2. It shall be the responsibility of the Contractor to clear the Right of Way in accordance with the provisions of the law as it effects each utility including irrigation lines and appurtenances and at no cost to the city.
3. The Private Engineer signing these plans is responsible for assuring the accuracy and acceptability of the work hereon. In the event of descrepancies arising during construction as a result of errors & omissions, the private engineer is responsible for determining an acceptable solution and revising the plans for approval by the City.

NOTE: Prior to any construction of U.G. pipelines, Contractor shall verify the location & depth of all existing U.G. facilities which may affect the proposed construction.

SOUTHERN CALIFORNIA GAS CO. APPROVED BY	PACIFIC TELEPHONE COMPANY APPROVED BY	CITY OF RIVERSIDE DOMESTIC SYSTEM	CITY OF RIVERSIDE OVERHEAD & UNDERGROUND
OR M. Gowan	Jon Fellman	Fred Lantz FOR CHIEF UTILITIES ENGINEER - WATER	For [signature] CHIEF UTILITIES ENGINEER - ELECTRIC
DATE 7/17/78	DATE 7/19/78	DATE 7/12/78	DATE July 17, 1978

WES ENGINEERING COMPANY
Public Works • Land Development • Planning
3272 North E Street, Suite D
San Bernardino, California 92405
714/883-8663

William E. Snell, R.C.E. 19452 — Date 8-3-77

MARK	REVISION	APPR.	DATE
⚠	Revise 24" RCP Alignment / Eliminate drain Pipe	KHK	4/3/85

DESIGNED BY A.E. DRAWN BY ____ CHECKED BY L.B.G.

*As built 2-11-87 TE

CITY OF RIVERSIDE, CALIFORNIA
PUBLIC WORKS DEPARTMENT

APPROVED BY	BY	DATE
PRINCIPAL ENGINEER		
PARK DEPARTMENT	CK	7/20/78
TRAFFIC DIVISION		
CHIEF PUB. WKS. ENGR.		

APPROVED BY William D. Gardner for DIRECTOR OF PUBLIC WORKS
DATE 8-15-78

PLAN & PROFILE

HARRISON STREET STORM DRAIN

PARCEL MAP NO. 9461

SCALE: Horiz: 1"=40' Vert: 1"=4'

ACCOUNT No.
DRAWING NUMBER D-362
SHEET 1 OF 1