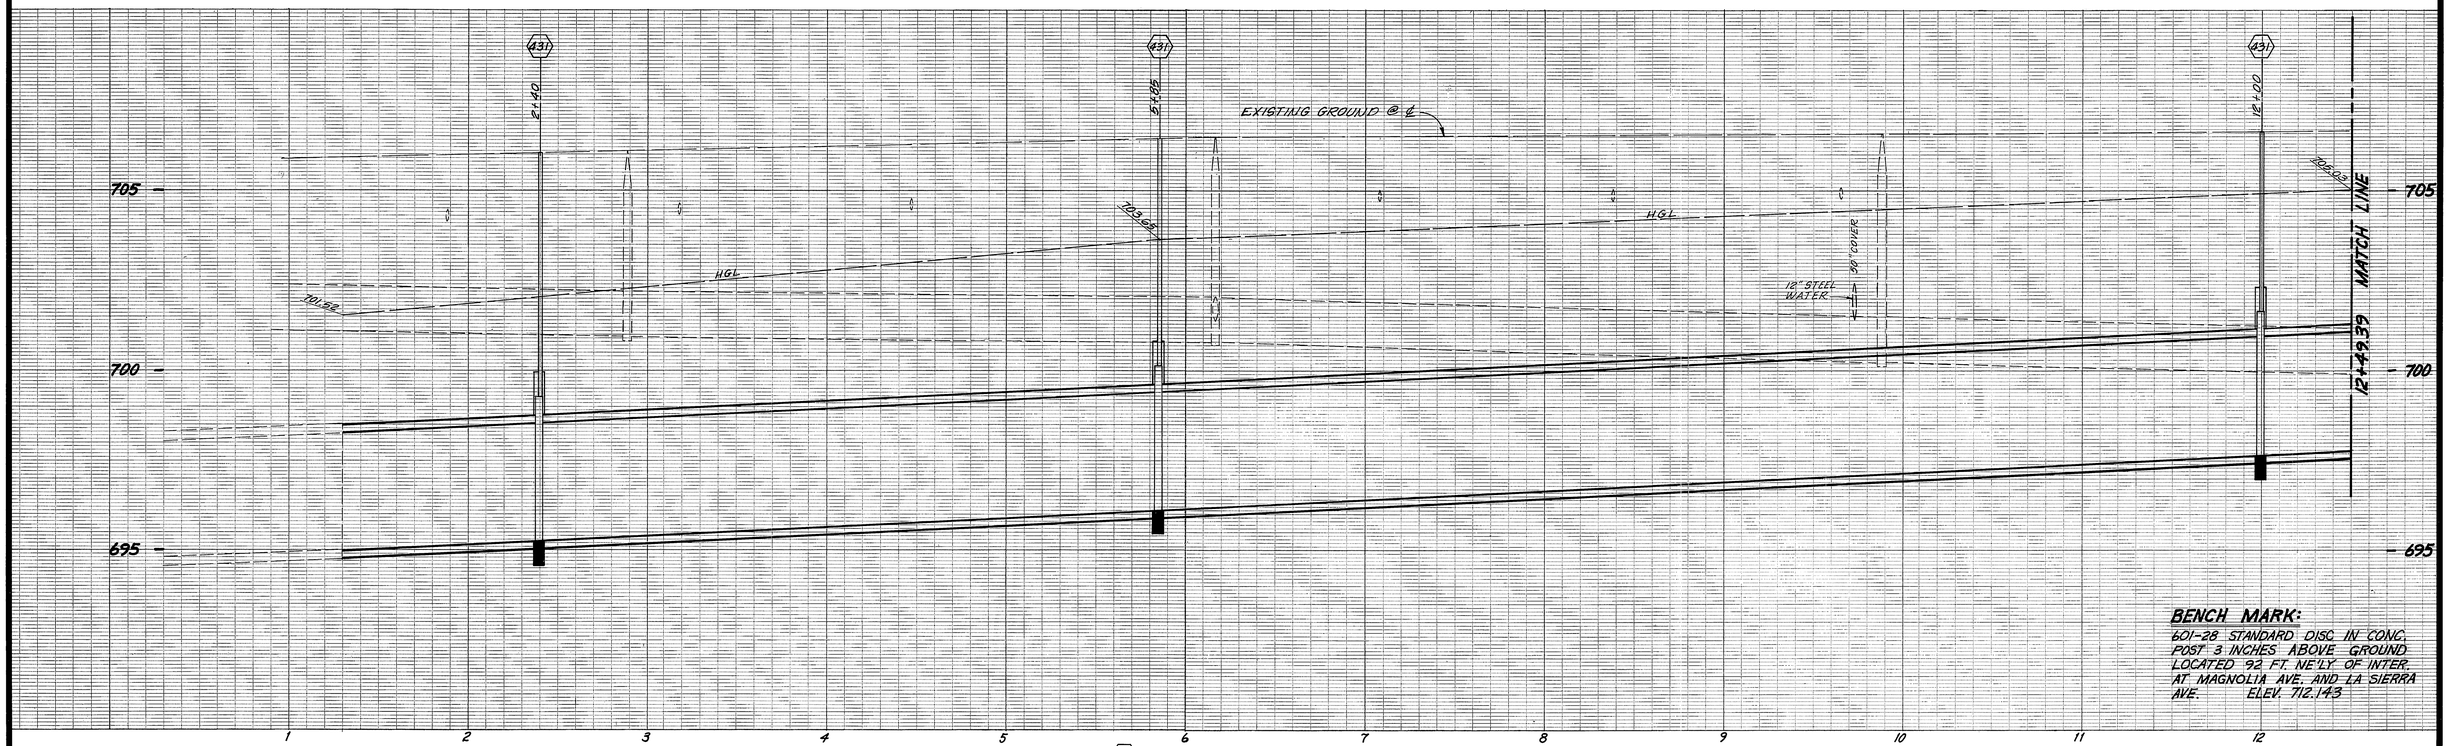

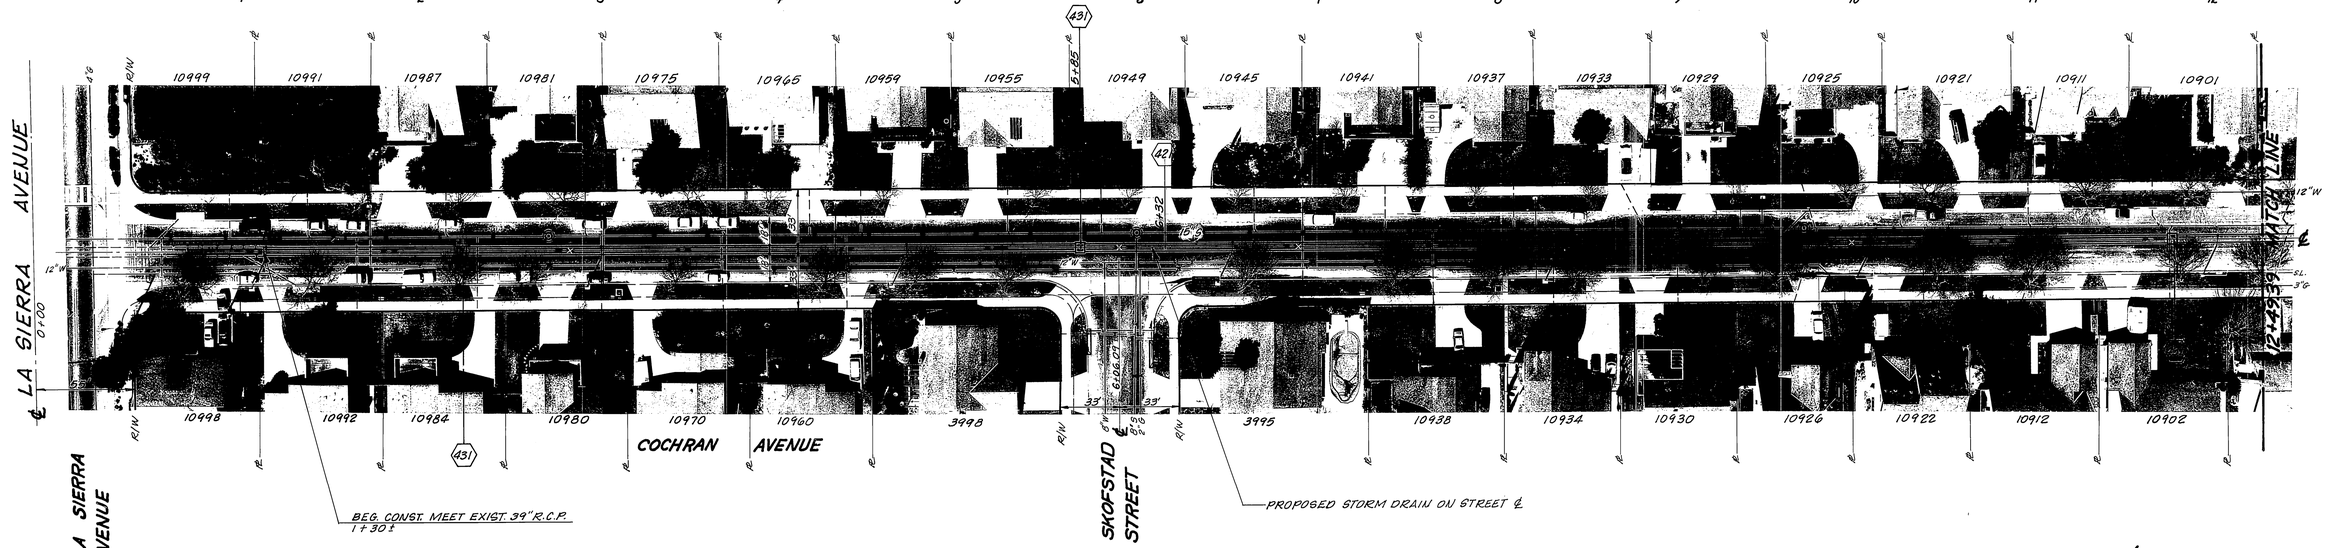

BENCH MARK:

601-28 STANDARD DISC IN CONC. POST 3 INCHES ABOVE GROUND LOCATED 92 FT. NE'LY OF INTER. AT MAGNOLIA AVE. AND LA SIERRA AVE. ELEV. 712.143

CONSTRUCTION NOTES

1. CONSTRUCTION SHALL BE IN ACCORDANCE WITH STANDARD SPECIFICATIONS FOR PUBLIC WORKS CONSTRUCTION, 1976 EDITION AND THE CITY OF RIVERSIDE STANDARD DRAWINGS.

CONSTRUCTION LEGEND

- (200) CONST. CURB & GUTTER PER STD. DWG. NO. 200.
- (304) CONST. WHEELCHAIR RAMP PER STD. DWG. NO. 304.
- (325) CONST. SIDEWALK PER STD. DWG. NO. 325.
- (405) CONST. CATCH BASIN PER STD. DWG. NO. 405.
- (406) CONST. CATCH BASIN PER STD. DWG. NO. 406.
- (421) CONST. JUNCTION STRUCTURE PER STD. DWG. NO. 421.
- (431) CONST. MANHOLE PER STD. DWG. NO. 431.

N

Not Built

MARK	REVISIONS	APPR.	DATE

DESIGNED BY ____ DRAWN BY R.C. CHECKED BY ____

CITY OF RIVERSIDE
PUBLIC WORKS DEPARTMENT

APPROVED BY	
PRINCIPAL ENGINEER	
PARK DEPARTMENT	
TRAFFIC DIVISION	
CHIEF P. W. ENGINEER	

APPROVED BY
PUBLIC WORKS DIRECTOR
DATE

COCHRAN AVENUE STORM DRAIN

IN COCHRAN AVENUE, BETWEEN LA SIERRA AVENUE AND WESTERLY OF CARRICK STREET

HORIZ. SCALE: 1" - 40 VERT. SCALE: 1" - 2'

ACCOUNT NO. 09-573-421

D-363

SHEET 1 OF 3

FILE NO.

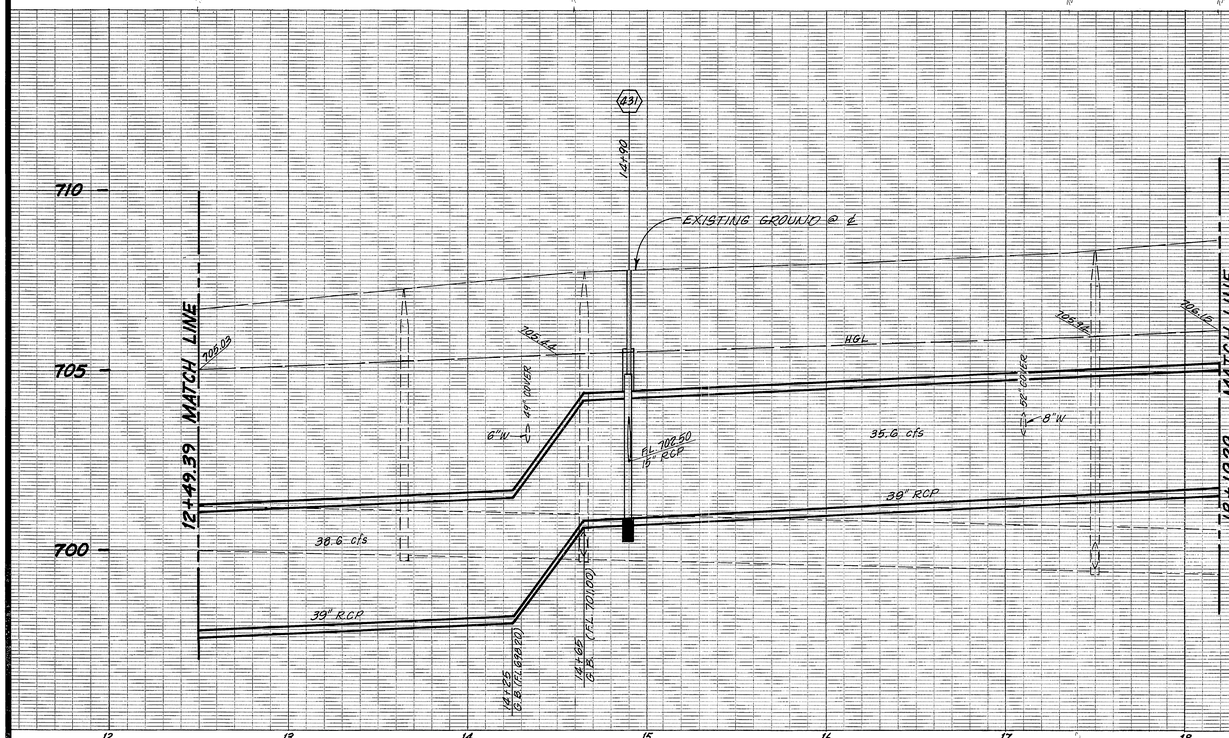

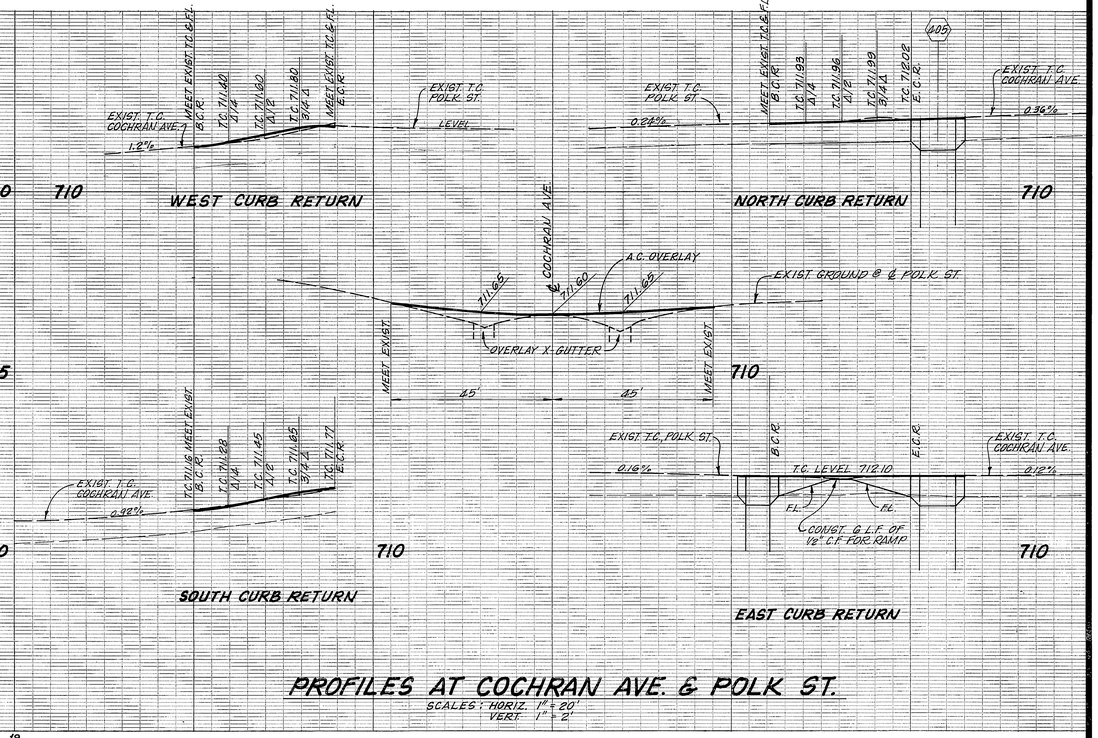

PROFILES AT COCHRAN AVE. & POLK ST.

SCALES: HORIZ. 1" = 20'
VERT. 1" = 2'

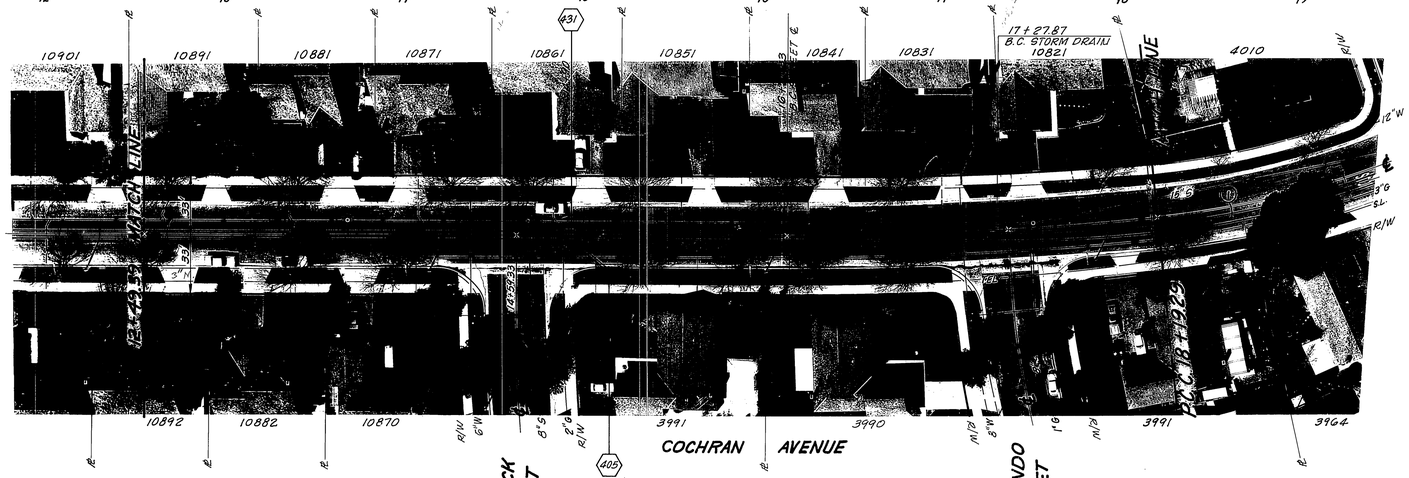

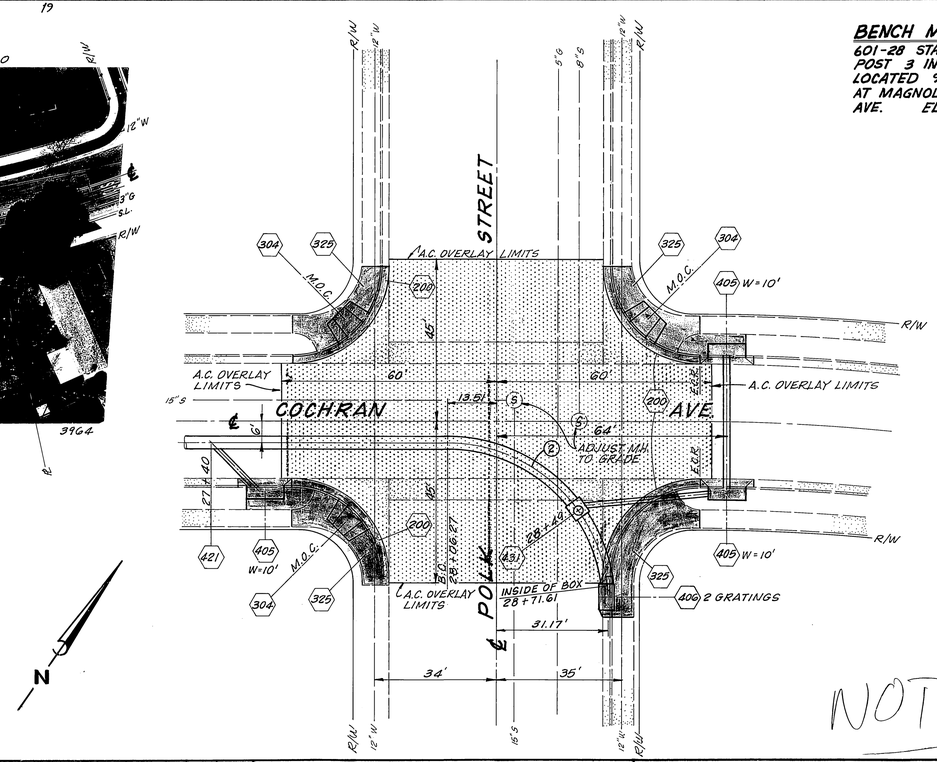

BENCH MARK:
601-28 STANDARD DISC IN CONC. POST 3 INCHES ABOVE GROUND LOCATED 92 FT. NE'LY OF INTER. AT MAGNOLIA AVE. AND LA SIERRA AVE. ELEV. 712.143

NOT BUILT

CURVE DATA

	R	Δ	L	T
①	888.62'	5°53'40"	91.42'	45.75'
②	45'	83°11'56"	65.34'	39.95'

MARK REVISIONS APPR. DATE

DESIGNED BY ____ DRAWN BY R.C. CHECKED BY ____

CITY OF RIVERSIDE
PUBLIC WORKS DEPARTMENT

APPROVED BY	
PRINCIPAL ENGINEER	
PARK DEPARTMENT	
TRAFFIC DIVISION	
CHIEF P. W. ENGINEER	

APPROVED BY
PUBLIC WORKS DIRECTOR
DATE ____

COCHRAN AVENUE STORM DRAIN

IN COCHRAN AVENUE, FROM WESTERLY OF CARRICK STREET TO WESTERLY OF JONES AVE.

HORIZ. SCALE: 1" - 40' VERT. SCALE: 1" - 2'

ACCOUNT NO. 09-573-421

D-363

SHEET 2 OF 3

FILE NO.

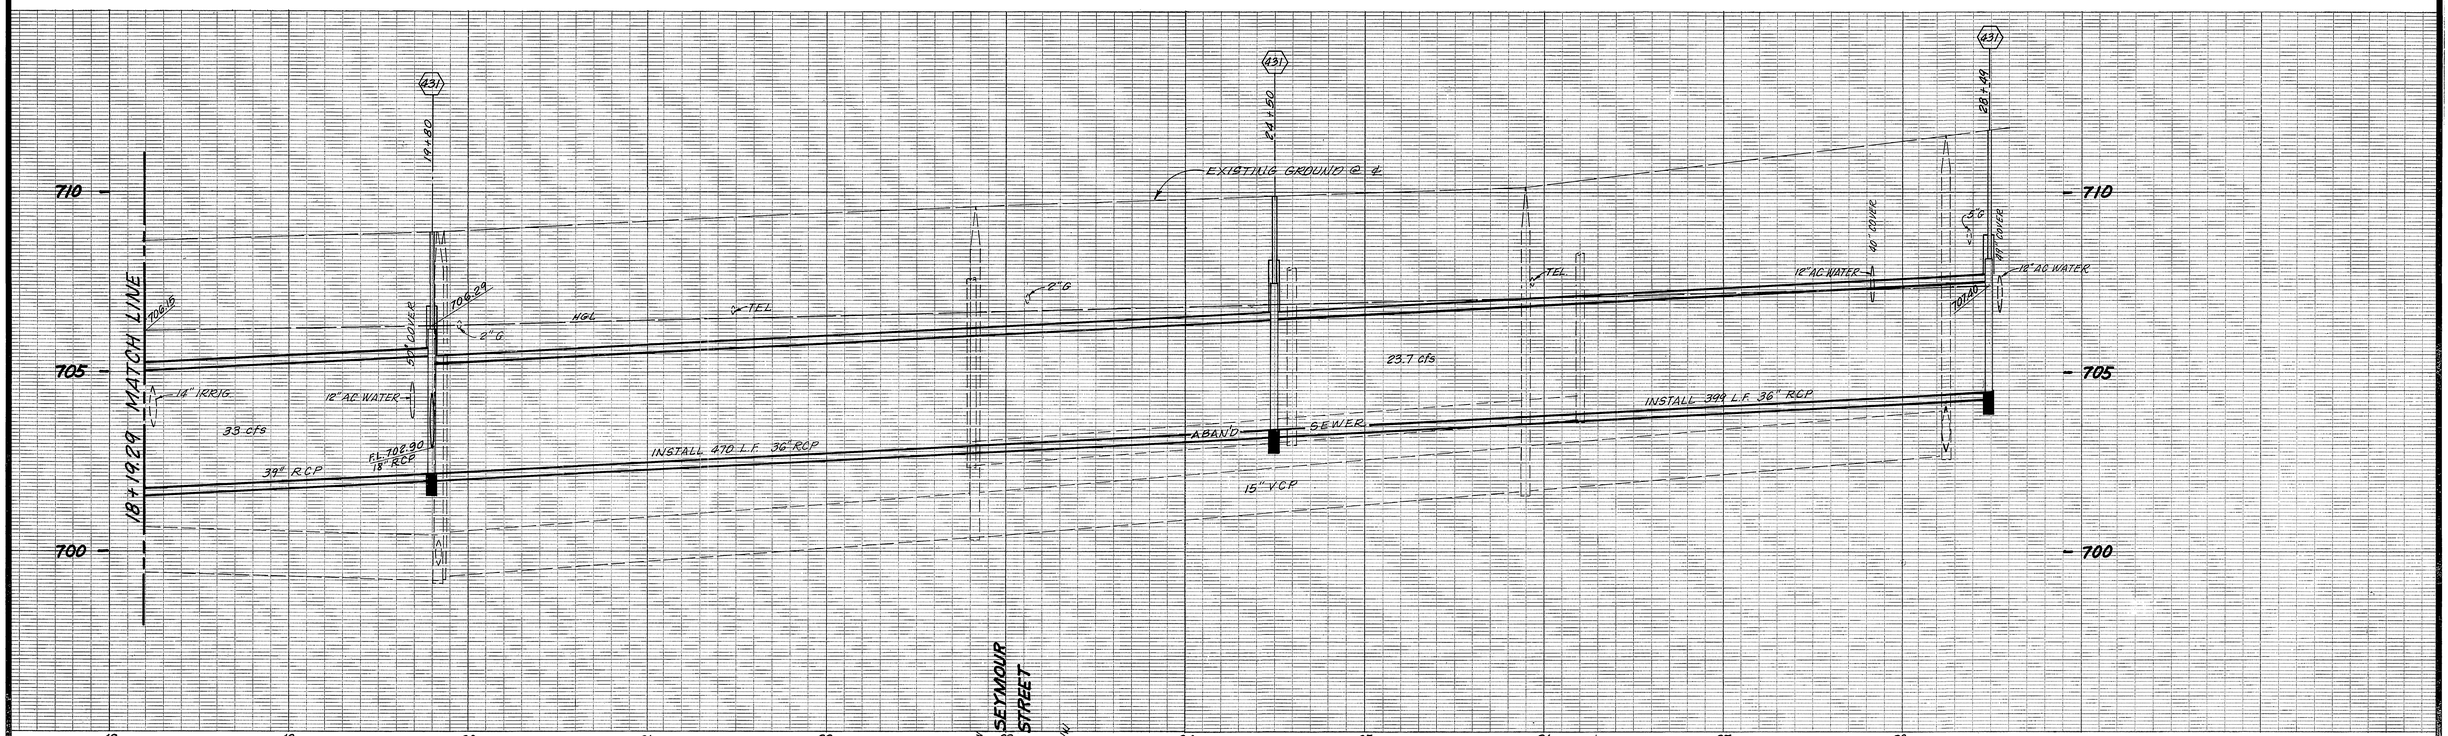

BENCH MARK:
601-28 STANDARD DISC IN CONC. POST 3 INCHES ABOVE GROUND LOCATED 92 FT. NE'LY OF INTER. AT MAGNOLIA AVE. AND LA SIERRA AVE. ELEV. 712.143

NOT BUILT

CURVE DATA				
	R	Δ	L	T
①	506'	41°11'10"	363.73'	190.12'
②	494'	47°05'35"	406.03'	215.27'
③	45'			

MARK REVISIONS APPR. DATE

DESIGNED BY ____ DRAWN BY R.C. CHECKED BY ____

CITY OF RIVERSIDE
PUBLIC WORKS DEPARTMENT

APPROVED BY
PRINCIPAL ENGINEER
PARK DEPARTMENT
TRAFFIC DIVISION
CHIEF P. W. ENGINEER

APPROVED BY
PUBLIC WORKS DIRECTOR
DATE ____

COCHRAN AVENUE STORM DRAIN

IN COCHRAN AVENUE, FROM WESTERLY OF JONES AVENUE TO POLK STREET

HORIZ. SCALE: 1" - 40' VERT. SCALE: 1" - 2'

ACCOUNT NO. 09-573-421

D-363

SHEET 3 OF 3

FILE NO.

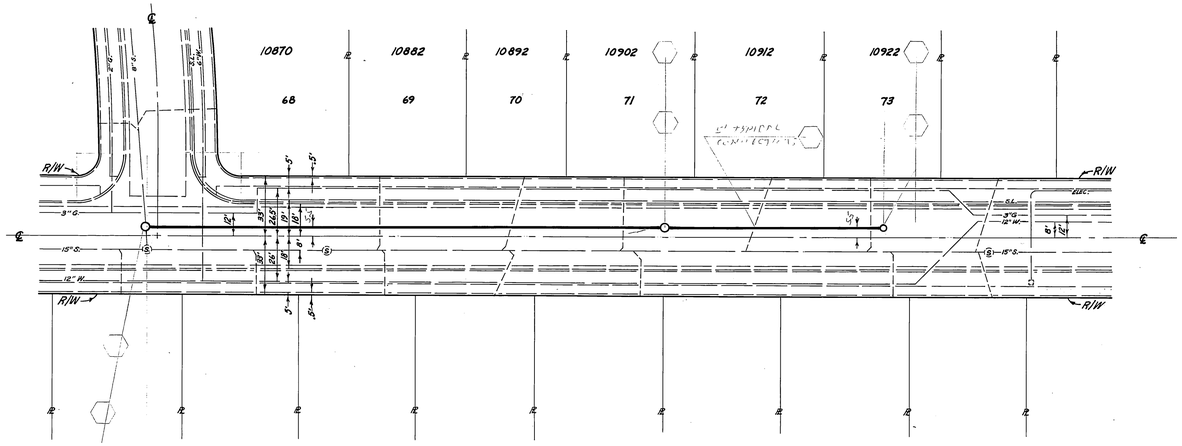

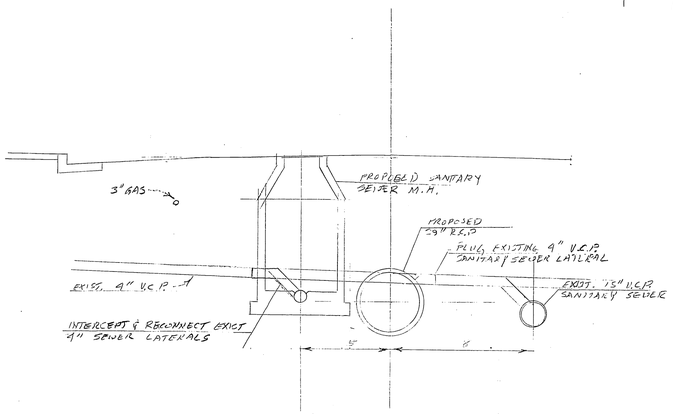

GENERAL CONSTRUCTION NOTES

1. CONSTRUCTION SHALL BE IN ACCORDANCE WITH STANDARD SPECIFICATION FOR PUBLIC WORKS CONSTRUCTION, 1976 EDITION AND CITY OF RIVERSIDE STANDARD DRAWINGS.

(500) CONSTRUCT SEWER MANHOLE PER STD. DWG. NO. 500.

(562) JOIN HOUSE LATERAL TO NEW SEWER LINE PER STD. DWG. NO. 562.

(560) CONSTRUCT SEWER CLEANOUT PER STD. DWG. NO. 560.

MARK	REVISIONS	APPR.	DATE

DESIGNED BY____ DRAWN BY____ CHECKED BY____

CITY OF RIVERSIDE
PUBLIC WORKS DEPARTMENT

APPROVED BY	
PRINCIPAL ENGINEER	
PARK DEPARTMENT	
TRAFFIC DIVISION	
CHIEF P. W. ENGINEER	

APPROVED BY

PUBLIC WORKS DIRECTOR

DATE ____

Cochran Ave
Storm Drain
Sewer Relocation

HORIZ. SCALE: 1" - VERT. SCALE: 1" -

ACCOUNT NO.
file with D-363

SHEET ____ OF 2

FILE NO.