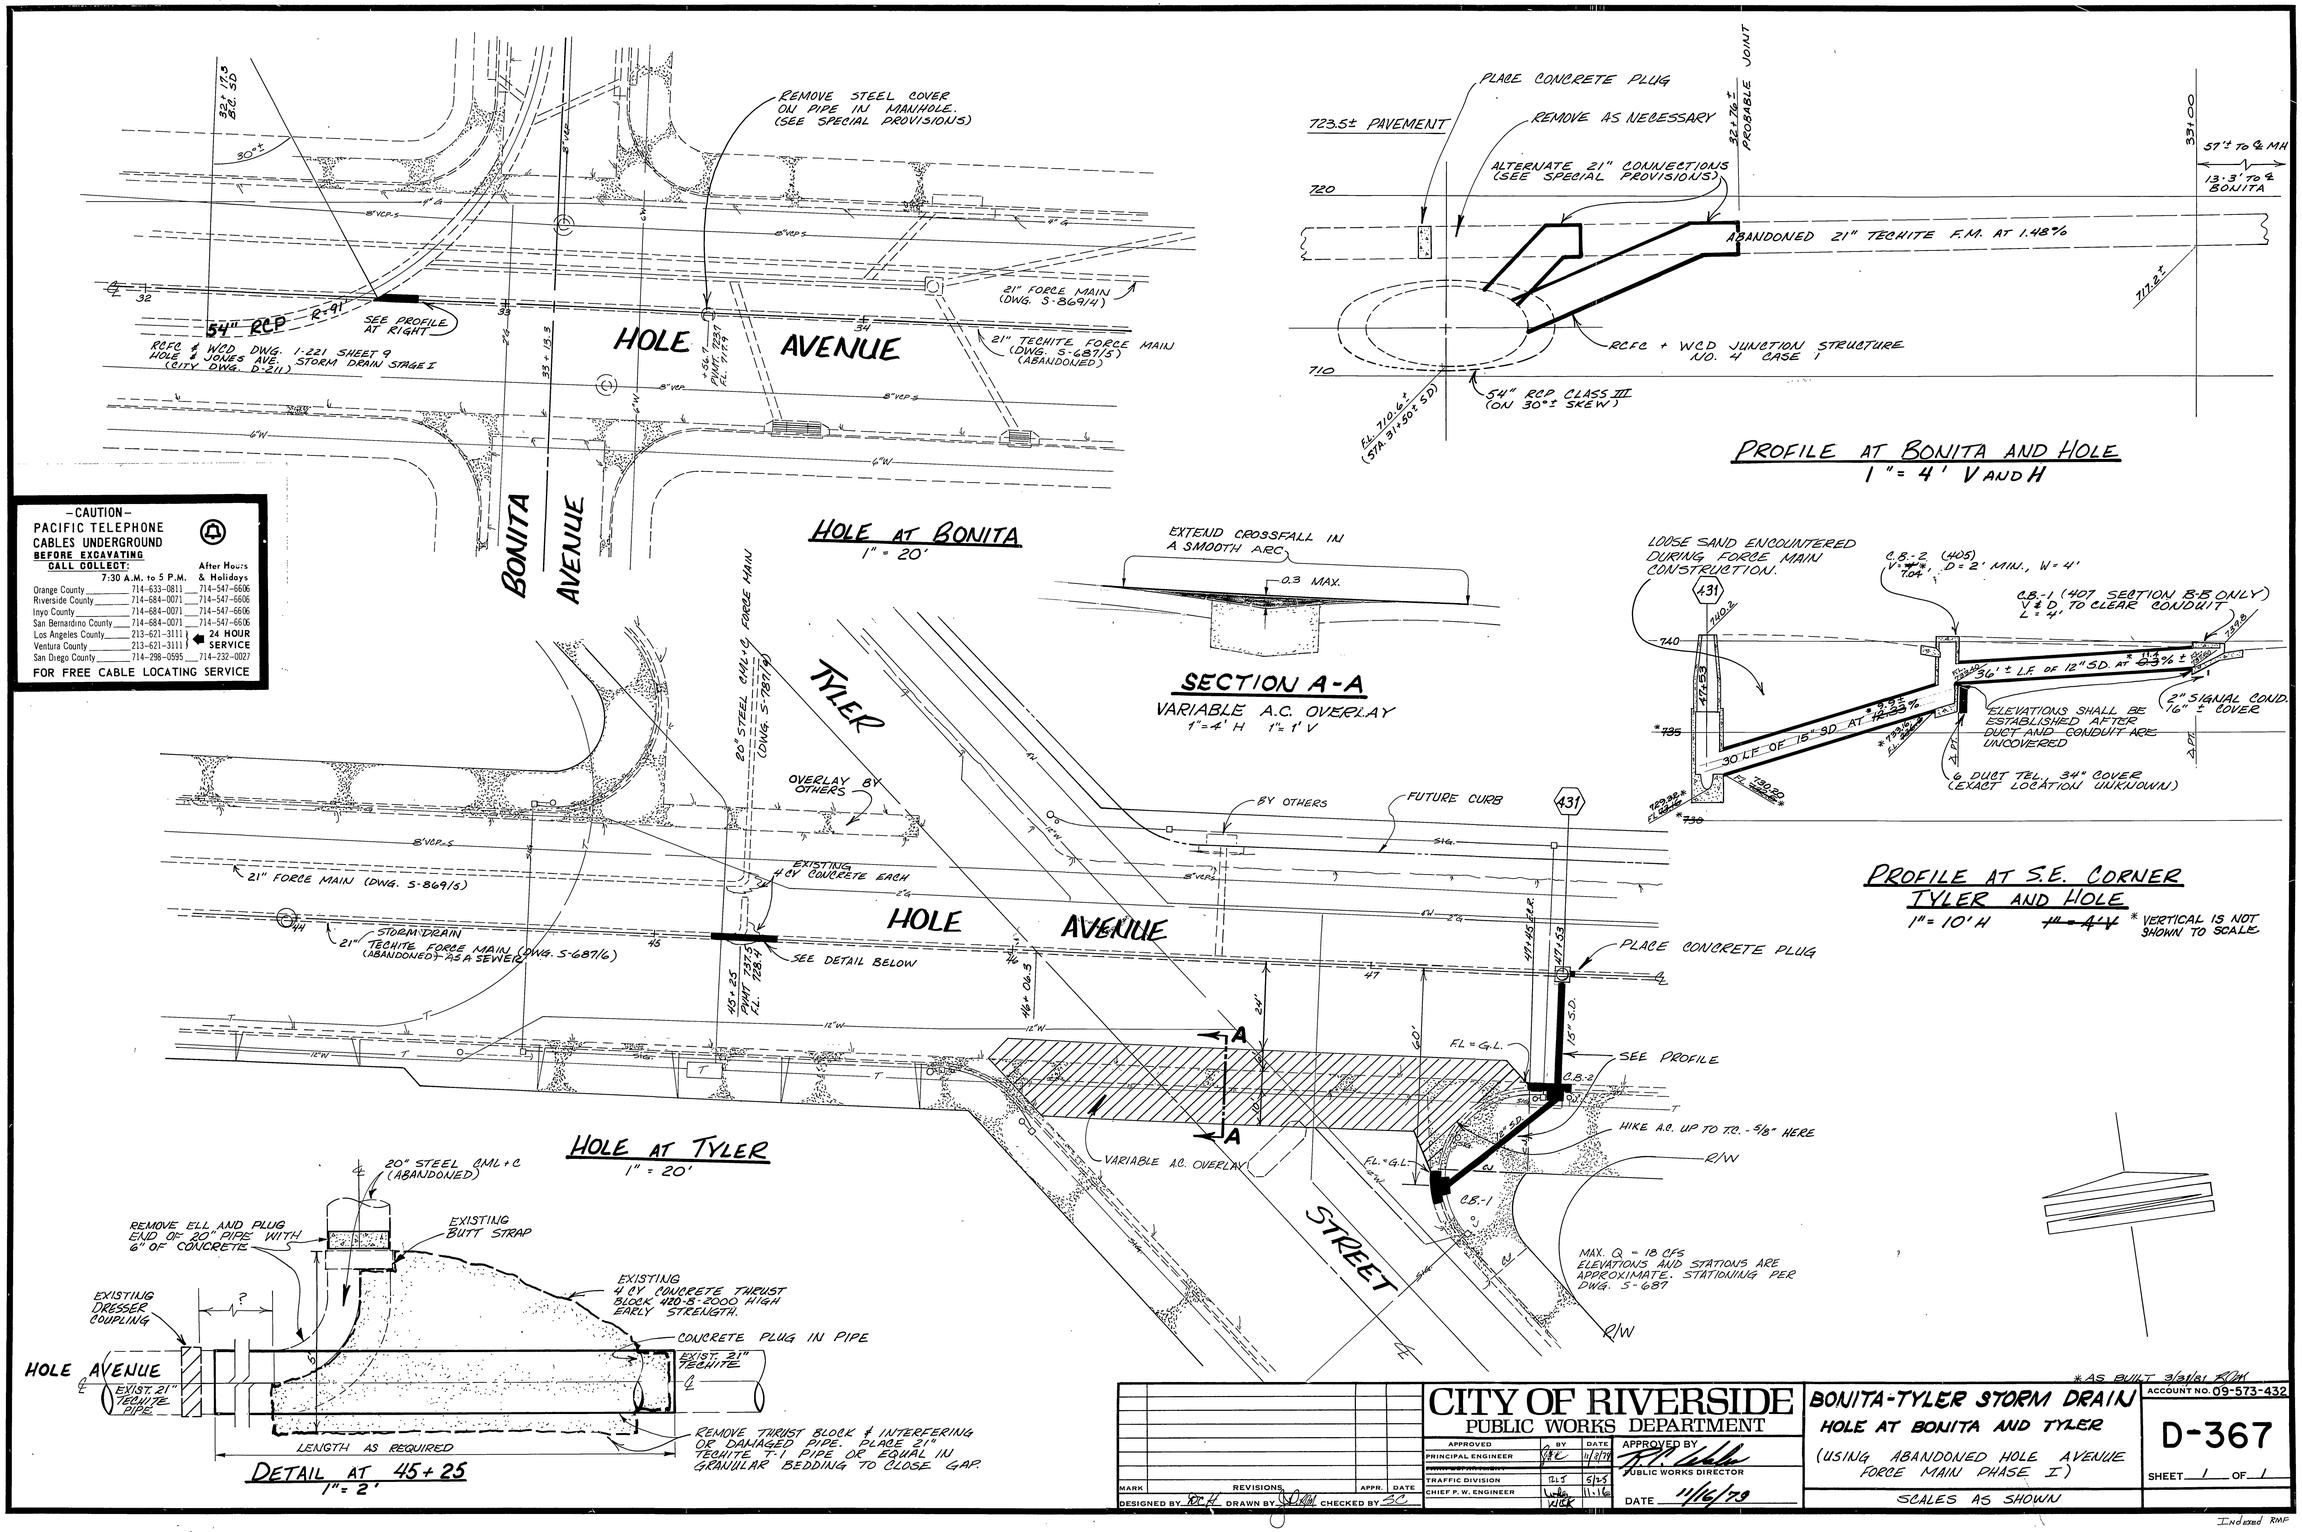

-CAUTION-
PACIFIC TELEPHONE CABLES UNDERGROUND
BEFORE EXCAVATING
CALL COLLECT:

	7:30 A.M. to 5 P.M.	After Hours & Holidays
Orange County	714-633-0811	714-547-6606
Riverside County	714-684-0071	714-547-6606
Inyo County	714-684-0071	714-547-6606
San Bernardino County	714-684-0071	714-547-6606
Los Angeles County	213-621-3111	24 HOUR SERVICE
Ventura County	213-621-3111	
San Diego County	714-298-0595	714-232-0027

FOR FREE CABLE LOCATING SERVICE

MARK	REVISIONS	APPR.	DATE

DESIGNED BY RCH DRAWN BY [illegible] CHECKED BY SC

CITY OF RIVERSIDE
PUBLIC WORKS DEPARTMENT

APPROVED	BY	DATE
PRINCIPAL ENGINEER	[illegible]	11/8/79
TRAFFIC DIVISION	RLS	5/25
CHIEF P.W. ENGINEER	[illegible]	11-16

APPROVED BY [illegible]
PUBLIC WORKS DIRECTOR
DATE 11/16/79

BONITA-TYLER STORM DRAIN
HOLE AT BONITA AND TYLER
(USING ABANDONED HOLE AVENUE FORCE MAIN PHASE I)
SCALES AS SHOWN

ACCOUNT NO. 09-573-432
D-367
SHEET 1 OF 1

*AS BUILT 3/31/81 RJM

Indexed RMF