



GENERAL NOTES




1. The Private Engineer signing these plans is responsible for the accuracy and acceptability of the work shown. In the event of discrepancies arising during construction, the private engineer shall be responsible for determining an acceptable solution and revising the plans for approval by the city.
2. It shall be the responsibility of the contractor to clear the Right-of-Way in accordance with the provisions of law, as it affects each utility including irrigation lines and appurtenances and at no cost to the City.
3. Construction shall be in accordance with the City of Riverside Department of Public Works Standard Drawings and the Standard Specifications for Public Works Construction, 1982 Edition.
4. Pipe Bedding shall be per City of Riverside Standard Drawing No. 452, Case 1.
5. All flagged elevations shall be staked in the field by the Private Engineer.

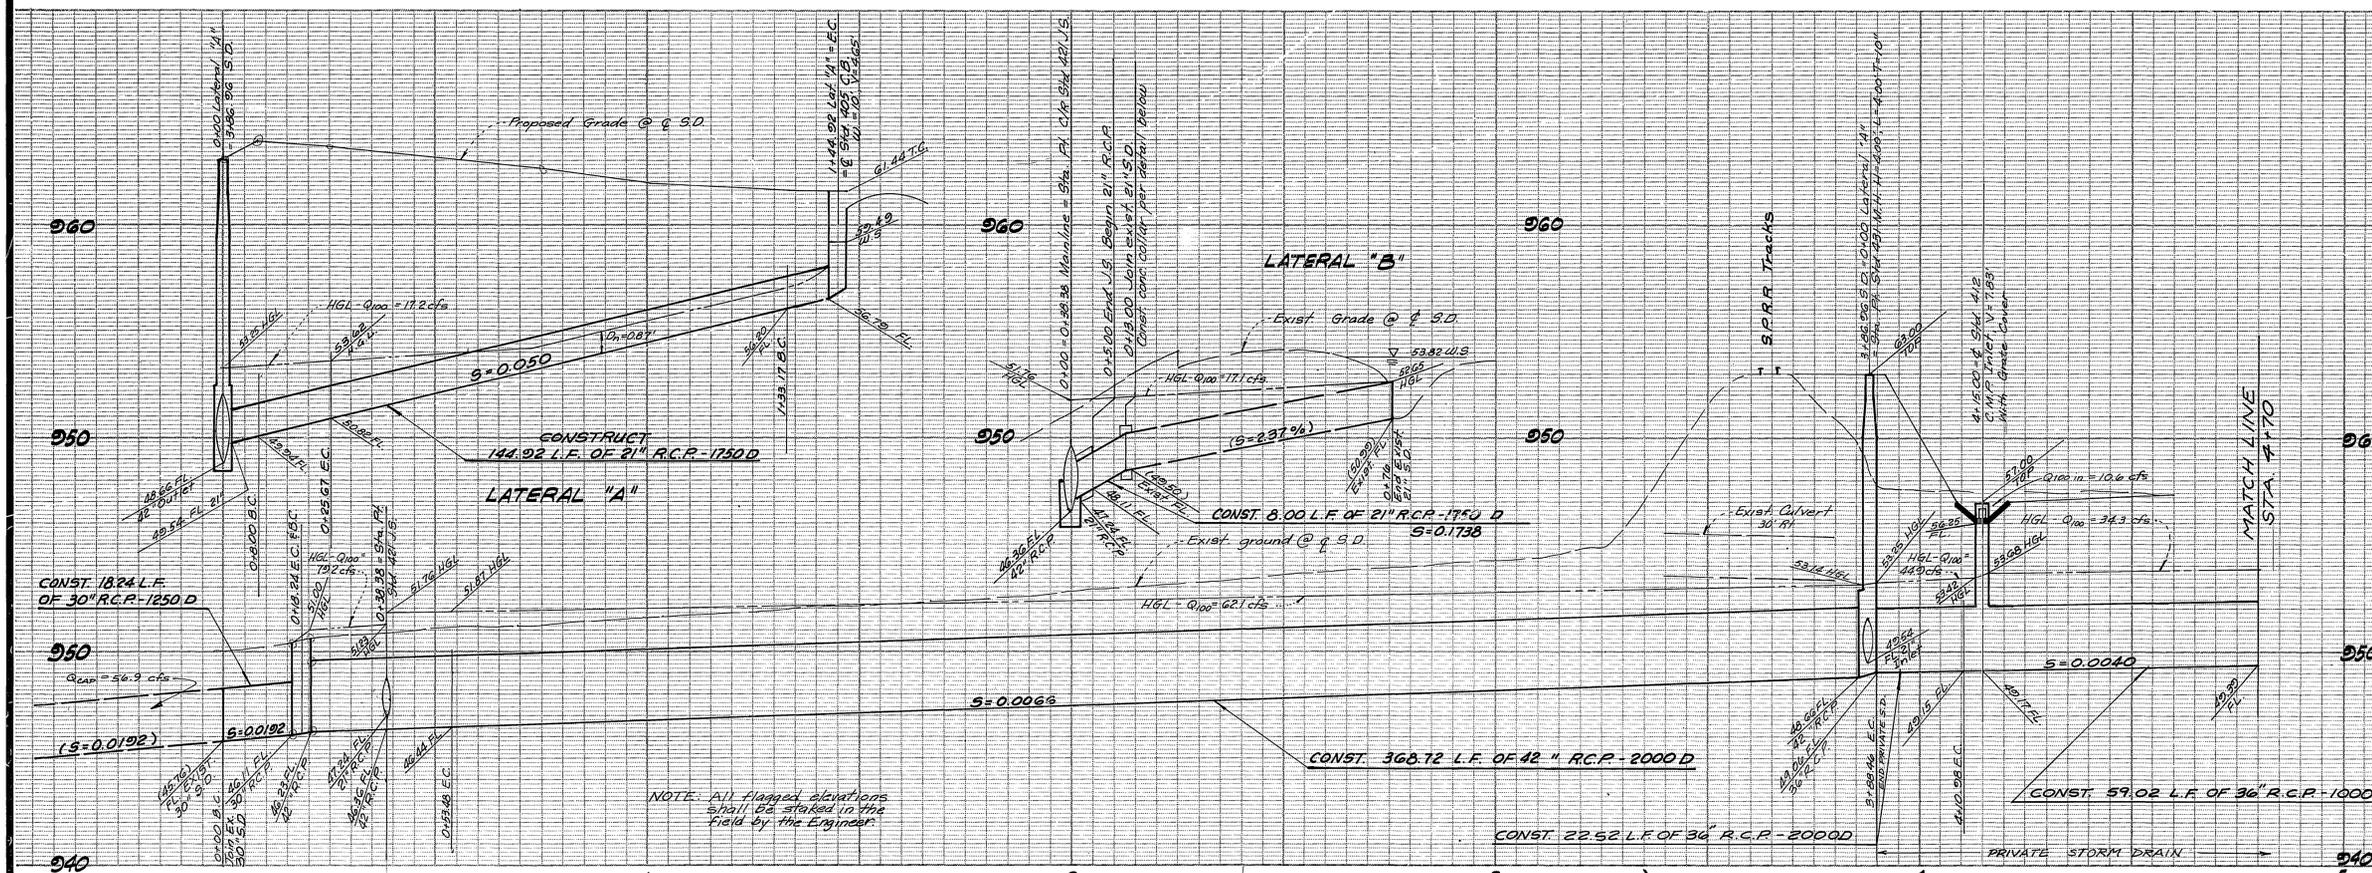

NOTICE TO CONTRACTOR
 The existence and location of any underground utility pipes or structures shown on these plans are obtained by a search of the available records. To the best of our knowledge, there are no existing utilities except as shown on these plans.
 The Contractor is required to take due precautionary measures to protect the utility lines shown and any other lines not of record or not shown on these plans.

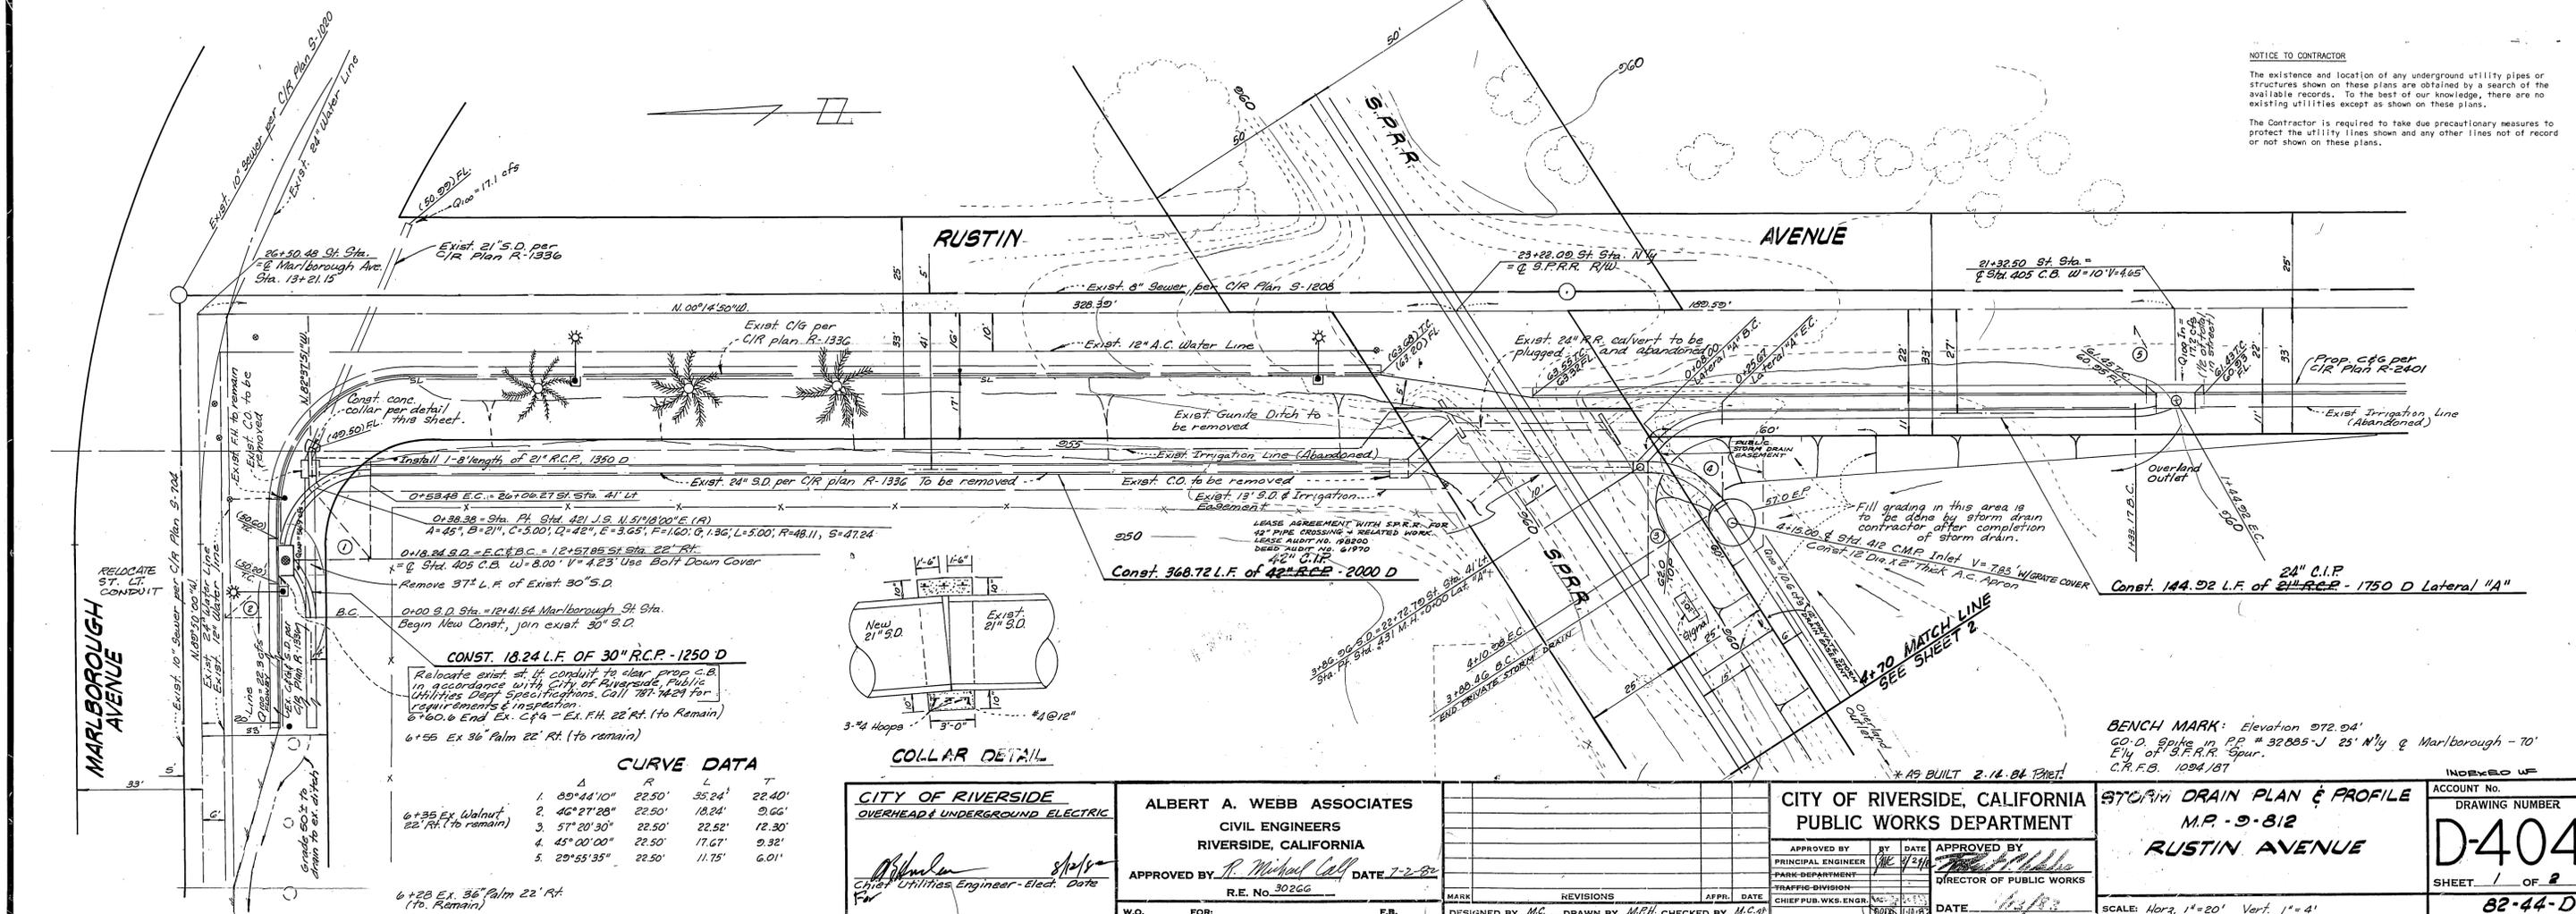

CITY OF RIVERSIDE OVERHEAD & UNDERGROUND ELECTRIC Utilities Engineer - Elec. Date	ALBERT A. WEBB ASSOCIATES CIVIL ENGINEERS RIVERSIDE, CALIFORNIA APPROVED BY: <i>R. Michael Call</i> DATE 7-2-80 R.E. No. 30266	CITY OF RIVERSIDE, CALIFORNIA PUBLIC WORKS DEPARTMENT APPROVED BY: <i>[Signature]</i> DATE 7/2/80 DIRECTOR OF PUBLIC WORKS	ACCOUNT NO. DRAWING NUMBER D-404
			SHEET 1 OF 2 82-44-D

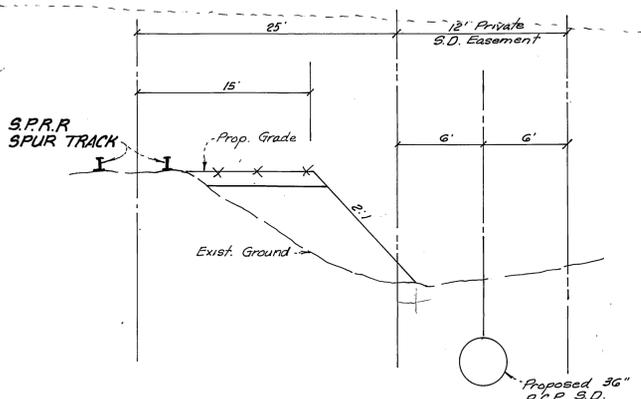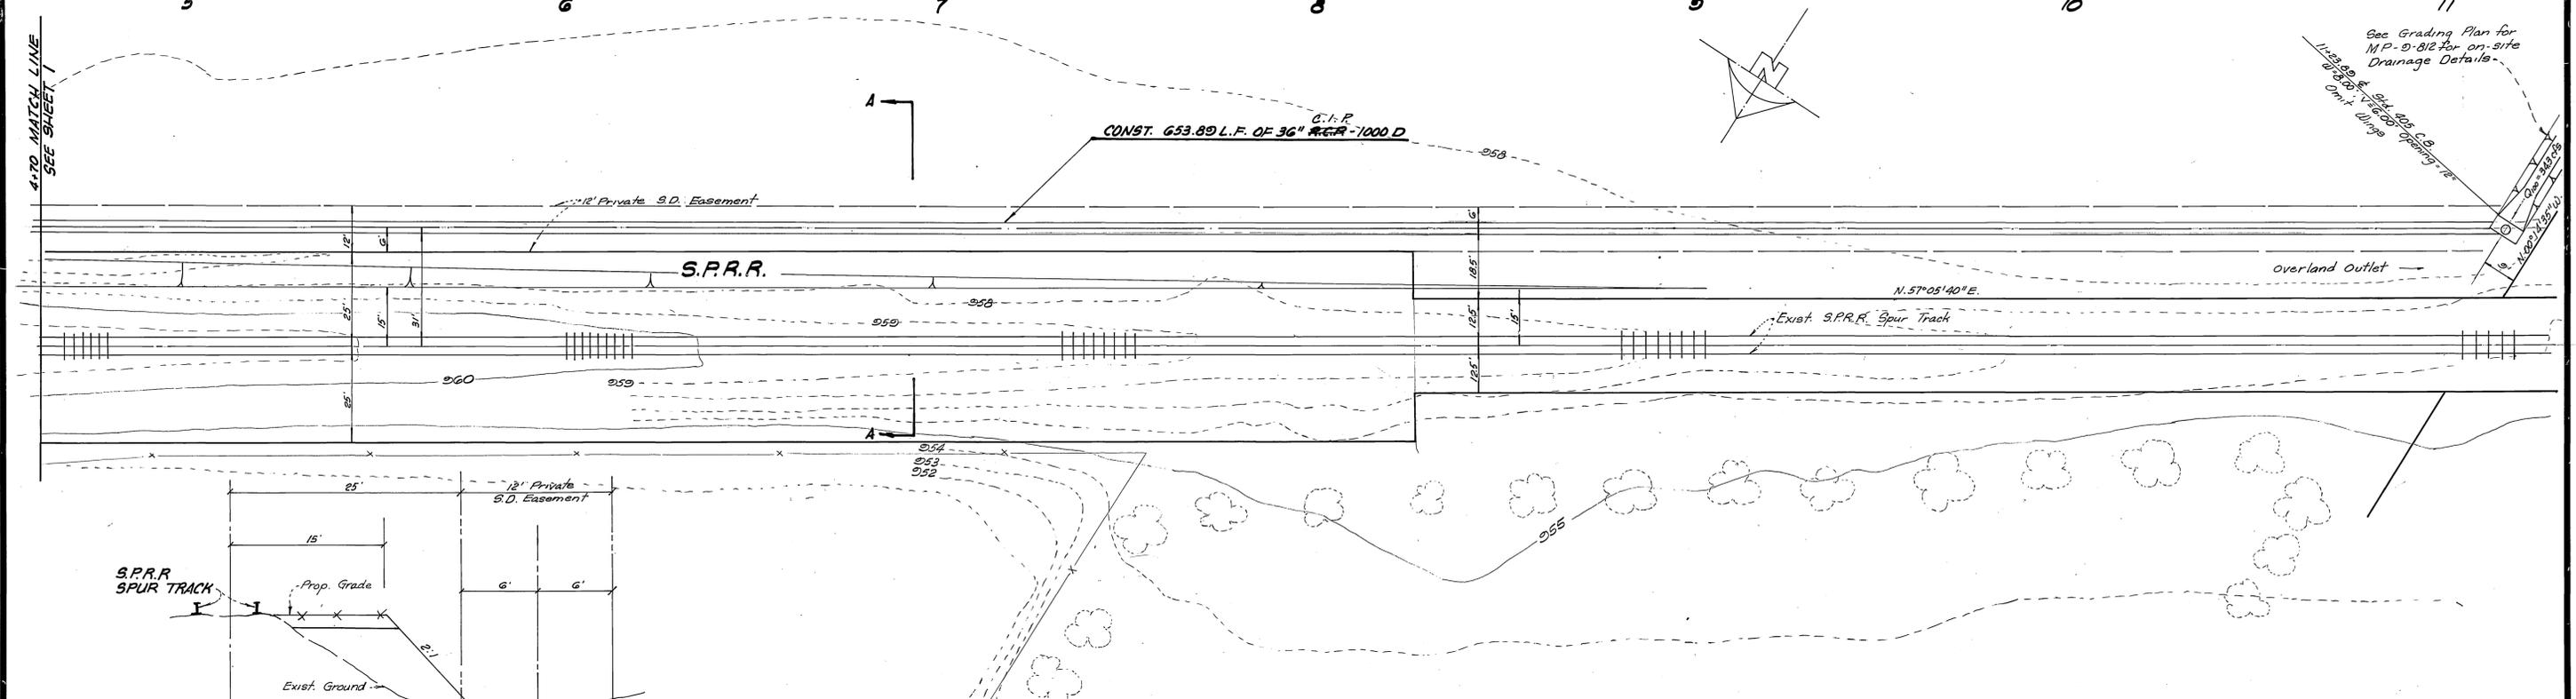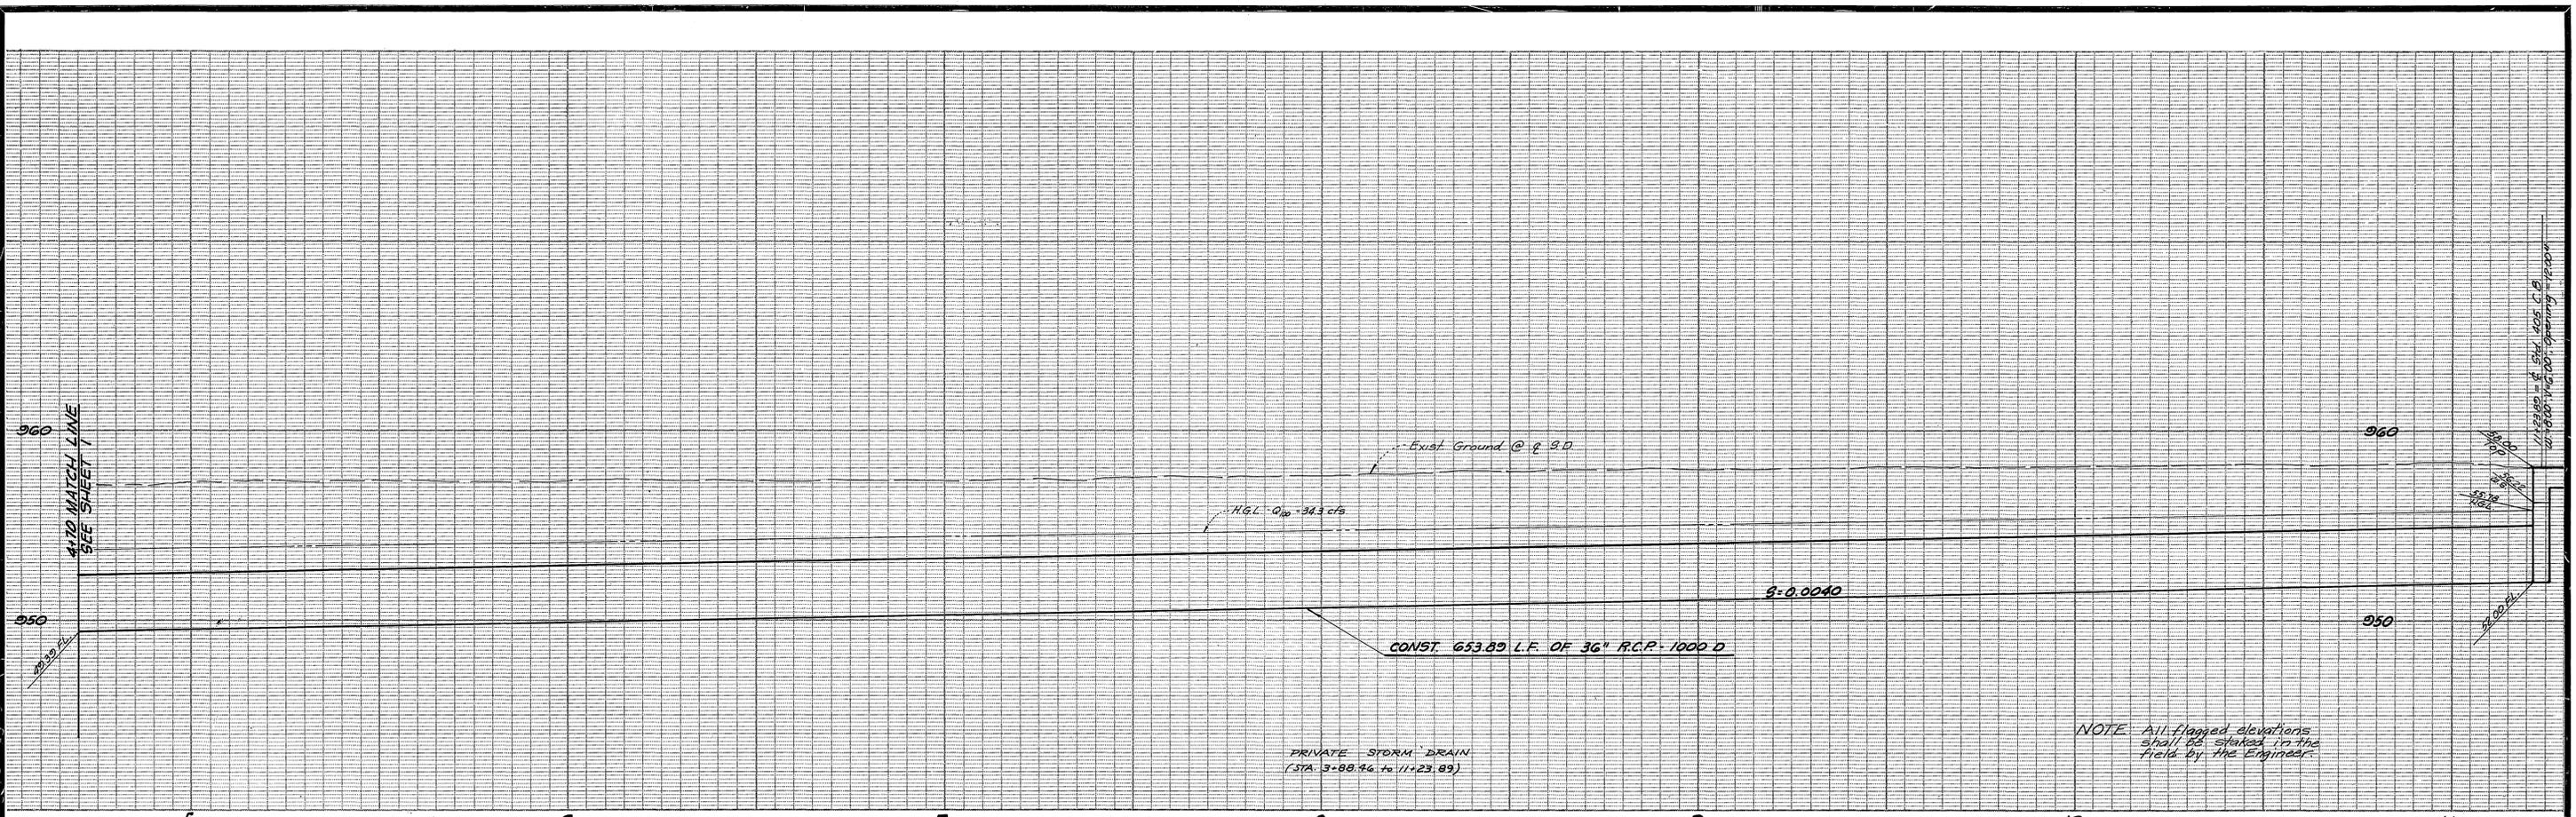

SECTION A-A

NOTICE TO CONTRACTOR
 The existence and location of any underground utility pipes or structures shown on these plans are obtained by a search of the available records. To the best of our knowledge, there are no existing utilities except as shown on these plans.
 The Contractor is required to take due precautionary measures to protect the utility lines shown and any other lines not of record or not shown on these plans.

ALBERT A. WEBB ASSOCIATES
 CIVIL ENGINEERS
 RIVERSIDE, CALIFORNIA
 APPROVED BY: *R. Michael Carl* DATE 7-2-82
 R.E. No. 30266

MAINT.	REVISIONS	APPR. DATE

DESIGNED BY: *MC* DRAWN BY: *M.P.H.* CHECKED BY: *MC*

CITY OF RIVERSIDE, CALIFORNIA
PUBLIC WORKS DEPARTMENT
 APPROVED BY: *[Signature]* DATE *11/13/83*
 CHIEF PUB. WKS. ENGR. DATE *11/13/83*

BENCH MARK: Elevation 972.94
 60-D Spike in PP #32225-J 25' Nly & Marlborough - 70'
 Ely of S.F.R.R. Spur.
 C.R.F.B. 1004/87.

STORM DRAIN PLAN & PROFILE
 M.P. - 9-812
 (PRIVATE - ON SITE SYSTEM)

ACCOUNT No.	INDEXED BY
DRAWING NUMBER	
D-404	
SHEET 2 OF 2	
82-44-D	

SCALE: Horiz. 1"=20' Vert. 1"=4'


See Grading Plan for
 M.P. - 9-812 for on-site
 Drainage Details.
