

CONSTRUCTION LEGEND




SPECIAL CONSTRUCTION NOTES




- NUMBERS ABOVE 100 IN A HEXAGON ON THE PLAN REFER TO THE RESPECTIVE STANDARD DRAWING AND SHALL BE CONSTRUCTED ACCORDINGLY, UNLESS MODIFICATIONS ARE NOTED ON THE PLAN. ANY NUMBER SHOWN BELOW THE STANDARD DRAWING NUMBER INDICATES THE SPECIFIC ALTERNATE TO BE CONSTRUCTED.
- STATE OF CALIFORNIA, BUSINESS AND TRANSPORTATION AGENCY, DEPARTMENT OF TRANSPORTATION, STANDARD PLANS, JANUARY 1981
- RIVERSIDE COUNTY FLOOD CONTROL DISTRICT STANDARD DRAWINGS

GENERAL CONSTRUCTION NOTES


- EXISTING UTILITIES SHOWN ON THIS PLAN, ARE PLOTTED FROM UTILITY RECORDS. THE CONTRACTOR IS REQUIRED TO TAKE DUE PRECAUTION. ANY MEASURES TO LOCATE AND PROTECT ALL UTILITIES, WHETHER OR NOT SHOWN ON THIS PLAN, IF THE COVER OF A UTILITY IS KNOWN, IT IS SHOWN IN THE PROFILE. UTILITIES SHOWN IN THE PROFILE AS --- INDICATES THAT COVER IS UNKNOWN, BUT THE UTILITY IS NOT EXPECTED TO CONFLICT WITH THE PROPOSED IMPROVEMENTS.
- PERMANENT TRENCH RESURFACING SHALL BE 0.20' A.C. OVER 0.60' CRUSHED AGGREGATE BASE OR 0.60' FULL DEPTH A.C.
- CONFLICTING UTILITIES SHOWN WITHIN CONSTRUCTION AREA WILL BE RELOCATED PRIOR TO CONSTRUCTION. THE EXISTING 20" WATER MAIN (STEEL, MORTAR LINED & COATED PIPE - DIPPED & WRAPPED) AND THE EXISTING 12" HIGH PRESSURE GAS MAIN (WELDED STEEL PIPE) SHALL BE PROTECTED IN PLACE.

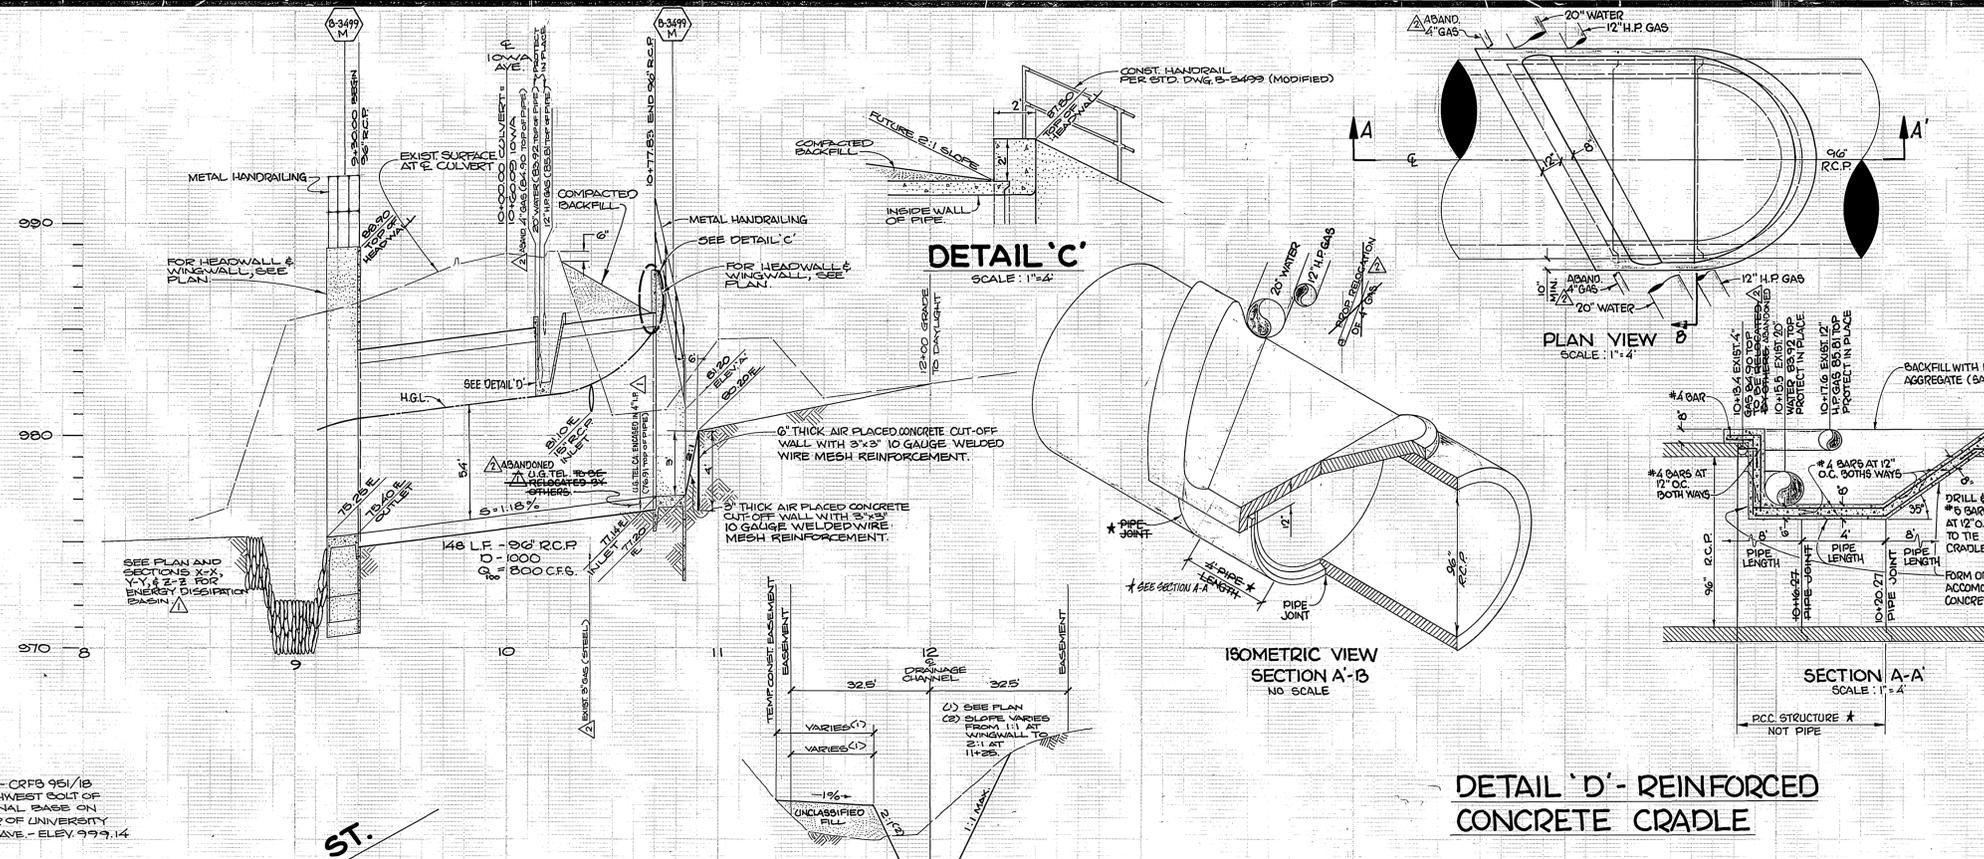

BENCHMARK - CRFB 951/13
TOP OF SOUTHWEST CORNER OF TRAFFIC SIGNAL BASE ON N.E. CORNER OF UNIVERSITY AVE. & IOWA AVE. - ELEV. 999.14

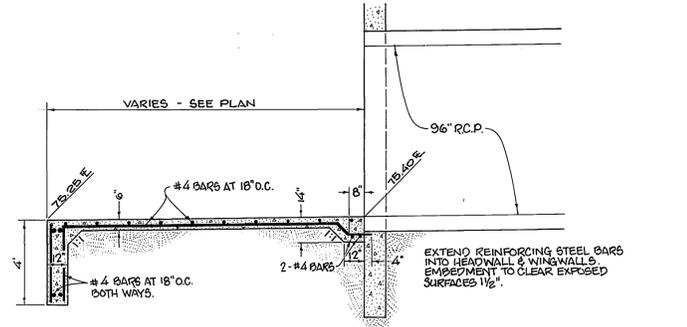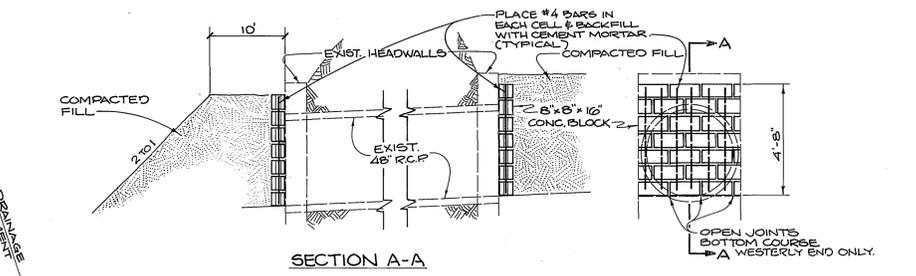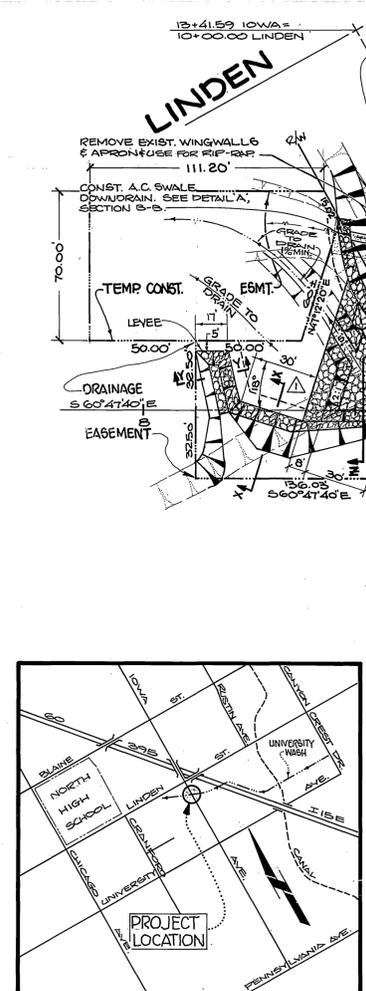

CAUTION!
HIGH PRESSURE GAS LINE
* NOTE: RCFCO STD. DWG. J6 229 REVISED TO C/R STD. DWG. 423

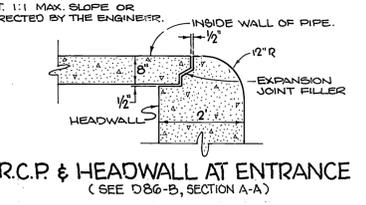


DETAIL 'B'

SCALE: 1"=2"



SCALE: 1"=1"

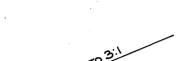

SCALE: 1"=1"



SCALE: 1"=1"

SECTION B-B

SCALE: 1"=2"



SECTION E-E

SCALE: 1"=2"




DETAIL 'A'

SCALE: 1"=2"



PLAN VIEW

SCALE: 1"=4"

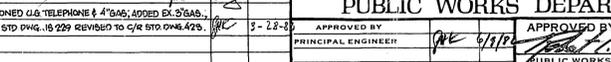

CITY OF RIVERSIDE PUBLIC WORKS DEPARTMENT		UNIVERSITY WASH CULVERT AT IOWA AVENUE		D-405
DESIGNED BY: <i>[Signature]</i> DRAWN BY: <i>[Signature]</i> CHECKED BY: <i>[Signature]</i>	REVISIONS:	TRAFFIC DIVISION:	CHIEF P.W. ENGINEER:	SHEET 1 OF 1 FILE NO.