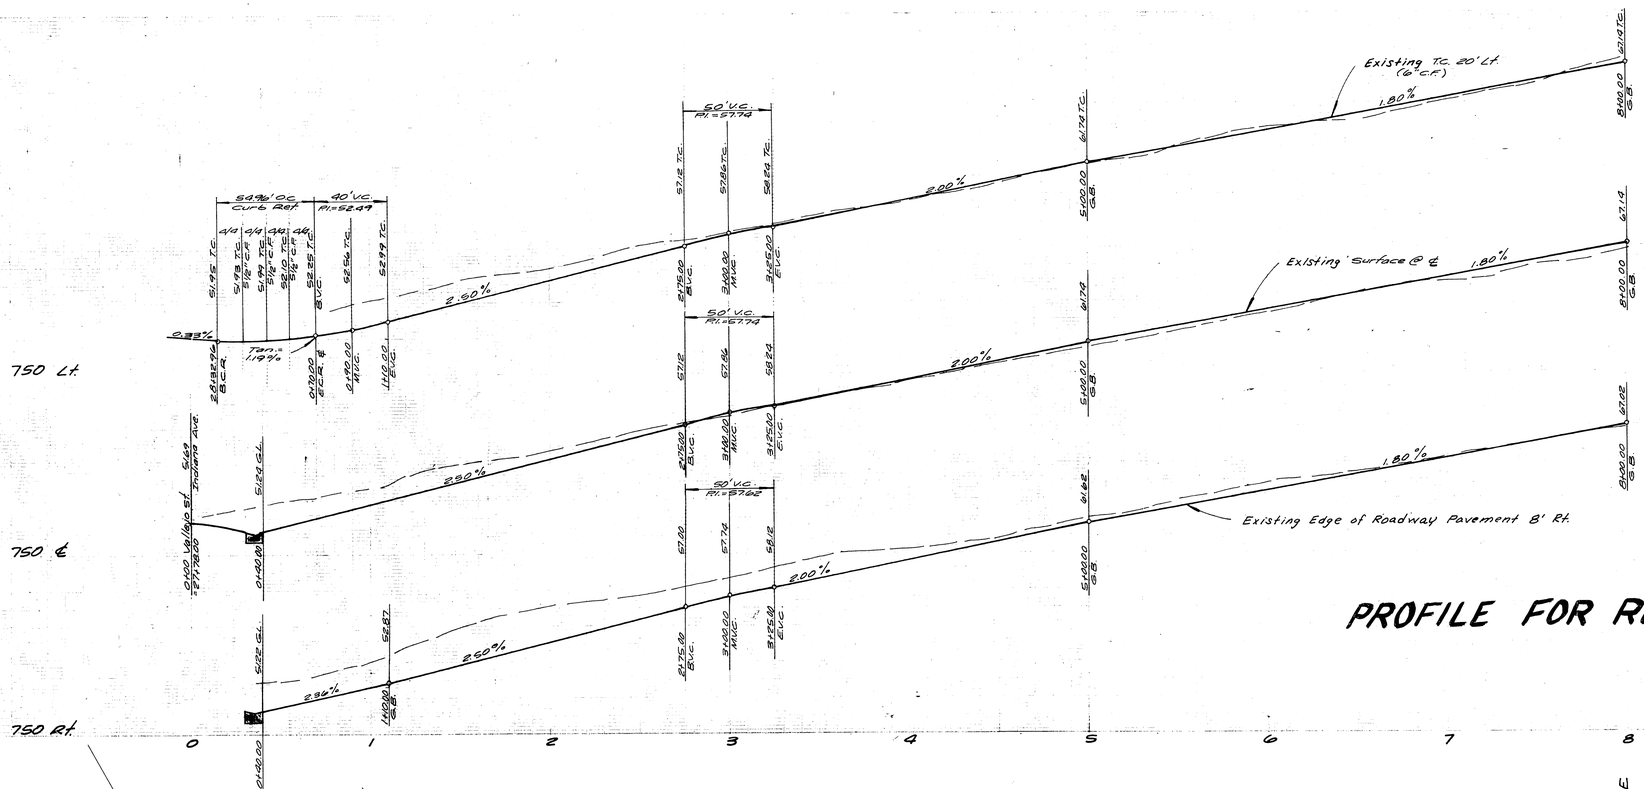

PROFILE FOR REFERENCE ONLY

GENERAL NOTES

1. PROPOSED CHANNEL LINING SHALL BE ALIGNED HORIZONTALLY AND VERTICALLY WITHIN THE ERODED BORDERS OF THE EXISTING EARTH DITCH. THE CHANNEL MAY BE ALIGNED HORIZONTALLY SO IT SHALL BE ALLOWED TO MEANDER WITHIN THE LIMITS OF THE EDGE OF PAVEMENT AND FENCE, AS LONG AS THE MEANDERS ARE CONTROLLED BY GRADUAL CHANGES IN HORIZONTAL ALIGNMENT.
2. THE VERTICAL ALIGNMENT SHALL FOLLOW THE ROUGH GRADE OF THE EXISTING EARTH CHANNEL INVERT (INDIANA ONLY) SUCH THAT THERE ARE NO GRADES LESS THAN 0.4% AND THAT THE NUMBER OF GRADE BREAKS ARE MINIMIZED. NO GRADE BREAK OVER 5% SHALL BE PERMITTED.
3. AT HORIZONTAL CURVES OF 30° OR MORE THE CHANNEL OUTSIDE WALL SHALL TRANSITION FROM A 2:1 TO 1:1 SLOPE FOR THE MIDDLE THIRD OF THE CURVE AND RISE AN ADDITIONAL 1 FOOT TO BE MAINTAINED THROUGH THE MIDDLE THIRD OF THE CURVE.

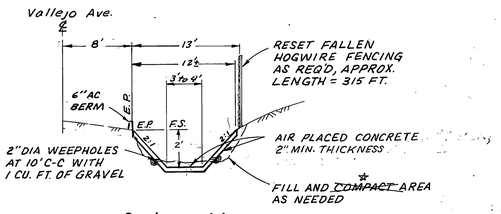

Section AA
For Vallejo Ave.
CHANNEL TYPE A
NO SCALE

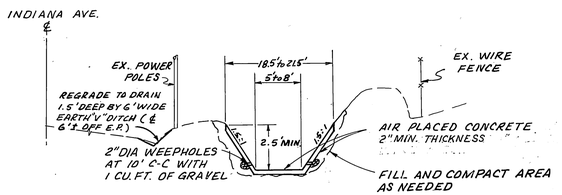

Typical Section
For Indiana Ave.
(REFER TO PLAN R1944C FOR ALIGNMENT)
CHANNEL TYPE B
NO SCALE

☆ AS BUILT LWC 11-30-83 INDEX 45

MARK	REVISIONS	APPR.	DATE	CITY OF RIVERSIDE, CALIFORNIA PUBLIC WORKS DEPARTMENT	STREET PLAN & PROFILE
				APPROVED BY / BY / DATE	ACCOUNT No.
				PRINCIPAL ENGINEER —	DRAWING NUMBER
				PARK DEPARTMENT —	INDIANA AND VALLEJO AVE. STORM DRAIN REPAIR
				TRAFFIC DIVISION —	D 438
				CHIEF PUB. WKS. ENGR. —	SHEET 1 OF 2
DESIGNED BY J.H.	DRAWN BY J.H.	CHECKED BY		APPROVED BY Thomas P. Wilson, DIRECTOR OF PUBLIC WORKS	SCALE: Horiz. 1"=40', Vert. 1"=4'
				DATE 9/26/83	

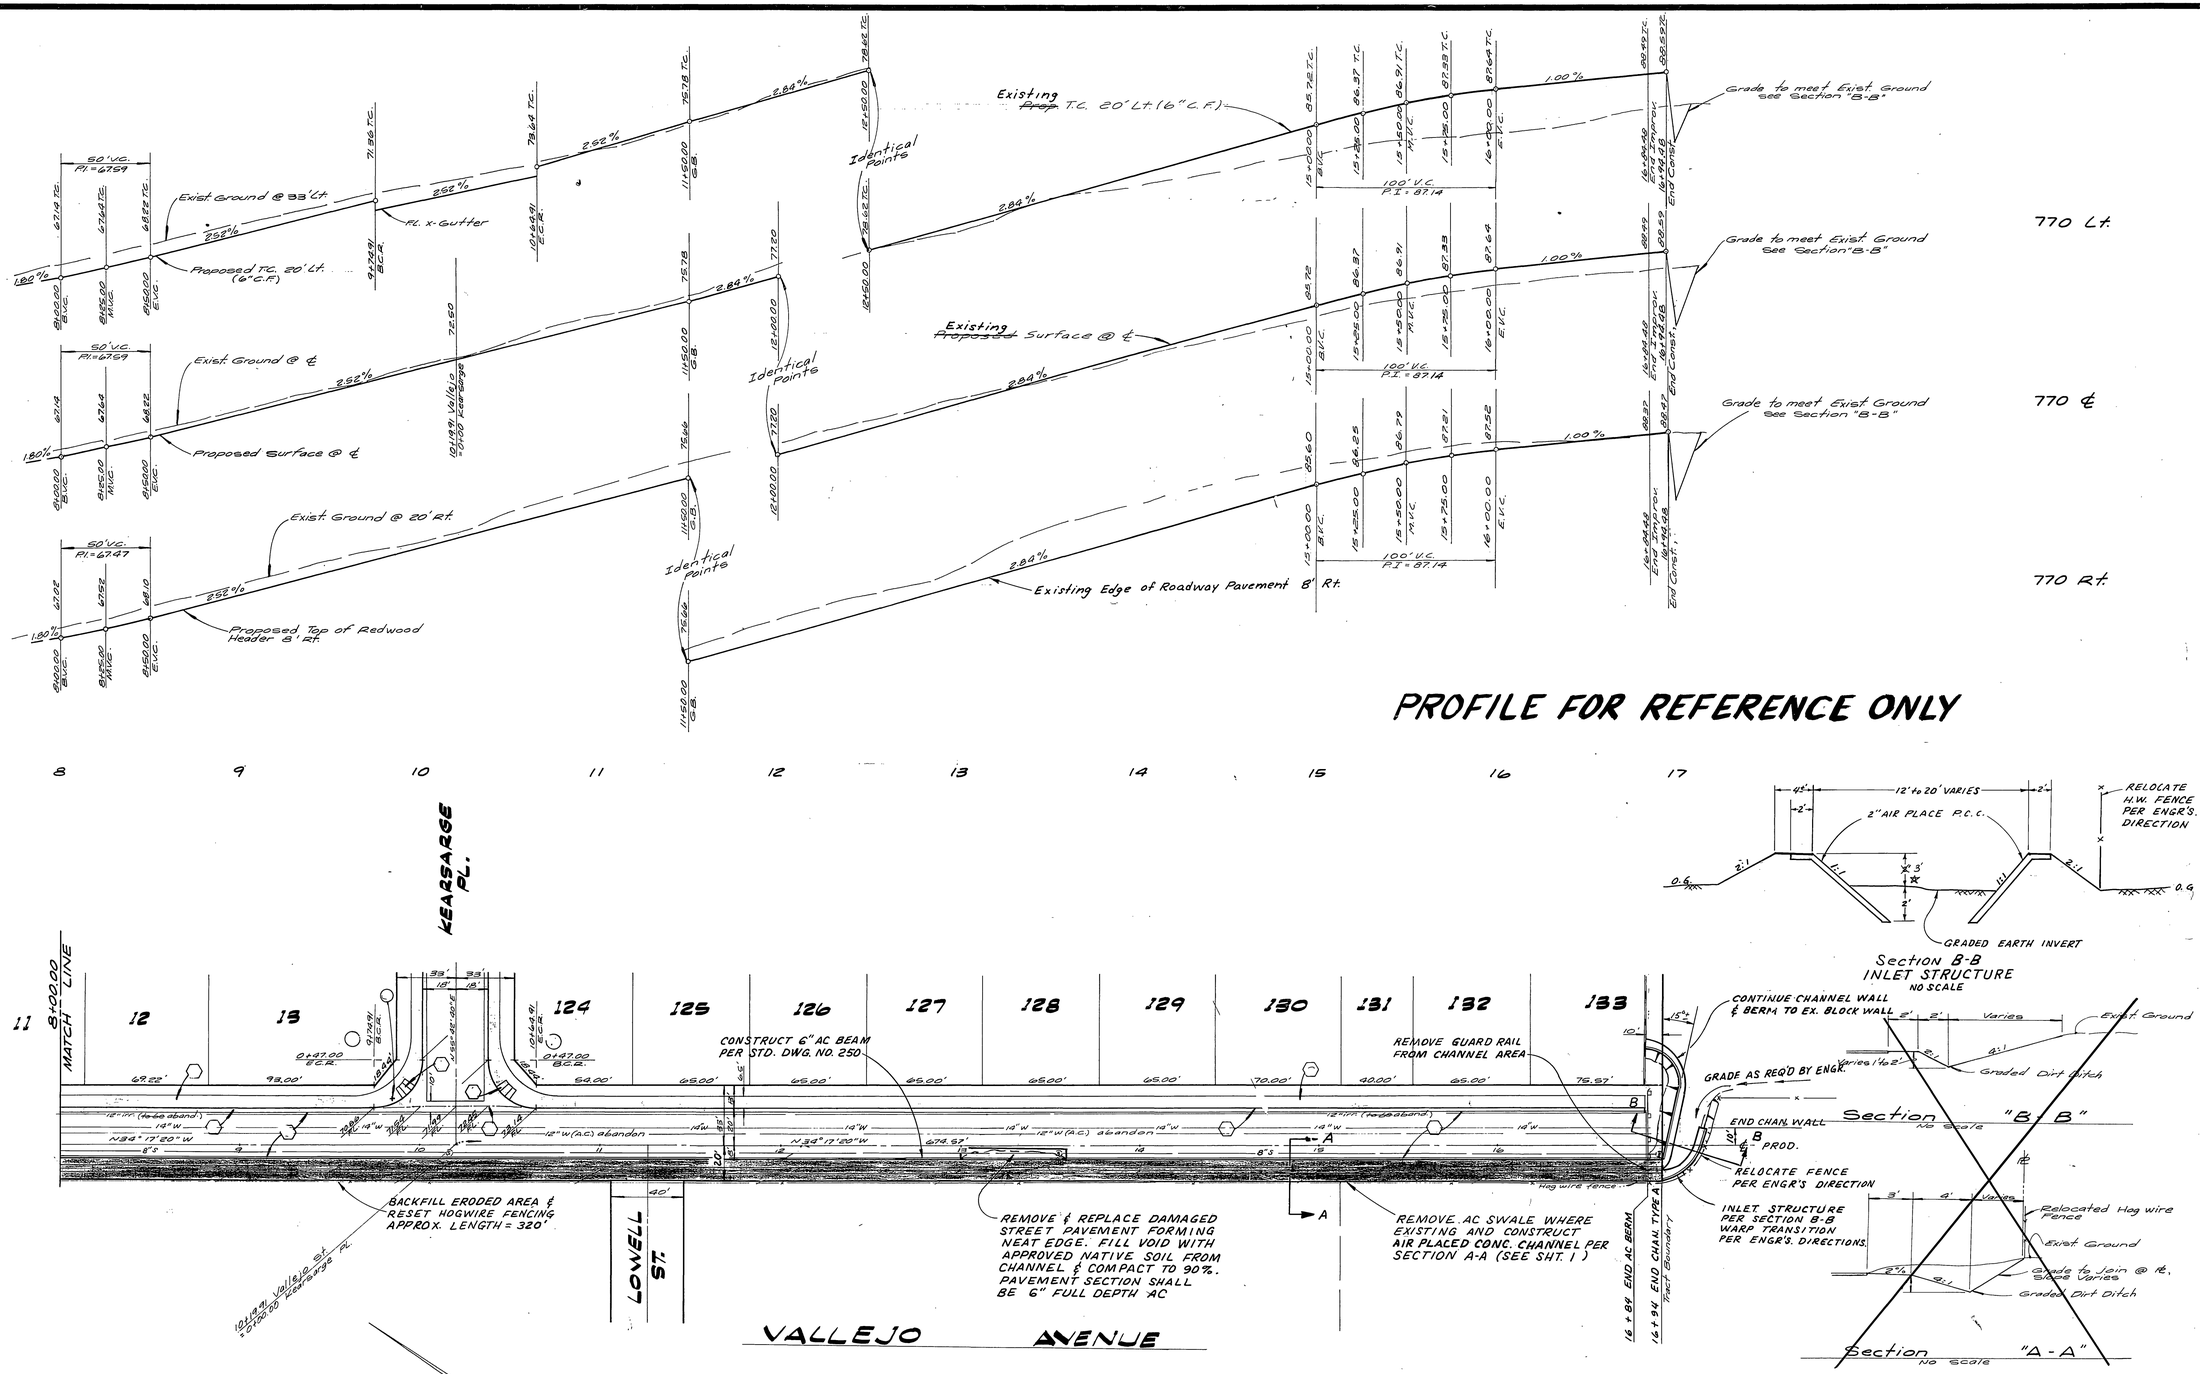

Note: See Sheet #1 for General & Construction Notes

* AS BUILT LWC 11-30-83

INDEX 45

CITY OF RIVERSIDE, CALIFORNIA
PUBLIC WORKS DEPARTMENT

APPROVED BY	BY	DATE
PRINCIPAL ENGINEER		
PARK DEPARTMENT		
TRAFFIC DIVISION		
CHIEF PUB. WKS. ENGR.		

APPROVED BY _____
DIRECTOR OF PUBLIC WORKS
DATE 9/26/83

MARK | REVISIONS | APPR. | DATE

DESIGNED BY J.H. DRAWN BY J.H. CHECKED BY _____

STREET PLAN & PROFILE

INDIANA AND VALLEJO AVE.
STORM DRAIN REPAIR

SCALE: Horiz. 1"=40', Vert. 1"=4'

ACCOUNT No.

DRAWING NUMBER
D-438

SHEET 2 OF 2