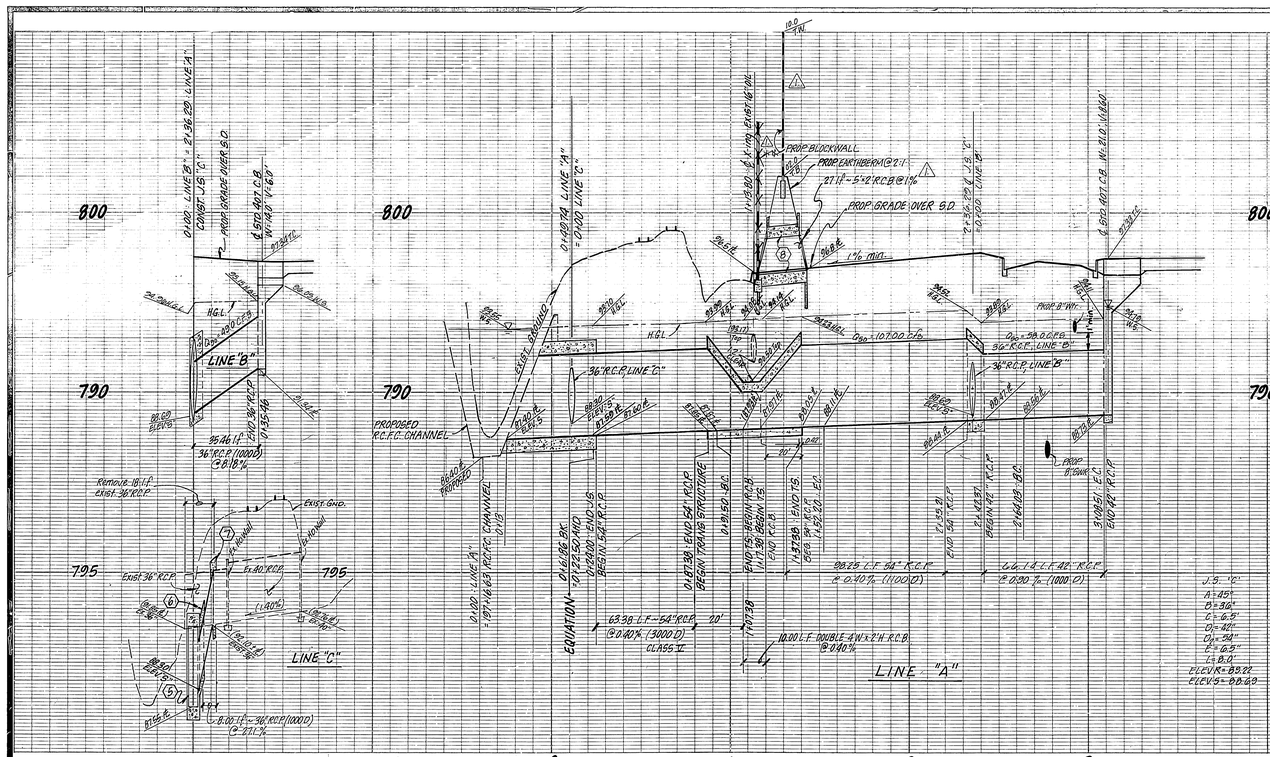
LINE "B"
LINE "C"
LINE "A"
TAYLOR STREET
DRESSAGE LANE
PROP. BLOCKWALL
PROP. EARTHBERM @ 2:1
PROP. GRADE OVER S.D.
PROPOSED R.C.F.C. CHANNEL
EXIST. GRADE
HGL
1% min.
EQUATION
TRACT BDRY.
PROPOSED STREET IMPROVEMENT per R-2574
PROP. 8" W.C.
PROP. 18" R.C.P.
EXIST. 36" R.C.P.
EXIST. GND.
PROP. 42" R.C.P.
PROP. 54" R.C.P.
PROP. 36" R.C.P.
