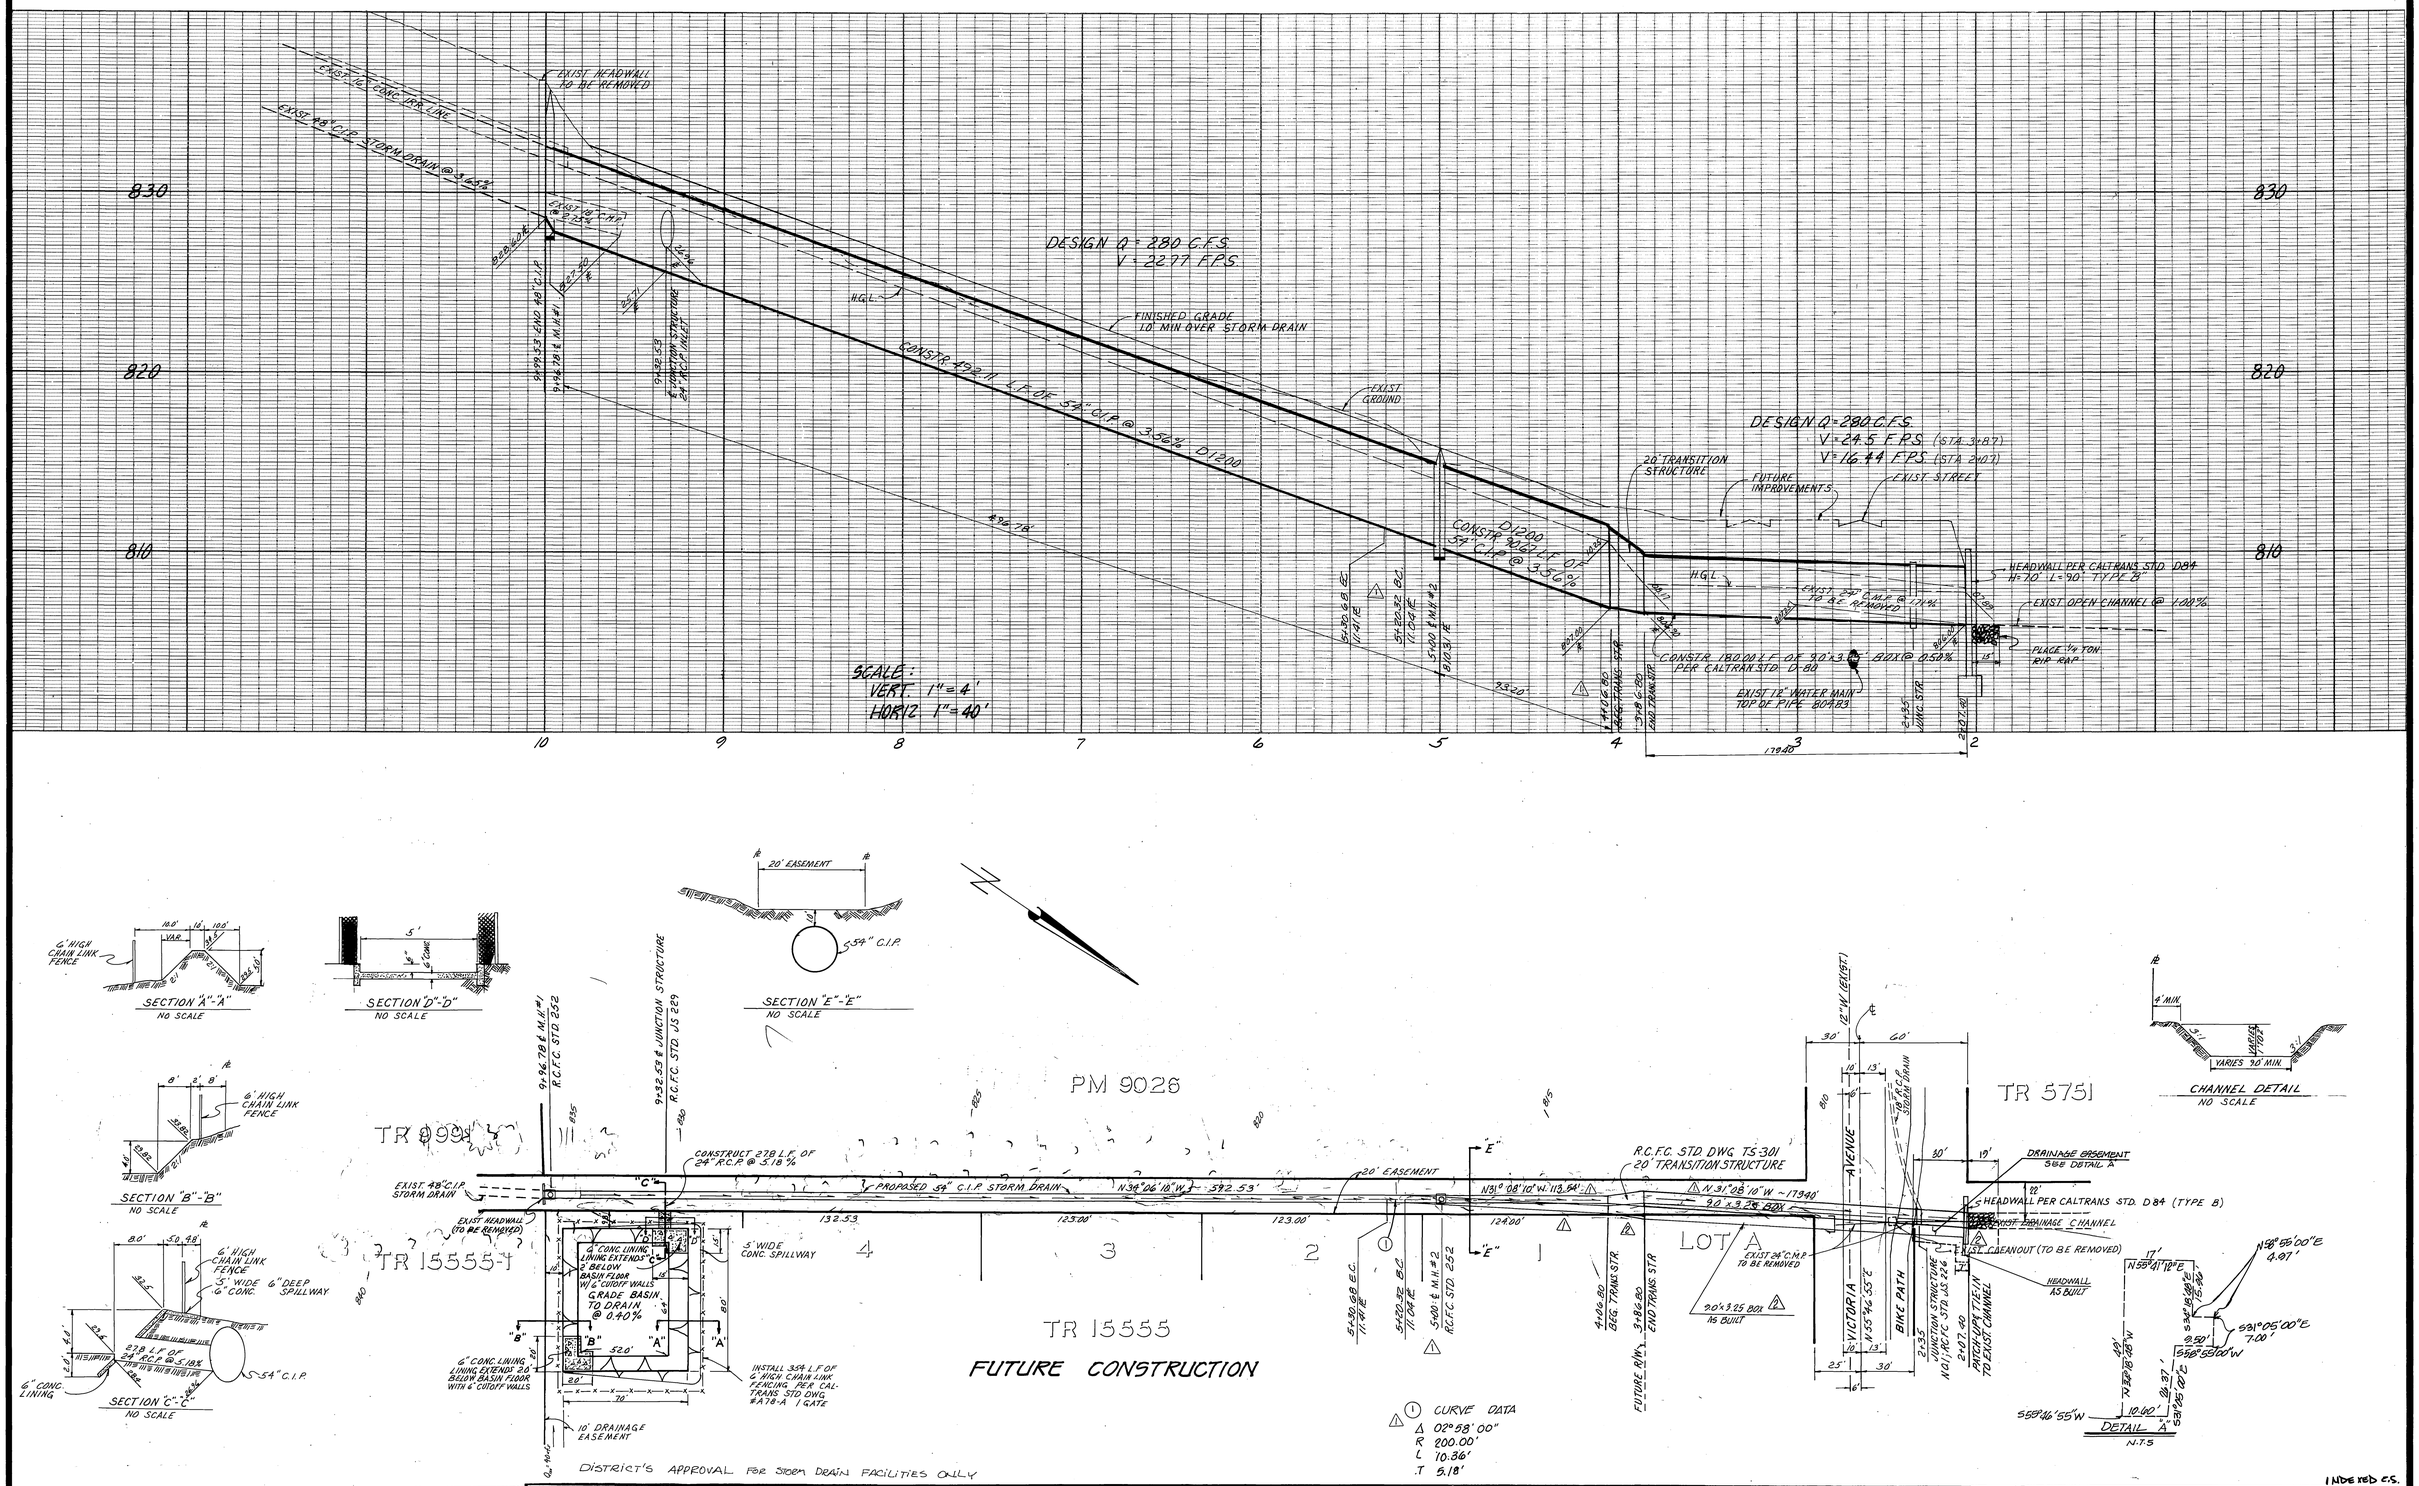

CITY OF RIVERSIDE DOMESTIC SYSTEM & IRRIGATION SYSTEM Fred Lantz 12/2/81 WATER SYSTEMS MANAGER DATE	RIVERSIDE COUNTY FLOOD CONTROL AND WATER CONSERVATION DISTRICT DESIGNED BY: DRAWN BY: DATE DRAWN: CHECKED BY: APPROVED BY: Kenneth P. Edwards CHIEF ENGINEER R.E. NO. 12400 DATE: 8-14-81	REVISIONS: 2 9.0x3.25 BOX CHANNEL AS BUILT ADDED, PER FB. 7065/114 & 134 1 REVISED ALIGN. TO JOIN AS-BUILT @ STA 3+86.80	APPROVED BY: John W. Canty REGISTERED CIVIL ENGINEER NO. 17550 DATE: 5/15/81 APPROVED BY: Elmer F. Baumgarten RIVERSIDE COUNTY, CALIF. FOR ROAD COMMISSIONER DATE: 5/1/84	J. F. DAVIDSON ASSOCIATES CIVIL ENGINEERS • SURVEYORS • PLANNERS 3426 TENTH STREET RIVERSIDE, CAL. 11200 S. MT. VERNON AVE. COLTON, CAL. SCALE: 1"=40' DATE BENCH MARK: BRASS DISC. IN CONC. 144' N.E. OF LA SIERRA & ARIZONA, 36' N.E. OF LA SIERRA AVE. ELEV. 783.41'	TRACT NO. 15555-1 COUNTY OF RIVERSIDE SOUTHWEST AREA DRAINAGE PLAN LINE C-4 W.O. 80-7065 FOR: KEUSDER F.B.	D-507 1 OF 1 SHEETS FILE NO. 81-7065