PLATE 1. PLAN-PROFILE O.P.R.&R.E. STANDARD
KEUFFEL & ESSER CO. NEW YORK.

K & E CO. No. 347-IR ALBANENE 1065 MADE IN U.S.A. 33560

PROFILE
SURVEYED
PLOTTED
GRADES CHECKED
R.W.S. NOTED
STRUCTURE INCTN'NS CK'ED
NOTE BOOK NO.
BY
DATE

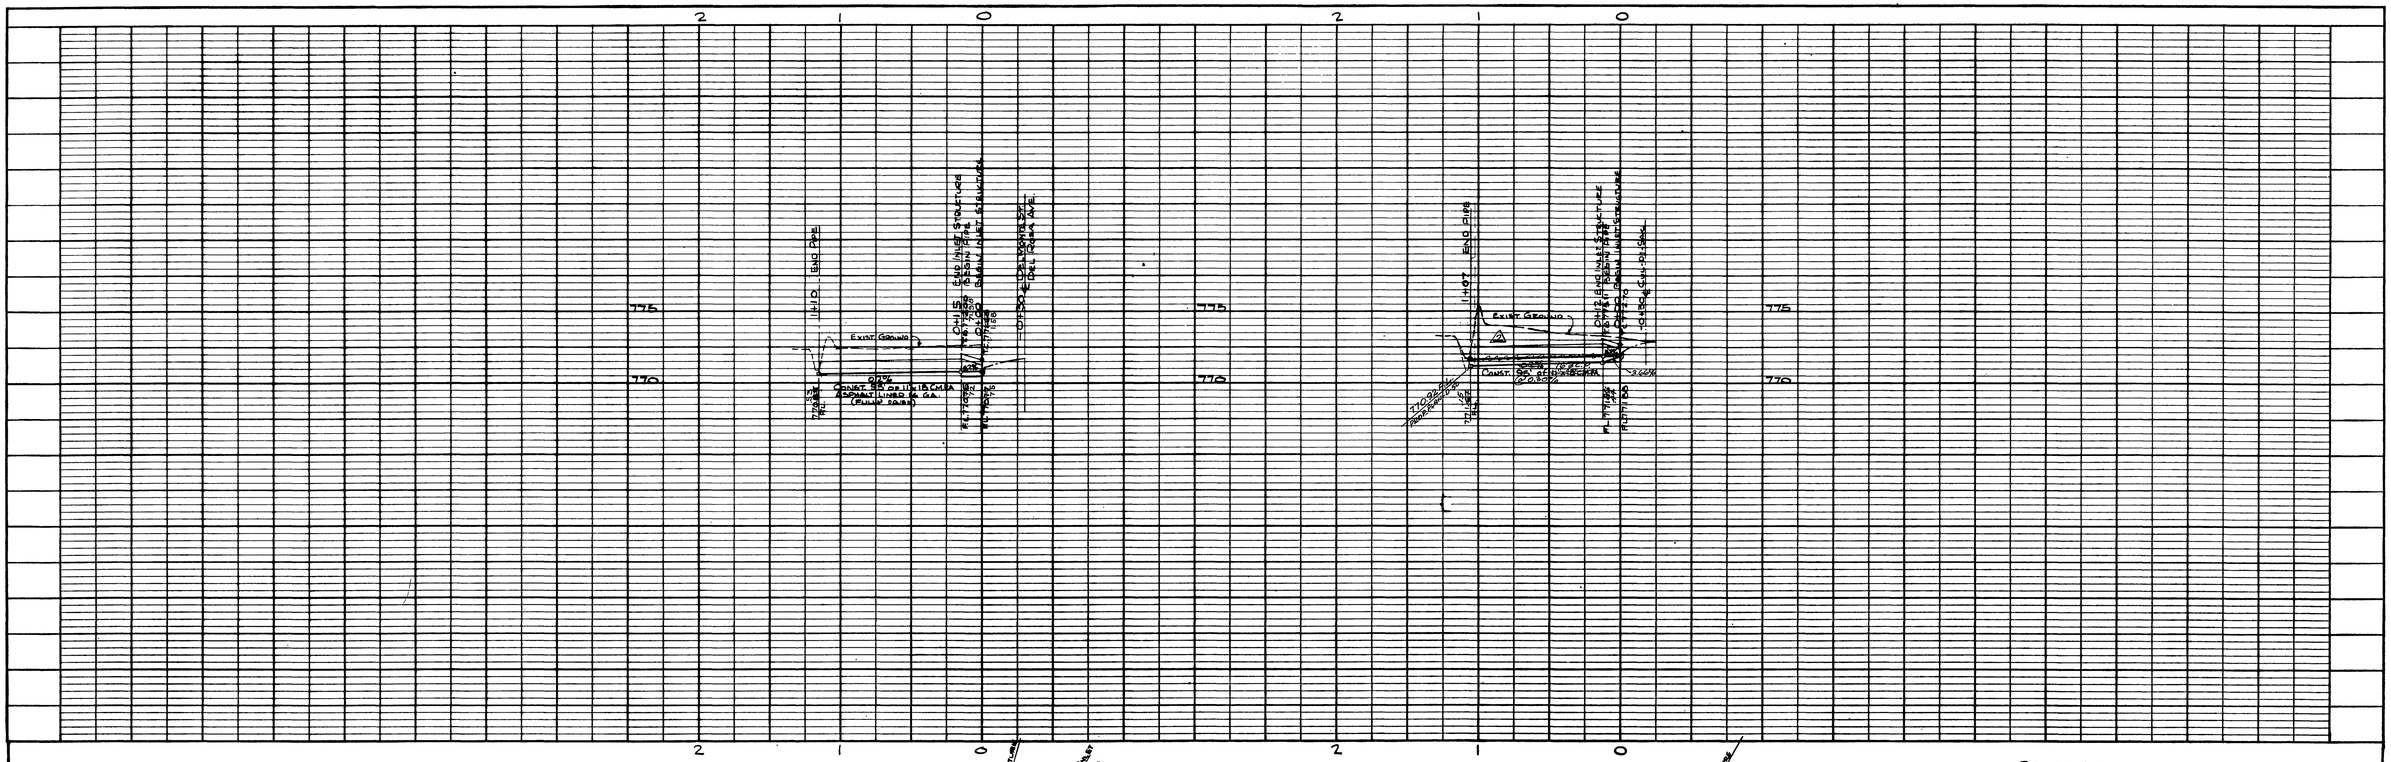

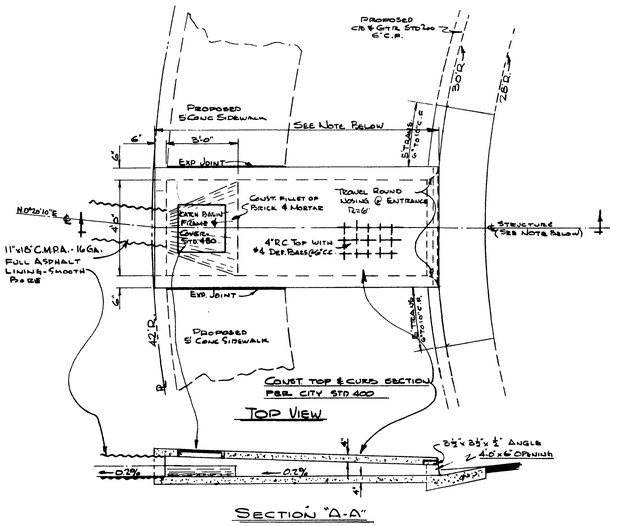

DETAILS "A" & "B"
INLET STRUCTURE
No Scale

NOTE:
DETAIL "A" - INLET STRUCTURE AT DEL MONTE ST. & DEL ROSA PL. TO BE 15'-0" LG. WITH ℄ BEARING OF ~~S 0°42'55" E~~ N 0°42'55" E
DETAIL "B" - INLET STRUCTURE AT EL CAMINO PL TO BE 12'-0" LG WITH ℄ BEARING OF N. 6°38'10" W.

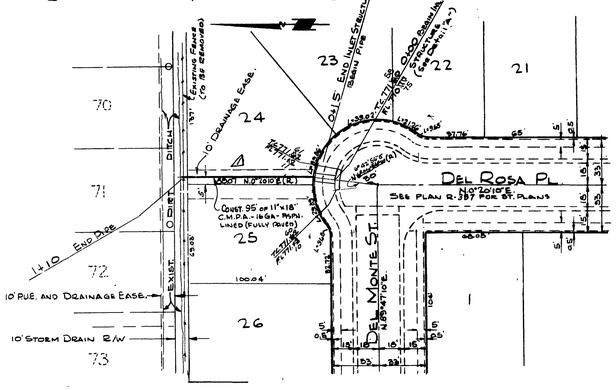

NOTE:
CONST. 488'± OF CHAIN LINK FENCE ALONG REAR OF LOTS NO. 14-15-24-25-26 PER STD. NO. 800 - FENCE TO BE LOCATED 1' INSIDE STORM DRAIN R/W WITH B.W. ARMS TOWARD PROPERTY.

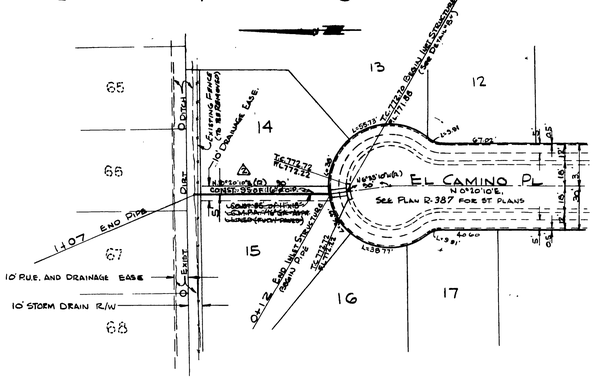

BENCH MARK
NAIL AND LEAD - WEST SIDE CATCH BASIN
170'± SLY GRANADA - WEST SIDE STREETER
ELEV. 775.230

NOTE:
CONSTRUCTION TO BE IN ACCORDANCE WITH CITY OF RIVERSIDE STANDARDS AND SPECIFICATIONS No. 460

QUANTITY ESTIMATE

11"x18" C.M.P.A. ASPHALT LINED (FULLY PAVED)	~~190~~ 95 L.F
SPECIAL INLET STRUCTURES	2 EA.
CHAIN LINK FENCE - STD. 800	488 L.F.
16⅝ CONC. PIPE	95 L.F.

PLAN
SURVEYED
PLOTTED
GRADES CHECKED
R/W CHECKED
NOTE BOOK NO.
BY
DATE

ALBERT A. WEBB ASSOCIATES
CIVIL ENGINEERS - RIVERSIDE, CALIFORNIA
APPROVED Emmett N. Webb DATE 4/4/60
R.E. 9876

CITY OF RIVERSIDE, CALIFORNIA
DEPARTMENT OF PUBLIC WORKS

STORM DRAIN PLAN & PROFILE
PALM VIEW ESTATES

REVISION		
MARK	DATE	DESCRIPTION
1	8-16-60	Relocated Storm to S'ly side of Lot Line 24-25. dkr. Approved by: [signature] Asst. City Engineer
2	12-15-60	TYPE OF PIPE, SIZE & GRADES dkr. Index 12/16/60 [illegible]

DATE MARCH 1960 | SCALE Horiz 1"=50' Vert 1"=5'
DRAWN dkr | W.O. 59-282
CHECKED | F.B. 418
APPROVED BY [signature] DIRECTOR OF PUBLIC WORKS
DATE May 13, 1960
NO. D-52
SHEET 1 OF 1

DWG NO. 59-282 D

INDEXED