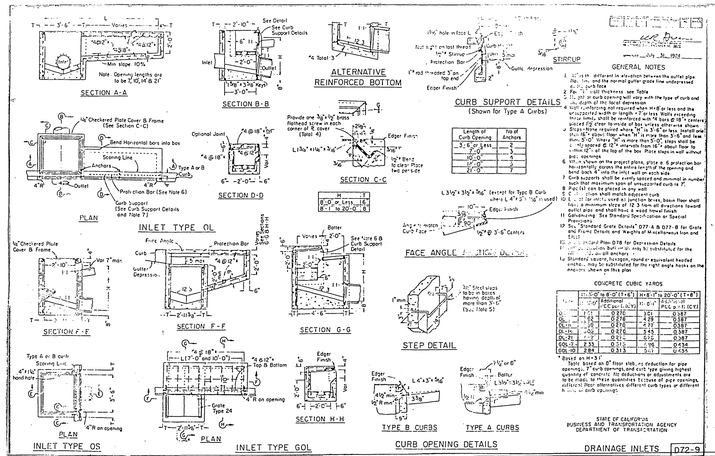

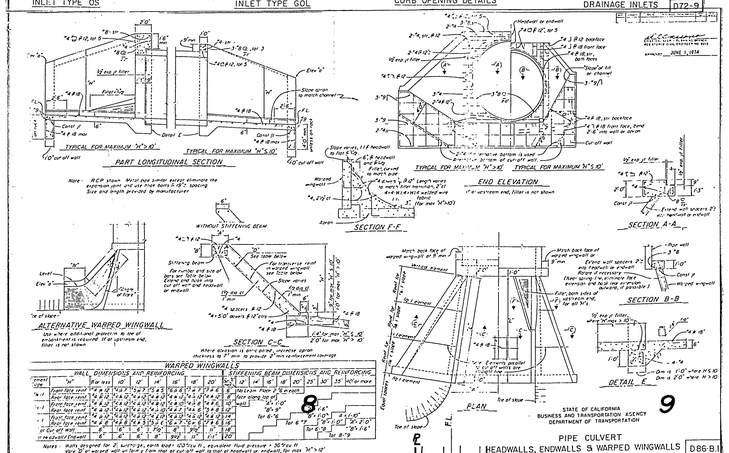

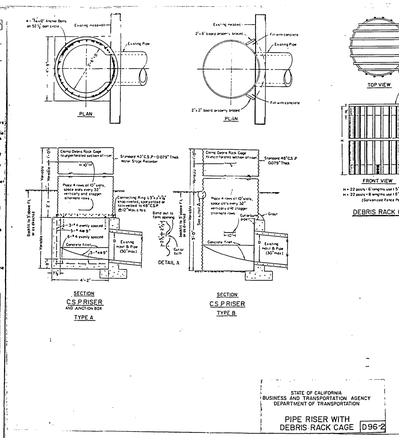

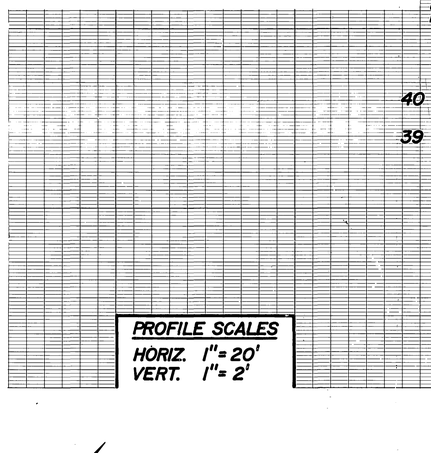

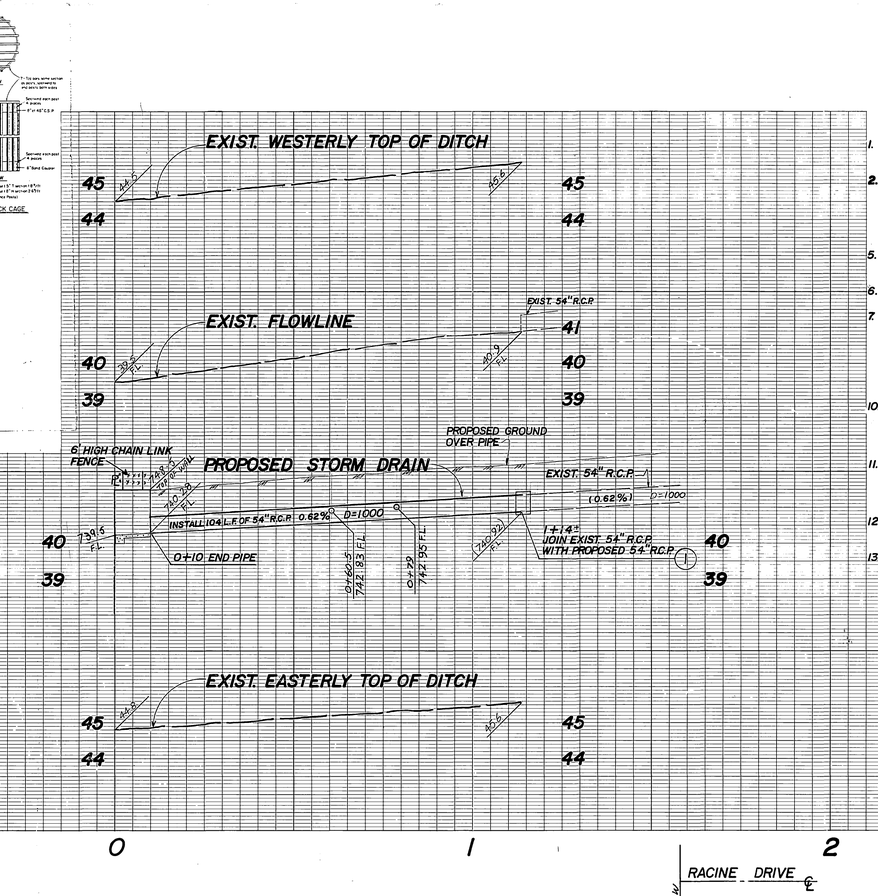

GENERAL NOTES

1. IT SHALL BE THE RESPONSIBILITY OF THE CONTRACTOR TO CLEAR THE RIGHT OF WAY IN ACCORDANCE WITH THE PROVISIONS OF LAW AS IT AFFECTS EACH UTILITY INCLUDING IRRIGATION LINES AND APPURTENANCES AND AT NO COST TO THE CITY.
2. CONST. SHALL BE IN ACCORDANCE WITH THE CITY OF RIVERSIDE DEPARTMENT OF PUBLIC WORKS, STANDARD DRAWING NO. 10 AND THE STANDARD SPECIFICATIONS FOR PUBLIC WORKS CONSTRUCTION, CURRENT EDITION.
5. NO FINISHED FLOOR ELEVATION SHALL BE LESS THAN 4' ABOVE THE SEWER FLOW LINE AT POINT OF CONNECTION WITHOUT HAVING A PROPER BACKWATER VALVE INSTALLED IN THE LATERAL.
6. QUANTITIES SHOWN ARE FOR INFORMATION ONLY AND THE CITY OF RIVERSIDE IS NOT RESPONSIBLE FOR THEIR ACCURACY.
7. ANY TRAFFIC CONTROL STRIPING OBLITERATED AND/OR BADLY WORN DURING CONSTRUCTION SHALL BE RESTORED BY THE CONTRACTOR WITHIN FIVE DAYS AFTER NOTIFICATION FROM THE CITY INSPECTORS.
10. THE PRIVATE ENGINEER SIGNING THESE PLANS IS RESPONSIBLE FOR ASSURING THE ACCURACY AND ACCEPTABILITY OF THE WORK HEREON. IN THE EVENT OF DISCREPANCIES ARISING DURING CONSTRUCTION, THE PRIVATE ENGINEER SHALL BE RESPONSIBLE FOR DETERMINING AN ACCEPTABLE SOLUTION AND REVISING THE PLANS FOR APPROVAL BY THE CITY.
11. THE CONTRACTOR SHALL CALL IN A LOCATION REQUEST TO UNDERGROUND SERVICE ALERT PHONE NO. 1-800-422-4133, TWO WORKING DAYS BEFORE DIGGING. NO CONSTRUCTION PERMIT WILL BE ISSUED BY THE PUBLIC WORKS DEPARTMENT INVOLVING EXCAVATION FOR UNDERGROUND FACILITIES UNLESS THE APPLICANT HAS BEEN PROVIDED AN INQUIRY IDENTIFICATION NUMBER BY U.S.A.
12. THE PRIVATE ENGINEER PREPARING THESE PLANS SHALL BE RESPONSIBLE FOR PRESERVING OR RE-ESTABLISHING AND REFERENCING SURVEY MONUMENTS DESTROYED, DISTURBED OR BURIED AS A RESULT OF CONSTRUCTION SHOWN HEREON.
13. BEDDING SHALL BE PER CITY OF RIVERSIDE STANDARD DRAWING NO. 428 CASE I

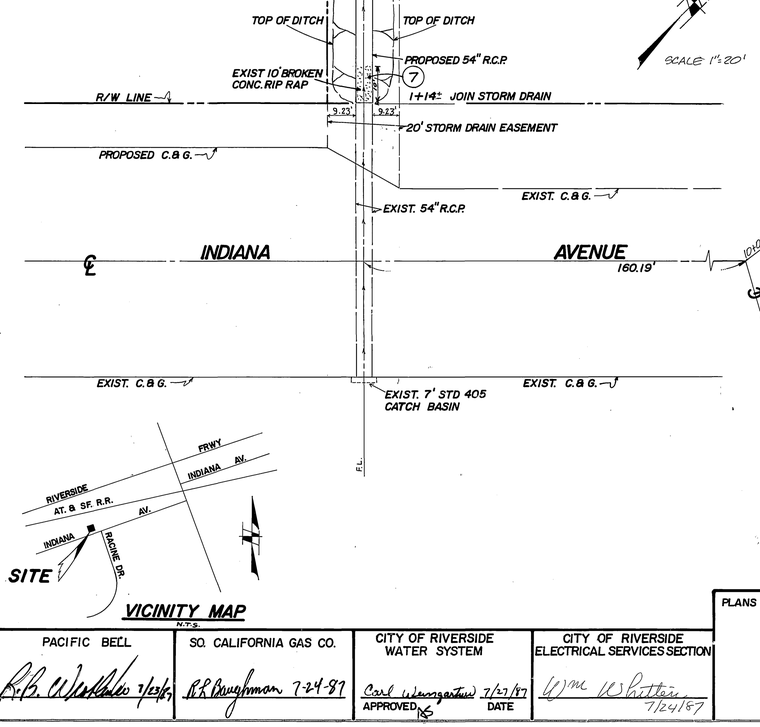

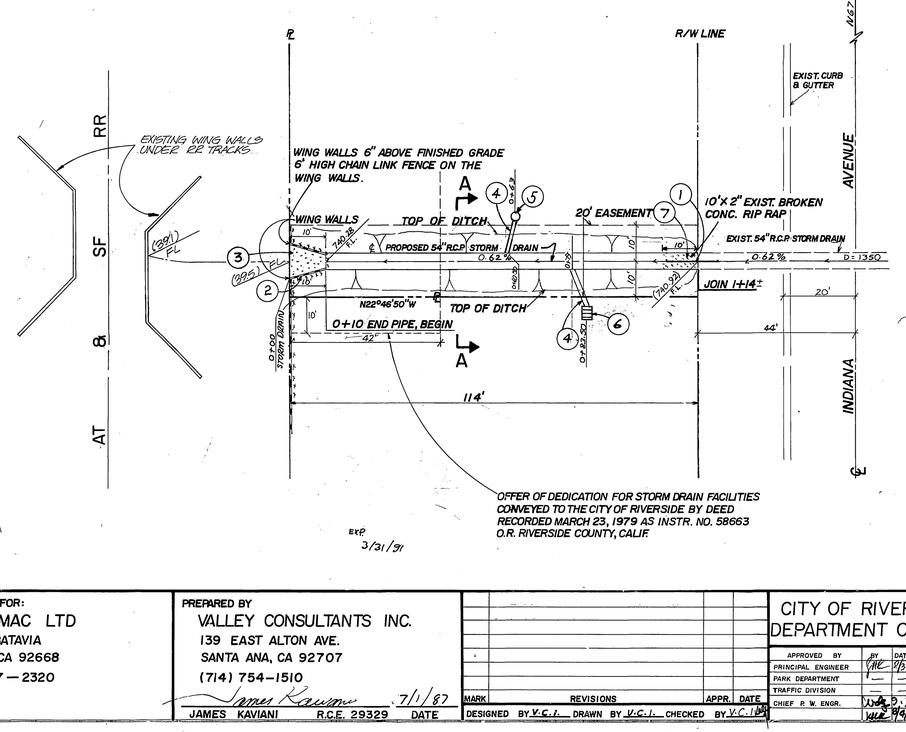

CONSTRUCTION NOTES

1. CONSTRUCT CONC. COLLAR PER STD. DRG. NO. 424
2. CONSTRUCT WINGWALL & ENDWALL PER CALTRANS STD PLAN NO. D86-B1 PER DETAIL
3. CONSTRUCT 10' OF CONCRETE RIP RAP
4. CONSTRUCT 15" R.C.P., 1000 D
5. CONSTRUCT PIPE RAISER + DEBRIS RACK CAGE PER CALTRANS STD PLAN NO. D96-2 PER DETAIL
6. CONSTRUCT INLET (SEE GRD. PLAN)
7. TO BE REMOVED (EXIST. RIP RAP)

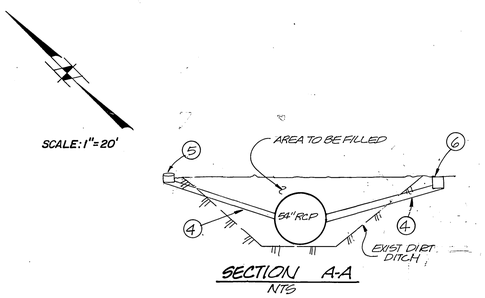

BENCHMARK

BRASS DISC SET IN CONCRETE STAMPED 601-25-68 ON WEST SIDE OF TYLER STREET 250' NORTH OF INDIANI AND 1' NORTHEAST OF BRIDGE NO 56-419

ELEV. = 756.665

* As built 6-7-88 TE

INDEXED 9-18-87 LH

PACIFIC BELL	SO. CALIFORNIA GAS CO.	CITY OF RIVERSIDE WATER SYSTEM	CITY OF RIVERSIDE ELECTRICAL SERVICES SECTION
R.B. Wooldridge 7/23/87	R.E. Brughman 7-24-87	Carl Weingartner 7/27/87 APPROVED DATE	Wm. W. Whitten 7/24/87

PLANS PREPARED FOR:
DAVID MAC LTD
874 N. BATAVIA
ORANGE, CA 92668
(714) 997-2320

PREPARED BY
VALLEY CONSULTANTS INC.
139 EAST ALTON AVE.
SANTA ANA, CA 92707
(714) 754-1510
James Kaviani 7/1/87
JAMES KAVIANI R.C.E. 29329 DATE

MARK	REVISIONS	APPR.	DATE
	DESIGNED BY V.C.I. DRAWN BY V.C.I. CHECKED BY V.C.I.		

CITY OF RIVERSIDE CALIFORNIA
DEPARTMENT OF PUBLIC WORKS

	APPROVED BY	DATE
PRINCIPAL ENGINEER		
PARK DEPARTMENT		
TRAFFIC DIVISION		
CHIEF P. W. ENGR.		

APPROVED BY Barry Bell
DIRECTOR OF PUBLIC WORKS
DATE 9/4/87

STORM DRAIN PLAN AND PROFILE
PARCEL MAP NO. 13156

10541 INDIANA AVENUE

HORIZ. SCALE: 1"= 20' VERT. SCALE: 1"= 2'

PROJECT NO. D - 521

SHEET 1 OF 1

FILE NO.

CITY BUSINESS LIC. NO. 25264 EXP. DATE June 29 1988