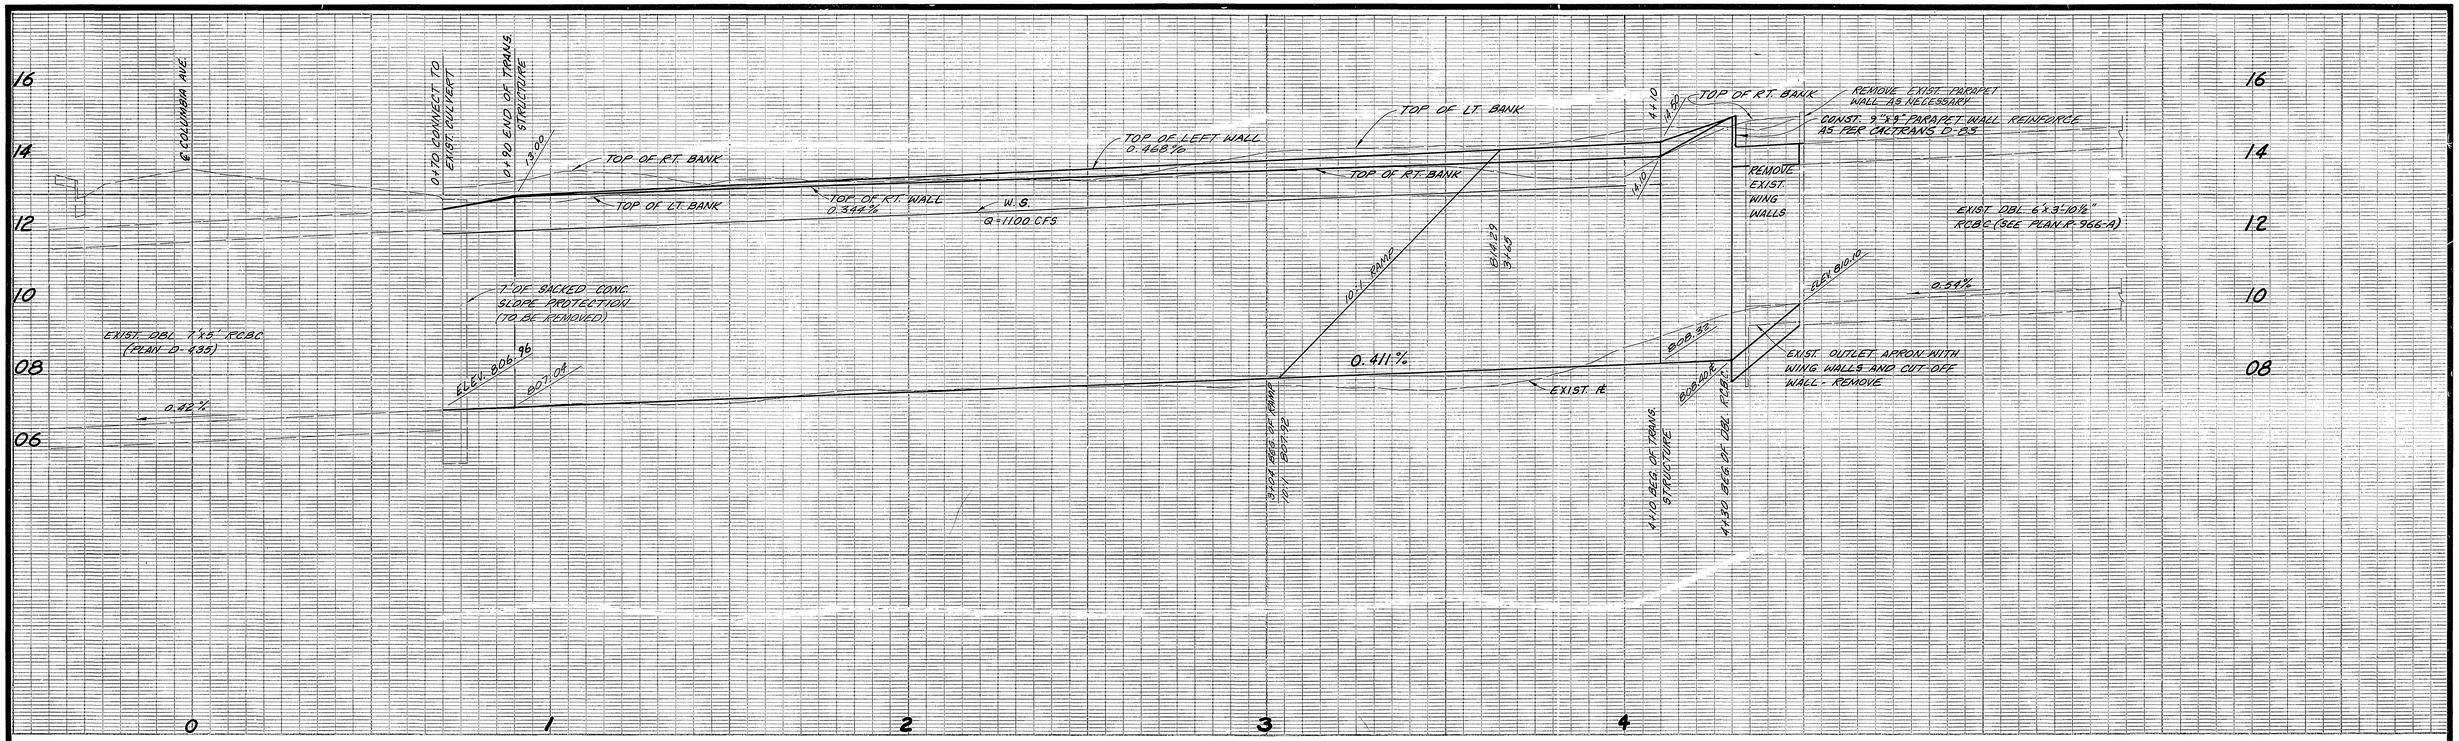

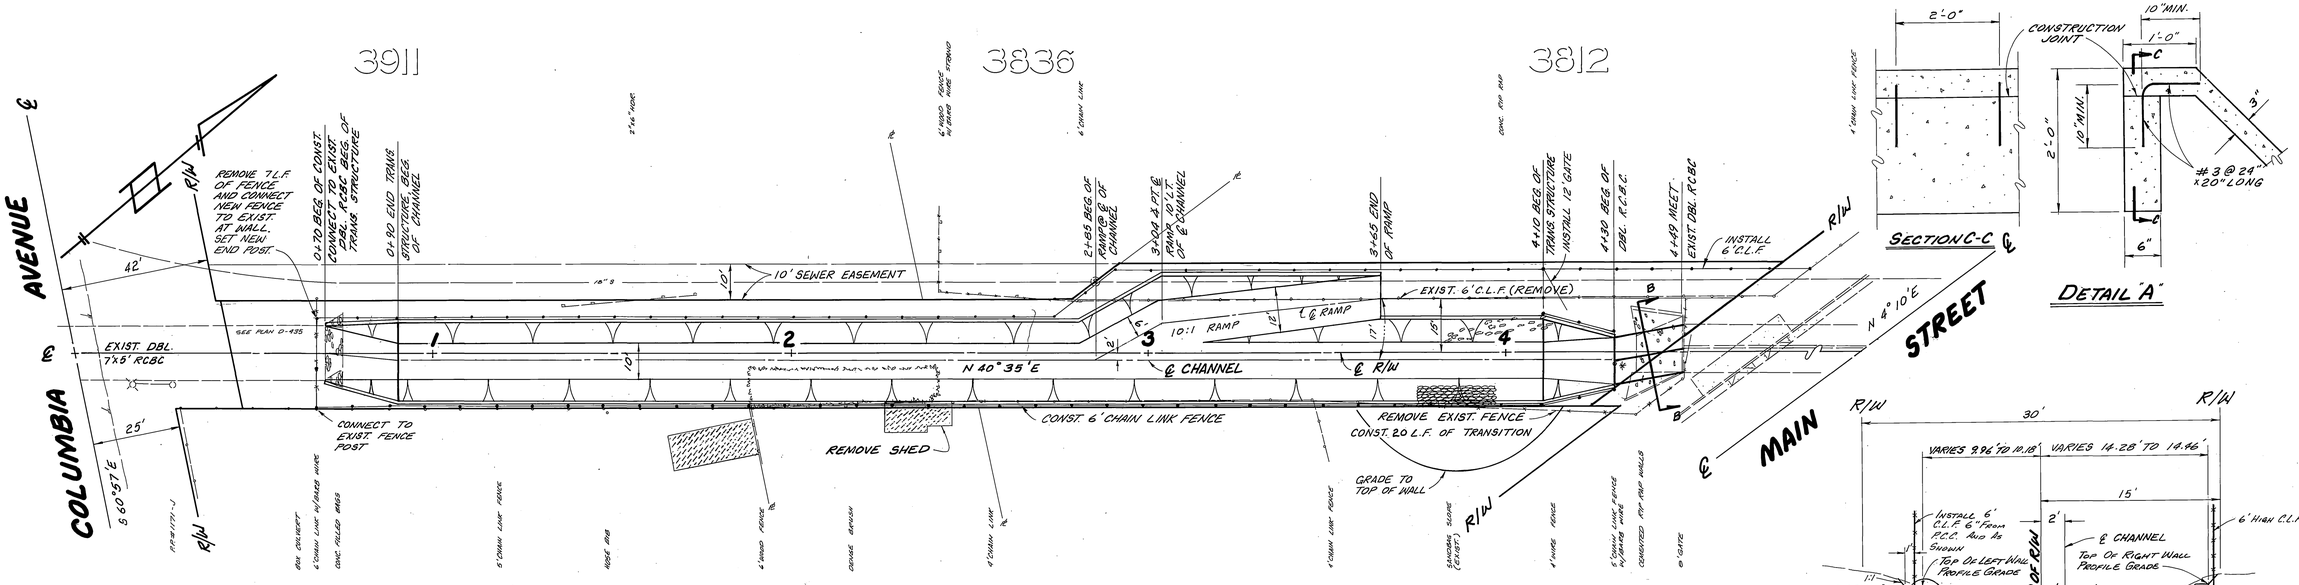

ENGINEER IN RESPONSIBLE CHARGE
HANS J. KAMRATH
R.C.E. 14712 expires 3/31/89
DATE 3/16/1988

REGISTERED PROFESSIONAL ENGINEER HANS J. KAMRATH NO: 14712 CIVIL STATE OF CALIFORNIA

*As built 2 2897℄

MARK	REVISIONS	APPR.	DATE

DESIGNED BY KHH DRAWN BY TE CHECKED BY

CITY OF RIVERSIDE
PUBLIC WORKS DEPARTMENT

APPROVED BY	DATE	BY
PRINCIPAL ENGINEER	3-28-88	
PARK DEPARTMENT		
TRAFFIC DIVISION		
CHIEF P. W. ENGINEER	4-7	
SURVEY 1/4/88 5PM	INSP 3/16/88 RC	

APPROVED BY
PUBLIC WORKS DIRECTOR
DATE April 7, 1988

SPRINGBROOK STORM DRAIN

BETWEEN COLUMBIA AVE. AND MAIN STREET

HORIZ. SCALE: 1"= 20' VERT. SCALE: 1"= 2'

ACCOUNT NO. 09-573-430

D-533

SHEET 1 OF 1

81630

OZALID- NO.1