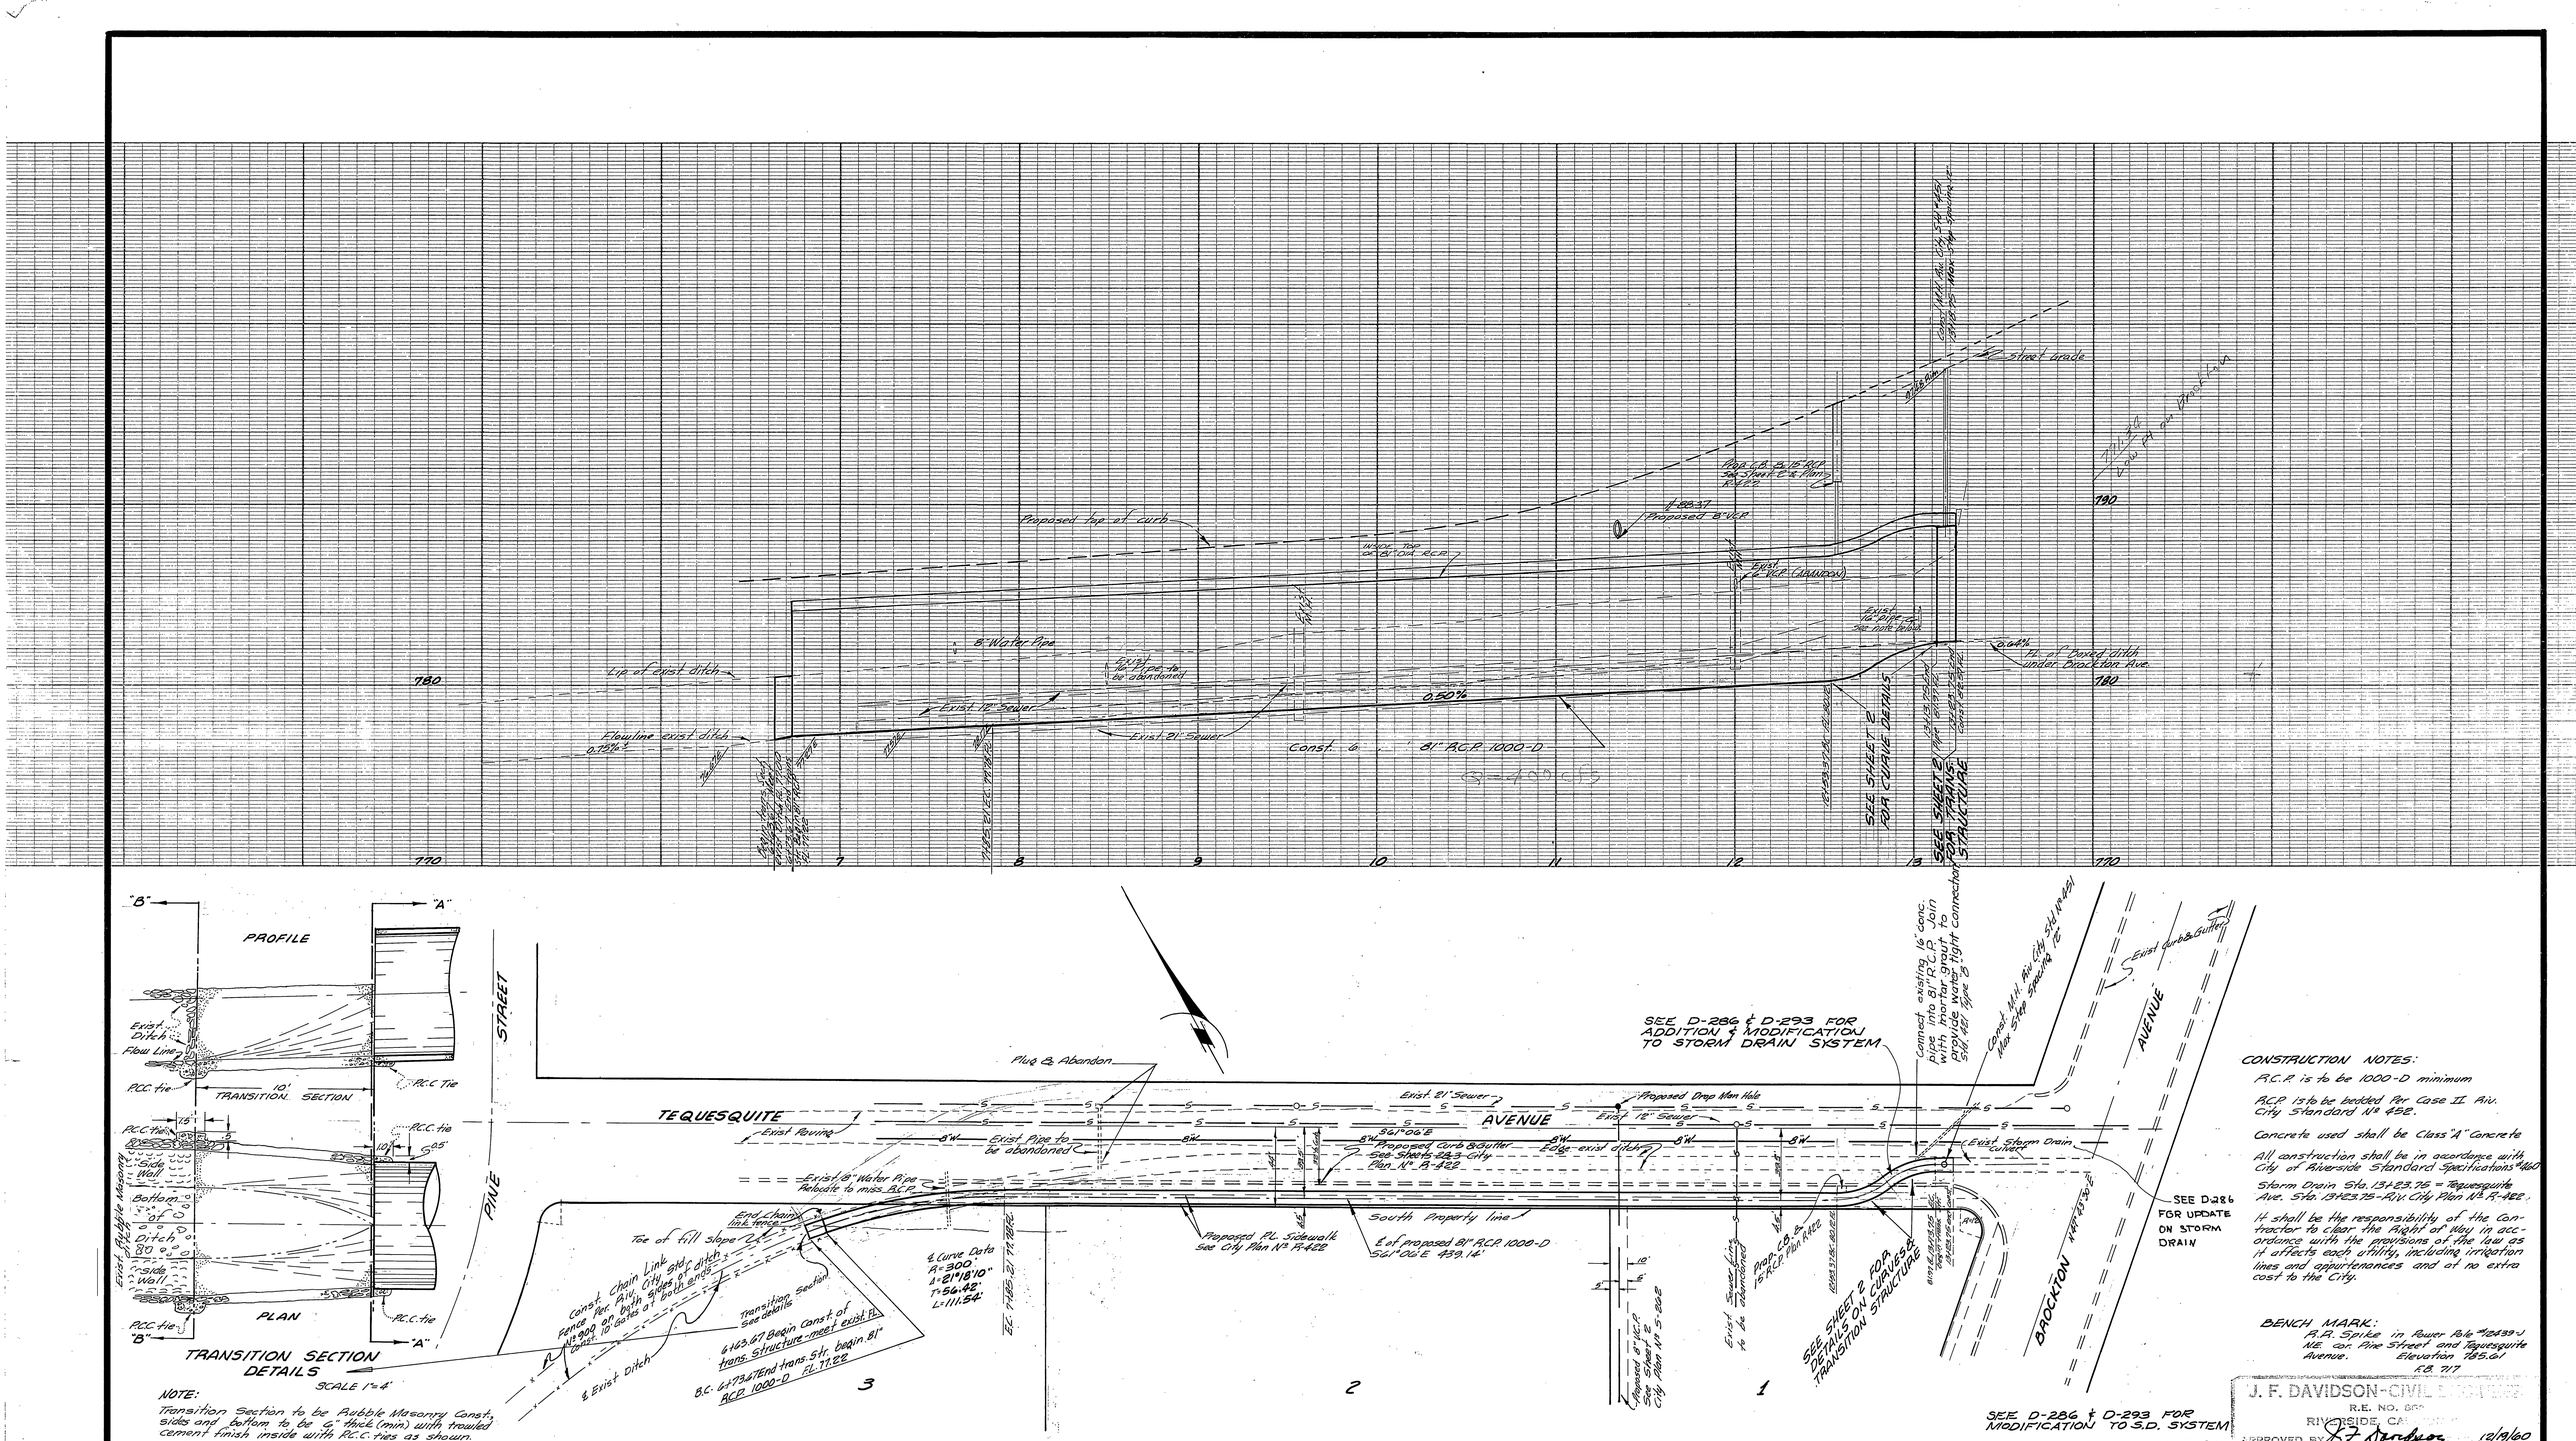
780
770
7
8
9
10
11
12
13
Proposed top of curb
Exist 12" Sewer
Exist 21" Sewer
Flowline exist ditch
0.75%±
Top of exist ditch
Const. 81" R.C.P. 1000-D
0.50%
Exist 12" Sewer

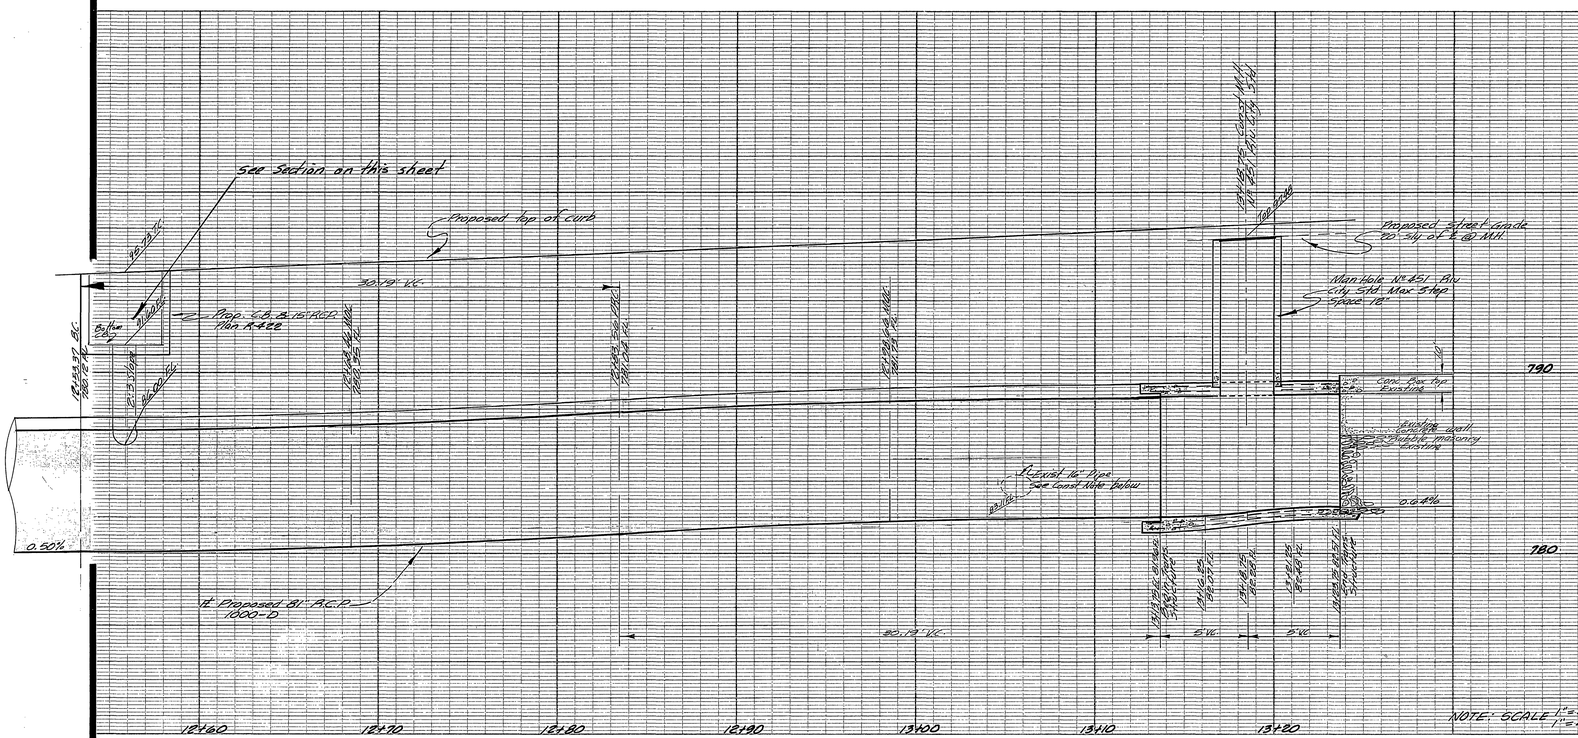

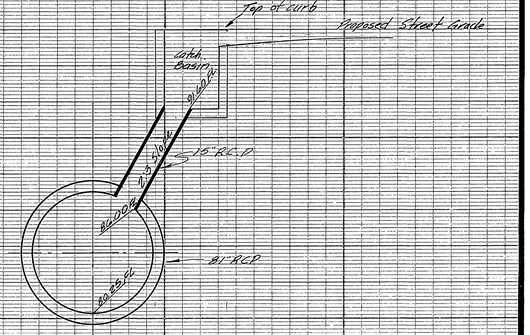

SECTION Showing 15" Pipe entering 81" RCP from Catch Basin

VALUES FOR STD. NO. 421 TYPE 'B'	
A	28"
B	16"
C	Join exist Pipe
D	81" RCP
E	8.75" ±
F	48"
G	40"
L	28"
R	Meet exist. Fl.
J	54"
K bar	#4 @ 4" oc.
M bar	#4 @ 4" oc.
T bar	#4 @ 6" oc.

SEE D-286 & D-293 FOR ADDITION AND MODIFICATION TO S.D. SYSTEM

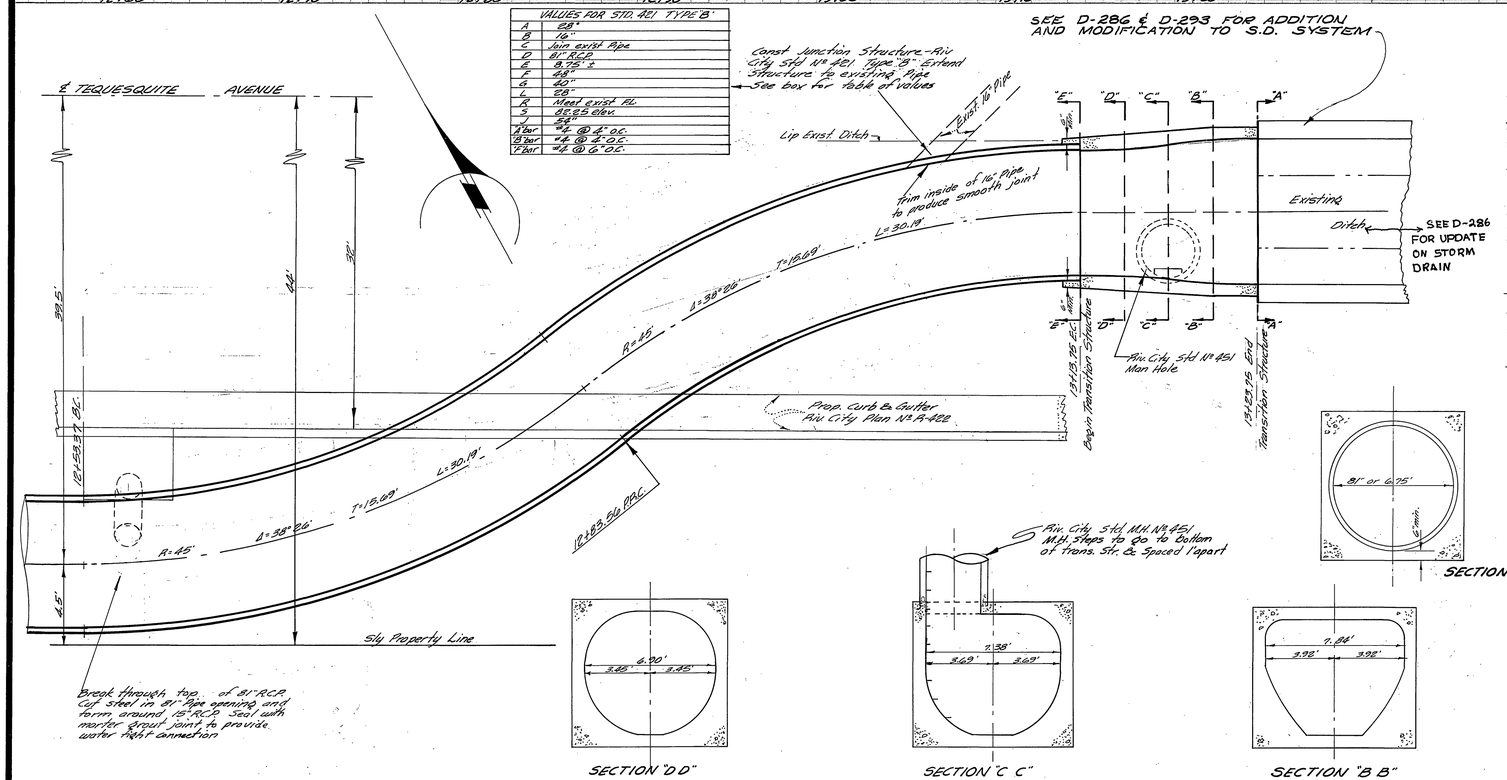

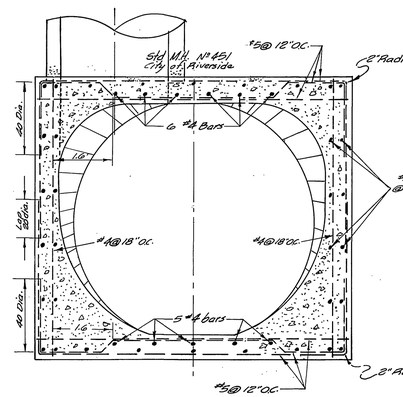

DETAIL – REINFORCING STEEL
From State of California Standard Single Box Culverts Standards
SCALE 1"=2'

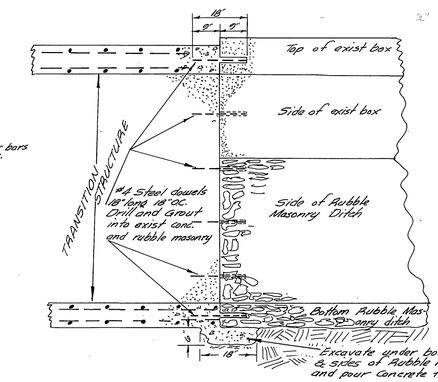

DETAIL – STEEL DOWELS & CONCRETE TIE
SCALE 1"=2'

NOTE:
Minimum thickness of concrete in Transition Str. shall be 8"
Class "A" Concrete to be used (6.0 sack)

SECTION "EE"

SECTION "D D"

SECTION "C C"

SECTION "B B"

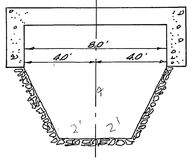

SECTION "A A"

BENCH MARK: R.R. Spike in Power Pole #12439-J NE corner Pine Street and Tequesquite Avenue
Elevation 785.61
F.B. 71/9

J.F. DAVIDSON-CIVIL ENGINEER
R.E. NO. 7414
J.F. Davidson 12/19/60

STORM DRAIN
DETAIL SHEET
TRANSITION STRUCTURE 13+23.75

TRACT 2175
1"=4' 1"=4'

D-56

2-6-61

2 2

1 2147