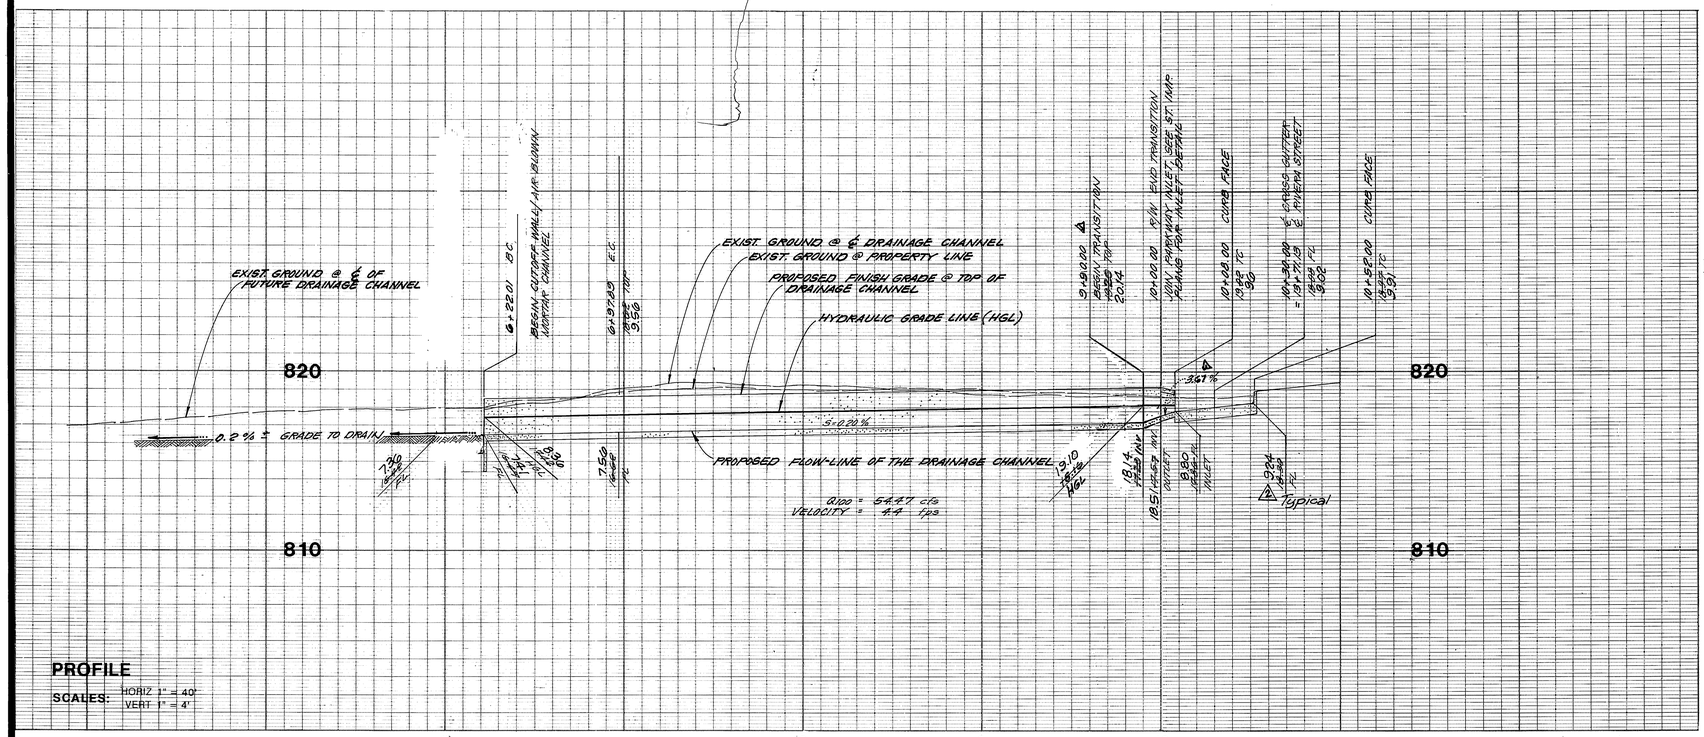

PROFILE

SCALES: HORIZ 1" = 40'
VERT 1" = 4'

PLAN

SCALE: 1" = 40'

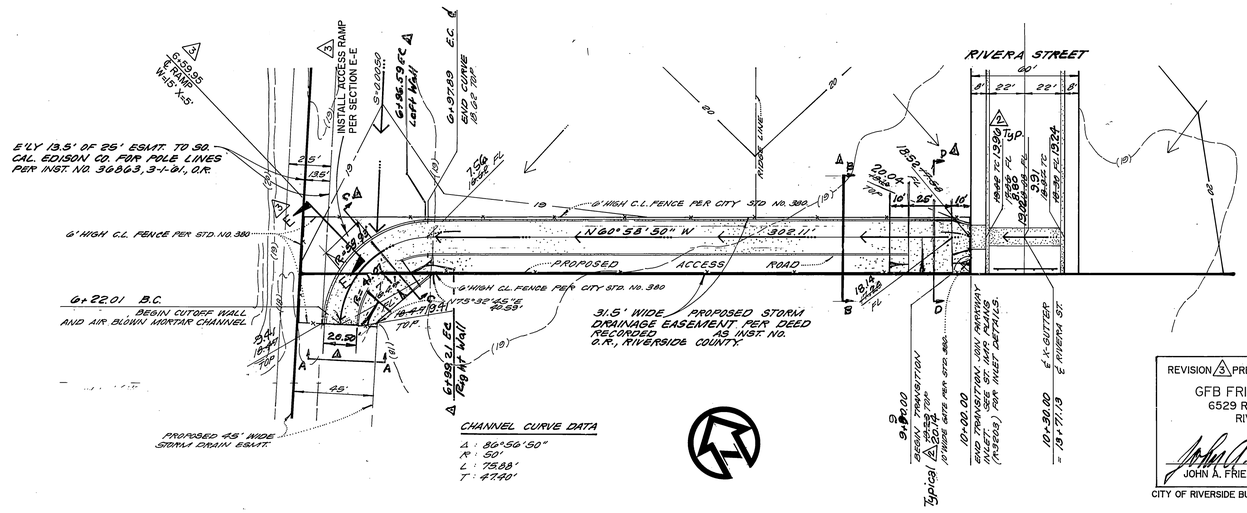

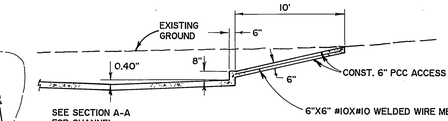

SECTION E-E
ACCESS RAMP NTS

REVISION 3 PREPARED UNDER THE SUPERVISION OF:
GFB FRIEDRICH & ASSOC., INC.
6529 RIVERSIDE AVE. STE. 230
RIVERSIDE, CA 92506
(909) 781-0811
JOHN A. FRIEDRICH, RCE 27861 — 12-29-97 DATE

CITY OF RIVERSIDE BUSINESS TAX CERTIFICATE NO.060137 EXP. 5-2-98

REGISTERED PROFESSIONAL ENGINEER JOHN A. FRIEDRICH NO. 27861 EXP. 3-31-98 CIVIL STATE OF CALIFORNIA

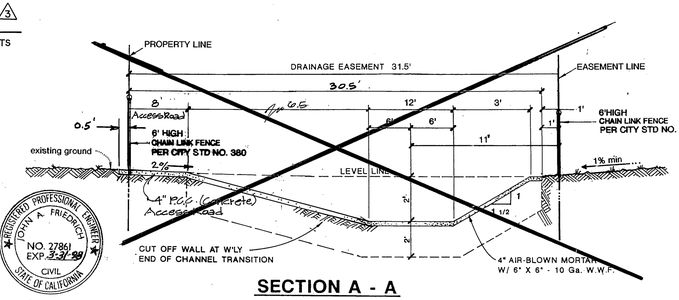

SECTION A - A
DRAINAGE CHANNEL
N.T.S.

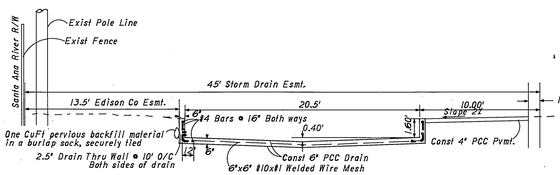

△ Section A-A

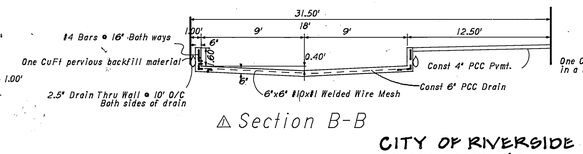

△ Section B-B

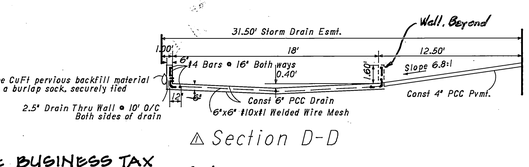

△ Section D-D

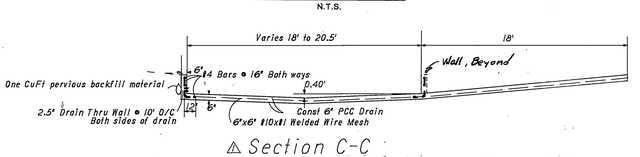

△ Section C-C

CITY OF RIVERSIDE BUSINESS TAX CERTIFICATE NO. 061133 , EXPIRES 12-31-9

CITY OF RIVERSIDE BUSINESS TAX CERTIFICATE NO. 061133 EXPIRES 9/22/95

BENCHMARK NO. K7-B

RIVERSIDE COUNTY SURVEYOR'S BRASS MONUMENT, CAPPED. AT THE INTERSECTION OF THE CENTERLINE OF NORTH MAIN STREET AND THE CENTERLINE OF PLACENTIA LANE.

ELEVATION: 833.594

48 hours **BEFORE** excavation...
1-800/422-4133
CALL Underground Service Alert

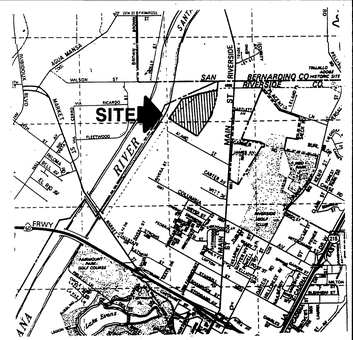

VICINITY MAP N.T.S.

GENERAL NOTES

1. It shall be the responsibility of the contractor to clear the right of way in accordance with the provisions of law as it affects each utility including irrigation lines and appurtenances and at no cost to the City.
2. Construction shall be in accordance with the City of Riverside Department of Public Works Standard drawings. Standard Drawing No. 10 and the Standard Specifications for Public Works Construction, current edition.
3. Quantities shown are for information only and the City of Riverside is not responsible for their accuracy.
4. All flagged elevations shall be staked in the field by the private engineer.
5. Before the rip rap is accepted, as priced at the outlet of any drainage structure, it shall be tested under flows as close as possible to design conditions with water obtained from fire hydrants in the immediate area.
6. The private engineer signing these plans is responsible for assuring the accuracy and acceptability of the work hereon. In the event of discrepancies arising during construction, the private engineer shall be responsible for determining an acceptable solution and revising the plans for approval by the City.
7. The contractor shall call in a location request to Underground Services Alert (USA) Phone No. 1-800-422-4133 two working days before digging. No construction permit will be issued by the Public Works Department involving excavation for underground facilities unless the applicant has been provided an inquiry identification number by U.S.A.
8. The Developer shall be responsible for preserving or re-establishing and referencing survey monuments destroyed, disturbed or buried as a result of the construction shown hereon.

Revisions by:
ADAMS & ELLS
Civil Engineers
320 B. Base Line Road, Suite 200
Claremont, CA. 91711
(909) 482-1581
REGISTERED PROFESSIONAL ENGINEER WILLIAM C. ELLS NO. 10660 CIVIL STATE OF CALIFORNIA
William C. Ells RCE 10660 Ex. 12/31/96 — 9/1/95 Date

PREPARED BY:
PHILIP E. BROWN
Professional Engineer
5635 Edgemont Dr.
San Bernardino, CA 92404
TEL: (909) 862-1565
FAX: (909) 862-3233
REGISTERED PROFESSIONAL ENGINEER PHILIP E. BROWN NO. 18679 CIVIL STATE OF CALIFORNIA
Philip E. Brown RCE 18679 Ex. 6/30/97 — 9/22/94 Date

PREPARED FOR:
GUTHRIE CONSTRUCTION
647 North Main, Ste 2C
Riverside, CA 92501
(714) 781 0640

MARK	REVISIONS	APPR.	DATE
1	Revised cross sections - Drainage Channel	WLE	9/1/95
2	Adjust elevations by 0.34' to conform to bench mark.	WLE	9/20/95
3	ADD CONC. ACCESS RAMP	WLE	12-29-97

CITY OF RIVERSIDE
PUBLIC WORKS DEPARTMENT

	APPROVED BY	DATE	BY
	PRINCIPAL ENGINEER	11/22/96	
	PARK DEPARTMENT		
	TRAFFIC DIVISION		
	CHIEF F. W. ENGINEER	12/19/96	
	ST. SERVICES	12/19/96	

APPROVED BY
PUBLIC WORKS DIRECTOR
DATE 12/12/96

STORM DRAIN PLAN
PARCEL MAP NO. 24758
HORIZ. SCALE: 1" = 40' VERT. SCALE: 1" = 4'

ACCOUNT NO.
D-598
SHEET 1 OF 1

BMI J.O. NO. 89-11-7
BMI DWG. NO. E-17-8

INDEXED 4-14-95 GH