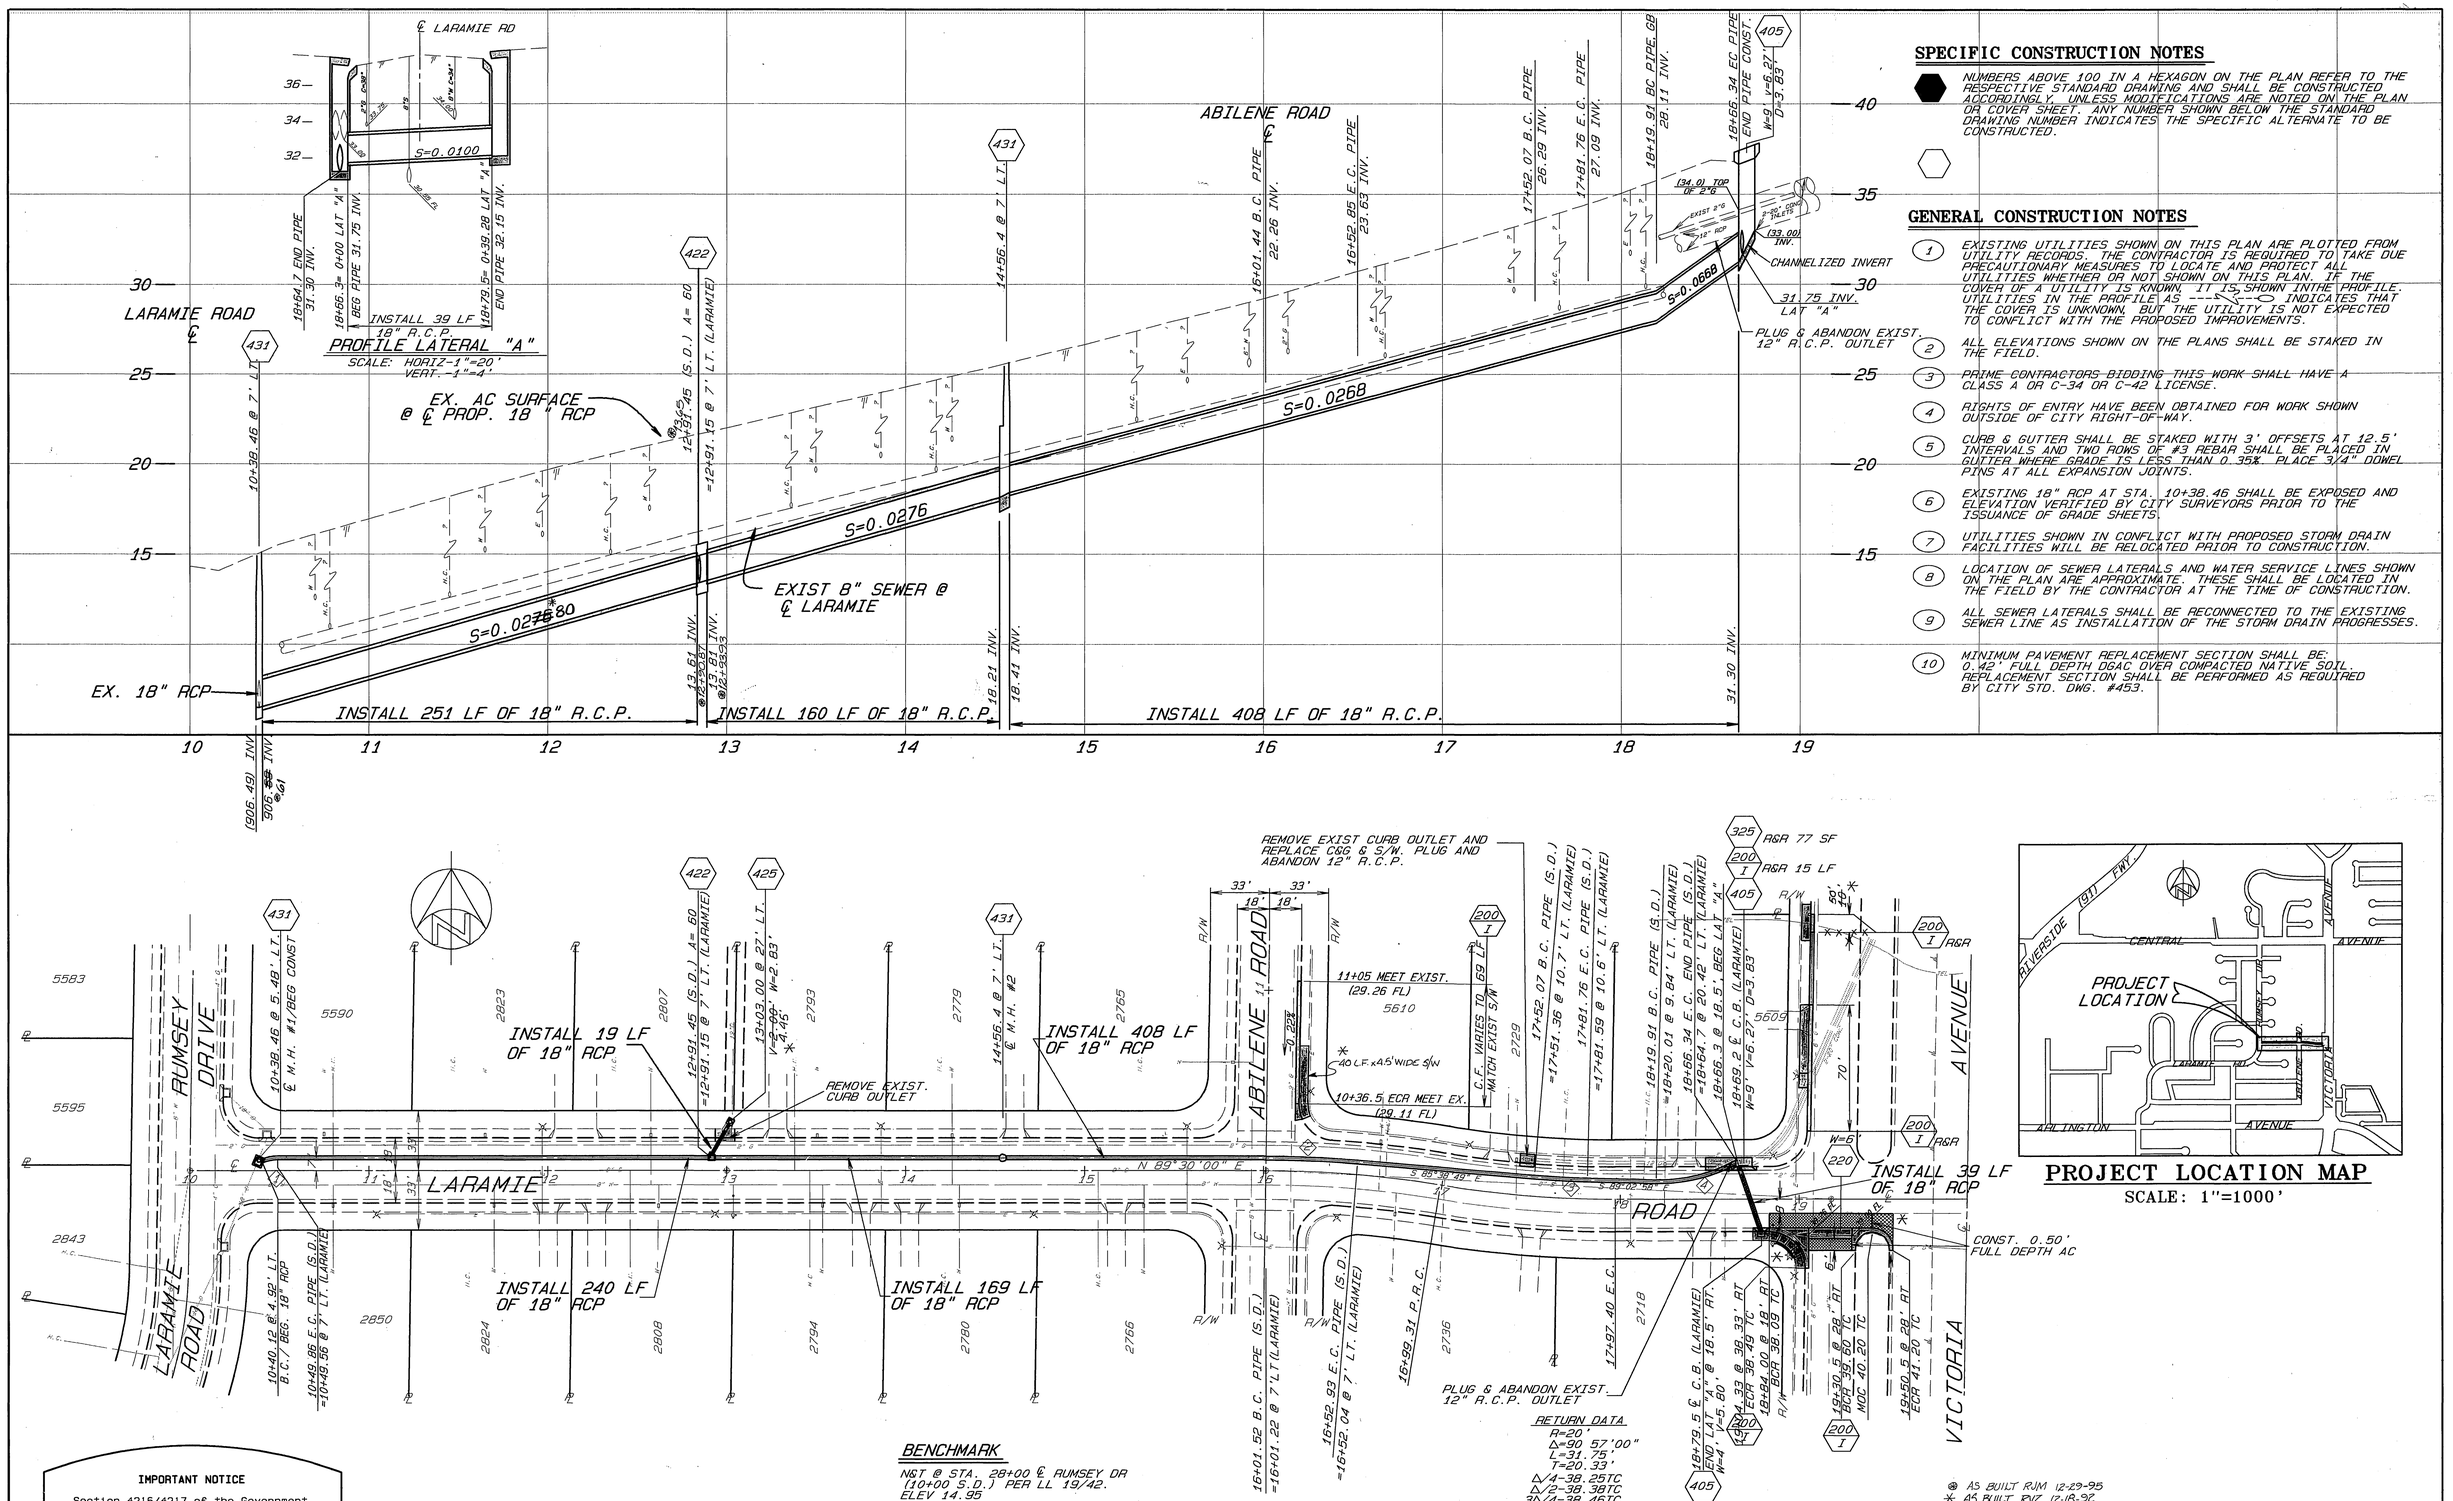

SPECIFIC CONSTRUCTION NOTES

NUMBERS ABOVE 100 IN A HEXAGON ON THE PLAN REFER TO THE RESPECTIVE STANDARD DRAWING AND SHALL BE CONSTRUCTED ACCORDINGLY, UNLESS MODIFICATIONS ARE NOTED ON THE PLAN OR COVER SHEET. ANY NUMBER SHOWN BELOW THE STANDARD DRAWING NUMBER INDICATES THE SPECIFIC ALTERNATE TO BE CONSTRUCTED.

GENERAL CONSTRUCTION NOTES

1. EXISTING UTILITIES SHOWN ON THIS PLAN ARE PLOTTED FROM UTILITY RECORDS. THE CONTRACTOR IS REQUIRED TO TAKE DUE PRECAUTIONARY MEASURES TO LOCATE AND PROTECT ALL UTILITIES WHETHER OR NOT SHOWN ON THIS PLAN. IF THE COVER OF A UTILITY IS KNOWN, IT IS SHOWN INTHE PROFILE. UTILITIES IN THE PROFILE AS ---><--- INDICATES THAT THE COVER IS UNKNOWN, BUT THE UTILITY IS NOT EXPECTED TO CONFLICT WITH THE PROPOSED IMPROVEMENTS.
2. ALL ELEVATIONS SHOWN ON THE PLANS SHALL BE STAKED IN THE FIELD.
3. PRIME CONTRACTORS BIDDING THIS WORK SHALL HAVE A CLASS A OR C-34 OR C-42 LICENSE.
4. RIGHTS OF ENTRY HAVE BEEN OBTAINED FOR WORK SHOWN OUTSIDE OF CITY RIGHT-OF-WAY.
5. CURB & GUTTER SHALL BE STAKED WITH 3' OFFSETS AT 12.5' INTERVALS AND TWO ROWS OF #3 REBAR SHALL BE PLACED IN GUTTER WHERE GRADE IS LESS THAN 0.35%. PLACE 3/4" DOWEL PINS AT ALL EXPANSION JOINTS.
6. EXISTING 18" RCP AT STA. 10+38.46 SHALL BE EXPOSED AND ELEVATION VERIFIED BY CITY SURVEYORS PRIOR TO THE ISSUANCE OF GRADE SHEETS.
7. UTILITIES SHOWN IN CONFLICT WITH PROPOSED STORM DRAIN FACILITIES WILL BE RELOCATED PRIOR TO CONSTRUCTION.
8. LOCATION OF SEWER LATERALS AND WATER SERVICE LINES SHOWN ON THE PLAN ARE APPROXIMATE. THESE SHALL BE LOCATED IN THE FIELD BY THE CONTRACTOR AT THE TIME OF CONSTRUCTION.
9. ALL SEWER LATERALS SHALL BE RECONNECTED TO THE EXISTING SEWER LINE AS INSTALLATION OF THE STORM DRAIN PROGRESSES.
10. MINIMUM PAVEMENT REPLACEMENT SECTION SHALL BE: 0.42' FULL DEPTH DGAC OVER COMPACTED NATIVE SOIL. REPLACEMENT SECTION SHALL BE PERFORMED AS REQUIRED BY CITY STD. DWG. #453.

PROJECT LOCATION MAP
SCALE: 1"=1000'

IMPORTANT NOTICE

Section 4216/4217 of the Government Code requires a Dig Alert Identification Number to be issued before a "Permit to Excavate" will be valid. For your Dig Alert I.D. Number call Underground Service Alert **TOLL FREE 1-800-422-4133** Two working days before you dig.

BENCHMARK

NGT @ STA. 28+00 ℄ RUMSEY DR (10+00 S.D.) PER LL 19/42. ELEV 14.95

CURVE DATA				
INDEX	R	Δ	T	L
1	22.5'	24°48'22"	4.95'	9.74'
2	607'	4°51'11"	25.72'	51.41'
3	500'	3°24'09"	14.85'	29.69'
4	90'	29°33'30"	23.74'	46.43'
5				

ENGINEER IN RESPONSIBLE CHARGE
Ronald C. Mueller
RONALD C. MUELLER
R.C.E. 29510 expires 3/31/95
DATE 8-3-92

REGISTERED PROFESSIONAL ENGINEER RONALD C. MUELLER NO. 29510 Expires 3/31/95 CIVIL STATE OF CALIFORNIA

MARK	REVISIONS	APPR.	DATE

DESIGNED BY RVZ DRAWN BY CS CHECKED BY RCM

CITY OF RIVERSIDE
PUBLIC WORKS DEPARTMENT

APPROVED BY	DATE	BY
DEPUTY P.W. DIRECTOR	8/11/92	RVZ
PRINCIPAL ENGINEER	8-4-92	RCM
CHIEF P.W. INSPECTOR		
SURVEYOR	7-29-92	RPH
TRAFFIC DIVISION	7-27-92	RC
PARKS DEPARTMENT		
STREET SERVICES	8-5-92	RE

APPROVED BY [signature] PUBLIC WORKS DIRECTOR
DATE Aug 12, 1992

LARAMIE ROAD STORM DRAIN EXT. RUMSEY TO VICTORIA

ACCOUNT NO. 09-573-446

D-601

SHEET 1 OF 1

HORIZ. SCALE: 1"= 40' VERT. SCALE: 1"= 4'

@ AS BUILT RJM 12-29-95
* AS BUILT RVZ 12-18-92

INDEXED 10-20-92 LH