SPECIFIC CONSTRUCTION NOTES

⬢ NUMBERS ABOVE 100 IN A HEXAGON ON THE PLAN REFER TO THE RESPECTIVE STANDARD DRAWING AND SHALL BE CONSTRUCTED ACCORDINGLY UNLESS MODIFICATIONS ARE NOTED ON THE PLAN OR COVER SHEET. ANY NUMBER SHOWN BELOW THE STANDARD DRAWING NUMBER INDICATES THE SPECIFIC ALTERNATE TO BE CONSTRUCTED.

(W) WATER SERVICES TO BE ADJUSTED BY THE P.U. WATER DIVISION PRIOR TO CONSTRUCTION.

GENERAL CONSTRUCTION NOTES

1. EXISTING UTILITIES SHOWN ON THIS PLAN ARE PLOTTED FROM UTILITY RECORDS. THE CONTRACTOR IS REQUIRED TO TAKE DUE PRECAUTIONARY MEASURES TO LOCATE AND PROTECT ALL UTILITIES WHETHER OR NOT SHOWN ON THIS PLAN. IF THE COVER OF A UTILITY IS KNOWN, IT IS SHOWN INTHE PROFILE. UTILITIES IN THE PROFILE AS ---*---○--- INDICATES THAT THE COVER IS UNKNOWN, BUT THE UTILITY IS NOT EXPECTED TO CONFLICT WITH THE PROPOSED IMPROVEMENTS.
2. ALL ELEVATIONS SHOWN ON THE PLANS SHALL BE STAKED IN THE FIELD.
3. PRIME CONTRACTORS BIDDING THIS WORK SHALL HAVE A CLASS A OR C-34 OR C-42 LICENSE.
4. UTILITIES SHOWN IN CONFLICT WITH PROPOSED STORM DRAIN FACILITIES WILL BE RELOCATED PRIOR TO CONSTRUCTION.
5. LOCATION OF SEWER LATERALS SHOWN ON THE PLAN ARE APPROXIMATE. SEWER LATERALS SHALL BE LOCATED IN THE FIELD BY THE CONTRACTOR AT THE TIME OF CONSTRUCTION.
6. ALL SEWER LATERALS SHALL BE RECONNECTED TO THE EXISTING SEWER LINE AS INSTALLATION OF THE STORM DRAIN PROGRESSES UPSTREAM. RECONNECTION SHALL INCLUDE THE NECESSARY PIPE EXTENSION OF ANY LATERAL LINE.
7. MINIMUM PAVEMENT REPLACEMENT SECTION SHALL BE: 0.50' FULL DEPTH D.G.A.C.

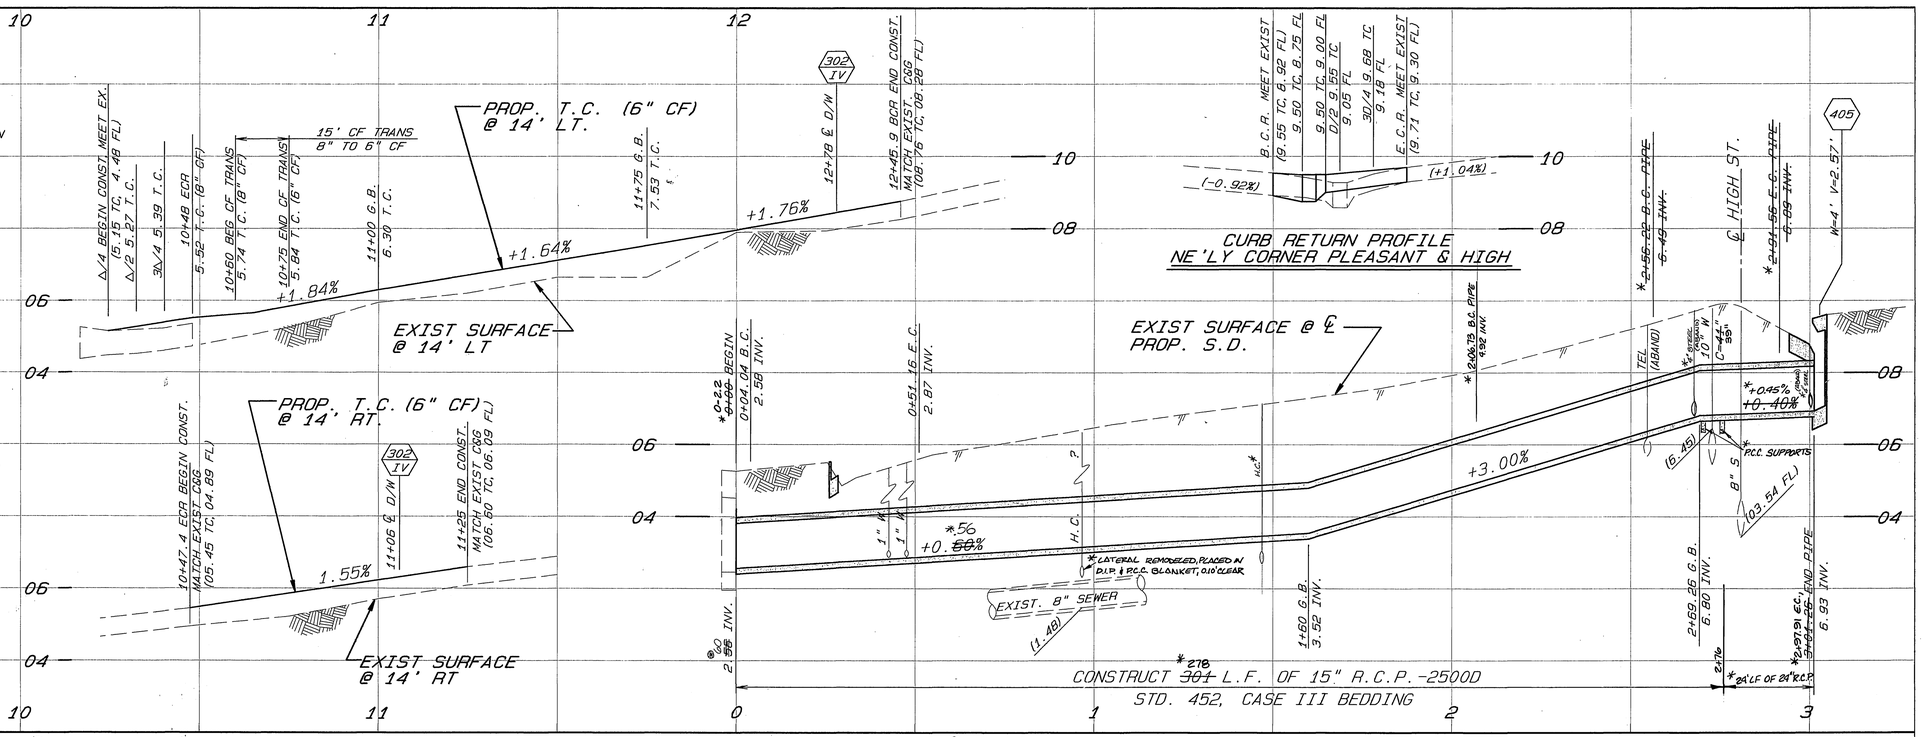

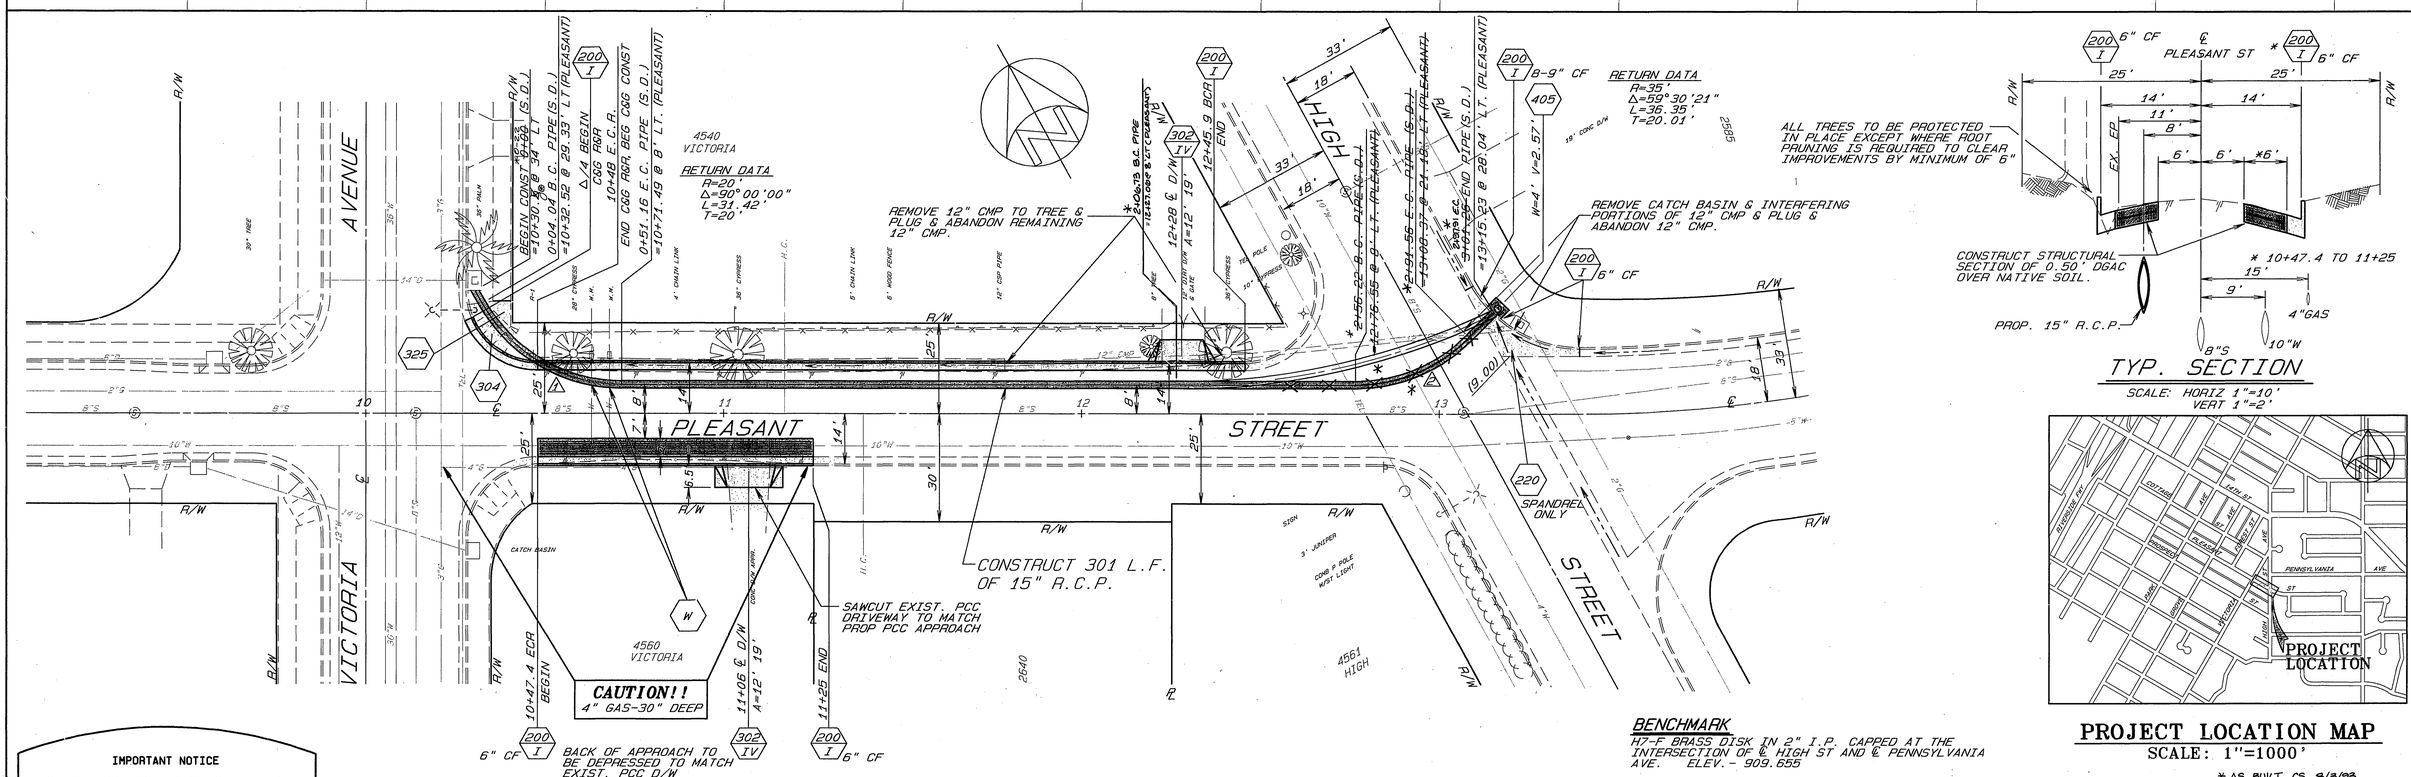

TYP. SECTION

SCALE: HORIZ 1"=10' VERT 1"=2'

PROJECT LOCATION MAP

SCALE: 1"=1000'

* AS BUILT CS 8/3/93

IMPORTANT NOTICE

Section 4216/4217 of the Government Code requires a Dig Alert Identification Number to be issued before a "Permit to Excavate" will be valid. For your Dig Alert I.D. Number call Underground Service Alert TOLL FREE 1-800-422-4133 Two working days before you dig.

CURVE DATA

INDEX	R	Δ	T	L
Δ/4	45'	60°00'00"	25.98'	47.12'
Δ/2	~~45'~~	~~45°00'00"~~	~~18.64'~~	~~35.34'~~
	204'	25° 30' 32"	46.36'	91.18'

ENGINEER IN RESPONSIBLE CHARGE
RONALD C. MUELLER
R.C.E. 29510 expires 3/31/95
DATE 8-3-92

REGISTERED PROFESSIONAL ENGINEER RONALD C. MUELLER NO. 29510 Expires 3/31/95 CIVIL STATE OF CALIFORNIA

DESIGNED BY CS DRAWN BY CS CHECKED BY RCM

MARK	REVISIONS	APPR.	DATE

BENCHMARK
H7-F BRASS DISK IN 2" I.P. CAPPED AT THE INTERSECTION OF ℄ HIGH ST AND ℄ PENNSYLVANIA AVE. ELEV. - 909.655

CITY OF RIVERSIDE
PUBLIC WORKS DEPARTMENT

APPROVED BY	DATE	BY
DEPUTY P.W. DIRECTOR	8/11/92	RM.C.
PRINCIPAL ENGINEER	8/6/92	RC
CHIEF P.W. INSPECTOR		
SURVEYOR	7-31-92	SPH
TRAFFIC DIVISION	7-30-92	
PARKS DEPARTMENT		
STREET SERVICES	8-5-92	

APPROVED BY
PUBLIC WORKS DIRECTOR
DATE 8/12/92

PLEASANT ST. STORM DRAIN VICTORIA AVE TO HIGH ST

ACCOUNT NO. 09-573-451

D-602

SHEET 1 OF 1

HORIZ. SCALE: 1"= 20' VERT. SCALE: 1"= 2'

INDEXED 9-1-93 GH