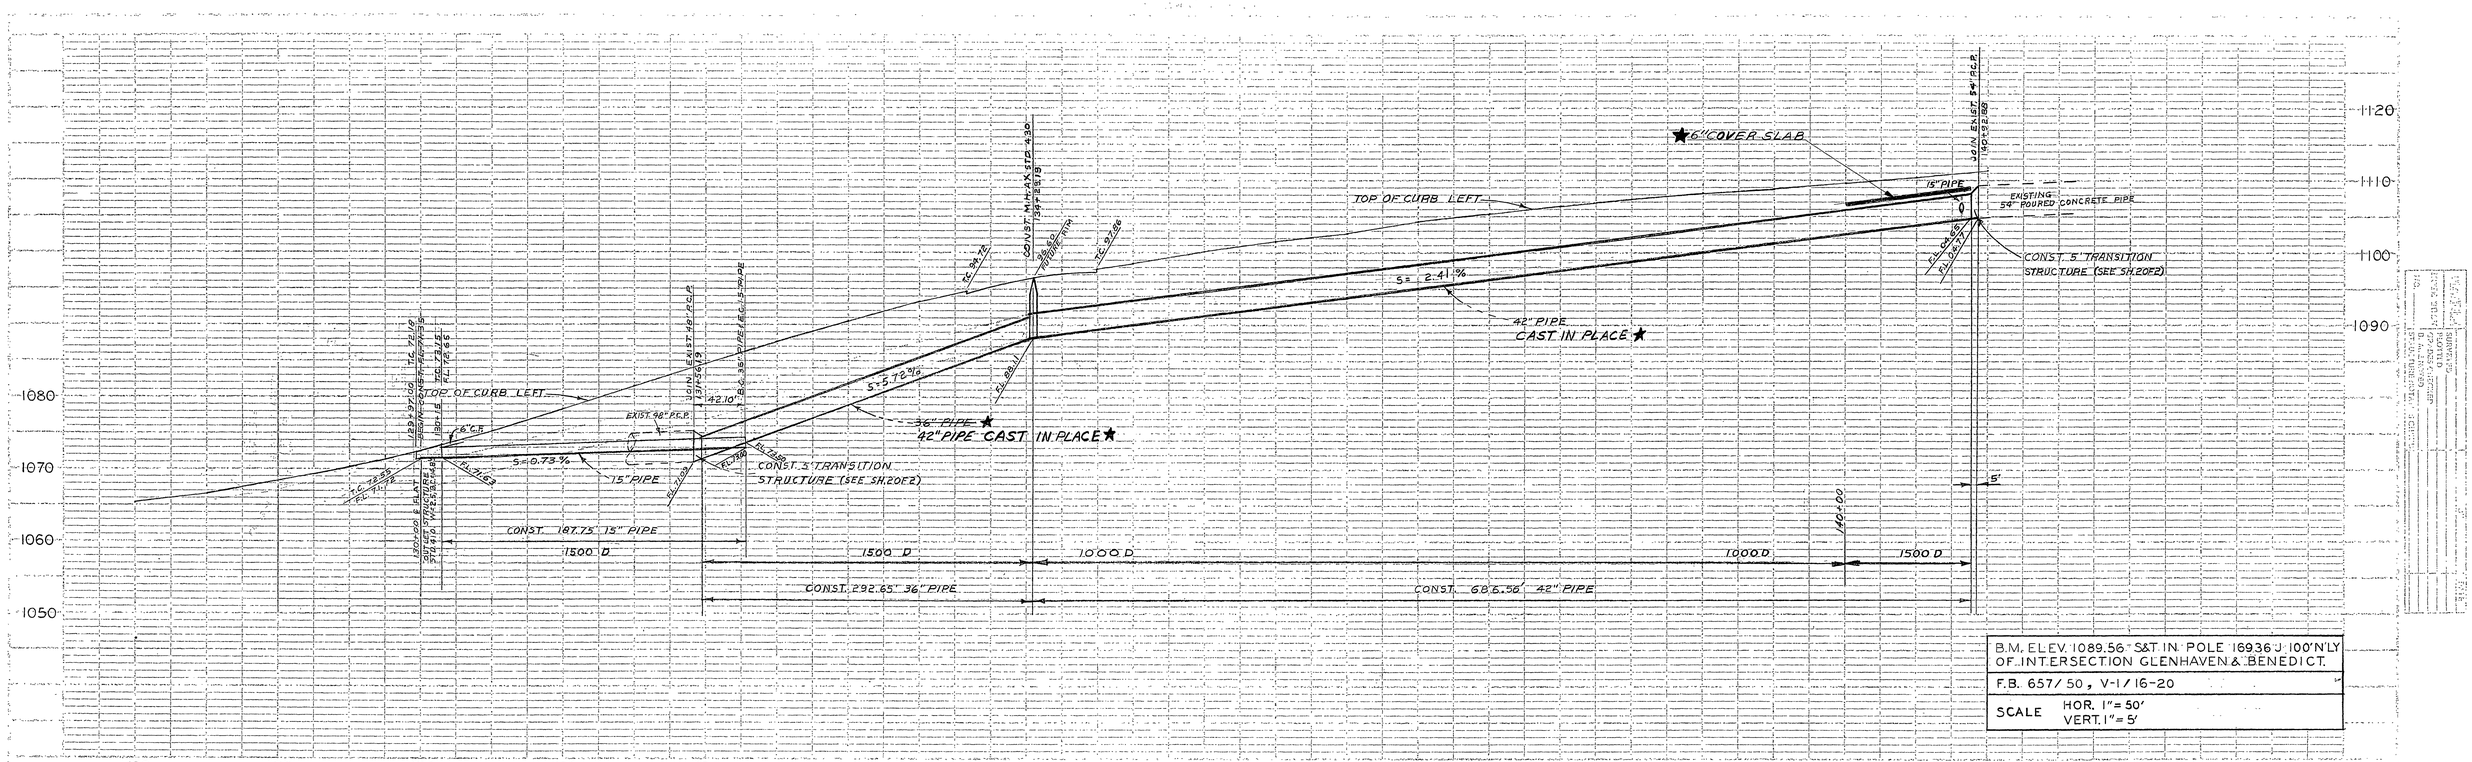

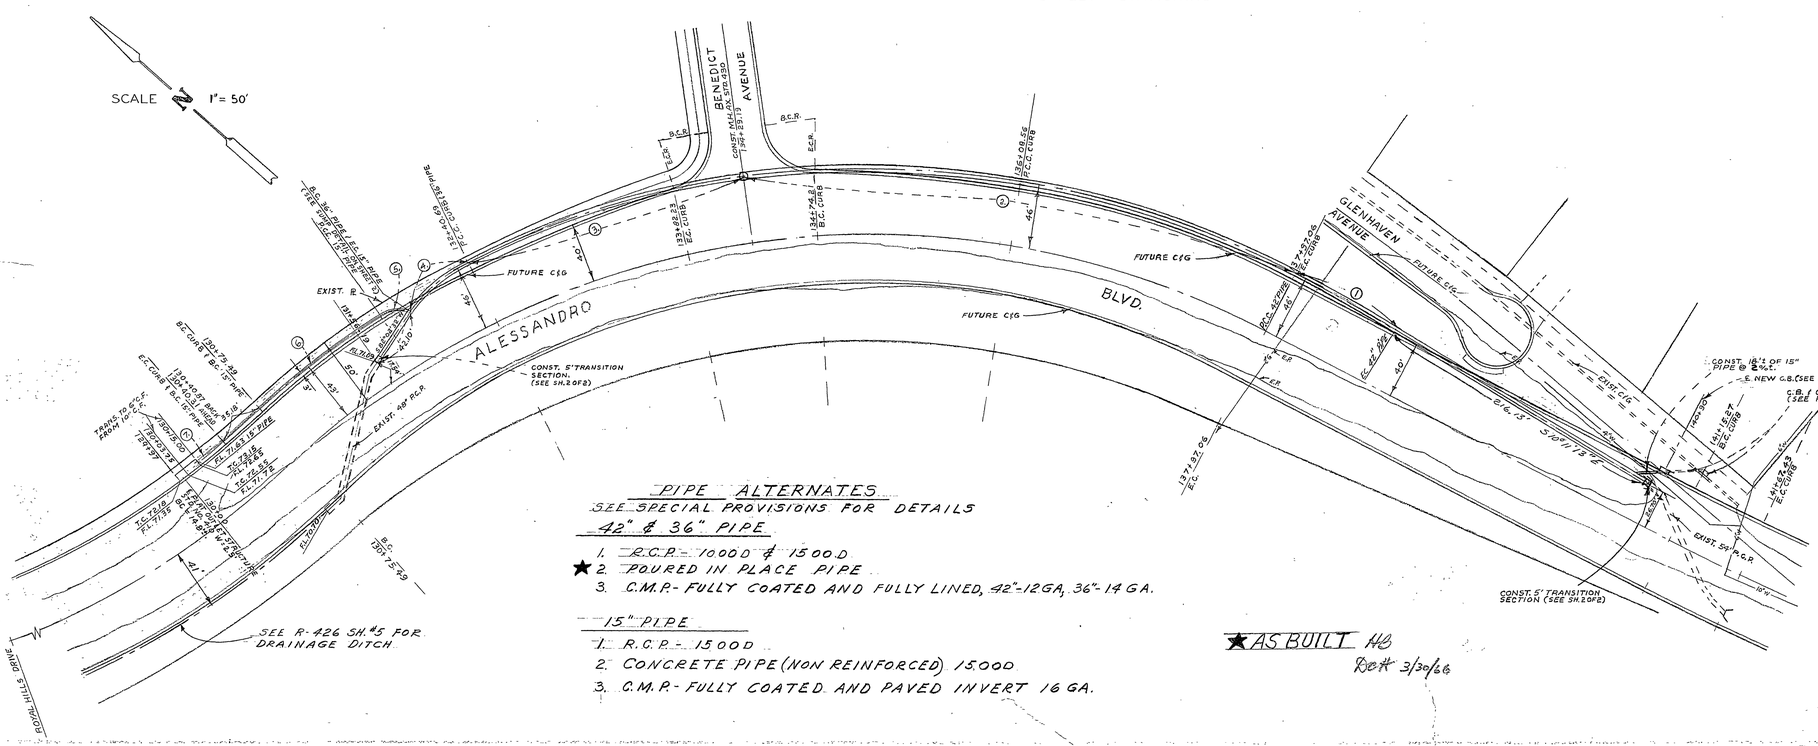
SCALE 1"= 50'
BENEDICT AVENUE
GLENHAVEN AVENUE
ALESSANDRO BLVD.
ROYAL HILLS DRIVE
FUTURE C/LG
EXIST. R/
EXIST. 48" R.C.P.
EXIST. 54" R.C.P.
CONST. 5' TRANSITION SECTION. (SEE SH.20F2)
CONST. 5' TRANSITION SECTION (SEE SH.20F2)
CONST. 16'± OF 15" PIPE @ 2%±.
E. NEW C.B. (SEE R-426 SHT.5)
C.B. & C.M.P. TO BE REMOVED (SEE R-426 SHT.6)
SEE R-426 SH.#5 FOR DRAINAGE DITCH
TRANS. TO 5'-0" C.C.P. FROM 15" R.C.P.
EXIST. 36" R.C.P.
EXIST. 54" R.C.P.

MISSION BLUEPRINT CO

TRANSITION SECTION NOTES

1. CONCRETE SHALL BE CLASS "A"
2. FLOOR OF STRUCTURE SHALL BE STEEL TROWELED TO SPRING LINE.
3. REINFORCING STEEL SHALL BE ROUND, DEFORMED, STRAIGHT BARS 1½" CLEAR FROM FACE OF CONCRETE.
4. TRANSITION STRUCTURE SHALL BE POURED IN ONE CONTINUOUS OPERATION EXCEPT THAT THE CONTRACTOR SHALL HAVE THE OPTION OF PLACING A CONSTRUCTION JOINT WITH LONGITUDINAL KEYWAY AT THE SPRING LINE.

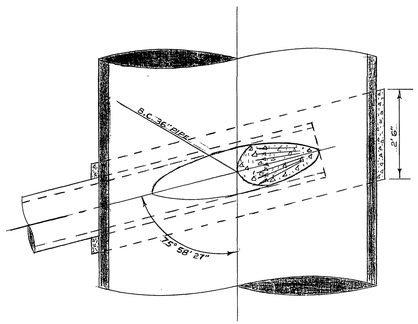

SECTION A—A

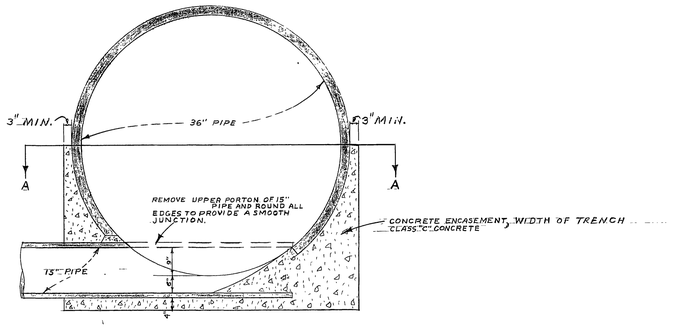

BLEEDER SUMP DETAIL

CONTRACTOR MAY USE A FORMED OR A PRECAST BLEEDER SUMP AT HIS OPTION. (TO BE APPROVED BY CITY ENGINEER.)

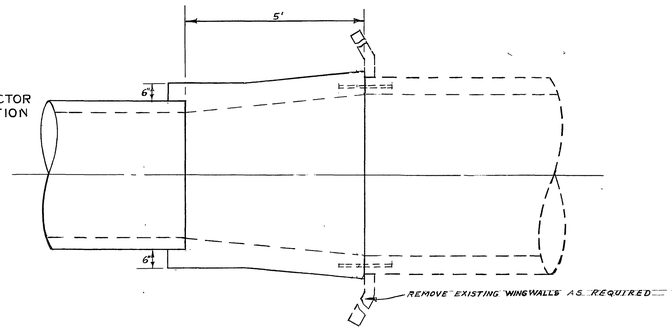

5' LONG TRANSITION SECTION
TOP VIEW

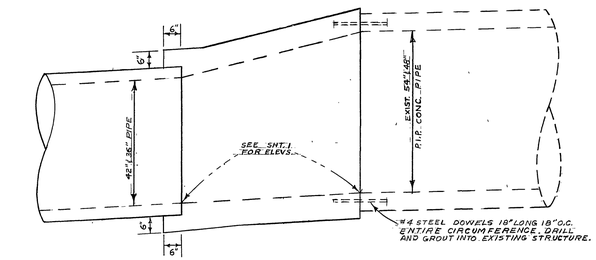

5' LONG TRANSITION SECTION
SIDE VIEW
SCALE 1"=2'

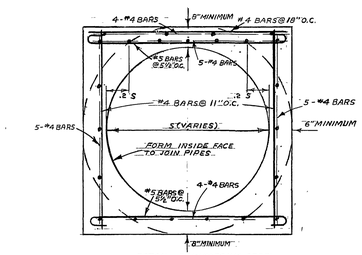

DETAIL REINFORCING STEEL
FROM STATE OF CALIFORNIA STD. BOX CULVERT

5' LONG TRANSITION SECTION
SCALE 1"=2'

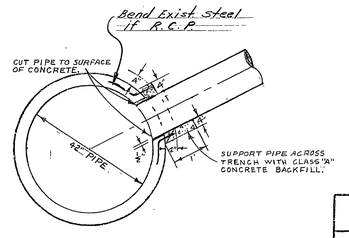

15" PIPE CONNECTION TO STORM DRAIN
SCALE 1"=2'
STA. 140 + 75 ±

REVISIONS			CITY OF RIVERSIDE CALIFORNIA
MARK	DATE	DESCRIPTION	DEPARTMENT OF PUBLIC WORKS
			ALESSANDRO BLVD. STORM DRAIN
			ROYAL HILLS DRIVE TO GLENHAVEN AVE.

DESIGNED BY CMJ
DRAWN BY RR
CHECKED BY CMW WDG WMK
RECOMMENDED BY ASSISTANT CITY ENGINEER
APPROVED BY DIRECTOR OF PUBLIC WORKS
DATE 11-15-61

D-67
SHEET 2 OF 2

INDEXED

7. H. Ove