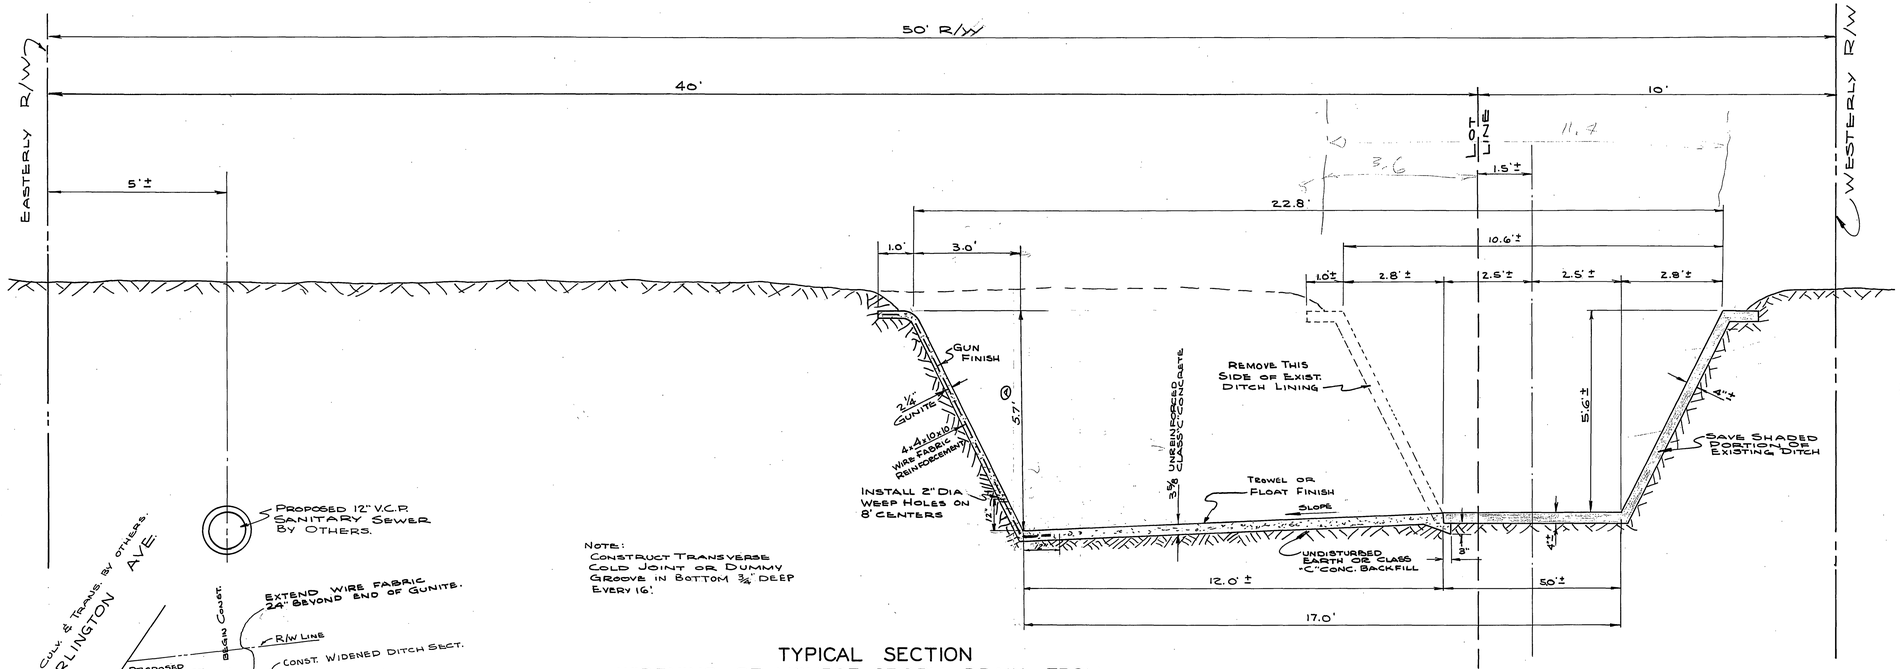

TYPICAL SECTION
WIDENING OF MONROE STORM DRAIN FROM
ARLINGTON AVE. TO COLORADO AVE.
SCALE ½"= 1'-0"

PLAN SHOWING
LOCATION OF EXISTING LINED
DITCH TO BE WIDENED

NOTES:
ALL FENCES ON EASTERLY SIDE OF EXISTING DITCH TO BE RELOCATED TO EASTERLY R/W LINE BY OTHERS

ALL IRRIGATION FACILITIES WITHIN R/W TO BE RELOCATED OR MODIFIED BY OTHERS (SEE SPECS.)

partially superseded

FIELD BOOK 555

REVISIONS			CITY OF RIVERSIDE DEPARTMENT OF PU
MARK	DATE	DESCRIPTION	
Ⓐ	9-4-56	CHANGED 6'-0" DIM. to 5.7'	MONROE · STORM · DRAIN FROM ARLINGTON AVENUE TO COLORADO AVENUE

DESIGNED BY F.L.
DRAWN BY [signature]
RECOMMENDED BY [signature] ASSISTANT CITY ENGINEER
CHECKED BY [signature]
APPROVED BY [signature] DIRECTOR OF PUBLIC WORKS
DATE July 25, 1956

D-7

INDEXED

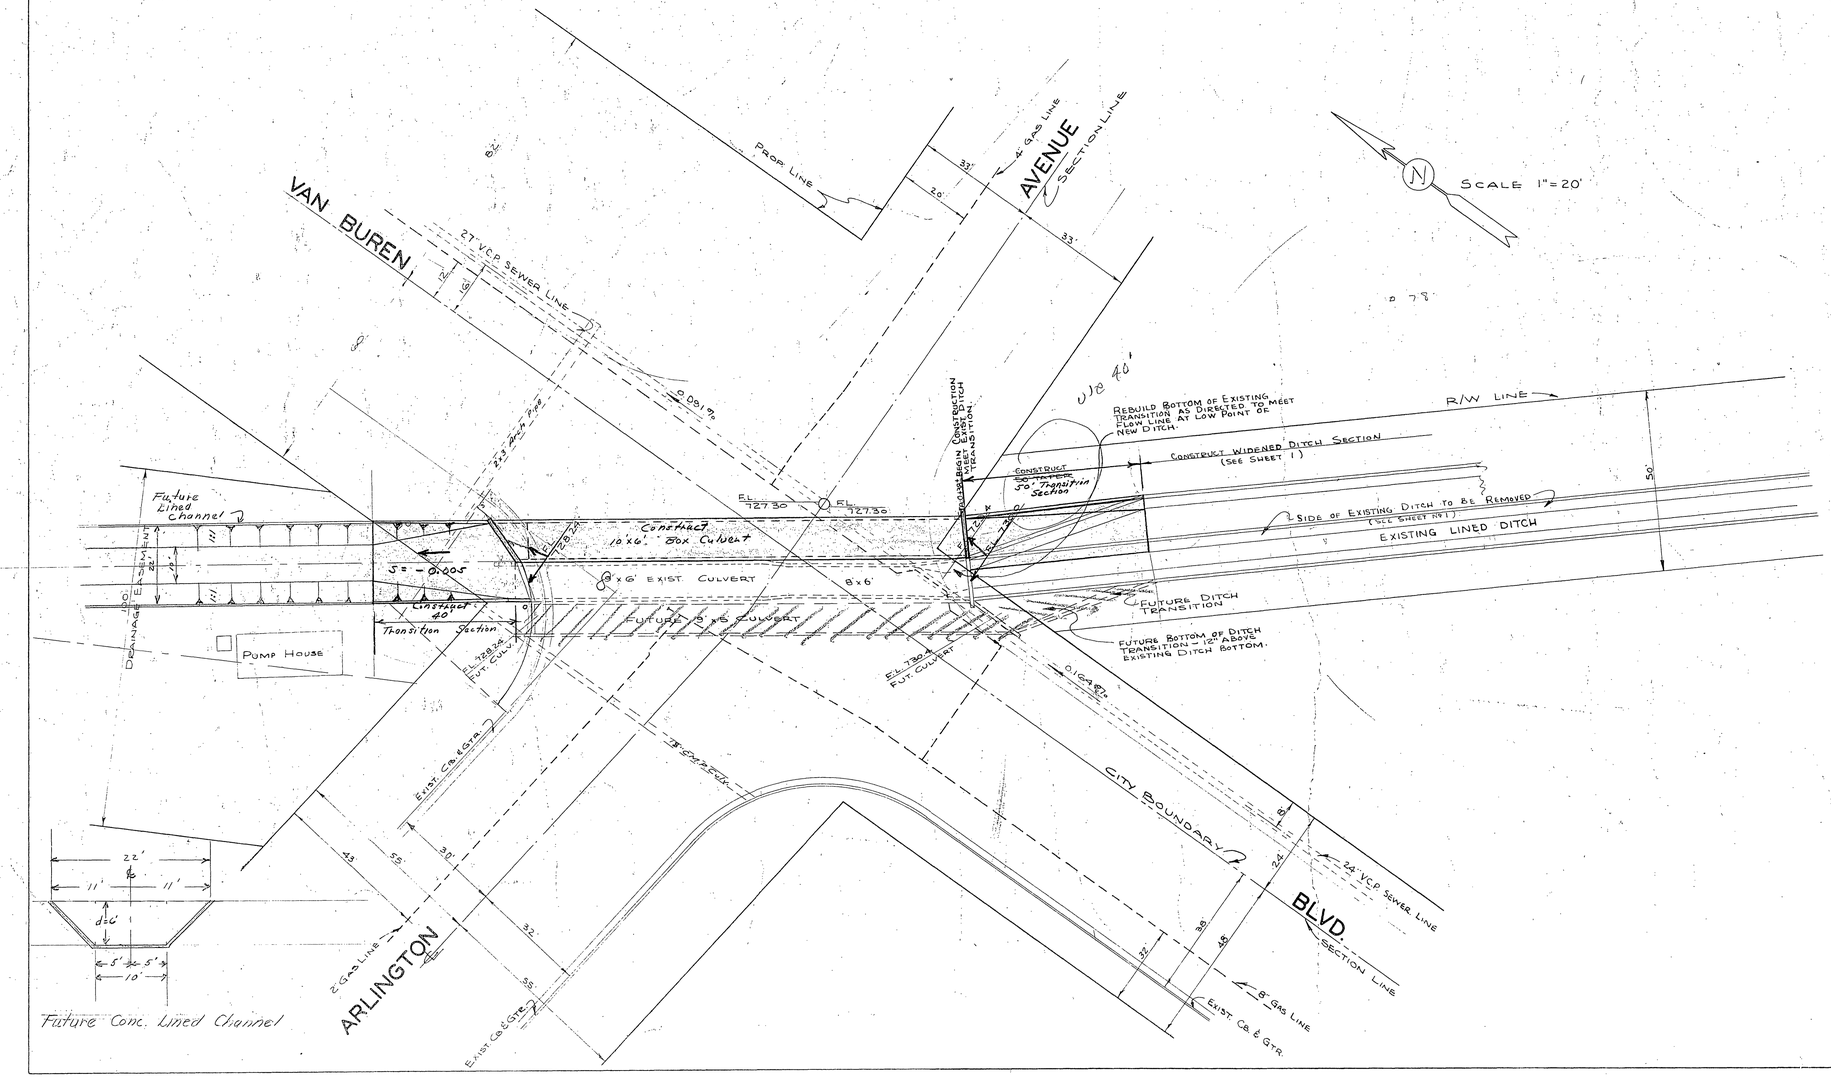

PRELIMINARY
SUBJECT TO REVISION

FIELD BOOKS
555 / 43-74

REVISIONS			CITY OF RIVERSIDE CALIFORNIA
MARK	DATE	DESCRIPTION	DEPARTMENT OF PUBLIC WORKS
			MONROE · STORM · DRAIN FROM ARLINGTON AVENUE TO COLORADO AVENUE
DESIGNED BY F.L.	CHECKED BY		APPROVED BY
DRAWN BY D. Barnes	Ken S. Whitaker		DIRECTOR OF PUBLIC WORKS
RECOMMENDED BY Hall M. Hoot ASSISTANT CITY ENGINEER			DATE
			D-7 SHEET 2 OF 2

INDEXED