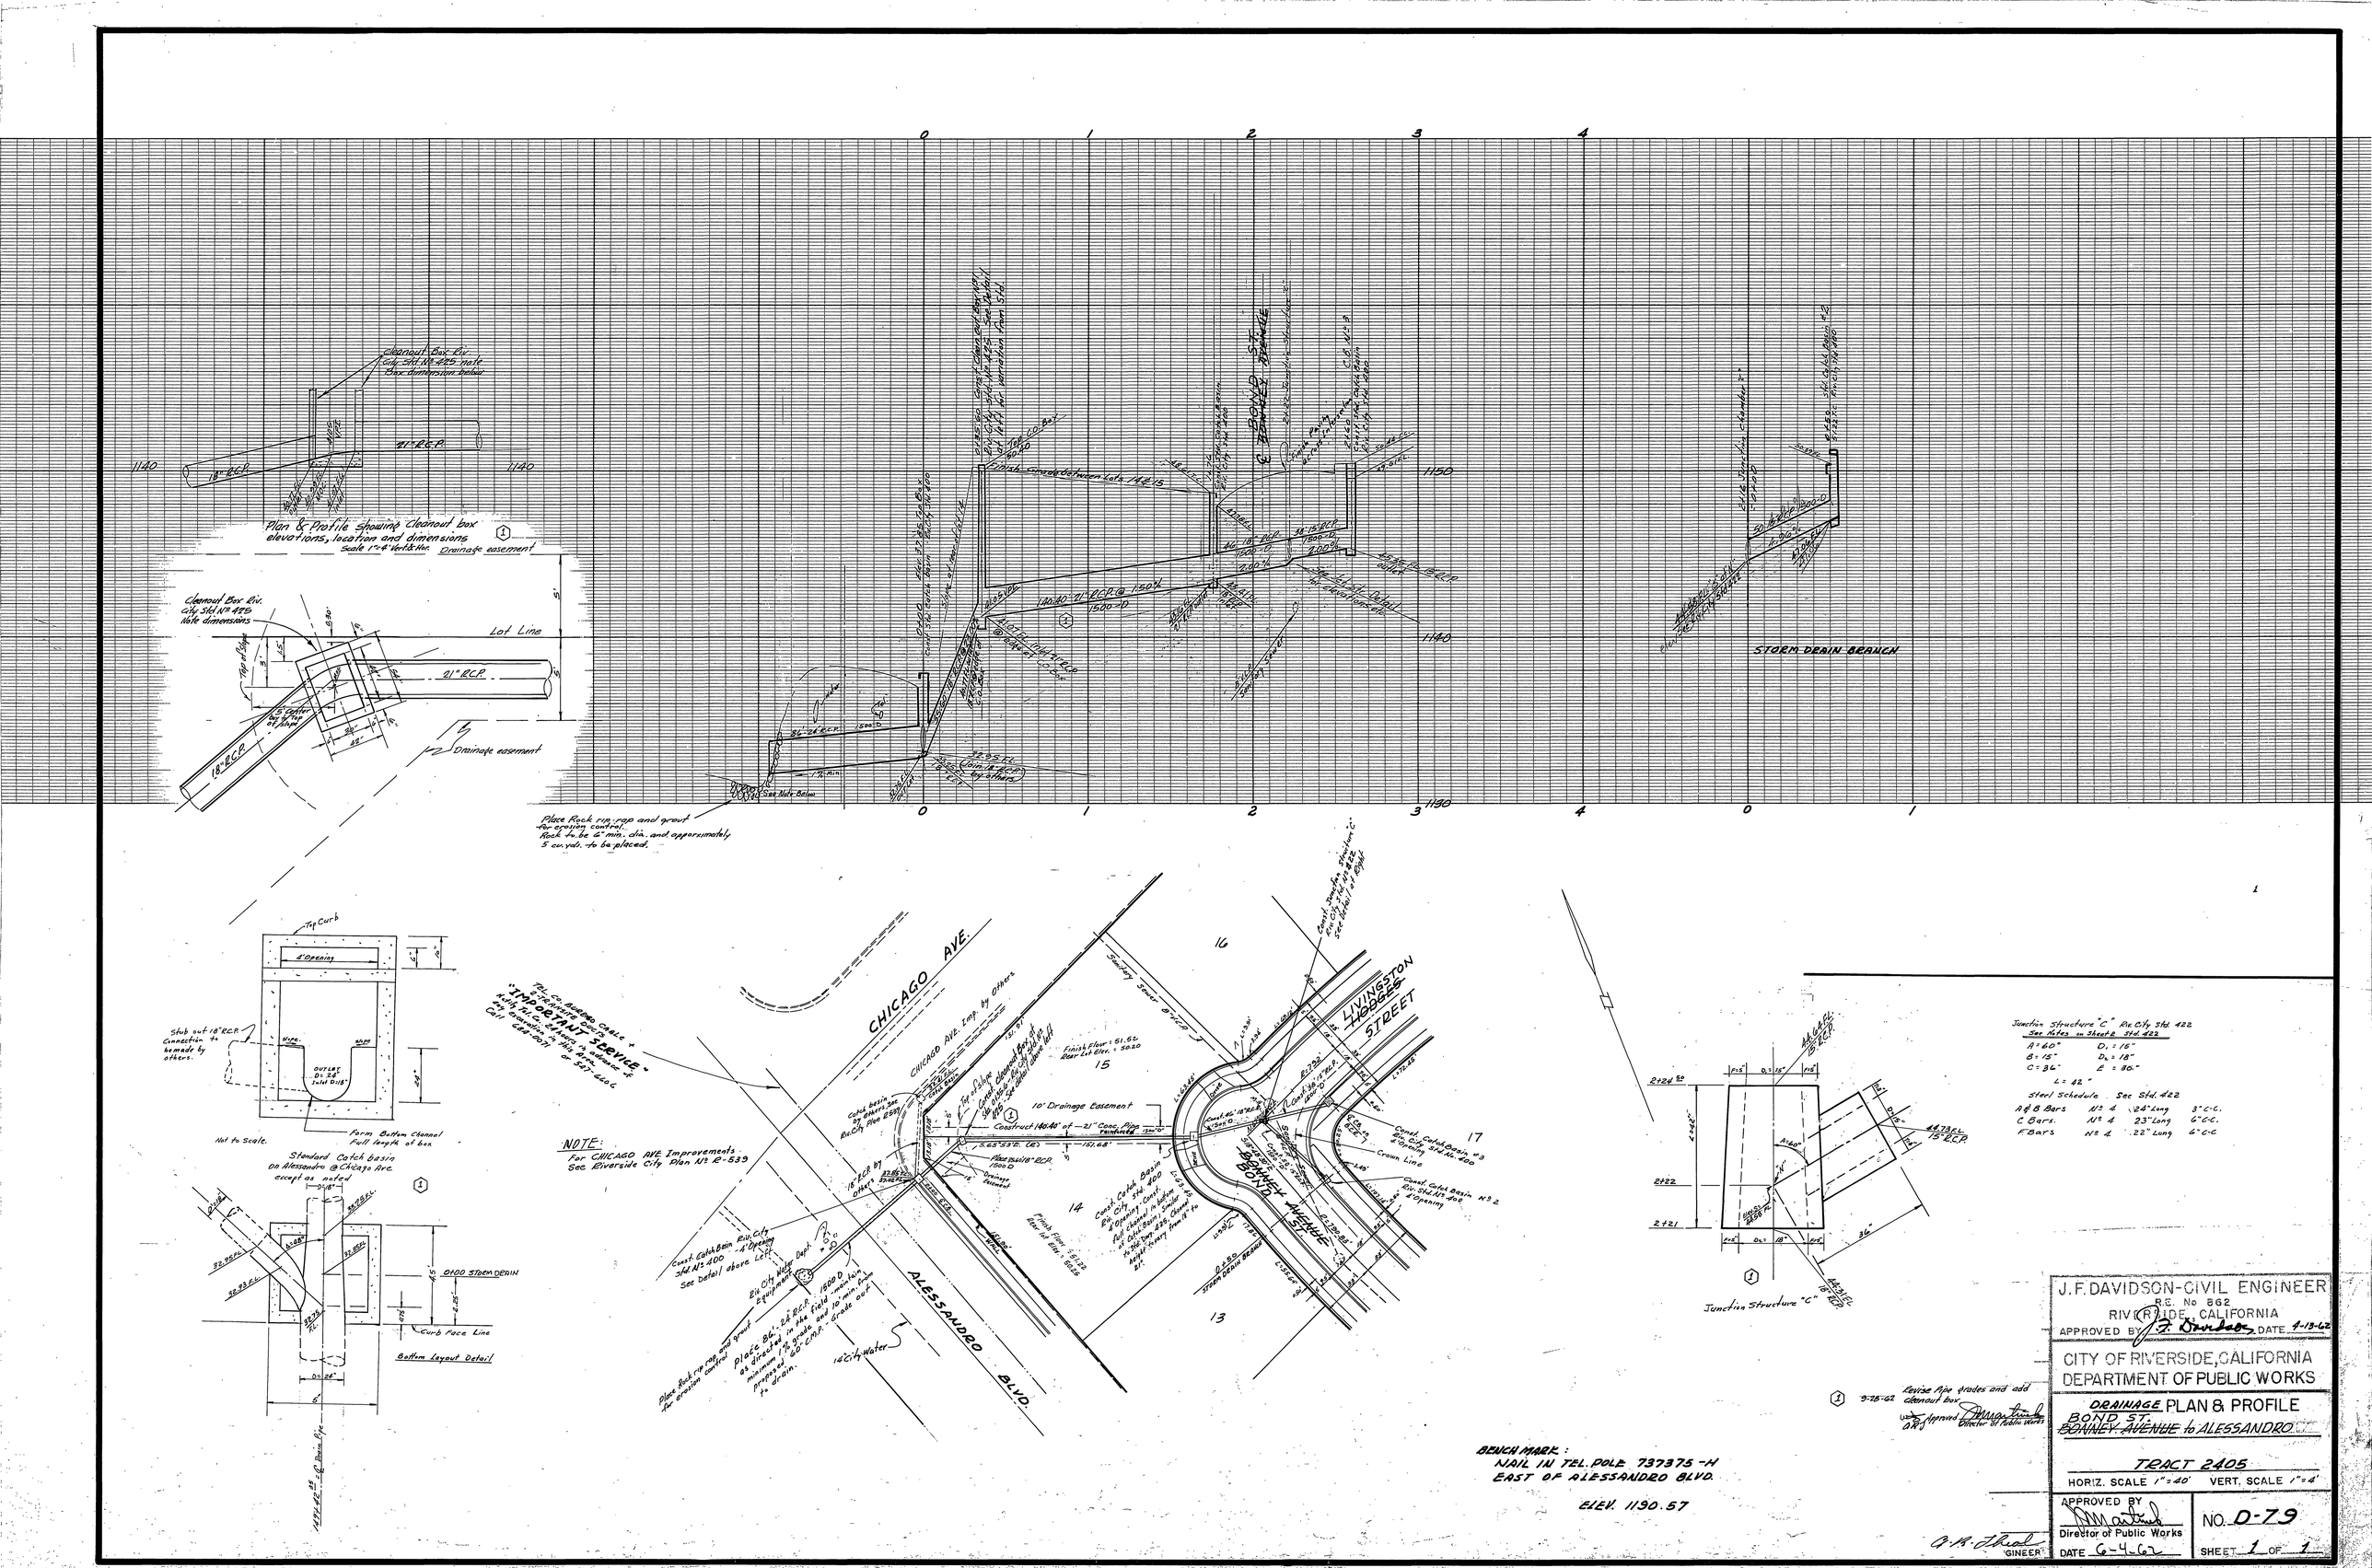Plan & Profile showing Cleanout box elevations, location and dimensions
Scale 1"=4' Vert & Hor.