



RIVERSIDE

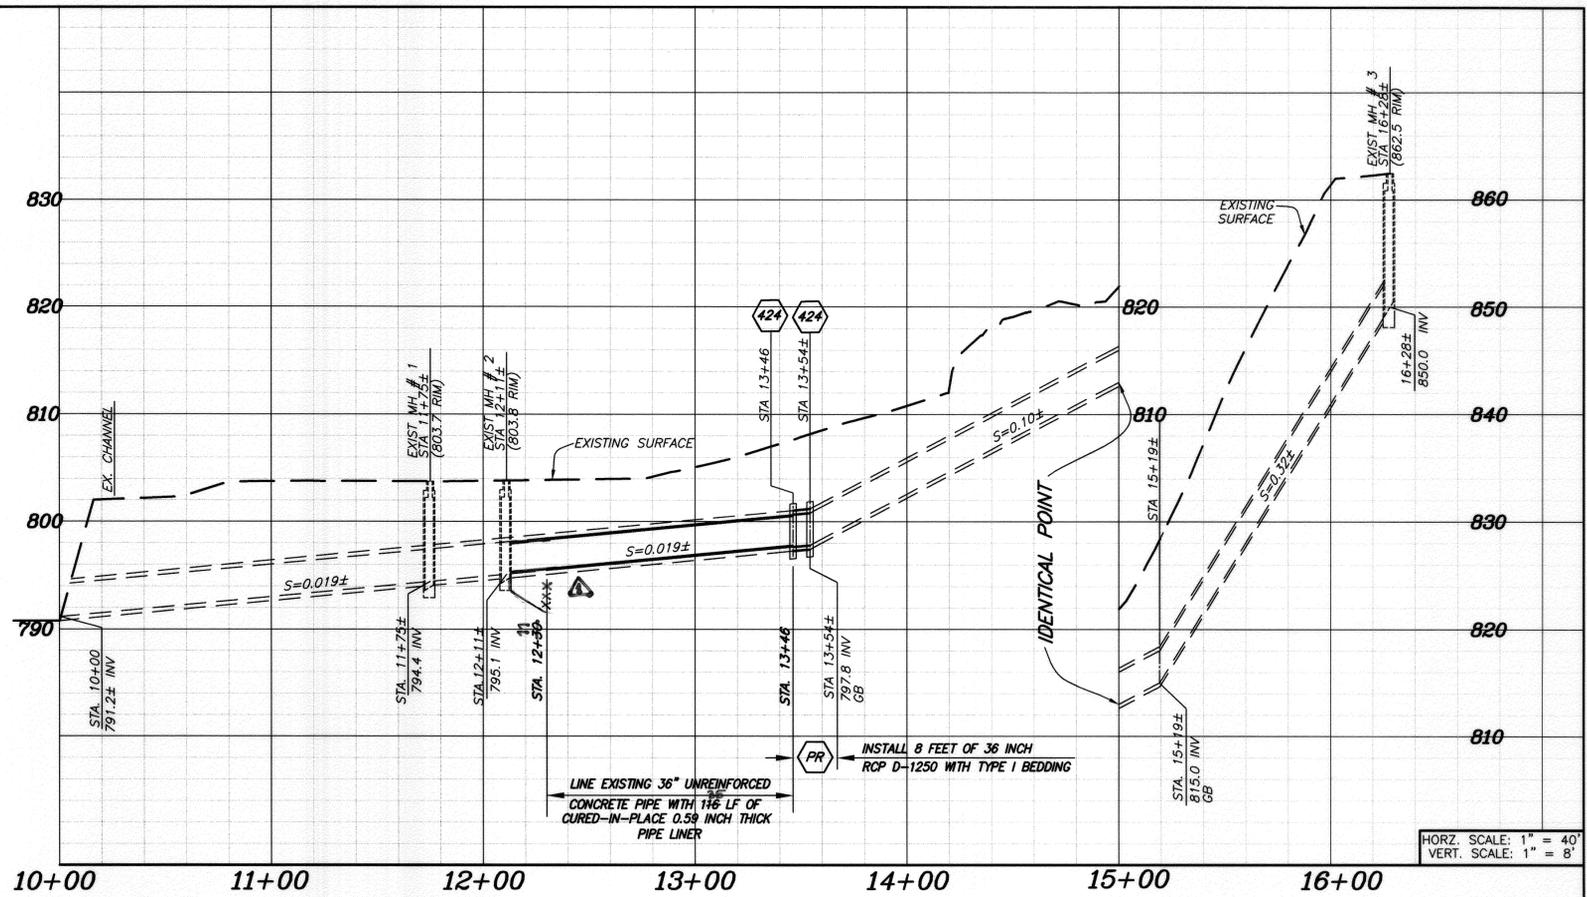

CALIFORNIA

PUBLIC WORKS DEPARTMENT STORM DRAIN REPAIR AT RIVERSIDE COMMUNITY COLLEGE SAUNDERS STREET

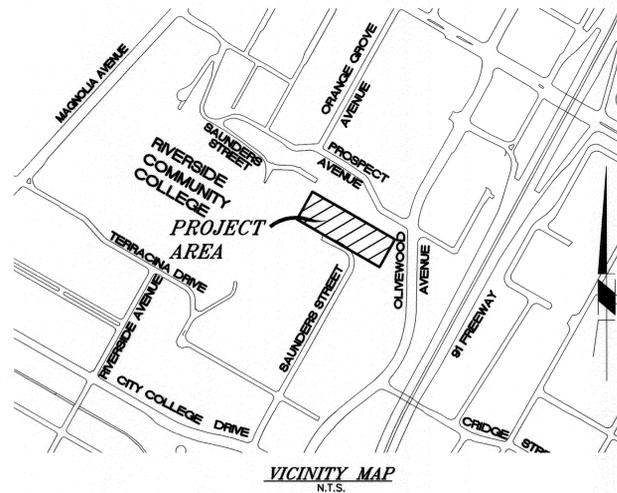

GENERAL CONSTRUCTION NOTES:

- EXISTING UTILITIES SHOWN ON THE PLAN, ARE PLOTTED FROM UTILITY RECORDS. THE CONTRACTOR IS REQUIRED TO TAKE DUE PRECAUTIONARY MEASURES TO LOCATE AND PROTECT ALL UTILITIES WHETHER OR NOT SHOWN ON THIS PLAN.
- PRIME CONTRACTORS BIDDING THIS WORK SHALL HAVE A CLASS "A" OR A "C-42" LICENSE.
- ALL ELEVATIONS SHOWN ON THE PLANS SHALL BE STAKED IN THE FIELD.
- CONSTRUCTION SHALL BE IN ACCORDANCE WITH THE CITY OF RIVERSIDE DEPARTMENT OF PUBLIC WORKS STANDARD DRAWINGS AND THE "STANDARD SPECIFICATIONS FOR PUBLIC WORKS CONSTRUCTION", 2009 EDITION.
- CONTRACTOR SHALL POTHOLE AND VERIFY ALL LOCATIONS AND ELEVATIONS OF UTILITIES PRIOR TO START OF CONSTRUCTION TO ELIMINATE INTERFERENCE WITH THE REPAIR WORK.
- LINER MATERIAL SHALL BE CURED-IN-PLACE PIPE LINER WITH A MINIMUM WALL THICKNESS OF 0.59 INCHES PER SECTION 500-1.4 OF THE GREEN BOOK.



LEGEND:

- STREET CENTERLINE
- STREET R/W
- EXISTING CURB
- EXISTING SLOPE
- EXISTING CONTOURS

SPECIFIC CONSTRUCTION NOTES:

- NUMBERS ABOVE 100 IN A HEXAGON ON THE PLAN REFER TO THE RESPECTIVE STANDARD DRAWING AND SHALL BE CONSTRUCTED ACCORDINGLY, UNLESS MODIFICATIONS ARE NOTED ON THE PLAN. ANY NUMBER SHOWN BELOW THE STANDARD DRAWING NUMBER INDICATES THE SPECIFIC ALTERNATE TO BE CONSTRUCTED.
- PR POINT REPAIR (INSTALL 8 FEET SECTION OF 36 INCH RCP D-1250 AND ADD TWO CONCRETE COLLAR, STD 424 BOTH ENDS).

CONTRACTOR SHALL PROTECT THE STORM DRAIN PIPE IN PLACE. ANY DAMAGE TO THE PIPE SHALL BE CONTRACTORS RESPONSIBILITY TO REPAIR.

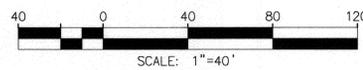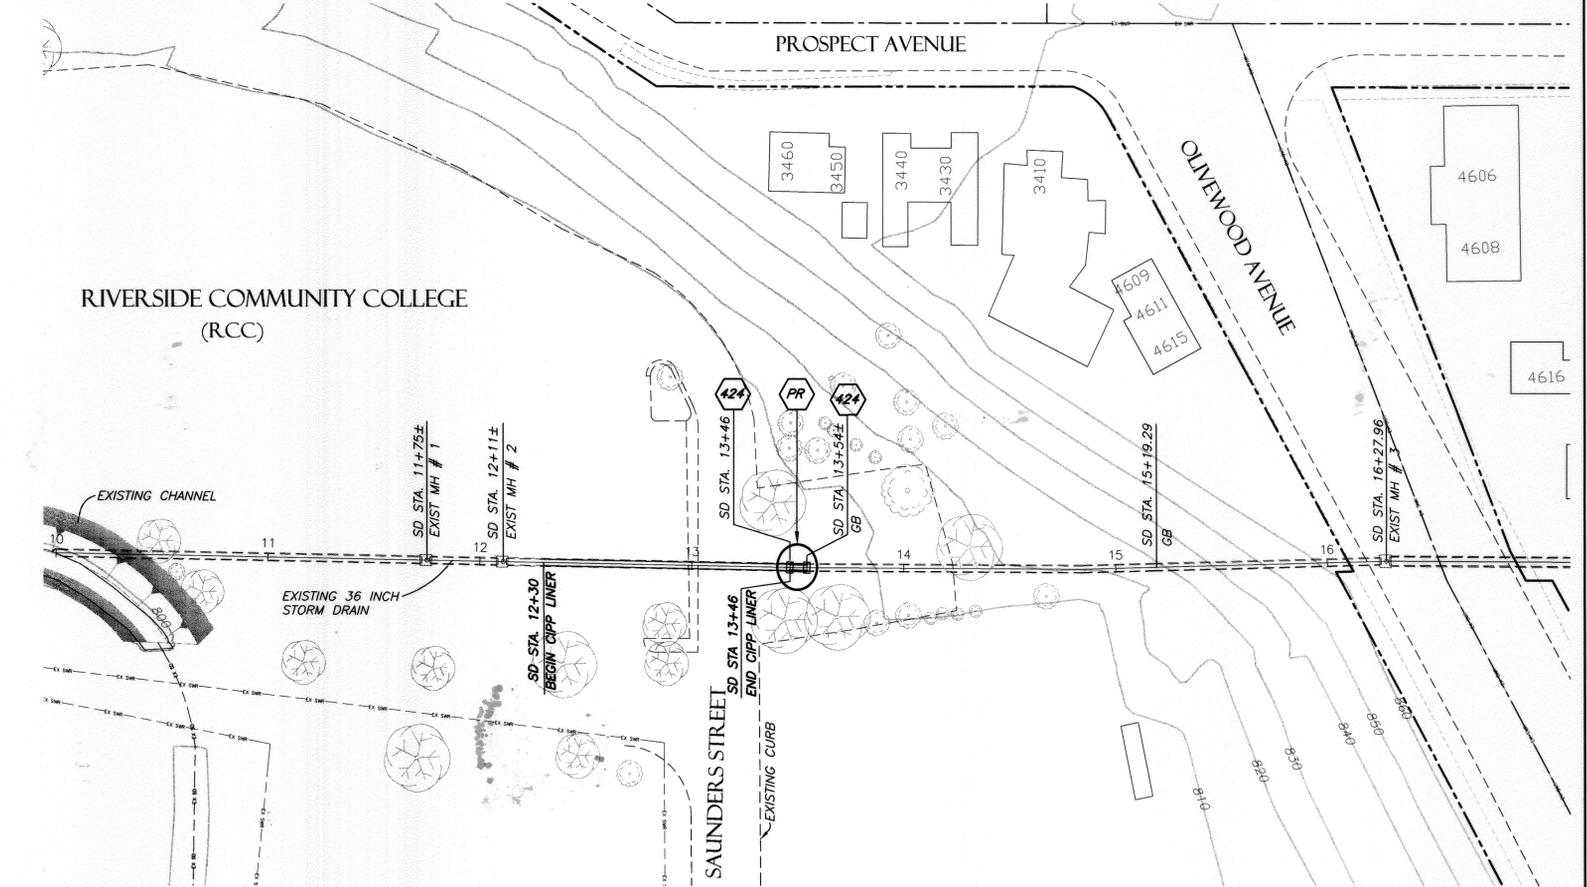

ENGINEER IN RESPONSIBLE CHARGE
LONNY LEW YOUNG
R.C.E. No. 43216 EXPIRES: 3-31-12
DATE 7/26/2011



DESIGNED BY	REVISIONS	APPR.	DATE
SP			
SP			
LLY			

APPROVED BY: *[Signature]*
CITY ENGINEER
DATE: 8/3/11

CITY OF RIVERSIDE, CALIFORNIA
PUBLIC WORKS DEPARTMENT
STORM DRAIN REPAIR AT RIVERSIDE COMMUNITY COLLEGE
SAUNDERS STREET
PLAN AND PROFILE

DESIGN NO. : 1121948
CONSTRUCTION NO. :
D-855
SHEET 1 OF 1
FILE NAME: D-855.DWG