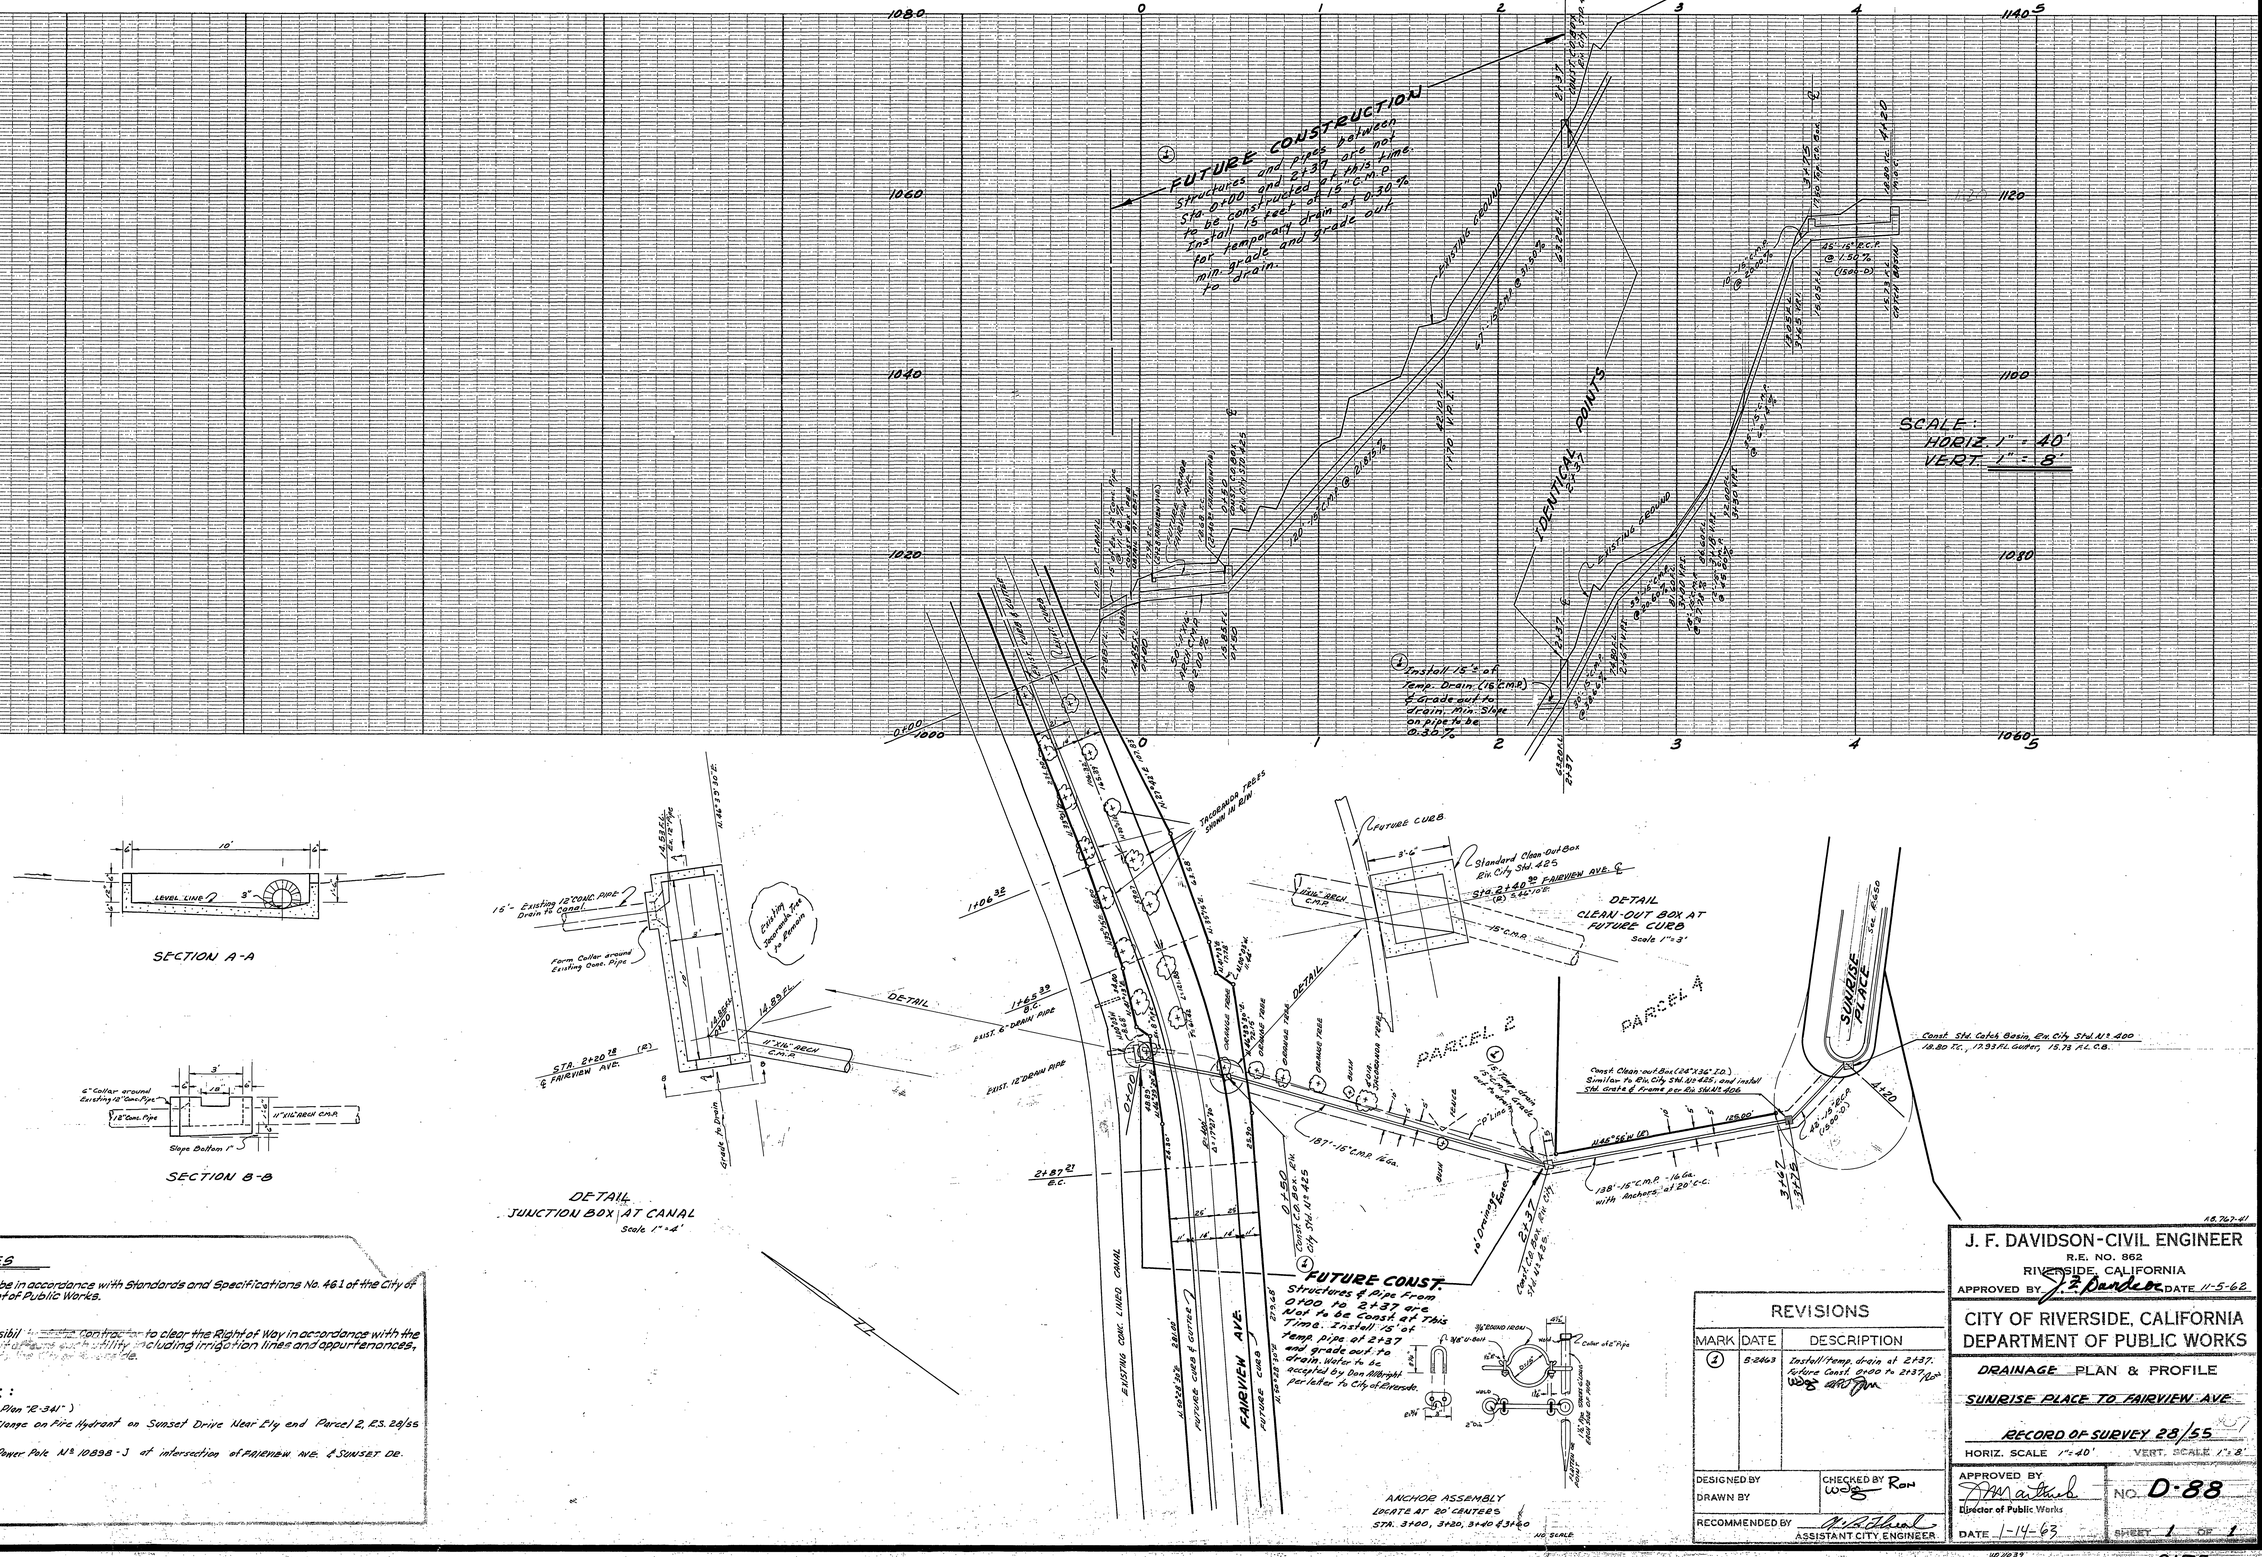

GENERAL NOTES

1. All Construction shall be in accordance with Standards and Specifications No. 461 of the City of Riverside Department of Public Works.
2. It shall be the responsibility of the Contractor to clear the Right of Way in accordance with the provisions of law and to protect and maintain all utility, including irrigation lines and appurtenances, and at no extra cost to the City.
3. **BENCH MARK:**
   T.B.M. "B" (Riv. City Plan "R-341")
   "+" Top N/S Flange on Fire Hydrant on Sunset Drive Near City end Parcel 2, ES. 28/55
   Elev. = 1045.49
   T.B.M. "A" Spk. in Power Pole No. 10898-J at intersection of FAIRVIEW AVE. & SUNSET DR.
   Elev. = 1020.62

REVISIONS		
MARK	DATE	DESCRIPTION
(1)	5-24-63	Install Temp. drain at 2+37. Future Const. grade to 2+37./Ron

DESIGNED BY
DRAWN BY
CHECKED BY WDS
RECOMMENDED BY
ASSISTANT CITY ENGINEER

A6.767-41

J. F. DAVIDSON-CIVIL ENGINEER
R.E. NO. 862
RIVERSIDE, CALIFORNIA
APPROVED BY J. F. Davidson DATE 11-5-62

CITY OF RIVERSIDE, CALIFORNIA
DEPARTMENT OF PUBLIC WORKS

DRAINAGE PLAN & PROFILE
SUNRISE PLACE TO FAIRVIEW AVE.
RECORD OF SURVEY 28/55

HORIZ. SCALE 1"=40' VERT. SCALE 1"=8'

APPROVED BY
Director of Public Works
DATE 1-14-63

NO. D-88
SHEET 1 OF 1

Indexed WDS

2175