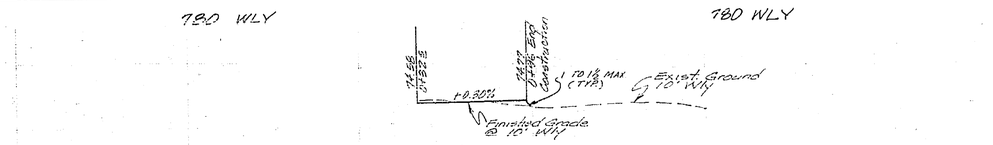

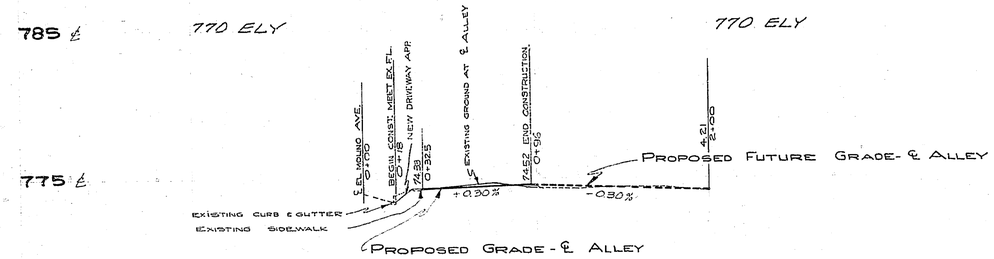

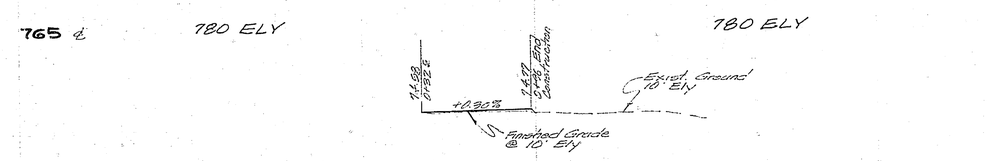

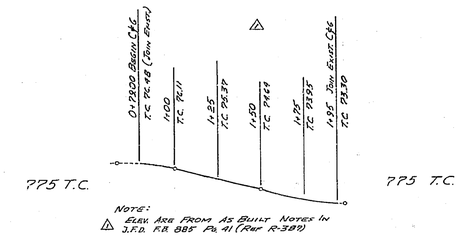

△ EL MOLINO AVE. T.C. PROFILE

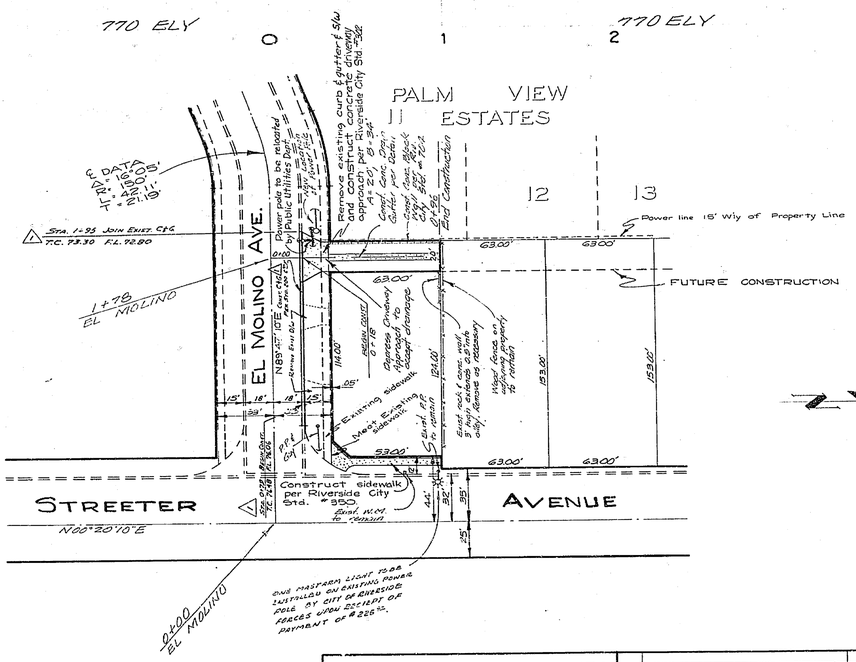

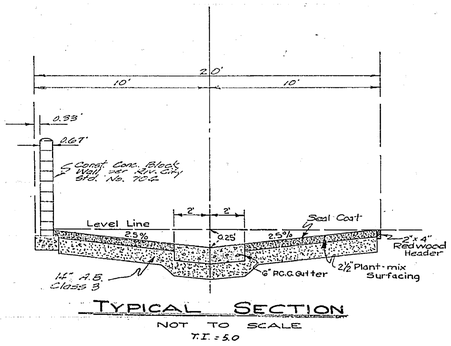

TYPICAL SECTION
NOT TO SCALE
T.E. = 5.0

GENERAL NOTES

1. For relocation of any City domestic or irrigation water facility, or electric power utility facility to be done by City forces, contact C. Hard, Water Commercial Engineer at 787-7426. Schedule about two weeks to process a work order before actual relocation work begins.
2. It shall be the responsibility of the Contractor to clear the right of way in accordance with the provisions of law as it affects each utility including irrigation lines and appurtenances and at no extra cost to the City.
3. Construction shall be in accordances with the City of Riverside, Department of Public Works, Specifications No. 461 and Standard Drawings.
4. Prime coat, seal coat, and paint binder are required.
5. Grading will require a permit under Ordinance 3093 for a cut or fill exceeding 100 cubic yards, or a fill over one food in depth.

BENCH MARK:
Spike and lead in south curb of Granada Ave., 50' West of original centerline of Streeter Ave. ELEV 775.697
Riverside City F.B. 939/16
S.R. 89 R=4

J. F. DAVIDSON ASSOCIATES
CIVIL ENGINEERS - SURVEYORS - PLANNERS
RIVERSIDE, CALIFORNIA
APPROVED BY [signature] DATE 10-4-67
R.E. NO. 13621

MARK	REVISIONS	APPR	DATE
△	ADDED CBC CURB ON EL MOLINO TO REMAIN REMOVED		

W.O. 1975 FOR: FRED BIEWER'S F.B. 885/37-43 DESIGNED BY ____ DRAWN BY [signature] CHECKED BY [signature]

CITY OF RIVERSIDE, CALIFORNIA
DEPARTMENT OF PUBLIC WORKS

APPROVED BY	BY	DATE
OFFICE ENGINEER	[signature]	11-12
PARK DEPARTMENT	—	—
TRAFFIC DIVISION	[signature]	1-10
ASSISTANT CITY ENG.	[signature]	2-7
	[signature]	1-17

APPROVED BY [signature]
DIRECTOR OF PUBLIC WORKS
DATE 2/7/63

ALLEY PLAN AND PROFILE
ZONE CASE R-28-667

HORIZ. SCALE: 1" = 40' VERT. SCALE: 1" = 4'

PROJECT NO. R-1265
SHEET 1 OF 1
FILE NO. 3724