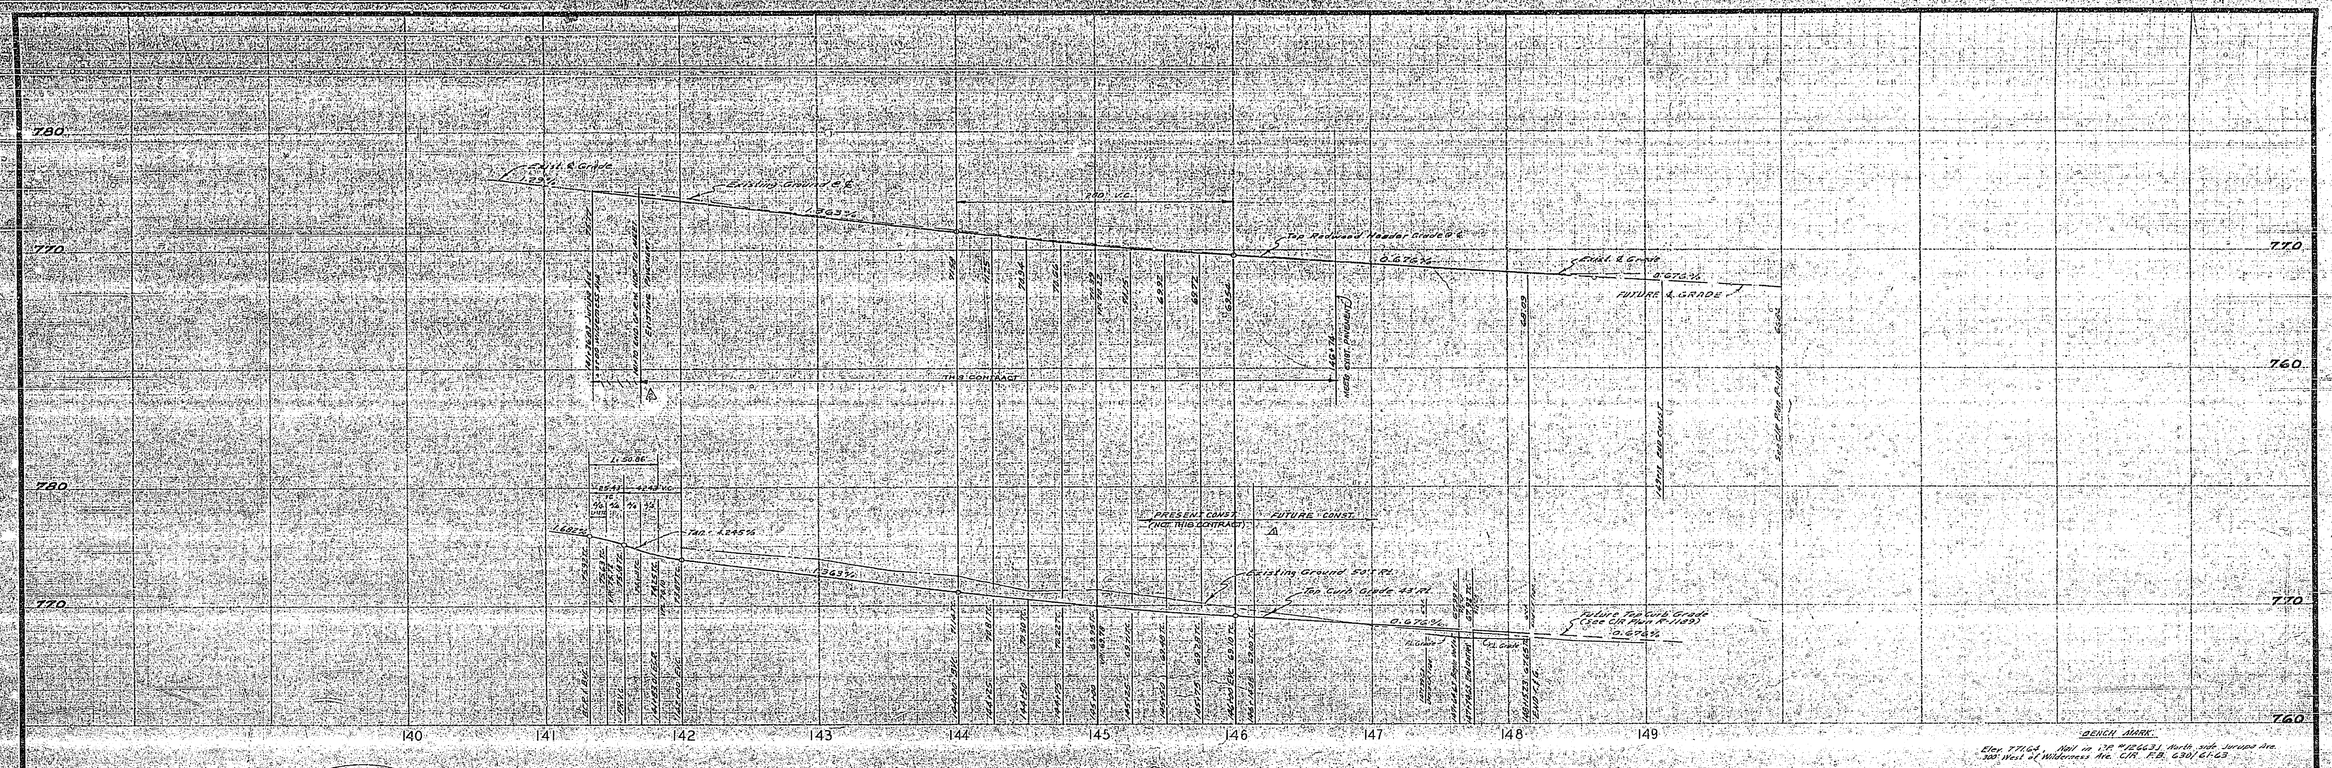

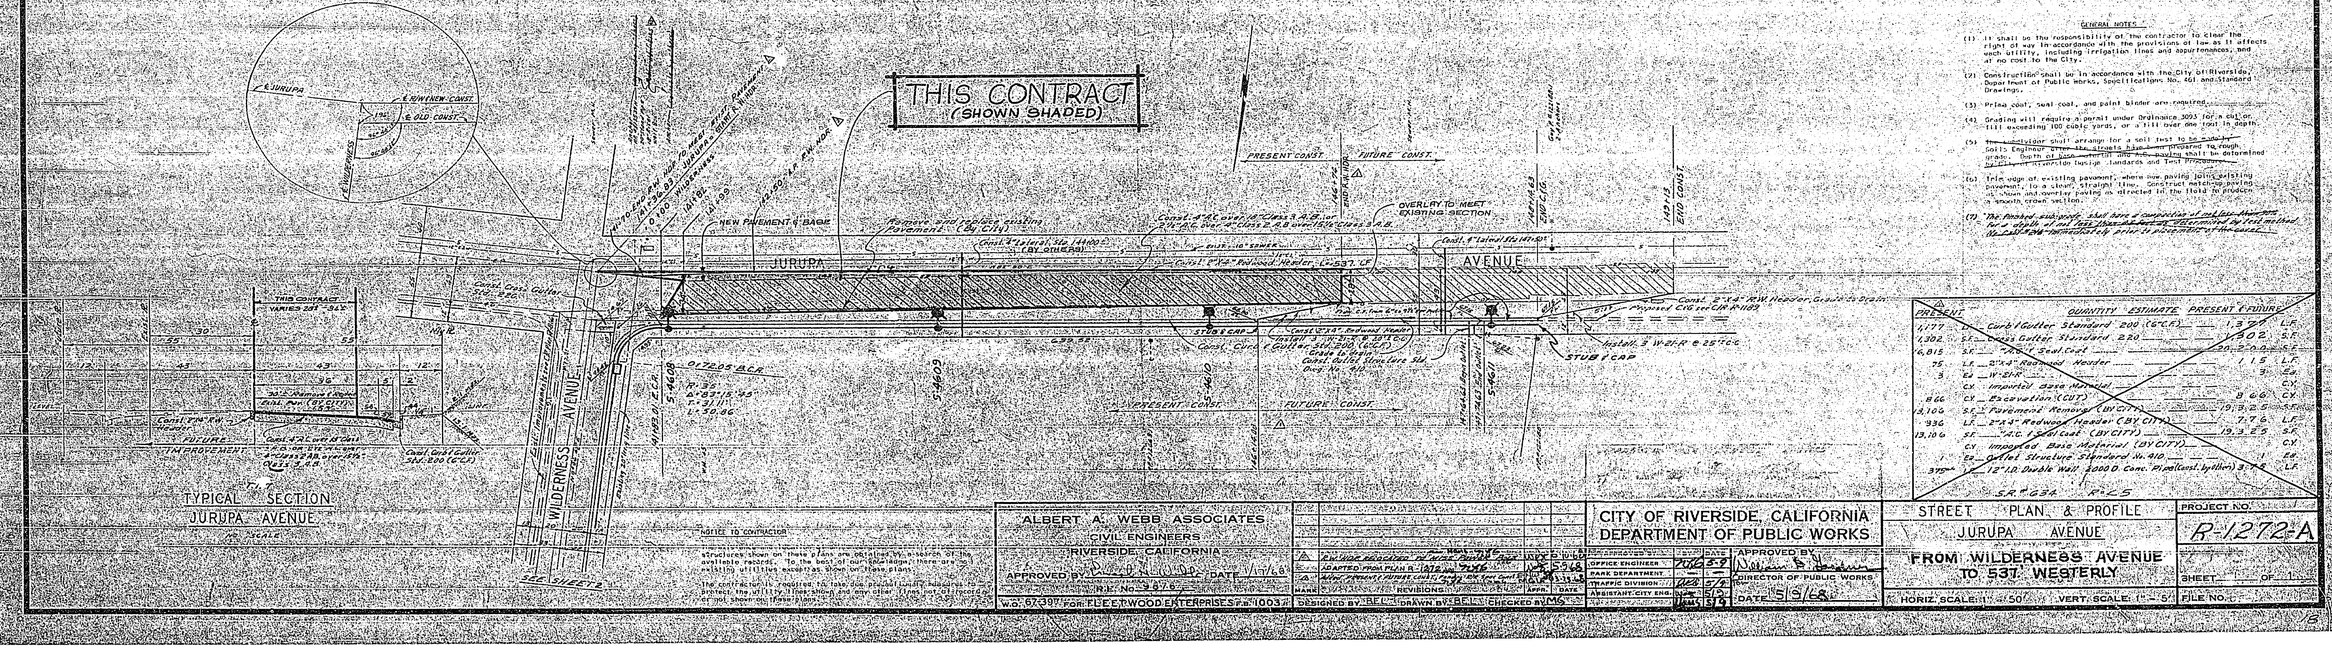

GENERAL NOTES

(1) It shall be the responsibility of the contractor to clear the right of way in accordance with the provisions of law as it affects each utility, including irrigation lines and appurtenances, and at no cost to the City.

(2) Construction shall be in accordance with the City of Riverside, Department of Public Works, Specifications No. 461 and Standard Drawings.

(3) Prime coat, seal coat, and paint binder are required.

(4) Grading will require a permit under Ordinance 3093 for a cut or fill exceeding 100 cubic yards, or a fill over one foot in depth.

(5) ~~The developer shall arrange for a soil test to be made by Soils Engineer after the streets have been prepared to rough grade. Depth of Asphaltic Concrete paving shall be determined by Soils Engineer according to Design Standards and Test Procedures.~~

(6) Trim edge of existing pavement, where new paving joins existing pavement, to a clean, straight line. Construct matching paving as shown and overlay paving as directed in the field to produce a smooth crown section.


PRESENT		QUANTITY ESTIMATE PRESENT & FUTURE		
1,177		curb & Gutter Standard 200 (6"C.F.)	1,377	L.F.
1,302	S.F.	Sidewalk Gutter Standard 220	1,302	S.F.
4,815	S.F.	2"A.C. Seal Coat	20,200	S.F.
25	L.F.	2"x4" Redwood Header	115	L.F.
3	Ea.	W.S.P.R.	3	Ea.
	C.Y.	Imported Base Material		C.Y.
866	C.Y.	Excavation (CUT)	866	C.Y.
12,106	S.F.	Pavement Removal (BY CITY)	19,325	S.F.
936	L.F.	2"x4" Redwood Header (BY CITY)	776	L.F.
13,106	S.F.	2"A.C. Seal Coat (BY CITY)	19,325	S.F.
	C.Y.	Imported Base Material (BY CITY)		C.Y.
1	Ea.	Outlet Structure Standard No. 410	1	Ea.
370	L.F.	12" I.D. Double Wall 2000 D Conc. Pipe (Cont. by other)	370	L.F.

S.P. #634 F.C.S.

NOTICE TO CONTRACTOR

Structures shown on these plans are obtained by a search of the available records. To the best of our knowledge there are no existing utilities except as shown on these plans.

The contractor is required to take due precautionary measures to prevent the utility installations and any other facilities from being damaged or disrupted.

ALBERT A. WEBB ASSOCIATES
CIVIL ENGINEERS
RIVERSIDE, CALIFORNIA

APPROVED BY: [illegible] DATE: [illegible]
R.E. No. 9879

W.O. 67-398 for FLEETWOOD ENTERPRISES S.P. #1003

MARK	REVISIONS	APPR.	DATE
A	Per User Direction to Move Curb	[illegible]	5-68
B	Adapted from Plan R-1272	[illegible]	5-68
C	Min. Pavement Thickness Only Seal Coat	[illegible]	5-13-68

DESIGNED BY: RFC DRAWN BY: RFC CHECKED BY: MG

CITY OF RIVERSIDE, CALIFORNIA
DEPARTMENT OF PUBLIC WORKS

		DATE
APPROVED BY: OFFICE ENGINEER	[illegible]	7-26-67
PARK DEPARTMENT	[illegible]	
TRAFFIC DIVISION	[illegible]	5/6
ASSISTANT CITY ENG.	[illegible]	5/10
	[illegible]	5/9

APPROVED BY: [illegible]
DIRECTOR OF PUBLIC WORKS
DATE: 5/9/68

STREET PLAN & PROFILE
JURUPA AVENUE
FROM WILDERNESS AVENUE TO 537' WESTERLY

HORIZ. SCALE: 1" = 50' VERT. SCALE: 1" = 5'

PROJECT NO. R-1272-A
SHEET ___ OF ___
FILE NO. ___