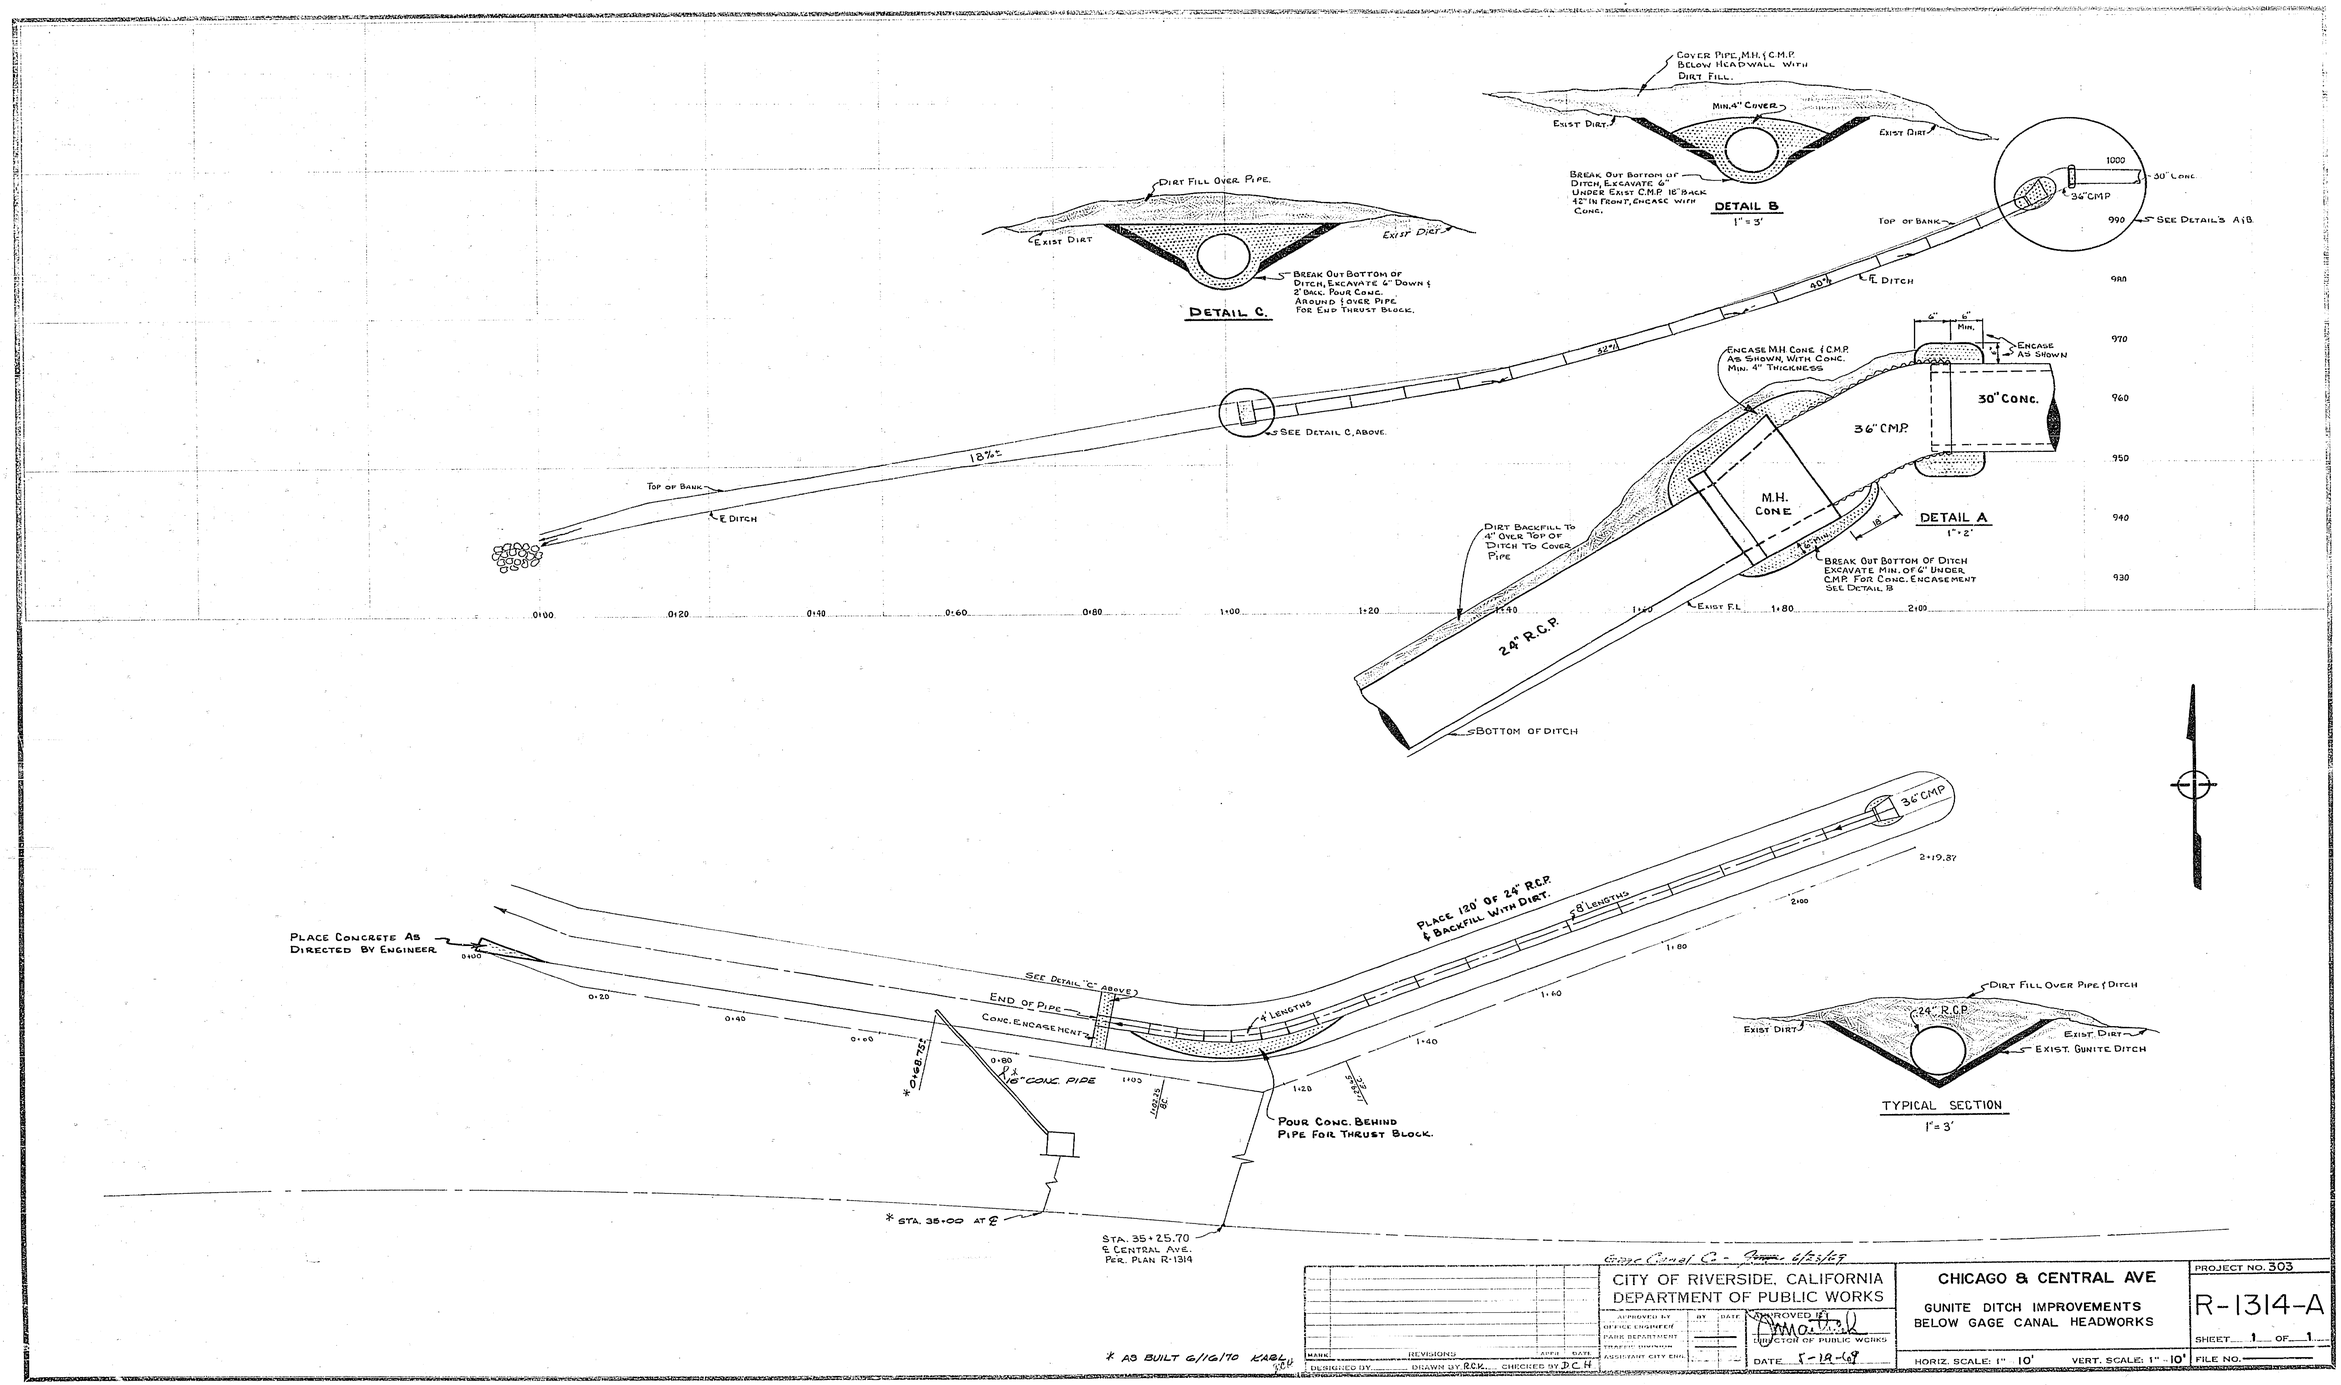

Gage Canal C - [illegible] 6/23/69

* AS BUILT 6/16/70 KABL

MARK	REVISIONS	APPR	DATE

DESIGNED BY ____ DRAWN BY RCK CHECKED BY DCH

CITY OF RIVERSIDE, CALIFORNIA
DEPARTMENT OF PUBLIC WORKS

APPROVED BY	BY	DATE
OFFICE ENGINEER		
PARK DEPARTMENT		
TRAFFIC DIVISION		
ASSISTANT CITY ENG.		

APPROVED BY [signature]
DIRECTOR OF PUBLIC WORKS
DATE 5-19-69

CHICAGO & CENTRAL AVE

GUNITE DITCH IMPROVEMENTS BELOW GAGE CANAL HEADWORKS

HORIZ. SCALE: 1" = 10' VERT. SCALE: 1" = 10'

PROJECT NO. 303

R-1314-A

SHEET 1 OF 1

FILE NO.