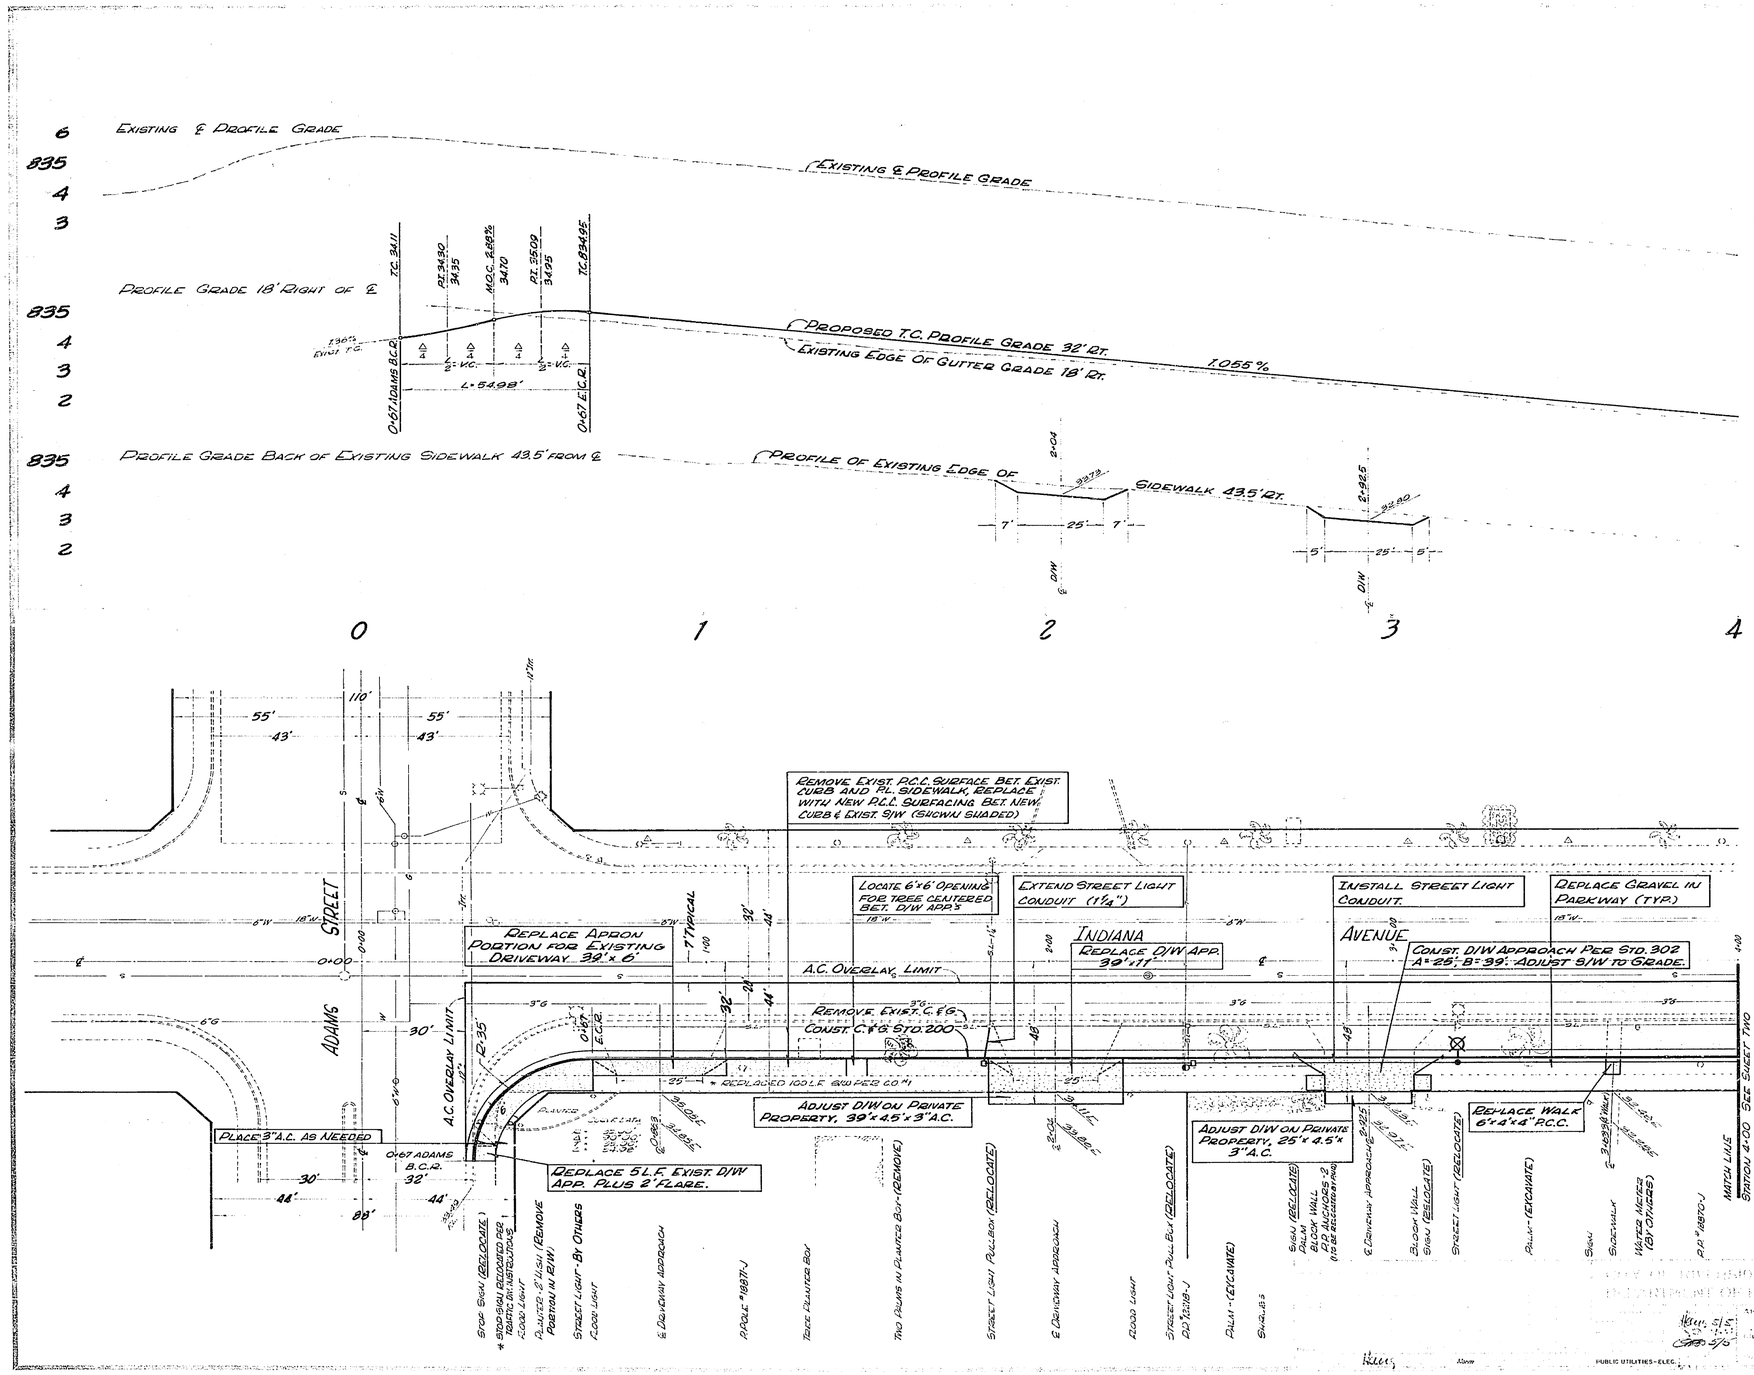

B.M. CITY OF RIVERSIDE TYPE 'A' B.M. #601-20-68 AT BACK OF SIDEWALK ON SW CORNER OF ADAMS AND INDIANA AVE. 833.51

—CAUTION—
PACIFIC TELEPHONE
CABLES UNDERGROUND
BEFORE EXCAVATING
CALL COLLECT:

	7:30 A.M. to 5 P.M.	After Hours & Holidays
Orange County	714-633-0811	714-547-6606
Riverside County	714-684-0071	714-547-6606
Inyo County	714-684-0071	714-547-6606
San Bernardino County	714-684-0071	714-547-6606
Los Angeles County	213-621-3111	◄ 24 HOUR SERVICE
Ventura County	213-621-3111	
San Diego County	714-298-0595	714-232-0027

FOR FREE CABLE LOCATING SERVICE

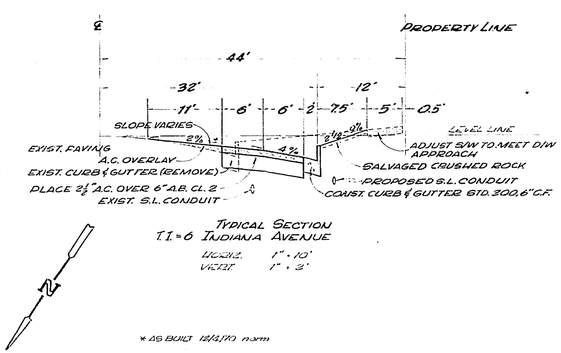

TYPICAL SECTION
T.I.=6 INDIANA AVENUE
HORIZ. 1" = 10'
VERT. 1" = 2'

* AS BUILT 12/3/70 n.s.m.

F.B. 922/40-42

CITY OF RIVERSIDE, CALIFORNIA
DEPARTMENT OF PUBLIC WORKS

INDIANA AVENUE
ADAMS TO 700' W'LY
PAVEMENT, CURB & GUTTER, SIDEWALK

PROJECT NO. D-1404
SHEET 1 OF 2
PROFILE SCALE 1" = 20' HORIZ. SCALE 1" = 2'
FILE NO.

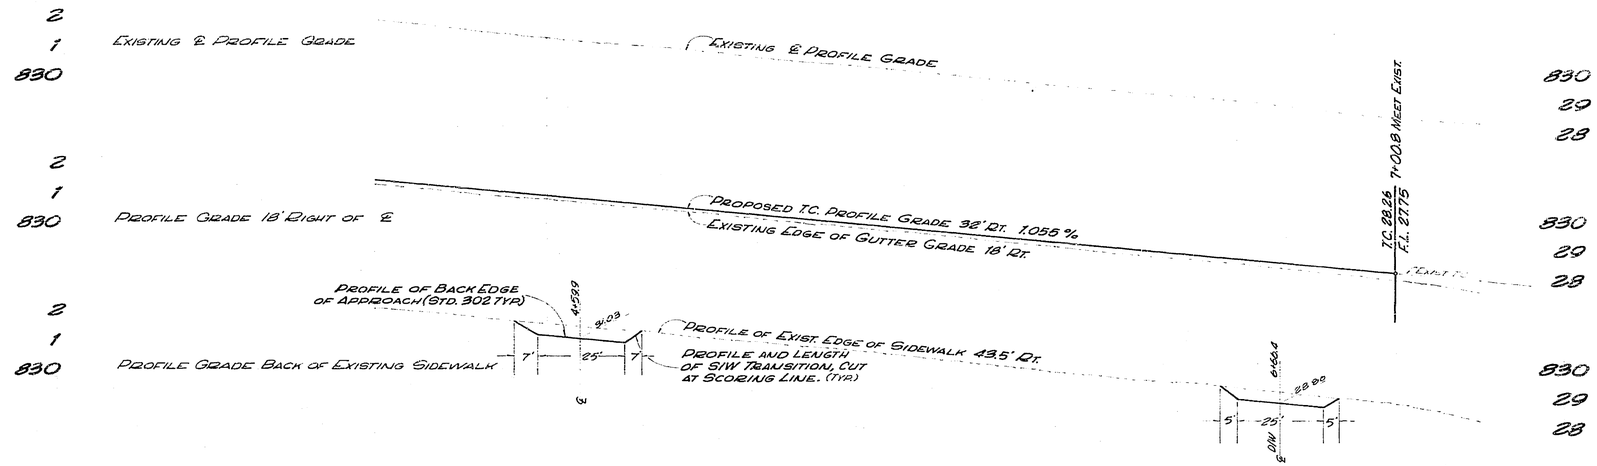

STREET LIGHT LEGEND

INDICATES CITY OF RIVERSIDE MARBELITE LIGHT STANDARD No. 4904 WITH 10,000 L, 250 W, TYPE III "LIVE MATERIAL" MERCURY VAPOR LUMINAIRE, CATALOG No. LM53A2 OR APPROVED EQUAL.

INDICATES No 3½ PULLBOX "BROOKS PRODUCTS INC", "QUINSET ED-17", OR APPROVED EQUAL.

INDICATES 1" RIGID GALVANIZED STEEL CONDUIT, EXCEPT AS NOTED.

INDICATES 240 V FEED POINT

CONTRACTOR SHALL OBTAIN DAILY CIRCUIT CLEARANCES FROM THE PUBLIC UTILITIES DEPARTMENT PRIOR TO WORKING ON ANY EXISTING CIRCUITS. CALL 787-7317 FOR CLEARANCE.

3 4 5 6 7

—CAUTION—

PACIFIC TELEPHONE

CABLES UNDERGROUND

BEFORE EXCAVATING

CALL COLLECT:

	7:30 A.M. to 5 P.M.	After Hours & Holidays
Orange County	714-633-0811	714-547-6606
Riverside County	714-686-0071	714-547-6606
Inyo County	714-684-0071	714-547-6606
San Bernardino County	714-684-0071	714-547-6606
Los Angeles County	213-621-3111	← 24 HOUR SERVICE
Ventura County	213-621-3111	
San Diego County	714-278-0595	714-232-0027

FOR FREE CABLE LOCATING SERVICE

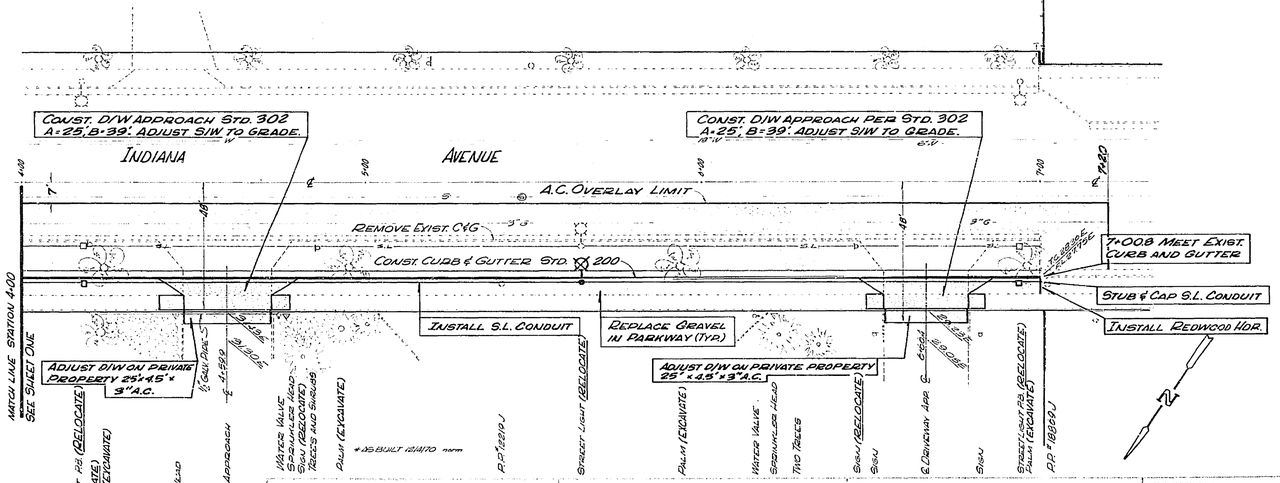

CITY OF RIVERSIDE, CALIFORNIA
DEPARTMENT OF PUBLIC WORKS

PUBLIC UTILITIES-ELEC.

INDIANA AVENUE

ADAMS TO 700' W'LY

PAVEMENT, CURB & GUTTER, SIDEWALK

HORIZ. SCALE 1" = 20' VERT. SCALE 1" = 2'

PROJECT NO. R-1404

SHEET 2 OF 2

TITLE NO.