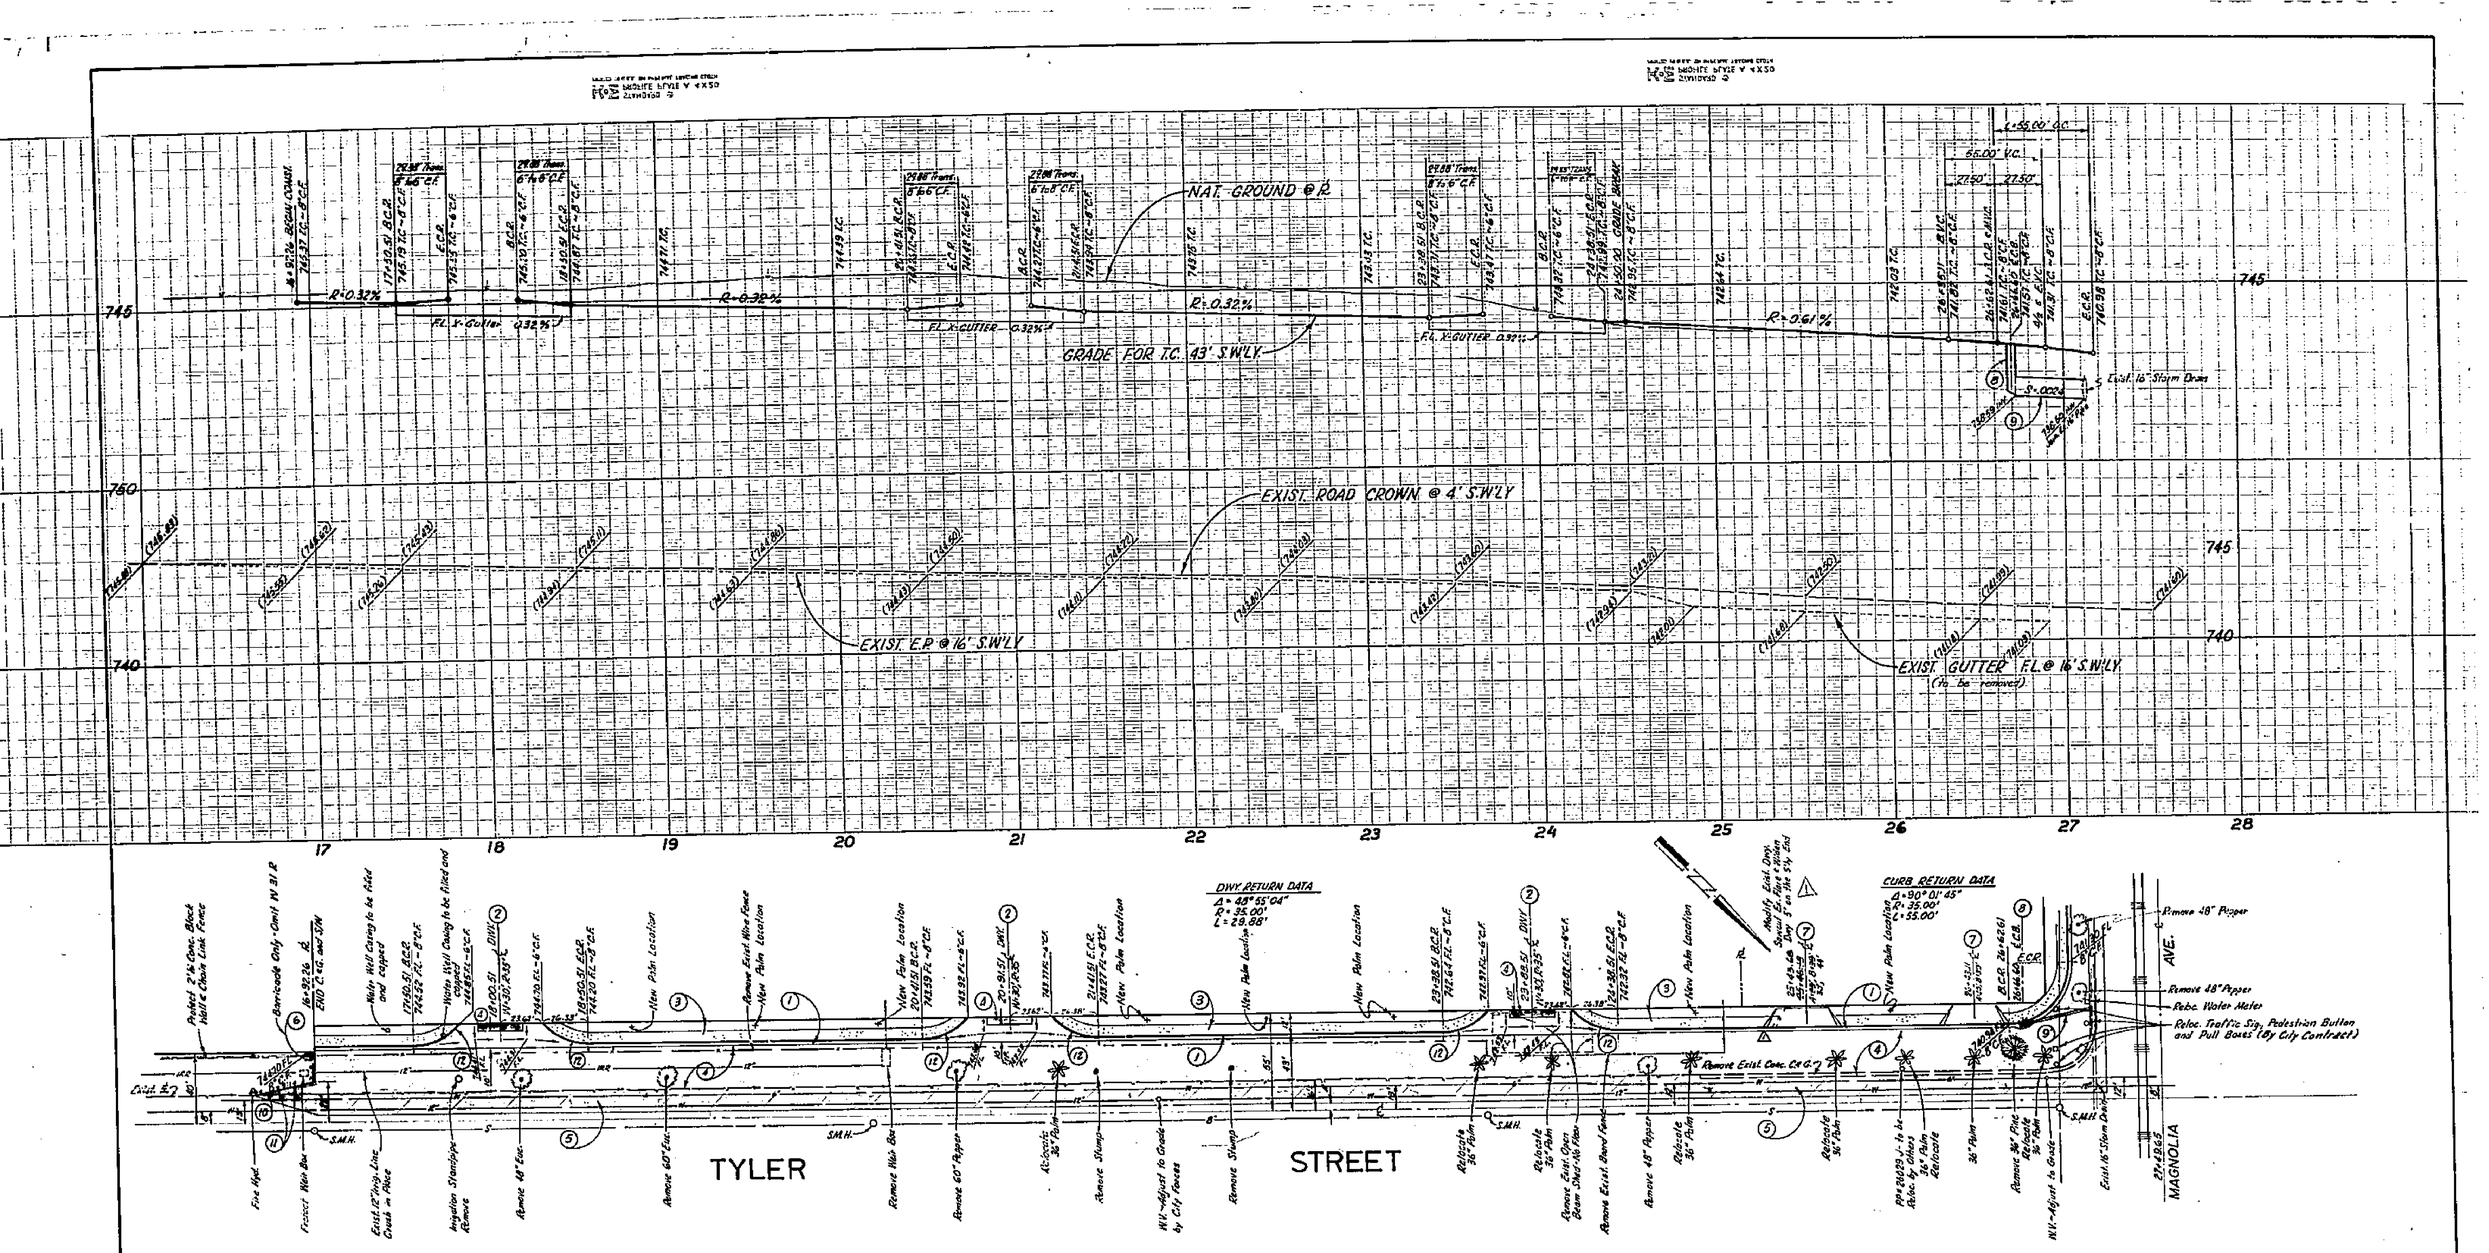

SEE SHEET 1 FOR TYPICAL SECTIONS, GENERAL NOTES AND CONSTRUCTION NOTES.

BENCH MARK

CITY B.M.-P.K. NAIL IN N.W. CURB RETURN @ MAGNOLIA & TYLER
CITY F.B. 625/69 ELEV. 740.279

IRRIGATION DIVISION	ANACAL ENGINEERING CO.		CITY OF RIVERSIDE, CALIFORNIA DEPARTMENT OF PUBLIC WORKS	ZONE CASE R-23-689 STREET PLAN AND PROFILE TYLER STREET	PROJECT NO. R-1445
APPROVED BY: [signature] DATE: 7-16-70	(P.O. BOX 3668) 222 E. LINCOLN AVENUE ANAHEIM, CALIF. 92803 PHONE (714) 774-1763 F.B. P-1/42		APPROVED BY: OFFICE ENGINEER, PARK DEPARTMENT, TRAFFIC DIVISION, ASSISTANT CITY ENG. — APPROVED BY: DIRECTOR OF PUBLIC WORKS DATE: 7-[illegible]	SWLY SIDE FROM 1057 FEET SELY OF MAGNOLIA AVE TO MAGNOLIA AVE	SHEET 2 OF 3
	PREPARED UNDER THE SUPERVISION OF: [signature] CARL CZAPLINSKI R.C.E. 8427 1-20-70 DATE	Revised Dwy. @ Sta. 25+49.68 REVISIONS		HORIZ. SCALE: 1" = 40' VERT. SCALE: 1" = 4'	FILE NO.
		DESIGNED BY TWC DRAWN BY TWC CHECKED BY [illegible]			

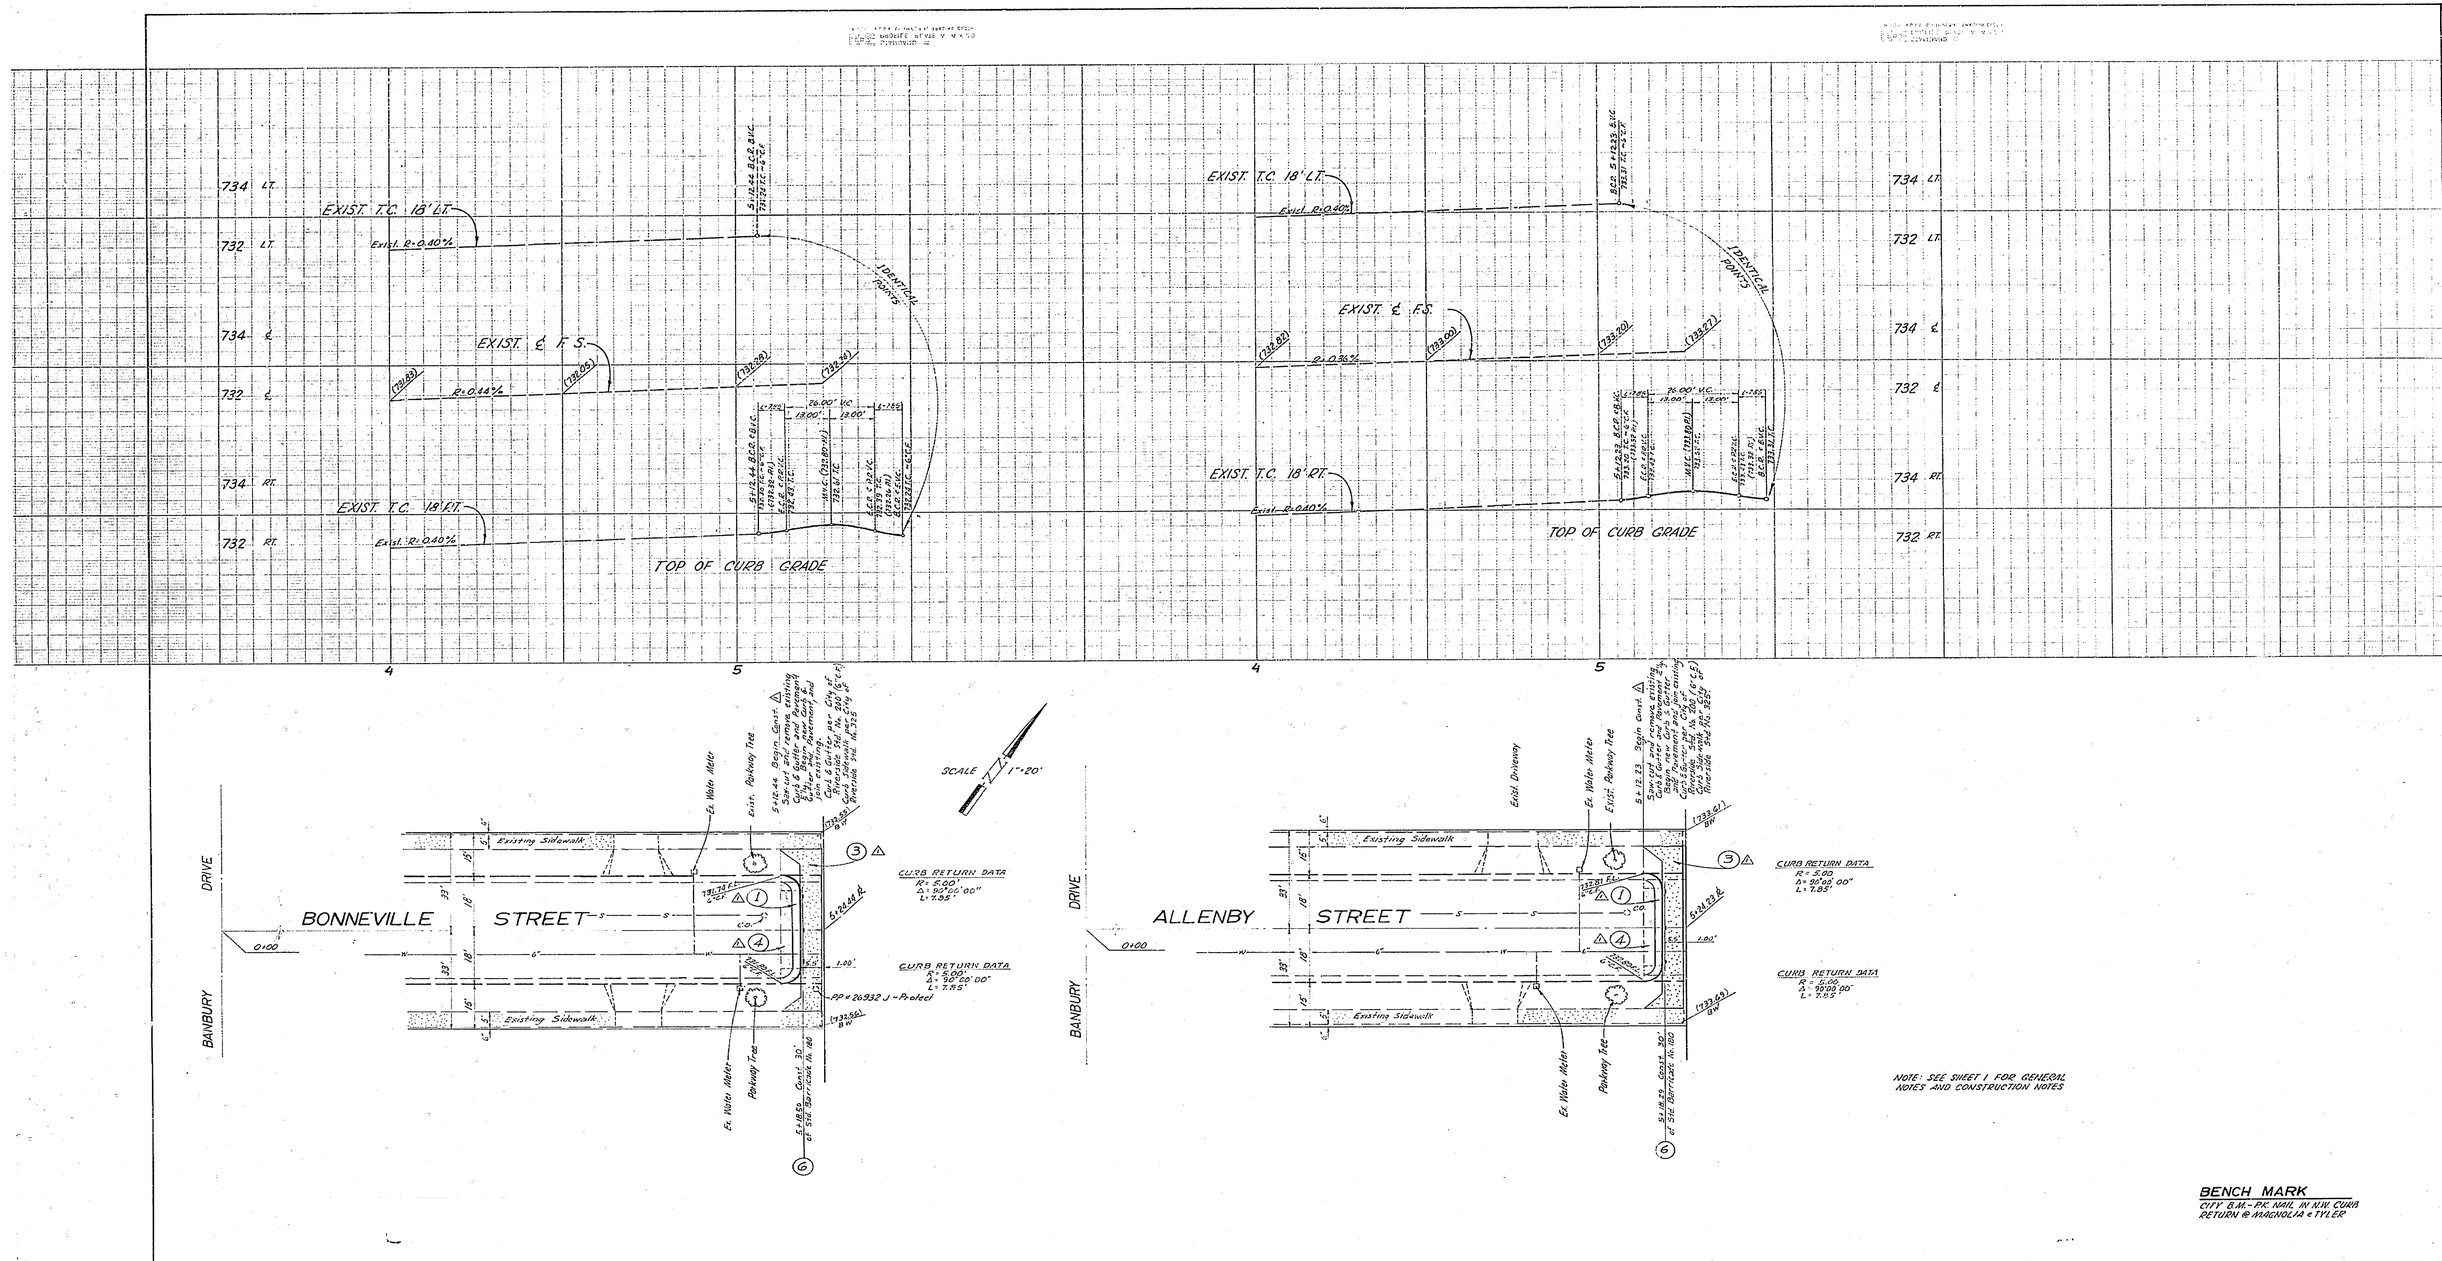

NOTE: SEE SHEET 1 FOR GENERAL NOTES AND CONSTRUCTION NOTES

BENCH MARK
CITY B.M. - P.K. NAIL IN N.W. CURB RETURN @ MAGNOLIA & TYLER

IRRIGATION DIVISION APPROVED BY: [signature] DATE: 7-16-70	ANACAL ENGINEERING CO. (P.O. BOX 3668) 222 E. LINCOLN AVENUE ANAHEIM, CALIF. 92803 PHONE (714) 774-1763 F.B. R1/42 PREPARED UNDER THE SUPERVISION OF: [signature] CARL CZAPLINSKI R.C.E. 8427 — 2-26-70 DATE	MARK: Revised Cul-de-sac — REVISIONS — APP'D — DATE 10-2-70 DESIGNED BY TWC DRAWN BY TWC CHECKED BY WLM	CITY OF RIVERSIDE, CALIFORNIA DEPARTMENT OF PUBLIC WORKS APPROVED BY / BY / DATE OFFICE ENGINEER [signature] 7-17 PARK DEPARTMENT [signature] 7-16 TRAFFIC DIVISION [signature] 7-17 ASSISTANT CITY ENG. [signature] 7-20 APPROVED BY [signature] DIRECTOR OF PUBLIC WORKS DATE 7-21-70	ZONE CASE R-23-689 STREET PLAN AND PROFILE BONNEVILLE STREET THE NELY 69.12 FEET ONLY ALLENBY STREET THE NELY 69.12 FEET ONLY HORIZ. SCALE: 1"=20' VERT. SCALE: 1"=2'

PROJECT NO. R-1445
SHEET 3 OF 3
FILE NO.