PLATE I—PLAN PROFILE R P A STANDARD
THE FREDERICK POST CO., CHICAGO

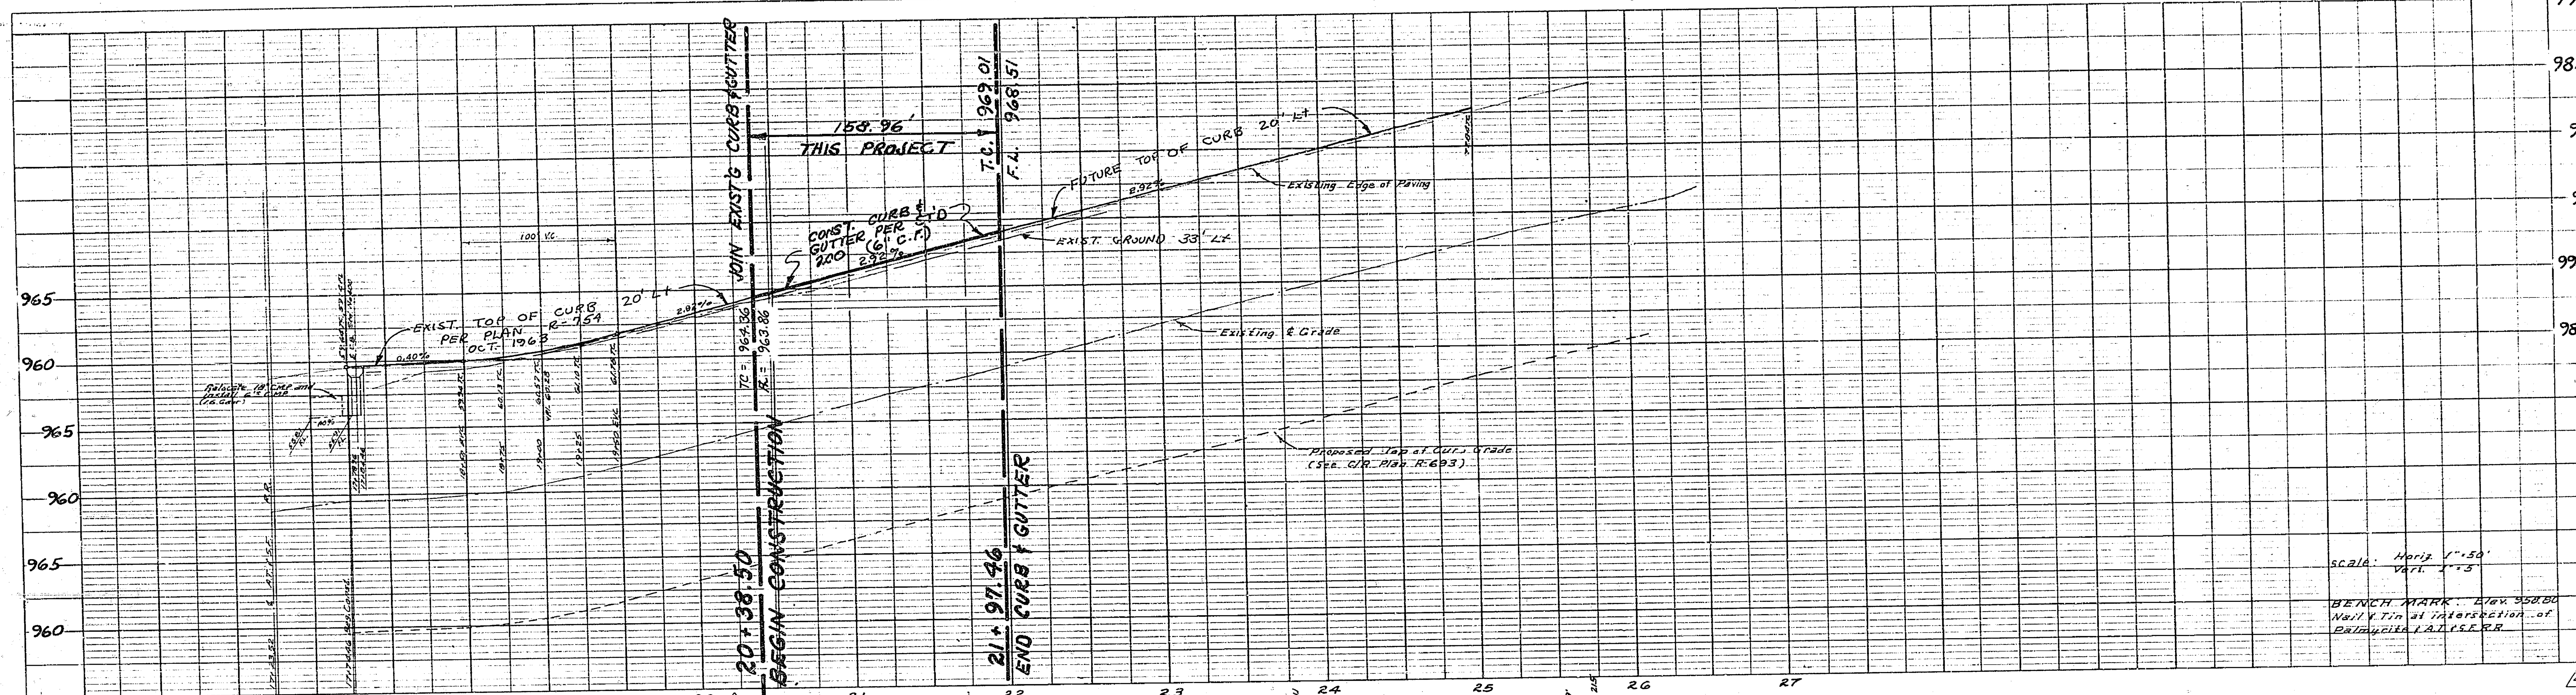

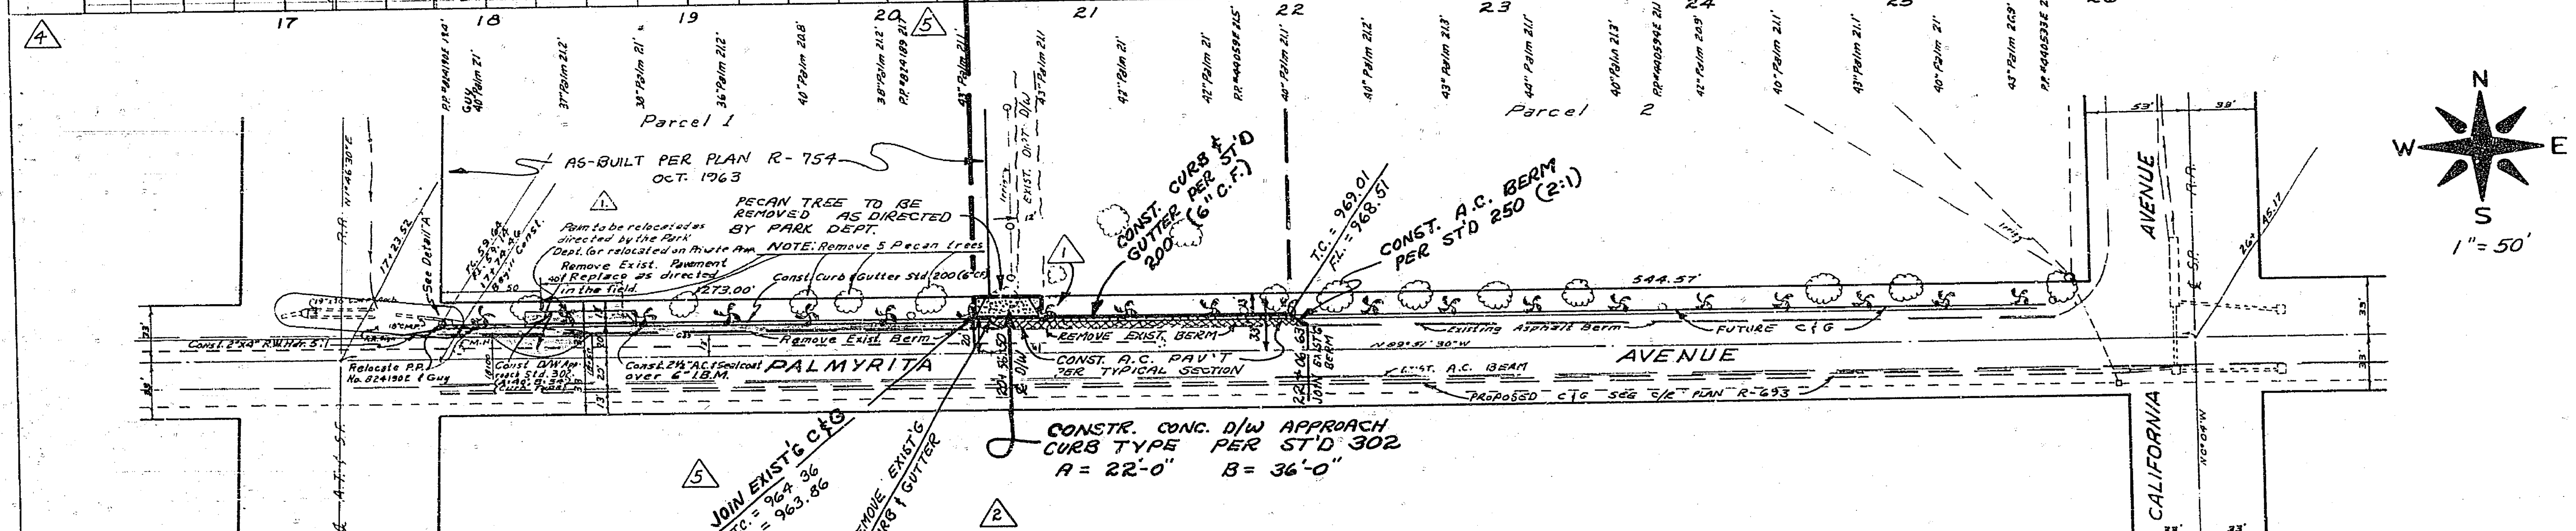

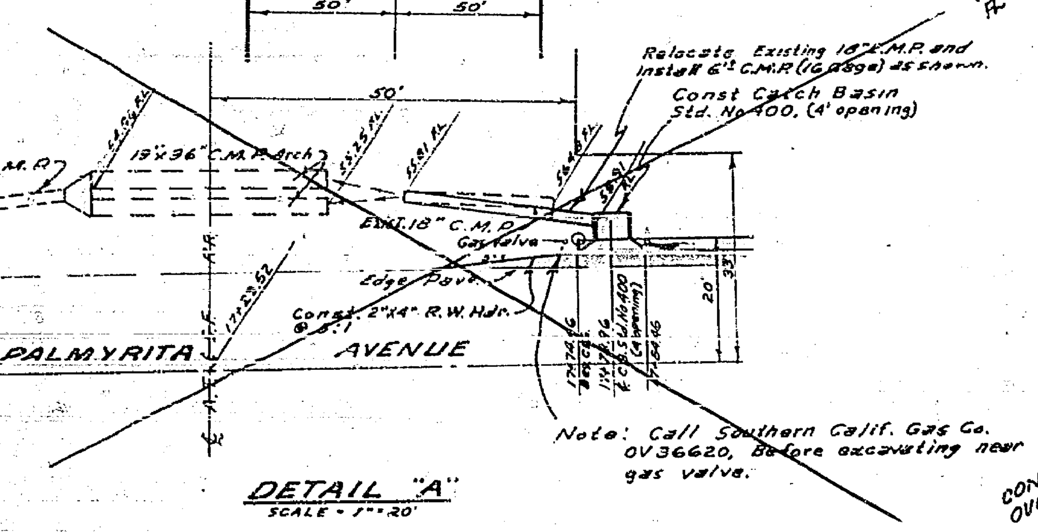

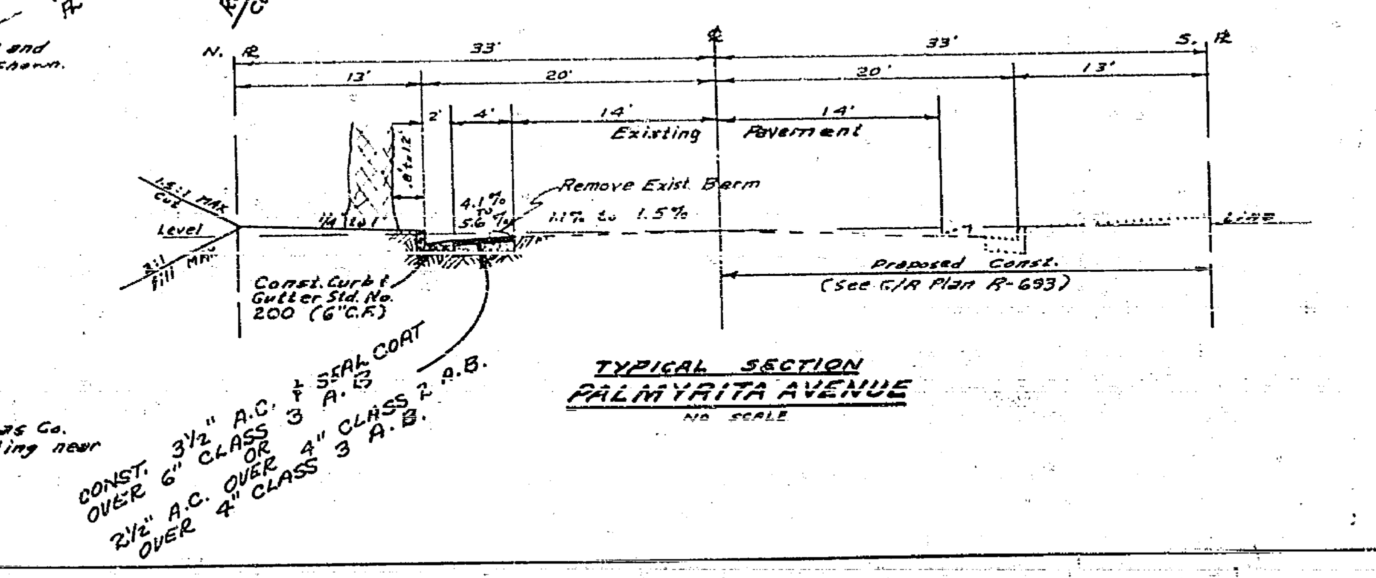

GENERAL NOTES:

1. Construction to be in accordance with Standards and Specifications No. 461 of the City of Riverside, Dept of Public Works.
2. Trim edge of existing paving where new paving joins existing pavement, to clean, straight line. Construct match-up paving as shown and overlay existing paving as directed in the field to produce a smooth crown section.
3. Prime coat & paint binder are required.
4. It shall be the responsibity of the Contractor to clear the Right of way in accordance with the provisions of law as it affects each utility including irrigation lines and appurtenances and at no extra cost to the City of Riverside.
5. ~~Location of Curb-S/W-Driveway Approaches to be determined at time of construction per plot plan that has been approved by the Traffic Dept.~~
6. T.I. = 6

Harry J. Krueper

QUANTITY ESTIMATE

Standard No. 200 Curb & Gutter (6" C.F.)	△3	158.96	L.F.
Standard No. 250 Berm		10'	L.F.
Driveway Approach Standard No. 302		400	S.F.
2½" A.C. & Sealcoat	△3	656	S.F.
4" Imported Base Material		6	C.Y.
4" Imported Base Material	△3	6	C.Y.

REVISION		
MARK	DATE	DESCRIPTION
△1	4 Dec. '70	DELETED PALM TREE "REMOVAL" NOTE
△2		RELOCATED D/W BETWEEN TWO PALM TREES
△3		CHANGE QUANTITY EST.
△4		CORRECTED ELEV. INDEX IN PROFILE
△5		EXPANDED PROJECT LIMITS

Approved 12-11-70

krueper engineering & associates
civil engineering • land surveying
449 west ninth street
san bernardino, california 92401
884-2159

Harry J. Krueper
Date 31 July 1970 Calif. Reg. No. 12953

CITY OF RIVERSIDE, CALIFORNIA
DEPARTMENT OF PUBLIC WORKS

STREET PLAN & PROFILE

PALMYRITA AVENUE
Between A.T. & S.F. R.R. & California
FOR
GENERAL STEEL & WIRE CO.

DATE 31 July 1970	SCALE 1" = 50'	APPROVED BY William D. Hardin, DIRECTOR OF PUBLIC WORKS	NO. E-1451
DRAWN B.H. Smith	W.O. 70-21.01		
CHECKED J.M.H.	FILE P-4-120	DATE 9/22/70	SHEET 1 OF 1

Dwg. No.

PROFILE		BY	DATE
NOTE BOOK	SURVEYED	FLOWERS	July '70
NO.	PLOTTED	POSTLETHWAITE	
	GRADES CHECKED	FLOWERS	
	B.M.'S NOTED	HUMBERG	July '70
	STRUCTURE NOTATIONS CH'KD		

PLAN		BY	DATE
NOTE BOOK	SURVEYED	FLOWERS	July '70
NO.	PLOTTED	POSTLETHWAITE	July '70
	ALIGNMENT CHECKED	SMITH	
	RT. OF WAY CHECKED		