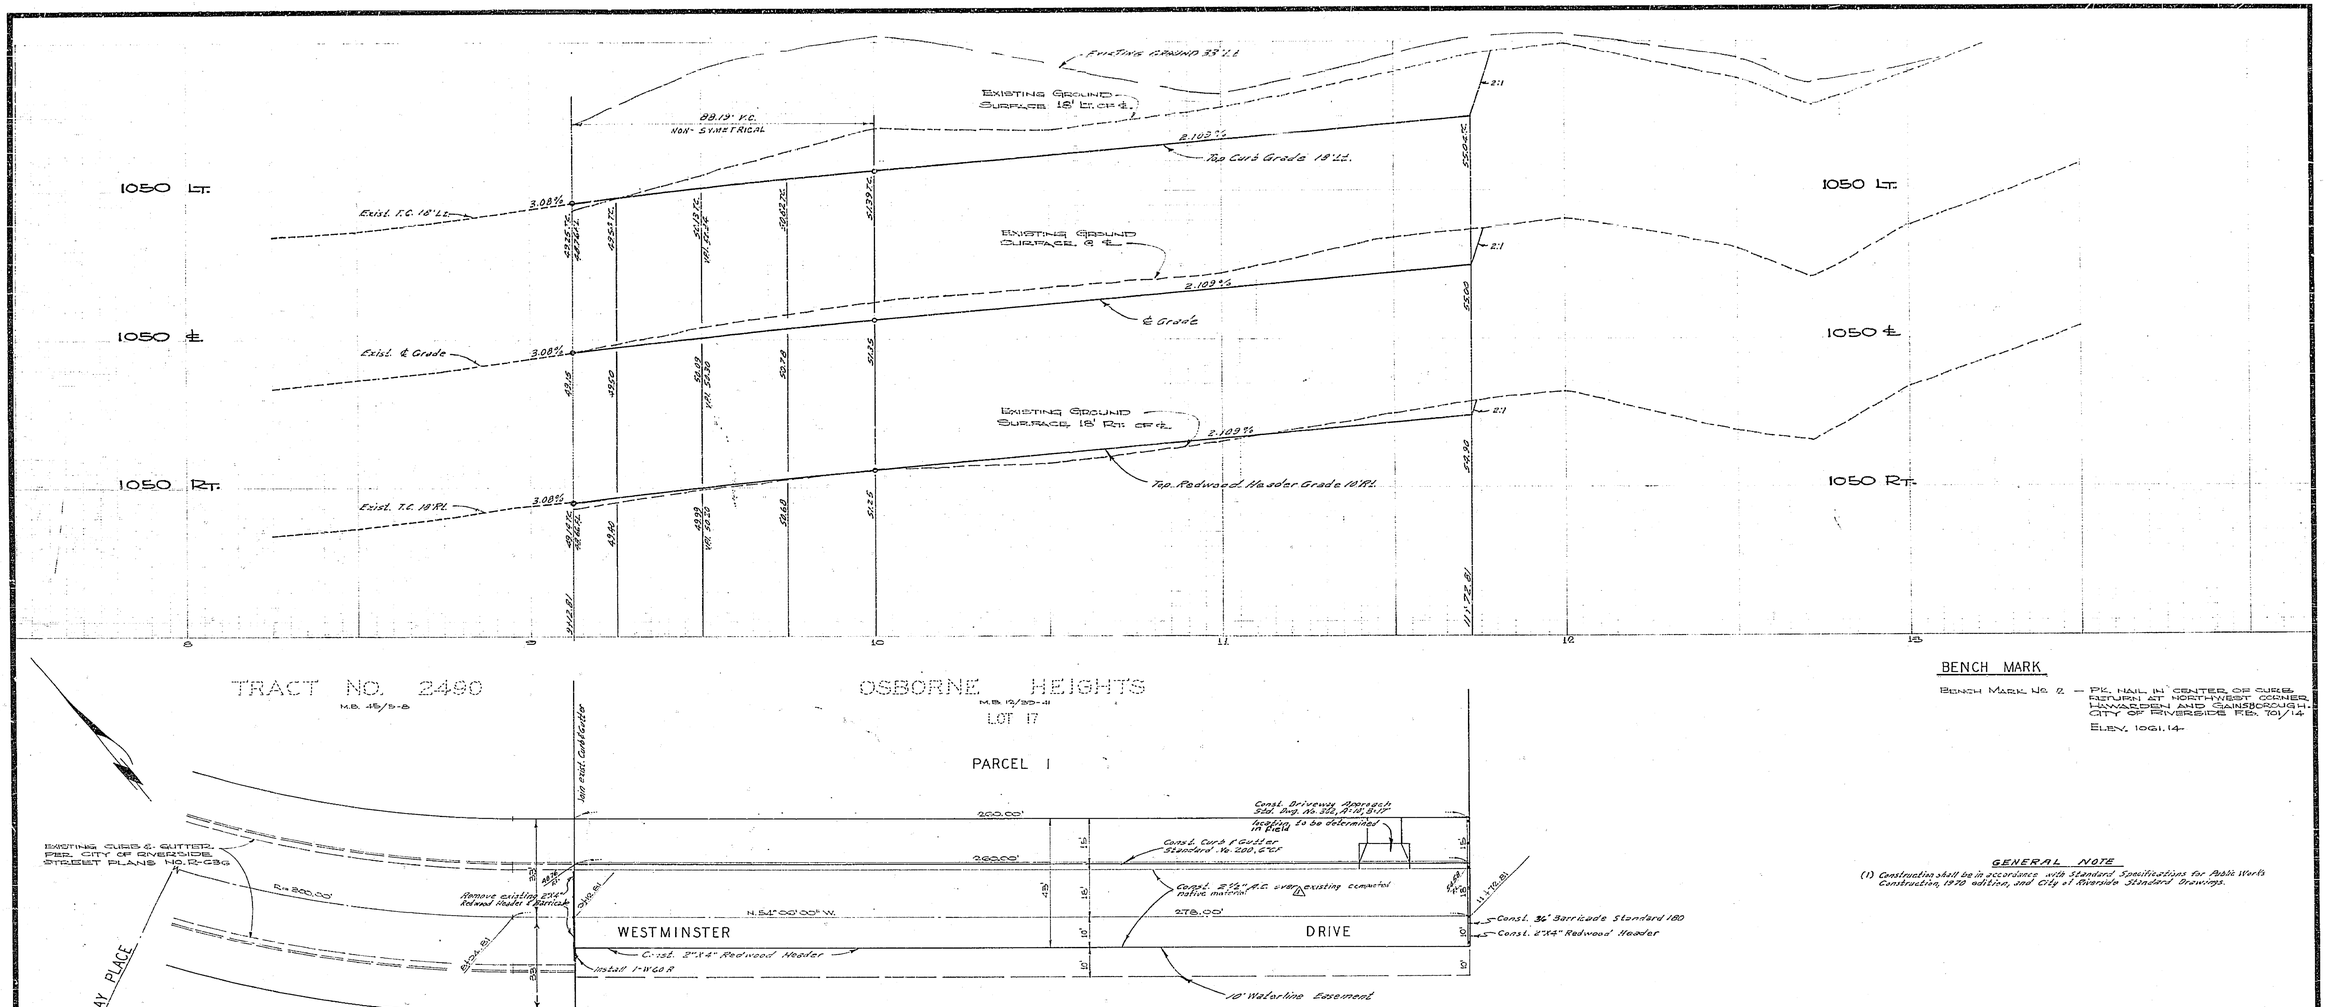

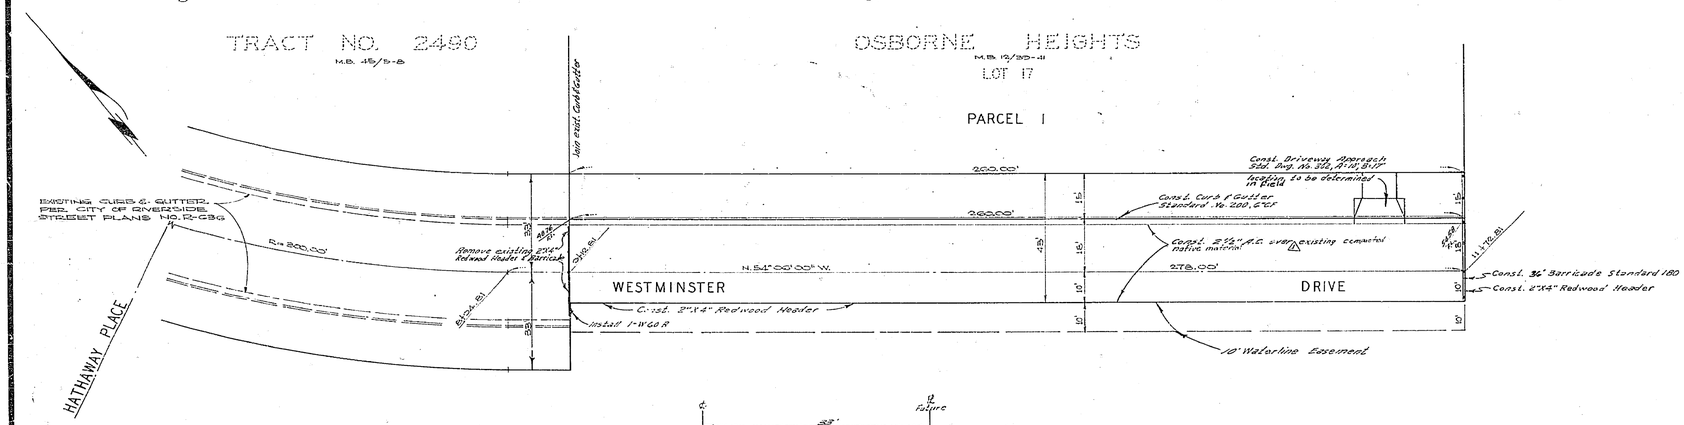

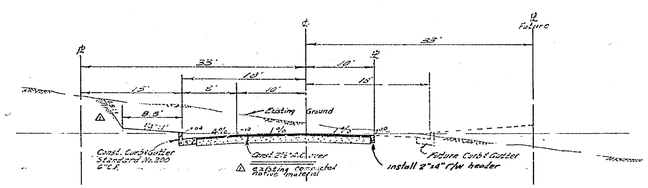

TYPICAL SECTION
WESTMINSTER DRIVE

NO SCALE
T.I. #5

BENCH MARK

Bench Mark No. 2 — PK. NAIL IN CENTER OF CURB RETURN AT NORTHWEST CORNER HAWARDEN AND GAINSBOROUGH. CITY OF RIVERSIDE F.B. 70/14

Elev. 1061.14

GENERAL NOTE

(1) Construction shall be in accordance with Standard Specifications for Public Works Construction, 1970 edition, and City of Riverside Standard Drawings.

AS BUILT 4/27/72 ec.

ALBERT A. WEBB ASSOCIATES
CIVIL ENGINEERS
RIVERSIDE, CALIFORNIA

APPROVED BY Robert N. Webb DATE 1/19/71
R.E. No. 9876

W.O. 70-145 FOR: Dann C. Warr F.B. 1030

MARK	REVISIONS	APPR.	DATE
1	(requested by owner) Add cobble, revised typical section and added level back		6-28-71

DESIGNED BY B.E.L. DRAWN BY B.E.L. CHECKED BY B.B.

CITY OF RIVERSIDE, CALIFORNIA
PUBLIC WORKS DEPARTMENT

APPROVED BY	BY	DATE
PRINCIPAL ENGINEER		
PARK DEPARTMENT		
TRAFFIC DIVISION		
CHIEF PUB. WKS. ENGR.		

APPROVED BY
DIRECTOR OF PUBLIC WORKS
DATE 3/27/71

STREET PLAN AND PROFILE
WESTMINSTER DRIVE
238'±S.E'ly OF HATHAWAY PLACE
PARCEL MAP NO. 14

SCALE: HORIZ. 1" = 20' ; VERT. 1" = 4'

ACCOUNT No.
DRAWING NUMBER R-1474
SHEET 1 OF 1
70-14-B-A