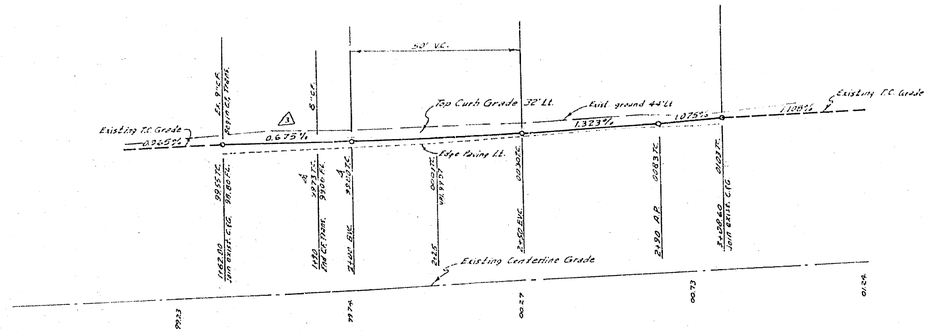

800 LT.

800 ℄

LT. 800

℄ 800

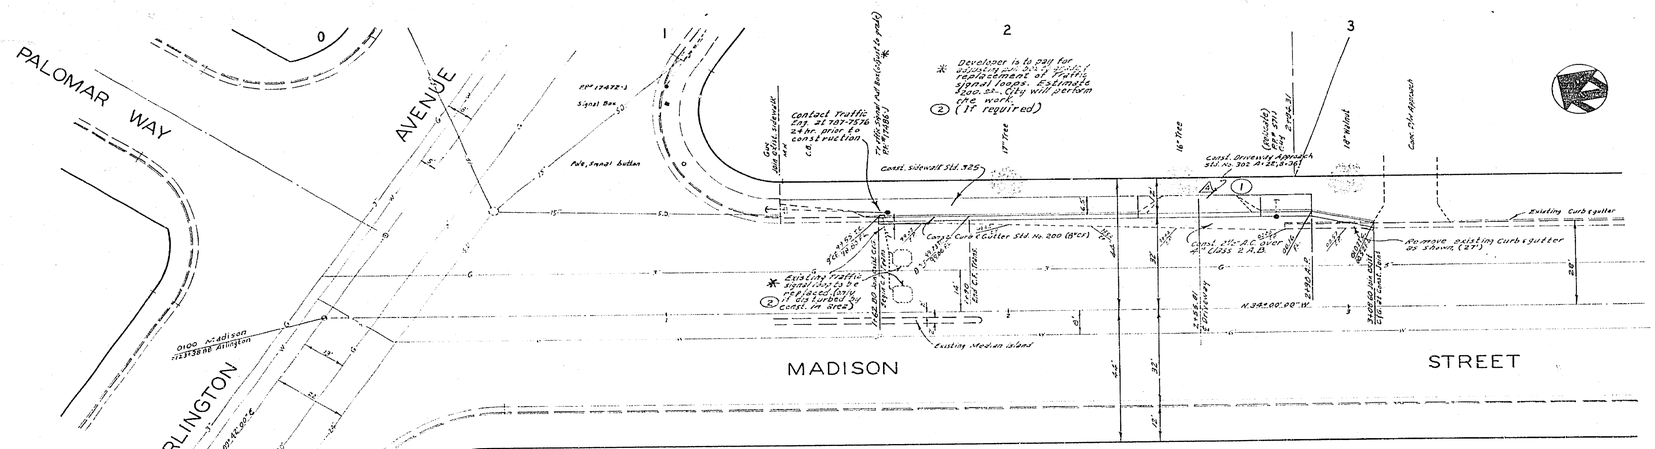

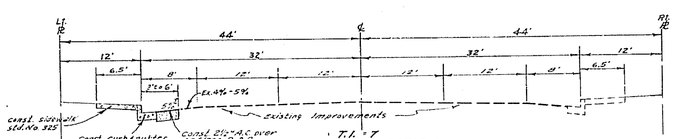

T.I. = 7

TYPICAL SECTION
MADISON STREET
NO SCALE

BENCH MARK

G.S.-C. Fund conc. monument with wire down, 1½" set monument cap at intersection of Arlington Ave. and Madison Ave. City of Riv. B.B. 735/29

GENERAL NOTES:

1. Construction shall be in accordance with the Standard Specifications for Public Works construction (1972 edition), and per City Std. Dwg.
2. All flagged elevations shall be staked in the field by the Engineer.
3. The subdivider shall arrange for a soil test to be made by soils Engineer after the street has been prepared to rough grade. Depth of base material and A.C. paving shall be determined by City of Riverside design standard and test procedures.

ALBERT A. WEBB ASSOCIATES
CIVIL ENGINEERS
RIVERSIDE, CALIFORNIA

APPROVED BY [signature] DATE 7/15/72
R.E. No. 9876
W.O. 72-223 FOR: Brown & Rawdon F.B. 1027

MARK	REVISIONS	BY	APPR.	DATE
4	Approved Alley showing (to be approved at hearing) Per Traffic Eng. (10-25-73)			10/25/73
3	Revised grade to meet Ex. Pav. Per Traffic Eng. (5-31-73)			5-4-73
2	Added (if required note) Per Traffic Eng. (11-15-72)			11-15-72
1	Revised location of Driveway per City plan Dwg. 302-A-2E,3-302			11-15-72

DESIGNED BY B.E.L. DRAWN BY B.E.L. CHECKED BY J.L.

CITY OF RIVERSIDE, CALIFORNIA
PUBLIC WORKS DEPARTMENT

APPROVED BY	BY	DATE
PRINCIPAL ENGINEER		
PARK DEPARTMENT		
TRAFFIC DIVISION		
CHIEF PUB. WKS. ENGR.		

APPROVED BY [signature]
DIRECTOR OF PUBLIC WORKS
DATE [signature]

STREET PLAN AND PROFILE
MADISON STREET
EASTERLY SIDE 300'± SOUTHERLY OF ARLINGTON AVENUE
Zoning Case R-50-712
SCALE: 1"=20' Horiz., 1"=4' Vert.

ACCOUNT No.
DRAWING NUMBER R-1598
SHEET 1 OF 1
72-223-A

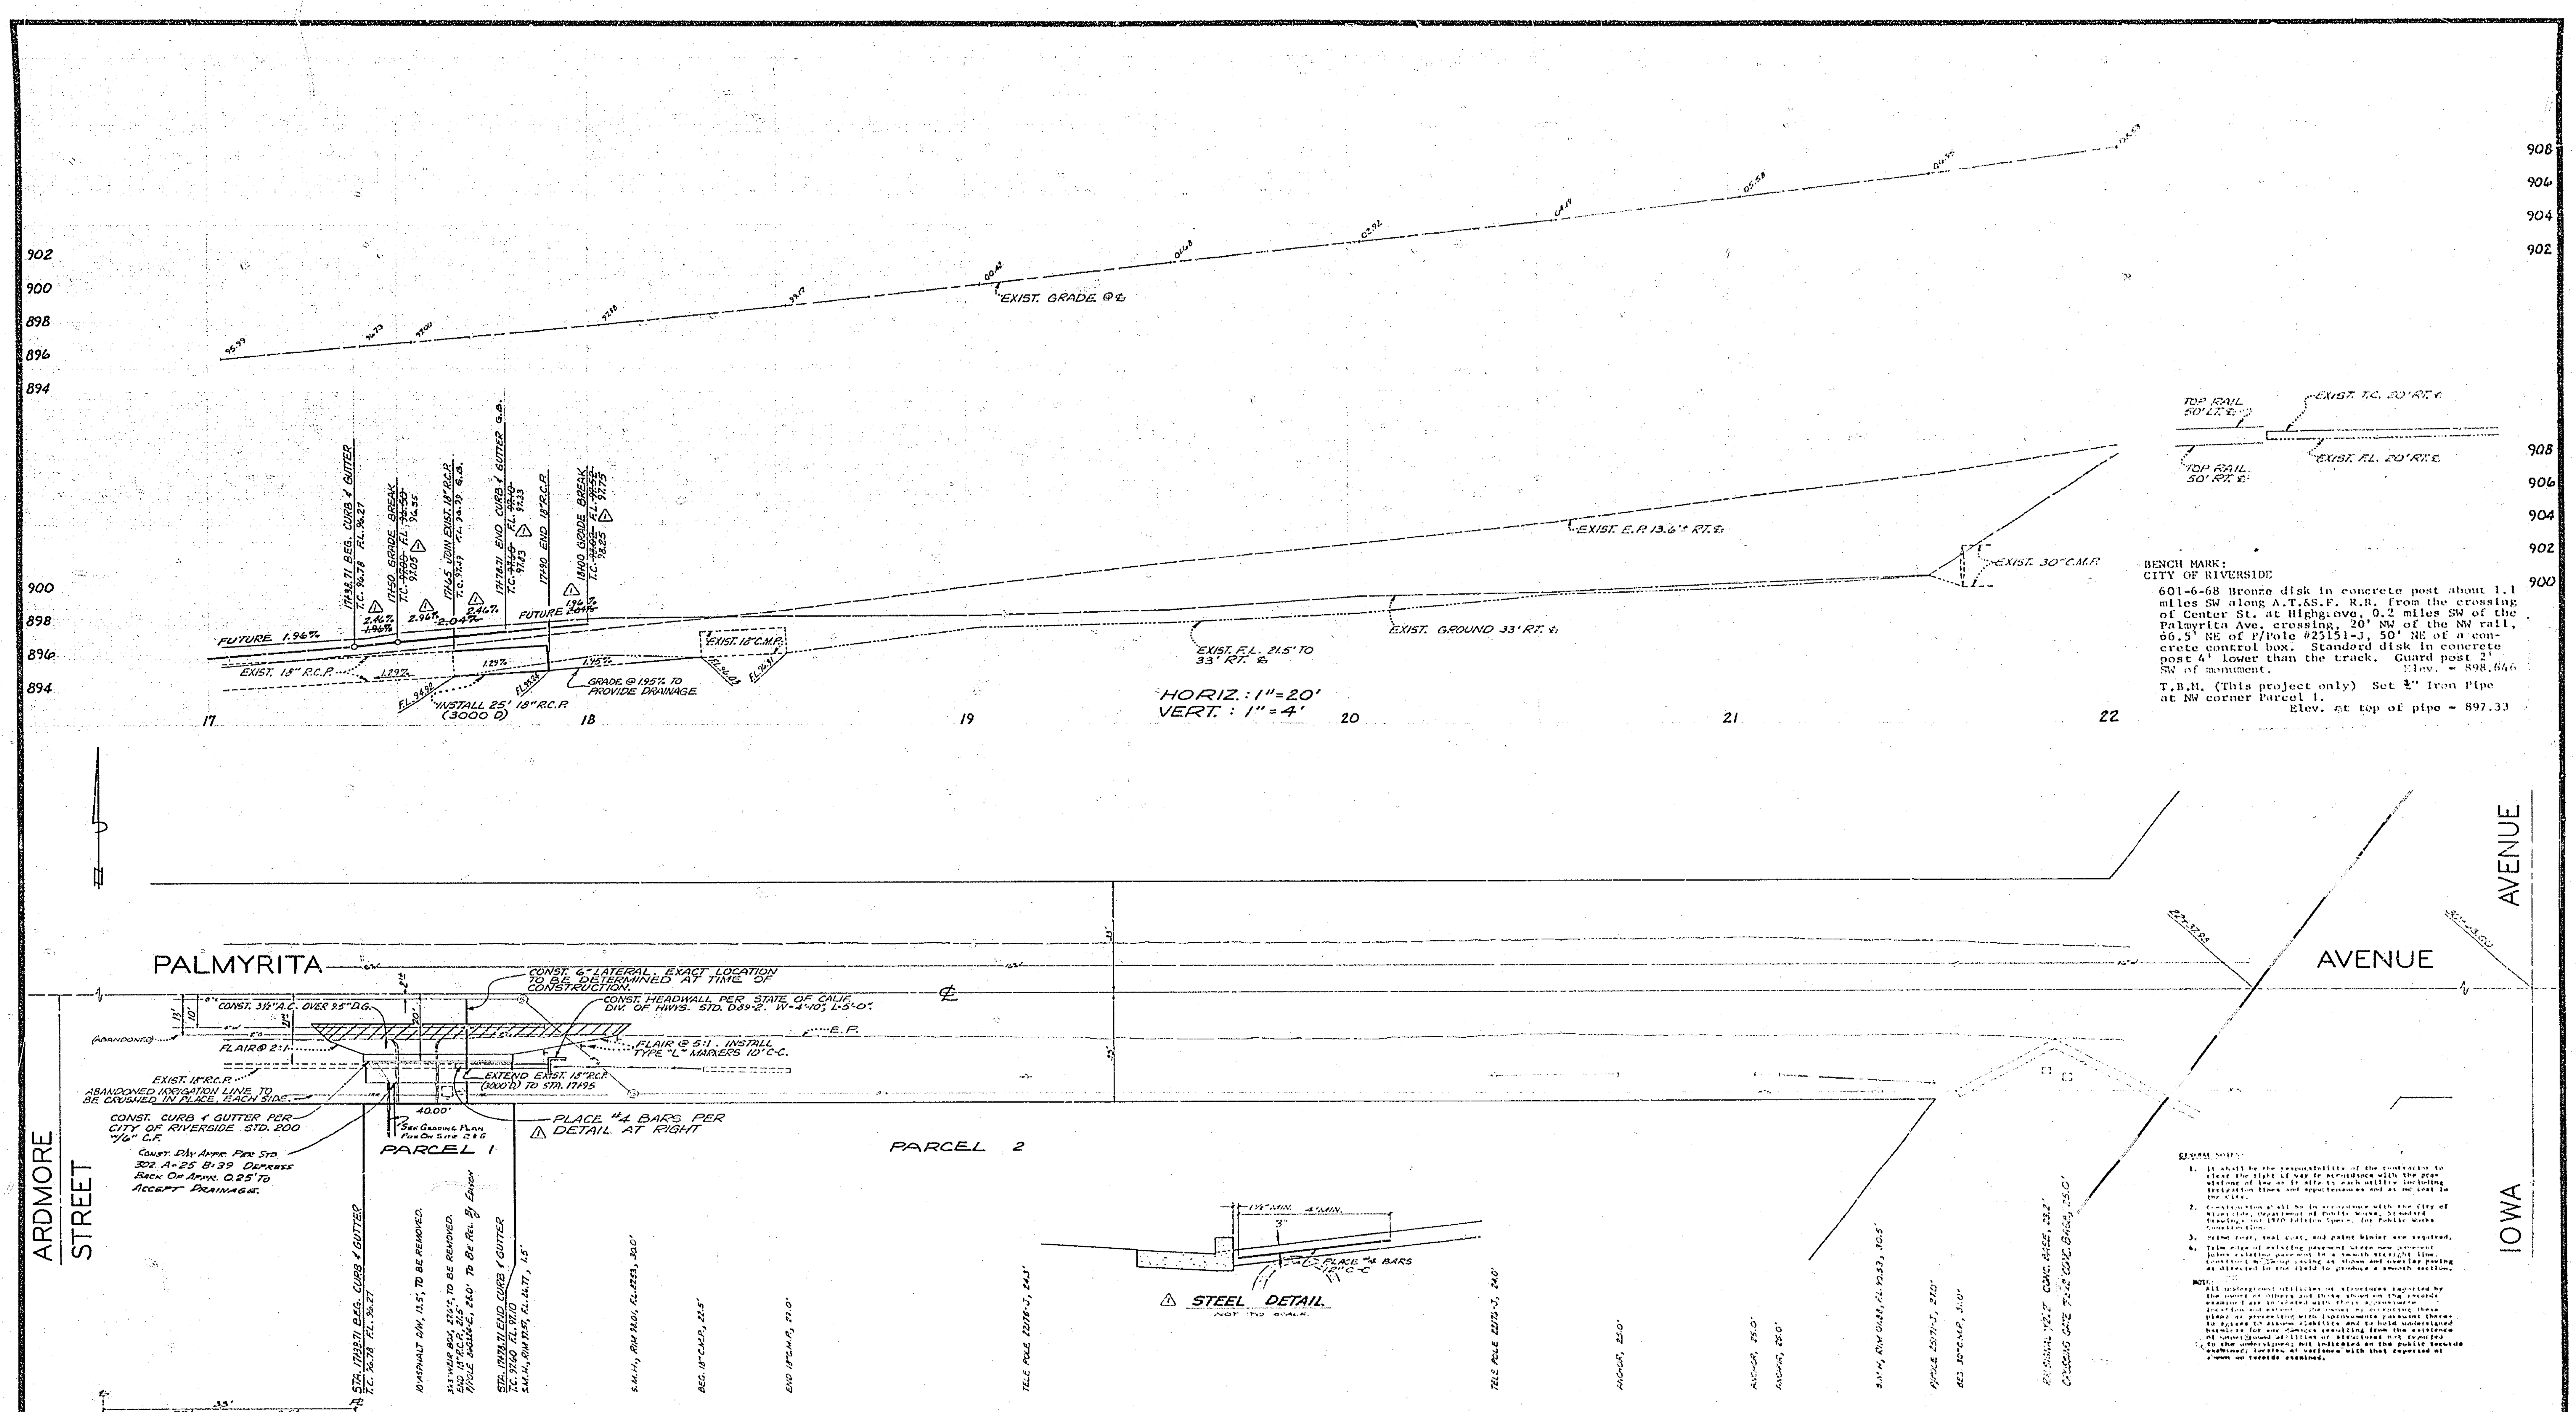

J.F.D. REFERENCE
4534 - Grading Plan

J. F. DAVIDSON ASSOCIATES
CIVIL ENGINEERS - SURVEYORS - PLANNERS
RIVERSIDE, CALIFORNIA
APPROVED BY Robert S. Kipper DATE 5-2-72
R.E. No. 13699

W.O. 3211 FOR Jeglum Pipe & Supply F.B. 1063

REVISIONS: "As Built" No Changes; Revised T.C. Grades to Clear W.D. Culvert

DESIGNED BY AW DRAWN BY AW CHECKED BY

CITY OF RIVERSIDE, CALIFORNIA
DEPARTMENT OF PUBLIC WORKS
APPROVED BY William D. Gordon
DIRECTOR OF PUBLIC WORKS
DATE 7/14/72

STREET PLAN & PROFILE
PALMYRITA AVENUE
S'LY SIDE
1284.29' TO 1324.29' W'LY OF LA CADENA
RM. 79

HORIZ. SCALE: 1" = 20' VERT. SCALE: 1" = 4'

PROJECT NO. R-1589
SHEET 1 OF 1
FILE NO. 4430