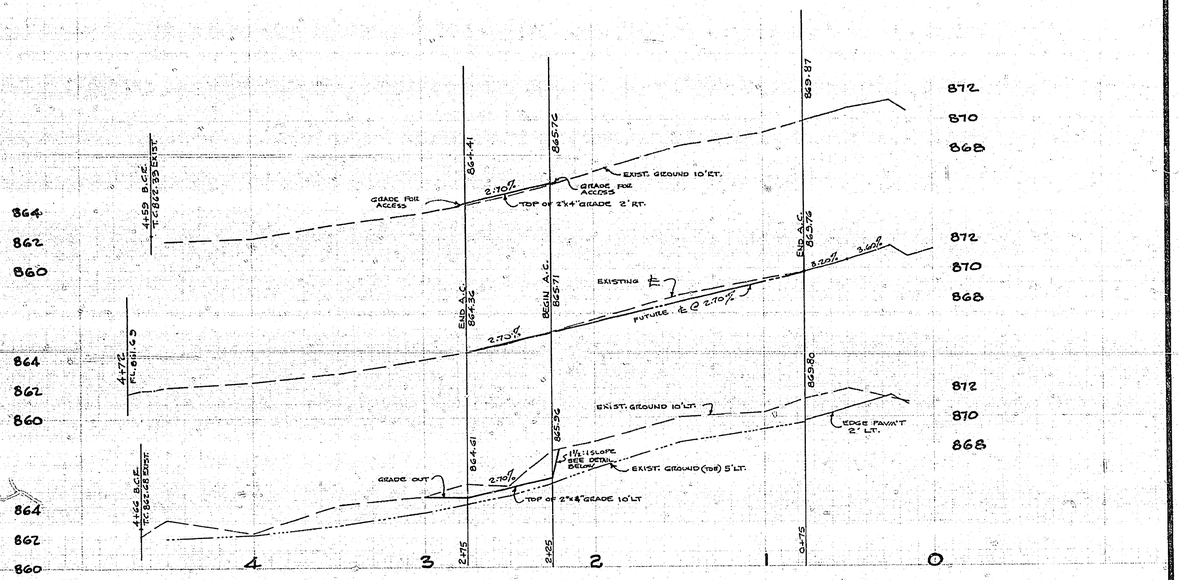

CONSTRUCTION NOTES:

1. ALL CONSTRUCTION SHALL BE IN ACCORDANCE WITH THE STANDARD SPECIFICATIONS FOR PUBLIC WORKS CONSTRUCTION, 1970 EDITION, AND PER CITY OF RIVERSIDE STANDARD DRAWINGS.

BENCH MARK: C/R F.B. 473
ELEV. 867.351 SPIKE AND LEAD IN NO. CURB
SPRING GARDEN STREET 10' W. OF W. ℄ OF LAUREL

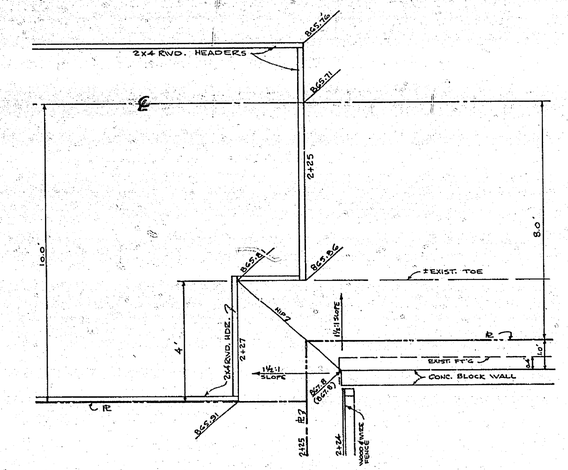

DETAIL "A"
SCALE: 1/2"=1'-0"

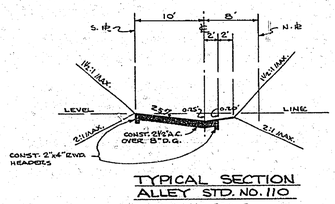

TYPICAL SECTION
ALLEY STD. NO. 110
NO SCALE

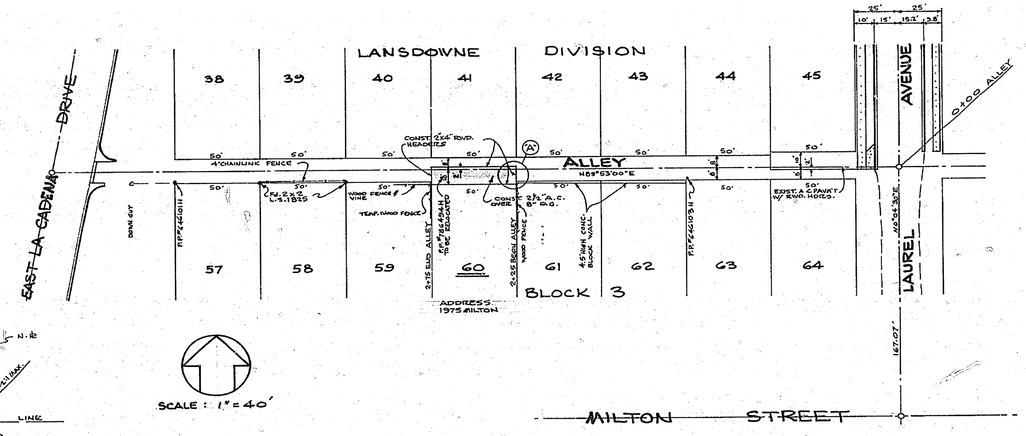

AS BUILT 2-5-73 BDM
(NO CHANGES)

LOCKWOOD ENGINEERING & SURVEYING COMPANY, INC.
380 W. FOOTHILL BLVD.
RIALTO, CALIFORNIA
CARLETON W. LOCKWOOD RCE 9181
8-21-72

MARK	REVISIONS	APPR.	DATE

DESIGNED BY BA DRAWN BY BA CHECKED BY JL

CITY OF RIVERSIDE, CALIFORNIA
DEPARTMENT OF PUBLIC WORKS

APPROVED BY	BY	DATE
PRINCIPAL ENGINEER	—	—
PARK DEPARTMENT	—	—
TRAFFIC DIVISION	[illegible]	9/12
CHIEF P. W. ENGR.	[illegible]	9/18

APPROVED BY [signature]
DIRECTOR OF PUBLIC WORKS
DATE 9-17-72

IMPROVEMENT PLANS

ALLEY
BETWEEN
LAUREL AND FRONTAGE ROAD
BUILDING PERMIT FOR 1975 MILTON ST.

HORIZ. SCALE: 1" = 40' VERT. SCALE: 1" = 4'

INDEXED [illegible]

PROJECT NO. 72-1602

SHEET 1 OF 1

FILE NO.