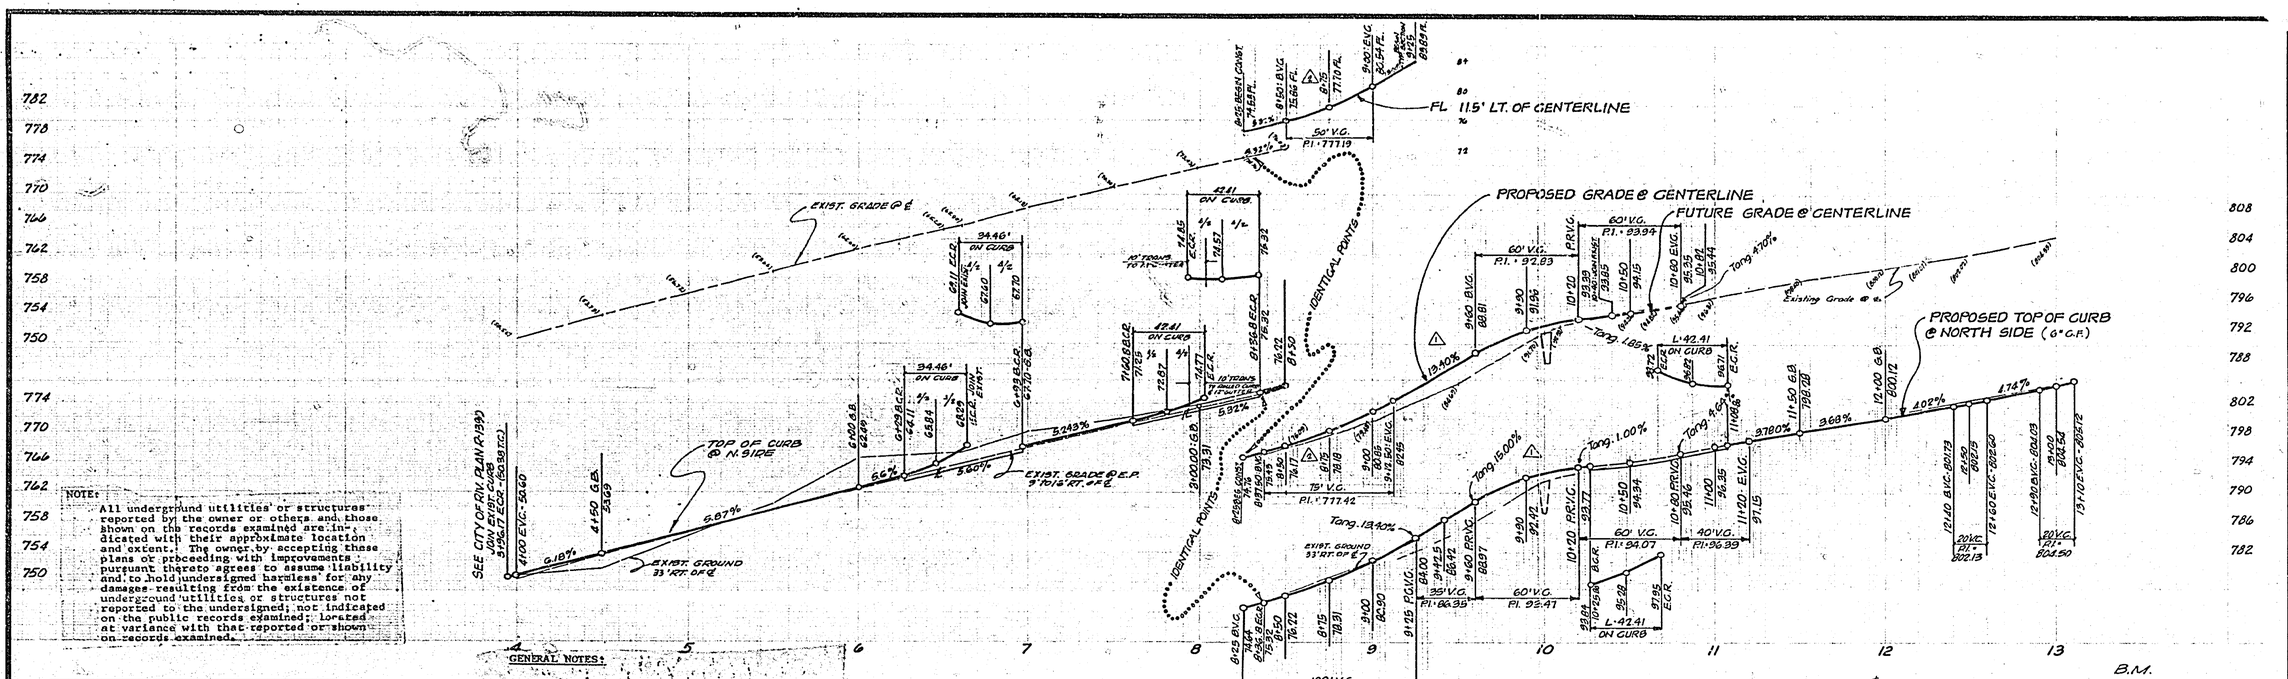

NOTE:

All underground utilities or structures reported by the owner or others and those shown on the records examined are indicated with their approximate location and extent. The owner by accepting these plans or proceeding with improvements pursuant thereto agrees to assume liability and to hold undersigned harmless for any damages resulting from the existence of underground utilities or structures not reported to the undersigned, not indicated on the public records examined, located at variance with that reported or shown on records examined.

CROSS-FALL SCHEDULE

STATION	DRIVING LANE	PARKING LANE
4+00	(2.55%)	2.13%
4+50	(2.00%)	3.50%
5+00	(0.75%)	5.00%
5+50	(1.08%)	4.63%
6+00	(2.30%)	3.38%
7+00	(1.49%)	4.50%
7+50	(2.39%)	4.88%
8+50	2.00%	2.17%
9+00	2.00%	2.17%
9+25	2.00%	5.00%
9+42.5	2.00%	3.83%
9+60	1.58%	1.58%
9+90	-.50%	-.50%
10+20	0.00%	0.00%
10+81.3	-(1.00%)	-1.80%
11+00	(.80%)	3.10%
11+50	(0.80%)	6.38%
12+00	(0.80%)	3.76%
12+50	(+0.36%)	3.50%
13+00	(1.25%)	4.17%
13+50	(0.26%)	5.17%
14+00	(+1.00%)	3.50%
14+50	(+1.00%)	3.17%
15+00	(+0.65%)	5.17%
14+50	(1.00%)	2.33%
17+00	(+0.54%)	6.83%
17+50	2.00%	4.00%
18+00	2.00%	4.50%
18+50	2.00%	5.97%
19+00	2.00%	4.00%
19+50	2.00%	4.67%
20+00	2.00%	4.83%
20+50	2.00%	5.33%
21+00	2.00%	2.00%
21+50	(0.60%)	4.50%
22+00	(2.53%)	3.17%

( ) EXISTING

GENERAL NOTES:

1. It shall be the responsibility of the contractor to clear the right of way in accordance with the provisions of law as it affects each utility including irrigation lines and appurtenances and at no cost to the City.
2. Construction shall be in accordance with the City of Riverside, Department of Public Works, Standard Drawings and 1973 Edition Specs. for Public Works Construction.
3. Prime coat, seal coat, and paint binder are required.
4. Trim edge of existing pavement where new pavement joins existing pavement to a smooth straight line. Construct match-up paving as shown and overlay paving as directed in the field to produce a smooth section.
5. Notify Traffic Engineering at 787-7366 upon completion of street paving to provide centerline striping prior to opening of street to traffic.

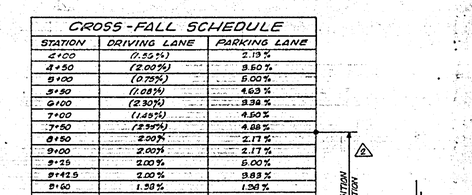

TYPICAL HALF STREET SECTION
FROM 3+99.17 TO 8+25
FROM 10+40 TO 22+09.34
(NO SCALE)
T.I. = 5

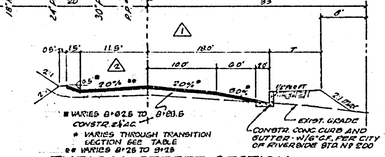

TYPICAL STREET SECTION
FROM 8+25 TO 10+40
(NO SCALE)
T.I. = 5

* VARIES 0+82.5 TO 8+13.6
CONSTR. 8"AC
* VARIES THROUGH TRANSITION SECTION SEE TABLE OF VARIES 8+25 TO 9+25

NOTE:
FROM STA. 8+25 TO 8+50, 10+25 TO 10+40 A.C. OVERLAY HAS BEEN PLACED TO CONST. THIS SECTION

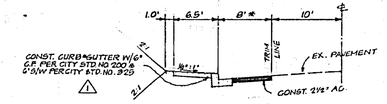

TYPICAL STREET SECTION
FROM STA. 16+18 TO 17+04
NO SCALE
T.I. = 5

* 8' - FROM STA. 10+18 TO 16+90
VARIES FROM STA. 16+90 TO 17+04

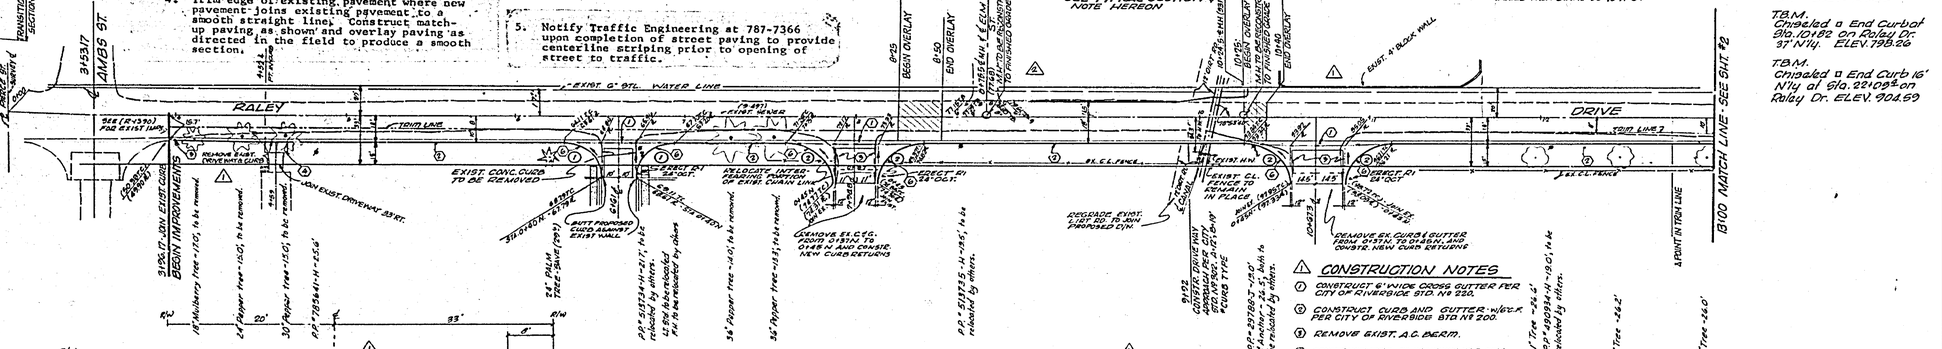

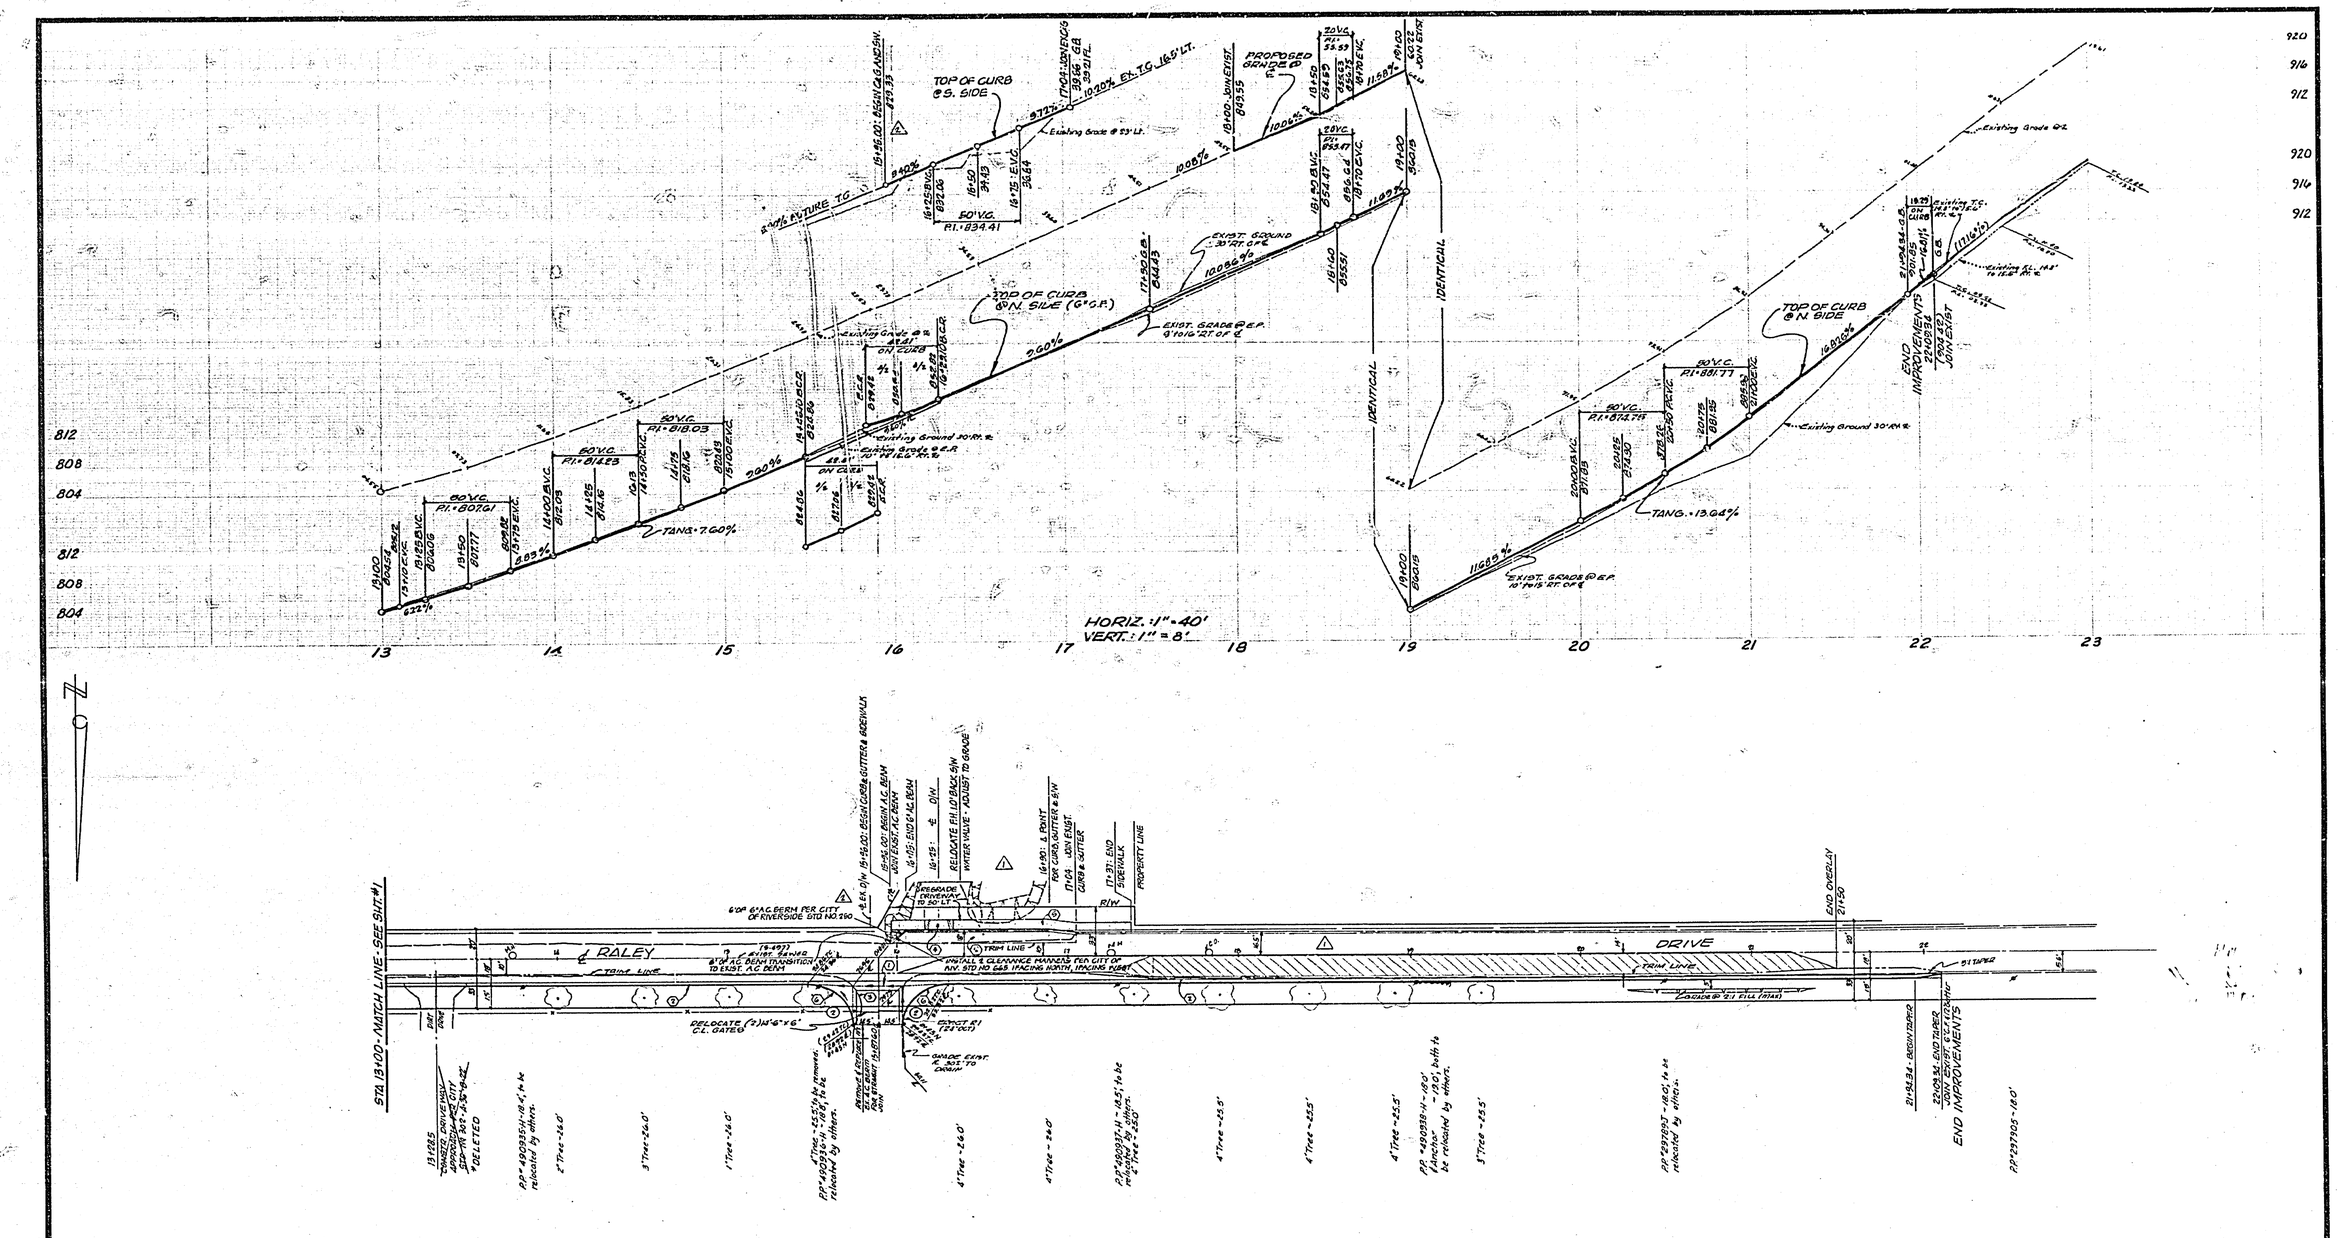

*AS BUILT 3-77 KBT

J. F. DAVIDSON ASSOCIATES
CIVIL ENGINEERS - SURVEYORS - PLANNERS
RIVERSIDE, CALIFORNIA
APPROVED BY [signature] DATE 9-12-73
R.E. No. 12891
W.O. 3241 FOR: Loma Linda University F.B. 204/12

MARK	REVISIONS	APPR.	DATE
1	REVISED GRADES, CENTERLINE BEARINGS, AND LIMITS OF CONSTRUCTION	[illegible]	1-22-74
2	REVISED CURB, GUTTER & SIDEWALK LOCATIONS	[illegible]	5-17-74

DESIGNED BY AW DRAWN BY MAC CHECKED BY W

CITY OF RIVERSIDE, CALIFORNIA
DEPARTMENT OF PUBLIC WORKS

APPROVED BY	BY	DATE
OFFICE ENGINEER	[illegible]	10/10
PARK DEPARTMENT	RD	10-31
TRAFFIC DIVISION	RC	11/21
ASSISTANT CITY ENG.	[illegible]	10-15

APPROVED BY [signature]
DIRECTOR OF PUBLIC WORKS
DATE 10-16-74

STREET PLAN & PROFILE
RALEY DRIVE
W'LY OF PIERCE STREET FROM STA. 4100 TO STA. 22+50
C-92-712 PHASE 1

HORIZ. SCALE: 1" - 40' VERT. SCALE: 1" - 8'

PROJECT NO. R-1607
SHEET 2 OF 2
FILE NO. 4435