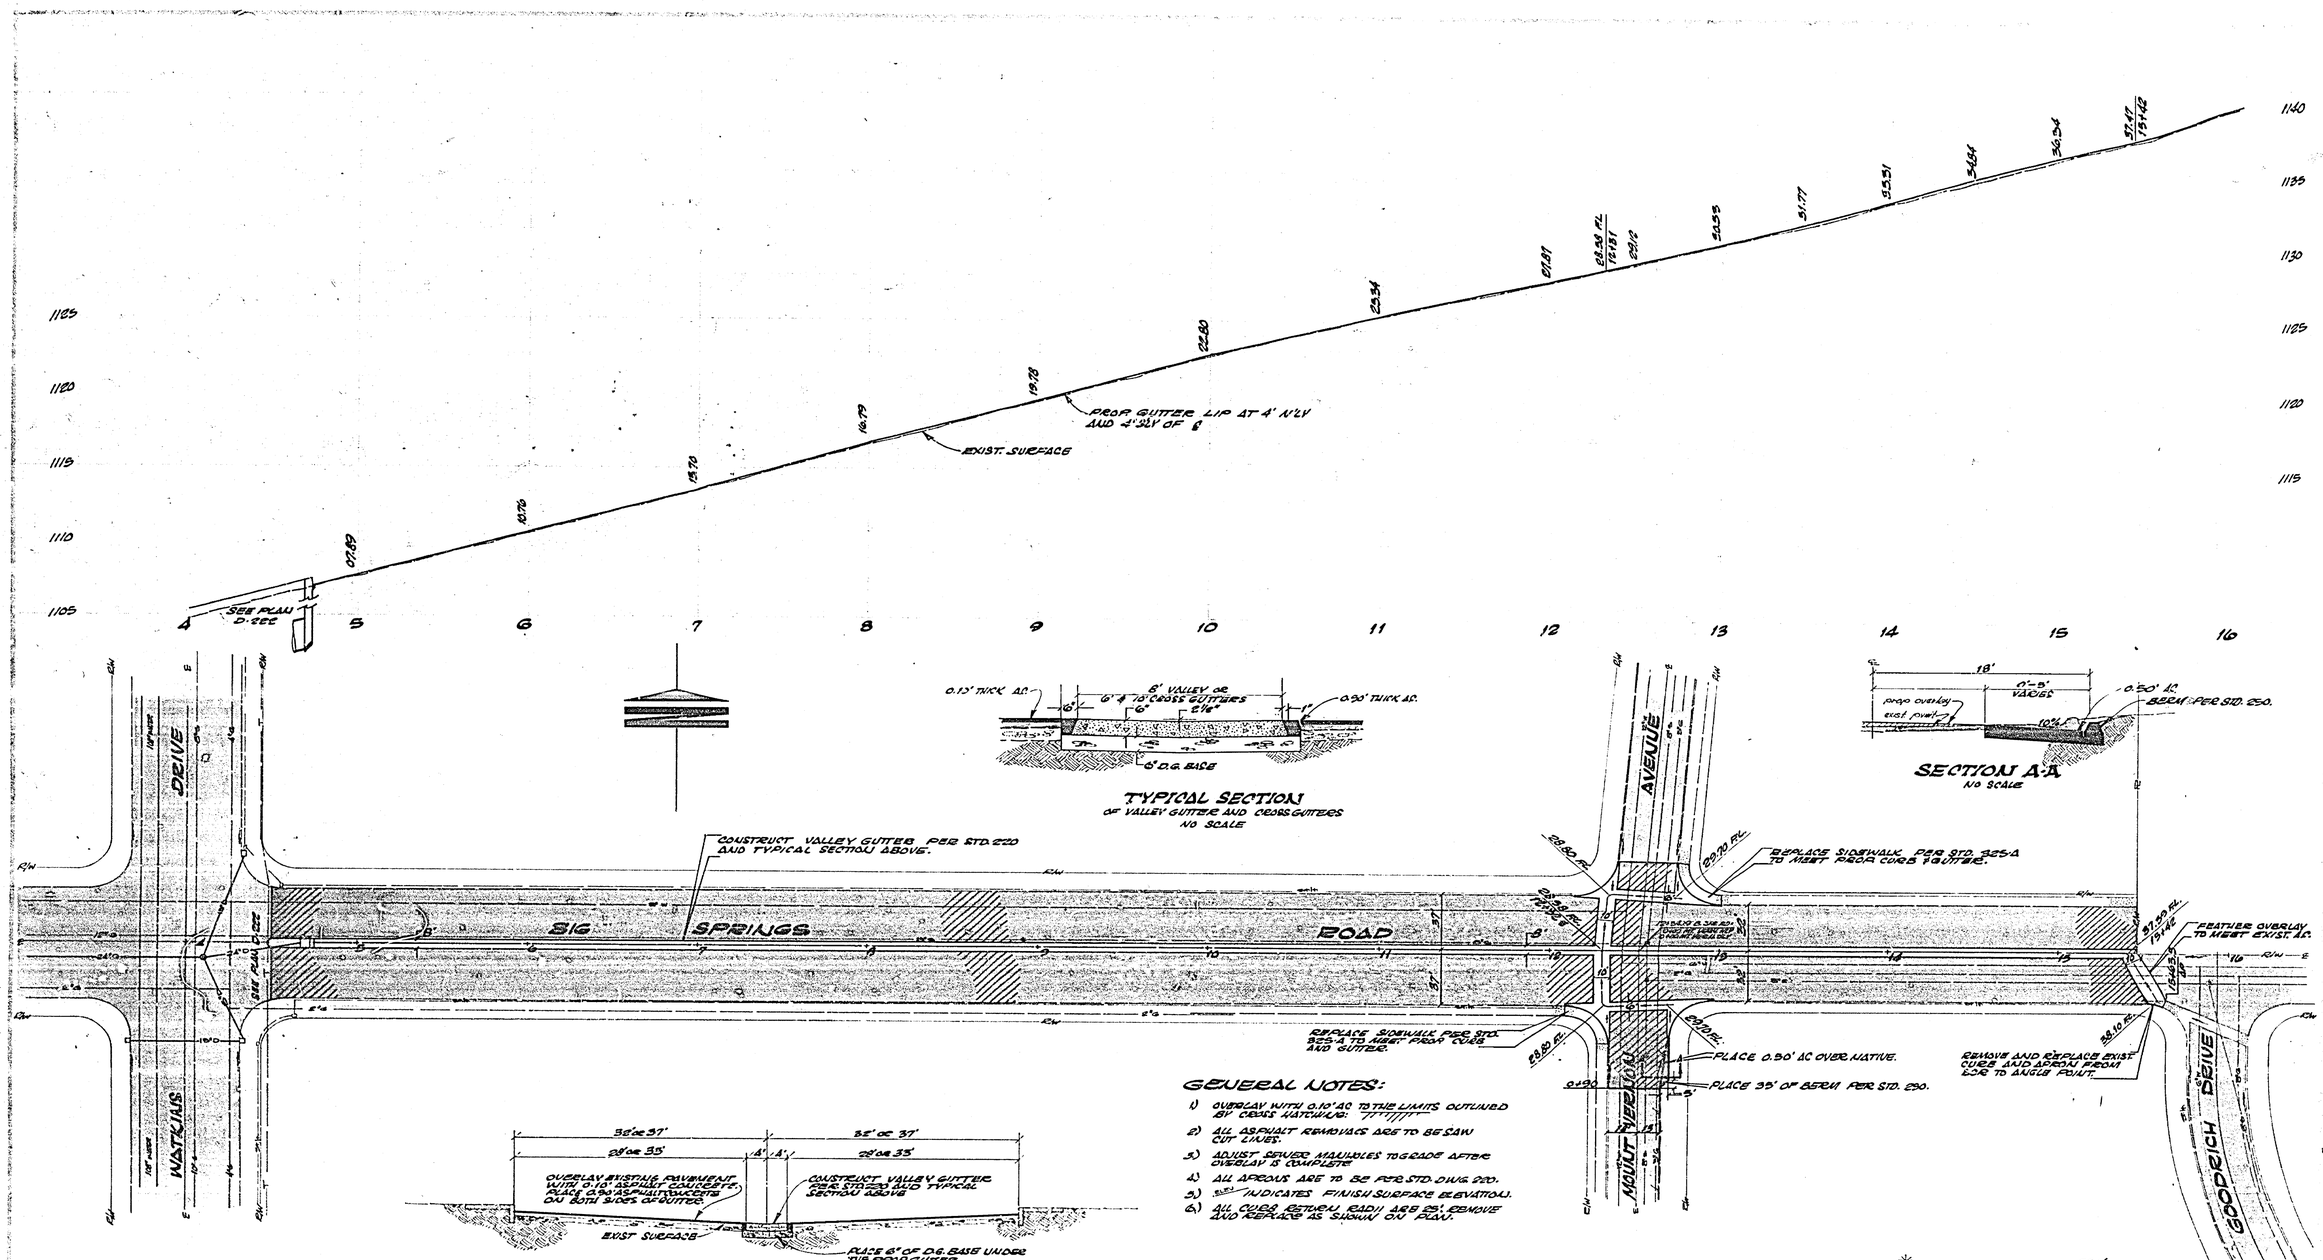

* AS BUILT 5-28-74