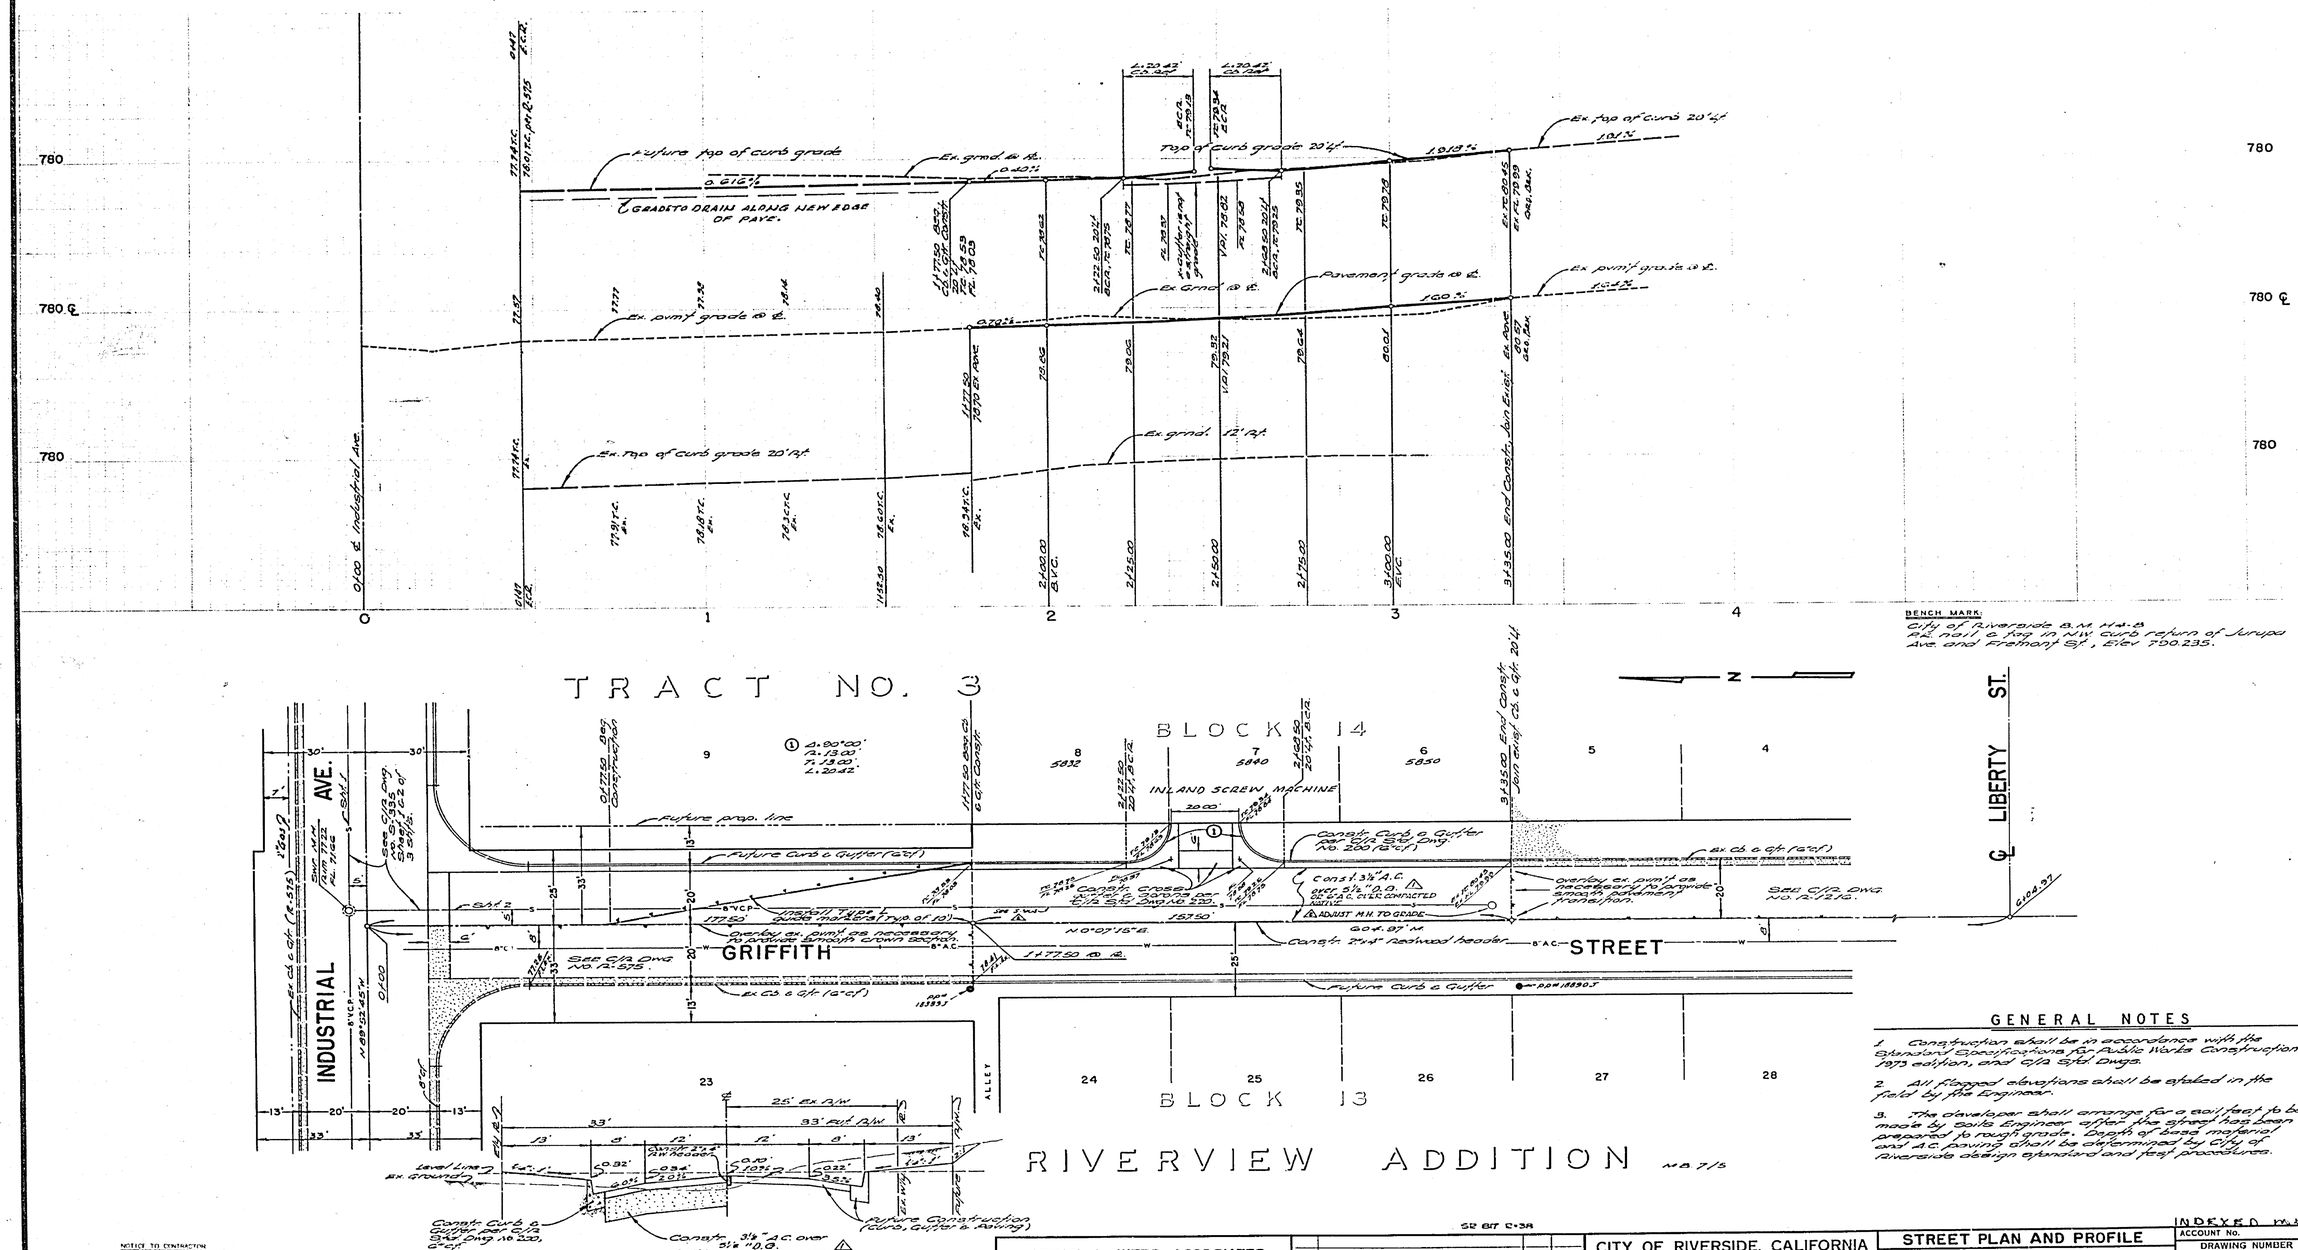

BENCH MARK:
City of Riverside B.M. H4-B
R.R. nail & tag in N.W. curb return of Jurupa Ave. and Fremont St., Elev. 790.235.

GENERAL NOTES

1. Construction shall be in accordance with the Standard Specifications for Public Works Construction 1973 edition, and C/R Std. Dwgs.
2. All flagged elevations shall be staked in the field by the Engineer.
3. The developer shall arrange for a soil test to be made by Soils Engineer after the street has been prepared to rough grade. Depth of base material and A.C. paving shall be determined by City of Riverside design standard and test procedures.

NOTICE TO CONTRACTOR

The existence and location of any underground utility pipes or structures shown on these plans are obtained by a search of the available records. To the best of our knowledge, there are no existing utilities except as shown on these plans.

The Contractor is required to take due precautions to measures to protect the utility lines shown and any other [illegible] not of record or not shown on these plans.

TYPICAL SECTION
GRIFFITH STREET
STA. 1+72.00 - 3+35.00
No Scale T.1.F.6

SR BIT C-38

ALBERT A. WEBB ASSOCIATES
CIVIL ENGINEERS
RIVERSIDE, CALIFORNIA
APPROVED BY [signature] DATE 10/26/72
R.E. No. 9878
W.O. 72-321 FOR: INLAND SCREW MACHINE CO. F.B. 1027

2	Added sewer per S-904 (on just M.H. (2a))	[illegible]	[illegible]
1	Added pavement section	[illegible]	1-8-74
MARK	REVISIONS	APPR.	DATE

DESIGNED BY R.E.C. DRAWN BY R.M. CHECKED BY [illegible]

CITY OF RIVERSIDE, CALIFORNIA
PUBLIC WORKS DEPARTMENT

APPROVED BY	BY	DATE
PRINCIPAL ENGINEER	[illegible]	[illegible]
PARK DEPARTMENT		
TRAFFIC DIVISION	[illegible]	11-28
CHIEF PUB. WKS. ENGR.	[illegible]	11-28

APPROVED BY [signature]
DIRECTOR OF PUBLIC WORKS
DATE 9-28-73

Wdg 9.28

STREET PLAN AND PROFILE
GRIFFITH STREET
EAST SIDE – STA. 1+77.50 TO 3+35.00
BUILDING PERMIT - 5832-5840-5850 GRIFFITH ST.
SCALE: HORIZ. 1" = 20' VERT. 1" = 4'

INDEXED [illegible]
ACCOUNT No.
DRAWING NUMBER R-1627
SHEET 1 OF 1
72-321-A