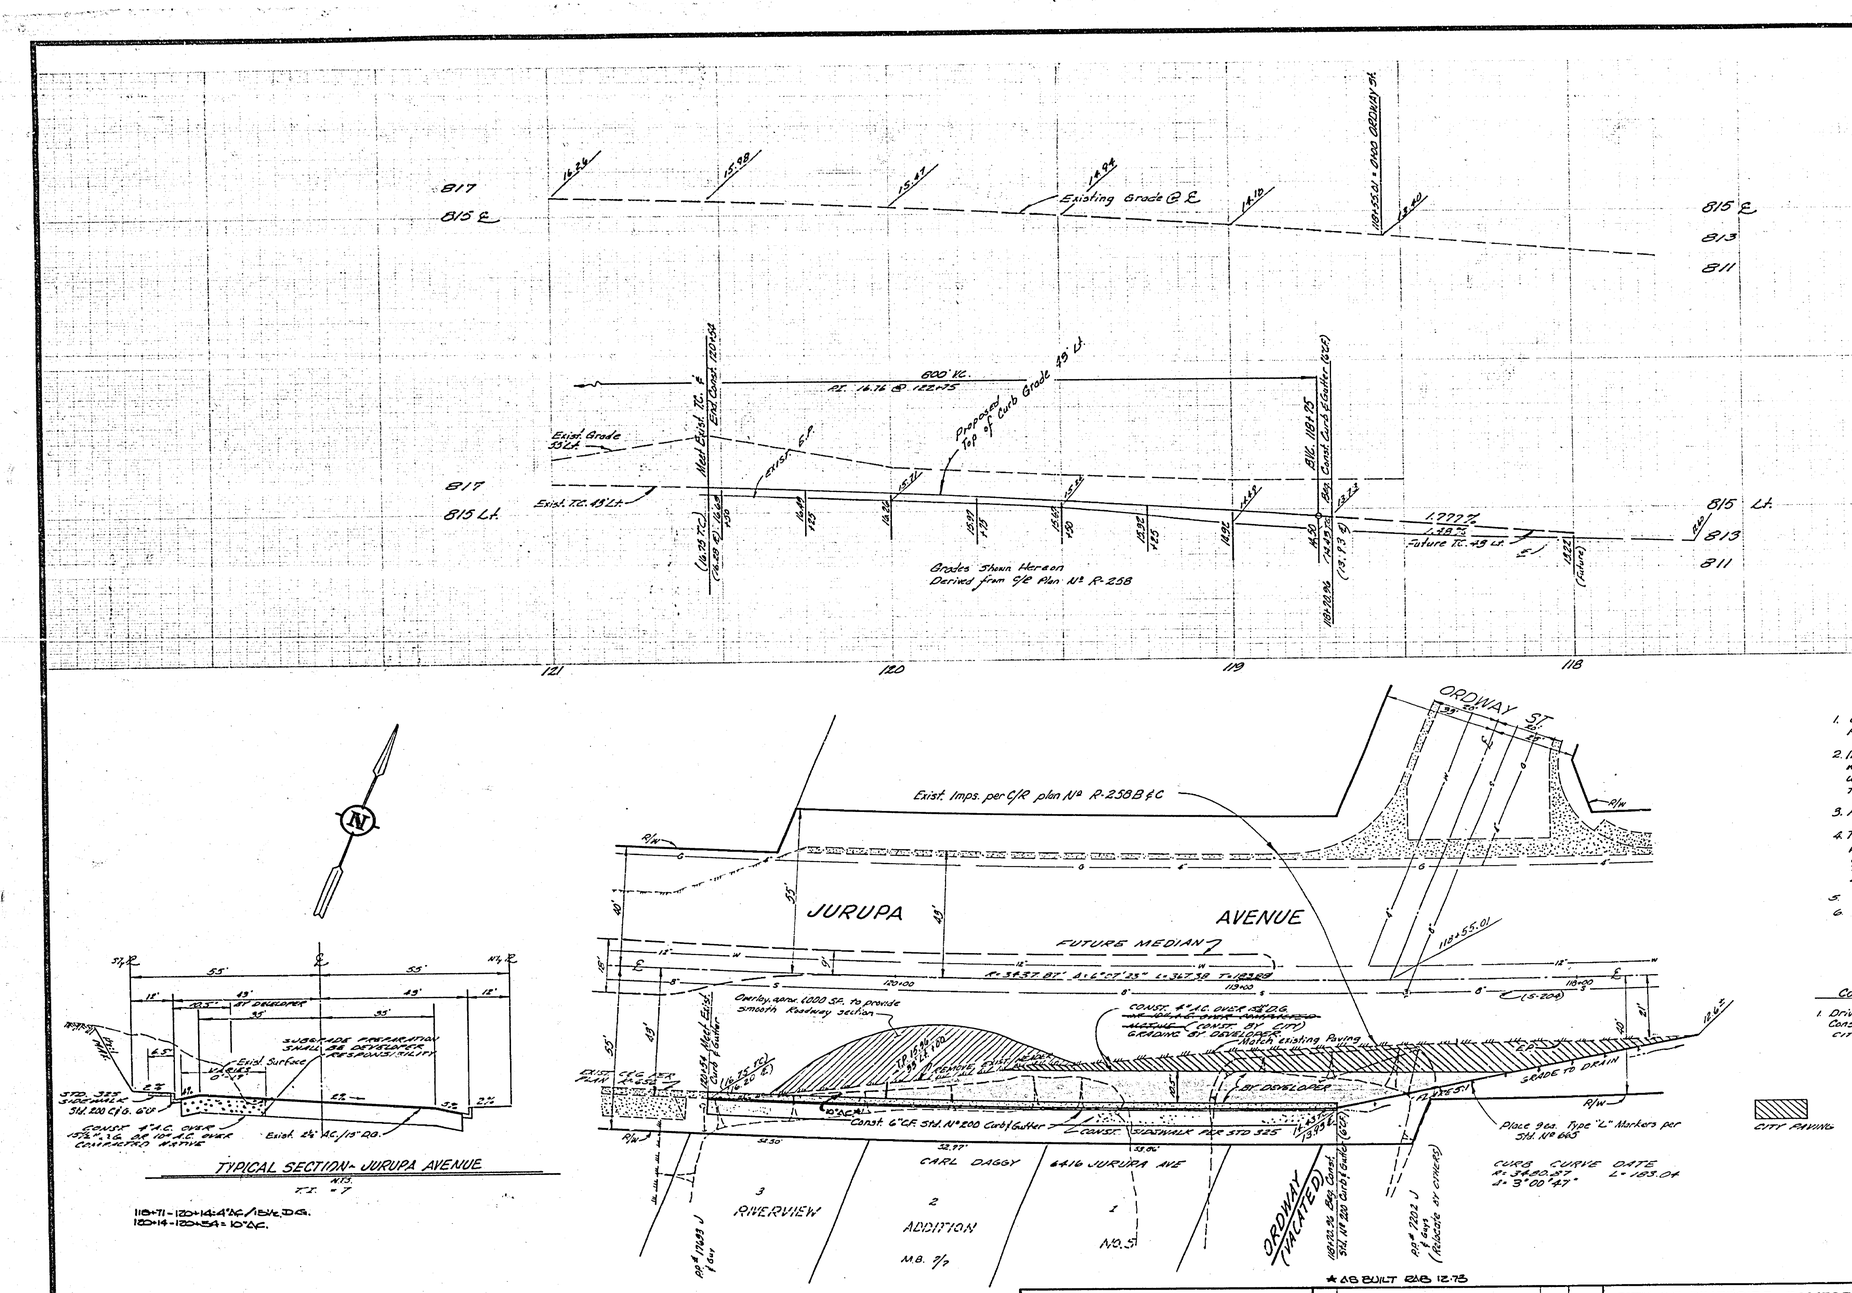

GENERAL NOTES

1. Construction shall be in accordance with Standard Specifications for Public Works Construction, 1970 Edition and CITY OF RIVERSIDE STD DWG.
2. It shall be the responsibility of the contractor to clear the right of way in accordance with the provisions of the law as it affects each utility, including irrigation lines and appurtenances and at no cost to the city.
3. Prime coat, seal coat and paint binder are required.
4. Trim edge of existing pavement where new pavement joins existing pavement to a clean straight edge. Construct match up paving as shown. OVERLAY PAVING AS DIRECTED IN THE FIELD TO PRODUCE A SMOOTH SECTION. ENGINEERS ESTIMATE OF OVERLAY - 15 TONS.
5. CURB TO BE STAKED WITH 3' OFFSET AT 25' INTERVALS.
6. CONTRACTOR TO CONTACT CITY OF RIVERSIDE, PUBLIC WORKS DEPARTMENT TWO WEEKS PRIOR TO CONSTRUCTION TO ARRANGE FOR PAYMENT OF CITY PARTICIPATION WORK.

Construction Notes:

1. Driveway location & Size to be determined AT TIME OF Construction - Construct in accordance with Std. Dwg. No 302 AND AS APPROVED BY CITY TRAFFIC ENGINEER.

BENCH MARK:
H-4-B PK NAIL AND TAG N.W. CURB RETURN @ JURUPA & FREMONT ST. F.B. 739/47
ELEV. 790.235

HAWKINS, ROBERTSON & ASSOC.
ENGINEERS & SURVEYORS
RIVERSIDE CALIFORNIA
Dale G. Gladding 4/5/73
R.C.E. NO. 17055 DATE

MARK	REVISIONS	APPR.	DATE

DESIGNED BY ____ DRAWN BY ____ CHECKED BY BM

CITY OF RIVERSIDE, CALIFORNIA
DEPARTMENT OF PUBLIC WORKS

APPROVED BY	BY	DATE
OFFICE ENGINEER		
PARK DEPARTMENT		
TRAFFIC DIVISION		8-8-73
ASSISTANT CITY ENG.		

APPROVED BY
DIRECTOR OF PUBLIC WORKS
DATE 8-10-73

S'LYSIDE JURUPA AVE.
@ ORDWAY ST.
for
Bld. Pmt. @ 6416 JURUPA AVE.
ML-2-723

HORIZ. SCALE: 1" - 20' VERT. SCALE: 1" - 4'

PROJECT NO. R-1703
SHEET 1 OF 1
FILE NO. 72-2298