740 ℄ 730 ℄ 720 ℄ 740 Rt. 730 Rt. 720 Rt.

13 14 15 16 17 18 19 20 21 22

PROFILE
POLK STREET

PLAN
POLK STREET

TYPICAL SECTION
POLK STREET
STA. 13+54.93 TO STA. 21+06.83

ARLINGTON GARDENS
M.B. 14/34

TRACT NO. 4660
M.B. 74/42-47

WHITE OAK DRIVE

MAGNOLIA AVENUE

DIANA AVENUE

FREEWAY (91)

RIVERSIDE

SEE SHEET NO. 2

See Sheet No. 2 for intersection details.

GENERAL NOTES:

1. Construction shall be in accordance with the Standard Specifications for Public Works Construction 1973 Edition and per City of Riverside Standard Drawings.
2. All Proposed Elevations shall be staked in the field by the Engineer.
3. The Subdivider shall arrange for a Soil Test to be made by a Soils Engineer after the Streets have been prepared to rough grade. Depth of Base Material and A.C. Paving shall be determined by the City of Riverside Design Standards and Test Procedure.
4. Traffic Control signs must be in place prior to opening streets to traffic.
5. Curb will be staked at 5' offsets and 25' intervals.
6. Irrigation line and standpipes in Diana Avenue shall be removed by the Contractor and piped for salvage by Mr. Bill Yamane. - Telephone 787-5170

NOTE: 14" ℄ Existing A.C. Conc. Irrigation Line to be protected during Construction. Any portion damaged during Construction shall be replaced at no cost to the City of Riverside.

BENCH MARK:
3" dia. Disk set in Concrete stamped 601-15-63 on West side of Tyler Street, 150'± North of Indiana Avenue & 1'± N.E. of Bridge No. 56-419. Elevation 760.665

SR-86 | 60

*AS BUILT 8-16 VAT

ALBERT A. WEBB ASSOCIATES
CIVIL ENGINEERS
RIVERSIDE, CALIFORNIA
APPROVED BY [signature] DATE 11-16-73
R.E. No. 12062
W.O. 73-207 FOR: GULF & STUFF F.B. 1032

MARK	REVISIONS	APPR.	DATE
1⁄4	ADD TYPICAL SECTION		12-7-73
2	CONSTRUCT BUTT OF CONCRETE LINED DITCH ON WEST SIDE OF TYLER STREET (STA. 10+00 TO STA. 10+50)		11-16-73
1	RELOCATED CONSTRUCTION ENTRANCE, R.C.B. STORM DRAIN, ADDED SIDEWALK @ STA. 13+00 TO STA. 13+20 & ADDED DRIVEWAYS @ STA. 13+93.00 (RT) & STA. 14+18.00 (RT)		11-16-73

DESIGNED BY RH DRAWN BY RH CHECKED BY [illegible]

CITY OF RIVERSIDE, CALIFORNIA
PUBLIC WORKS DEPARTMENT

	BY	DATE
APPROVED BY PRINCIPAL ENGINEER		
PARK DEPARTMENT		
TRAFFIC DIVISION		
CHIEF PUB. WKS. ENGR.		

APPROVED BY [signature] DIRECTOR OF PUBLIC WORKS
DATE 5/25/74

APPROVED BY [signature] 12-12-73
CHIEF WATER UTILITY ENGINEER — DATE

POLK STREET
WESTERLY SIDE - FROM DIANA AVENUE TO 803'N.L.Y.
C-21-723

ACCOUNT No. 73-207
DRAWING NUMBER R-1721
SHEET 1 OF 2
SCALE: HORIZ. 1"=40'; VERT. 1"=4'
73-207 -A

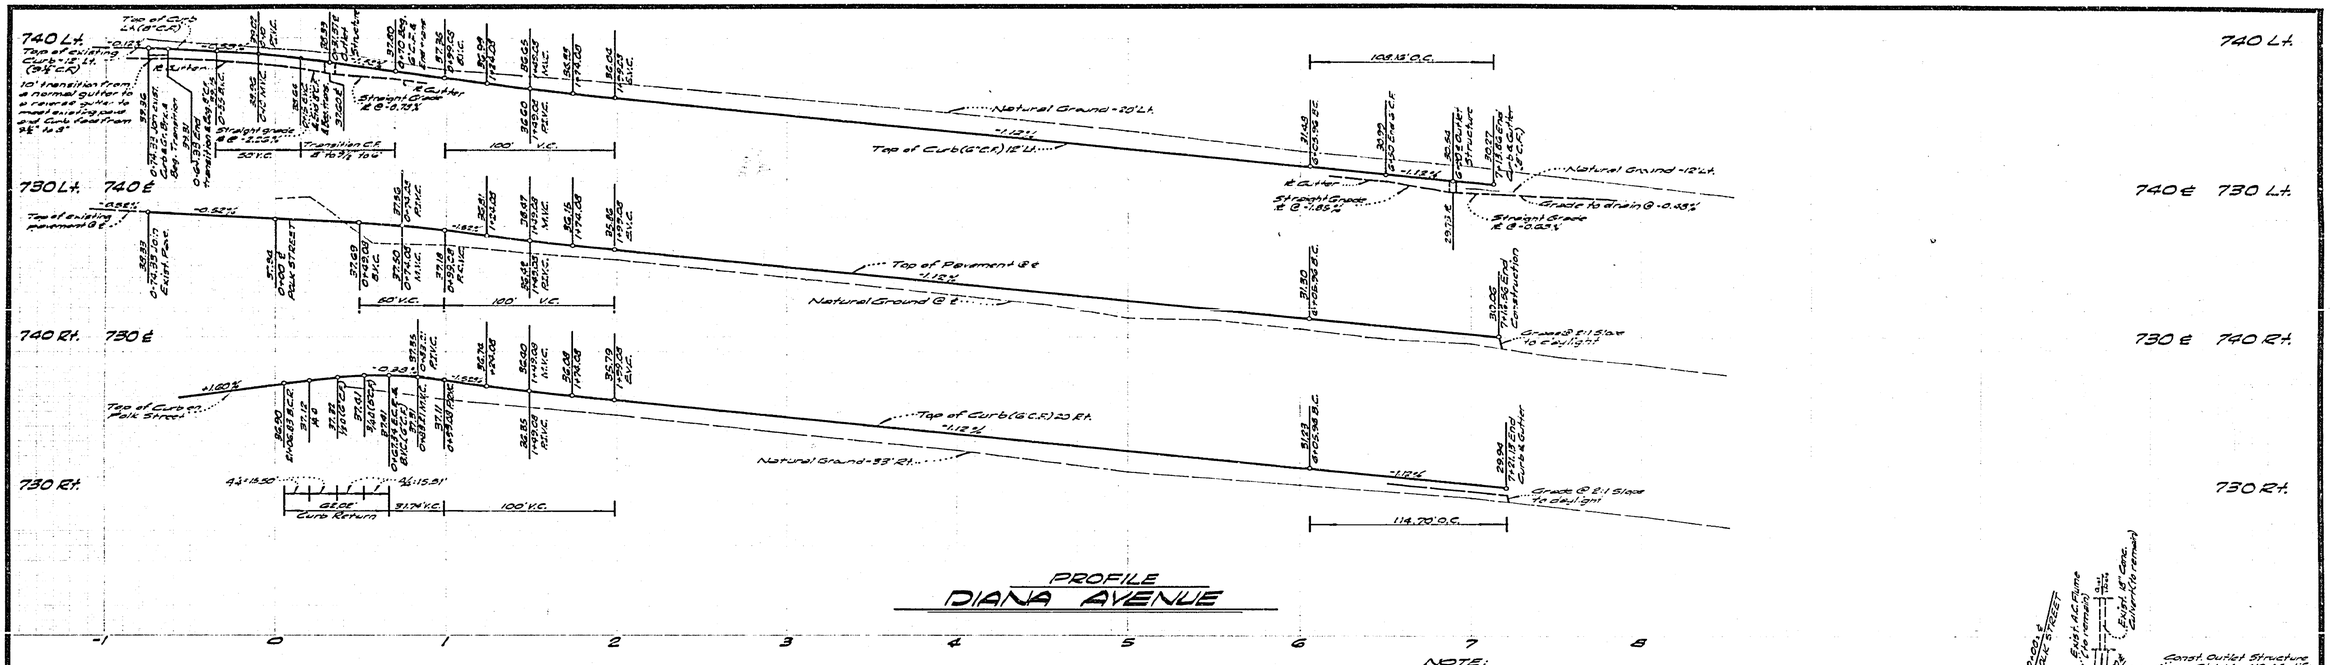

NOTE:
See Sheet No. 1 for General and Construction Notes.

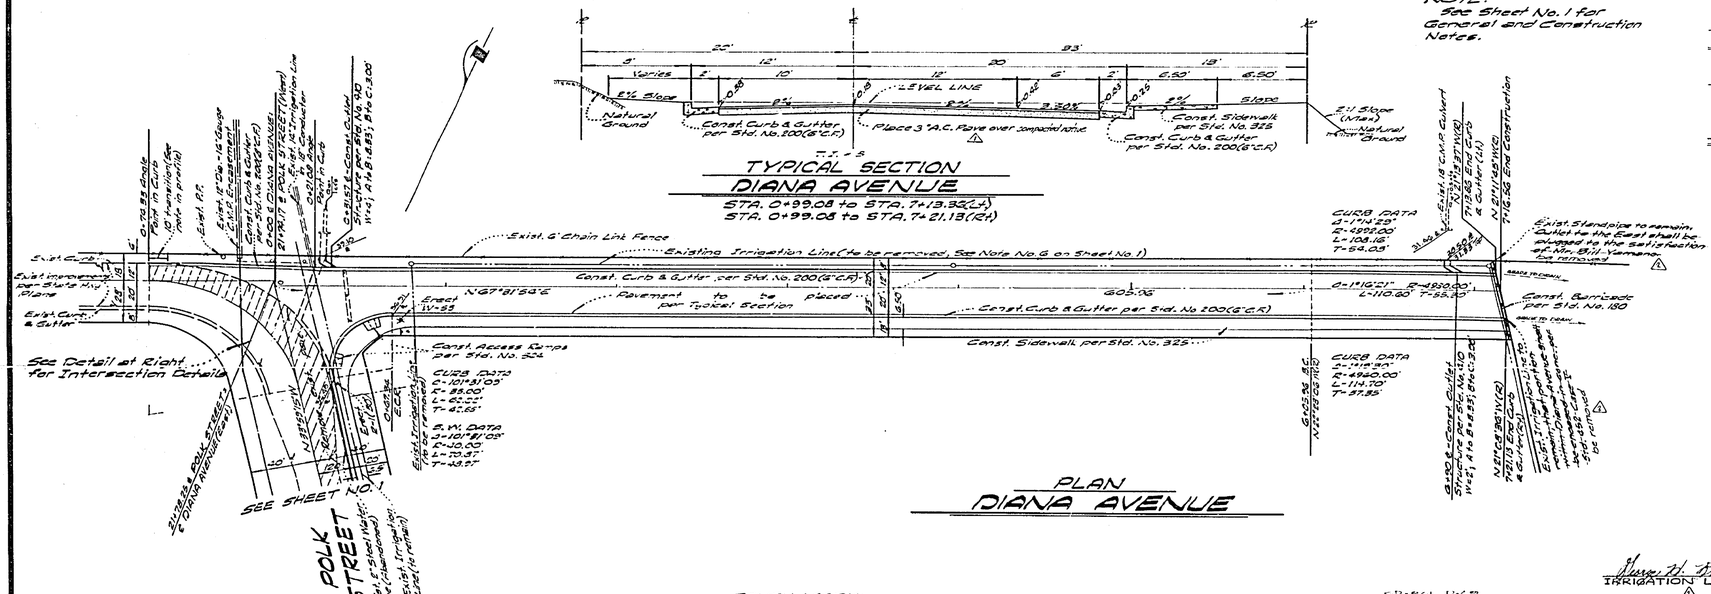

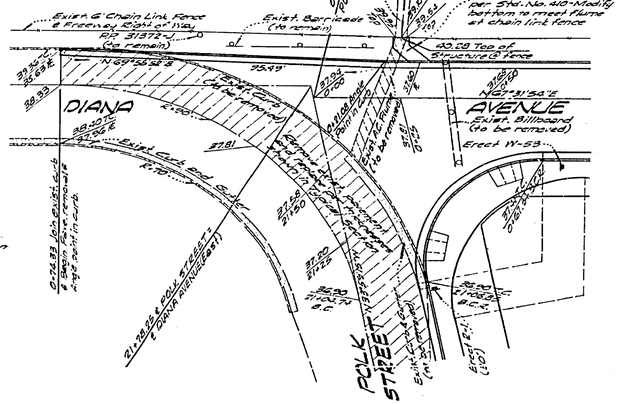

BENCH MARK:
Bronze Disk set in Concrete & stamped 601-56-68 on West side of Tyler Street, 250± North of Indiana Avenue & 1± N.E. of Bridge No. 56-419
Elevation 736.885

Jesse H. Marshall 10/10/75
IRRIGATION LINES APPROVED.

APPROVED BY
Howard L. Brown 12-12-73
CHIEF WATER UTILITY ENGINEER
DATE

ALBERT A. WEBB ASSOCIATES
CIVIL ENGINEERS
RIVERSIDE, CALIFORNIA
APPROVED BY R.O. Marshall DATE 11-12-73
R.E. No. 12056
W.O. 73-207 FOR: GOLF & STURF F.B. 1032

MARK	REVISIONS	APP'D	DATE
1	ADDED APPROVAL SIGNS AND REMOVAL NOTE TO IRRIGATION FACILITIES	DK	10/10/75
2	ADDED "AS BUILT" NOTATION	DK	12-12-75

DESIGNED BY DK DRAWN BY DK CHECKED BY

CITY OF RIVERSIDE, CALIFORNIA
PUBLIC WORKS DEPARTMENT

APPROVED BY	BY	DATE
PRINCIPAL ENGINEER		
PARK DEPARTMENT		
TRAFFIC DIVISION		
CHIEF PUB. WKS. ENGR.		

APPROVED BY
William D. Stanley
DIRECTOR OF PUBLIC WORKS
DATE 5/20/74

DIANA AVENUE
FROM POLK STREET TO 716' WESTERLY
C-21-723

SCALE: HOR. 1"=40'; VERT. 1"=4'

ACCOUNT No. 73-207
DRAWING NUMBER R-1721
SHEET 2 OF 2
73-207-A