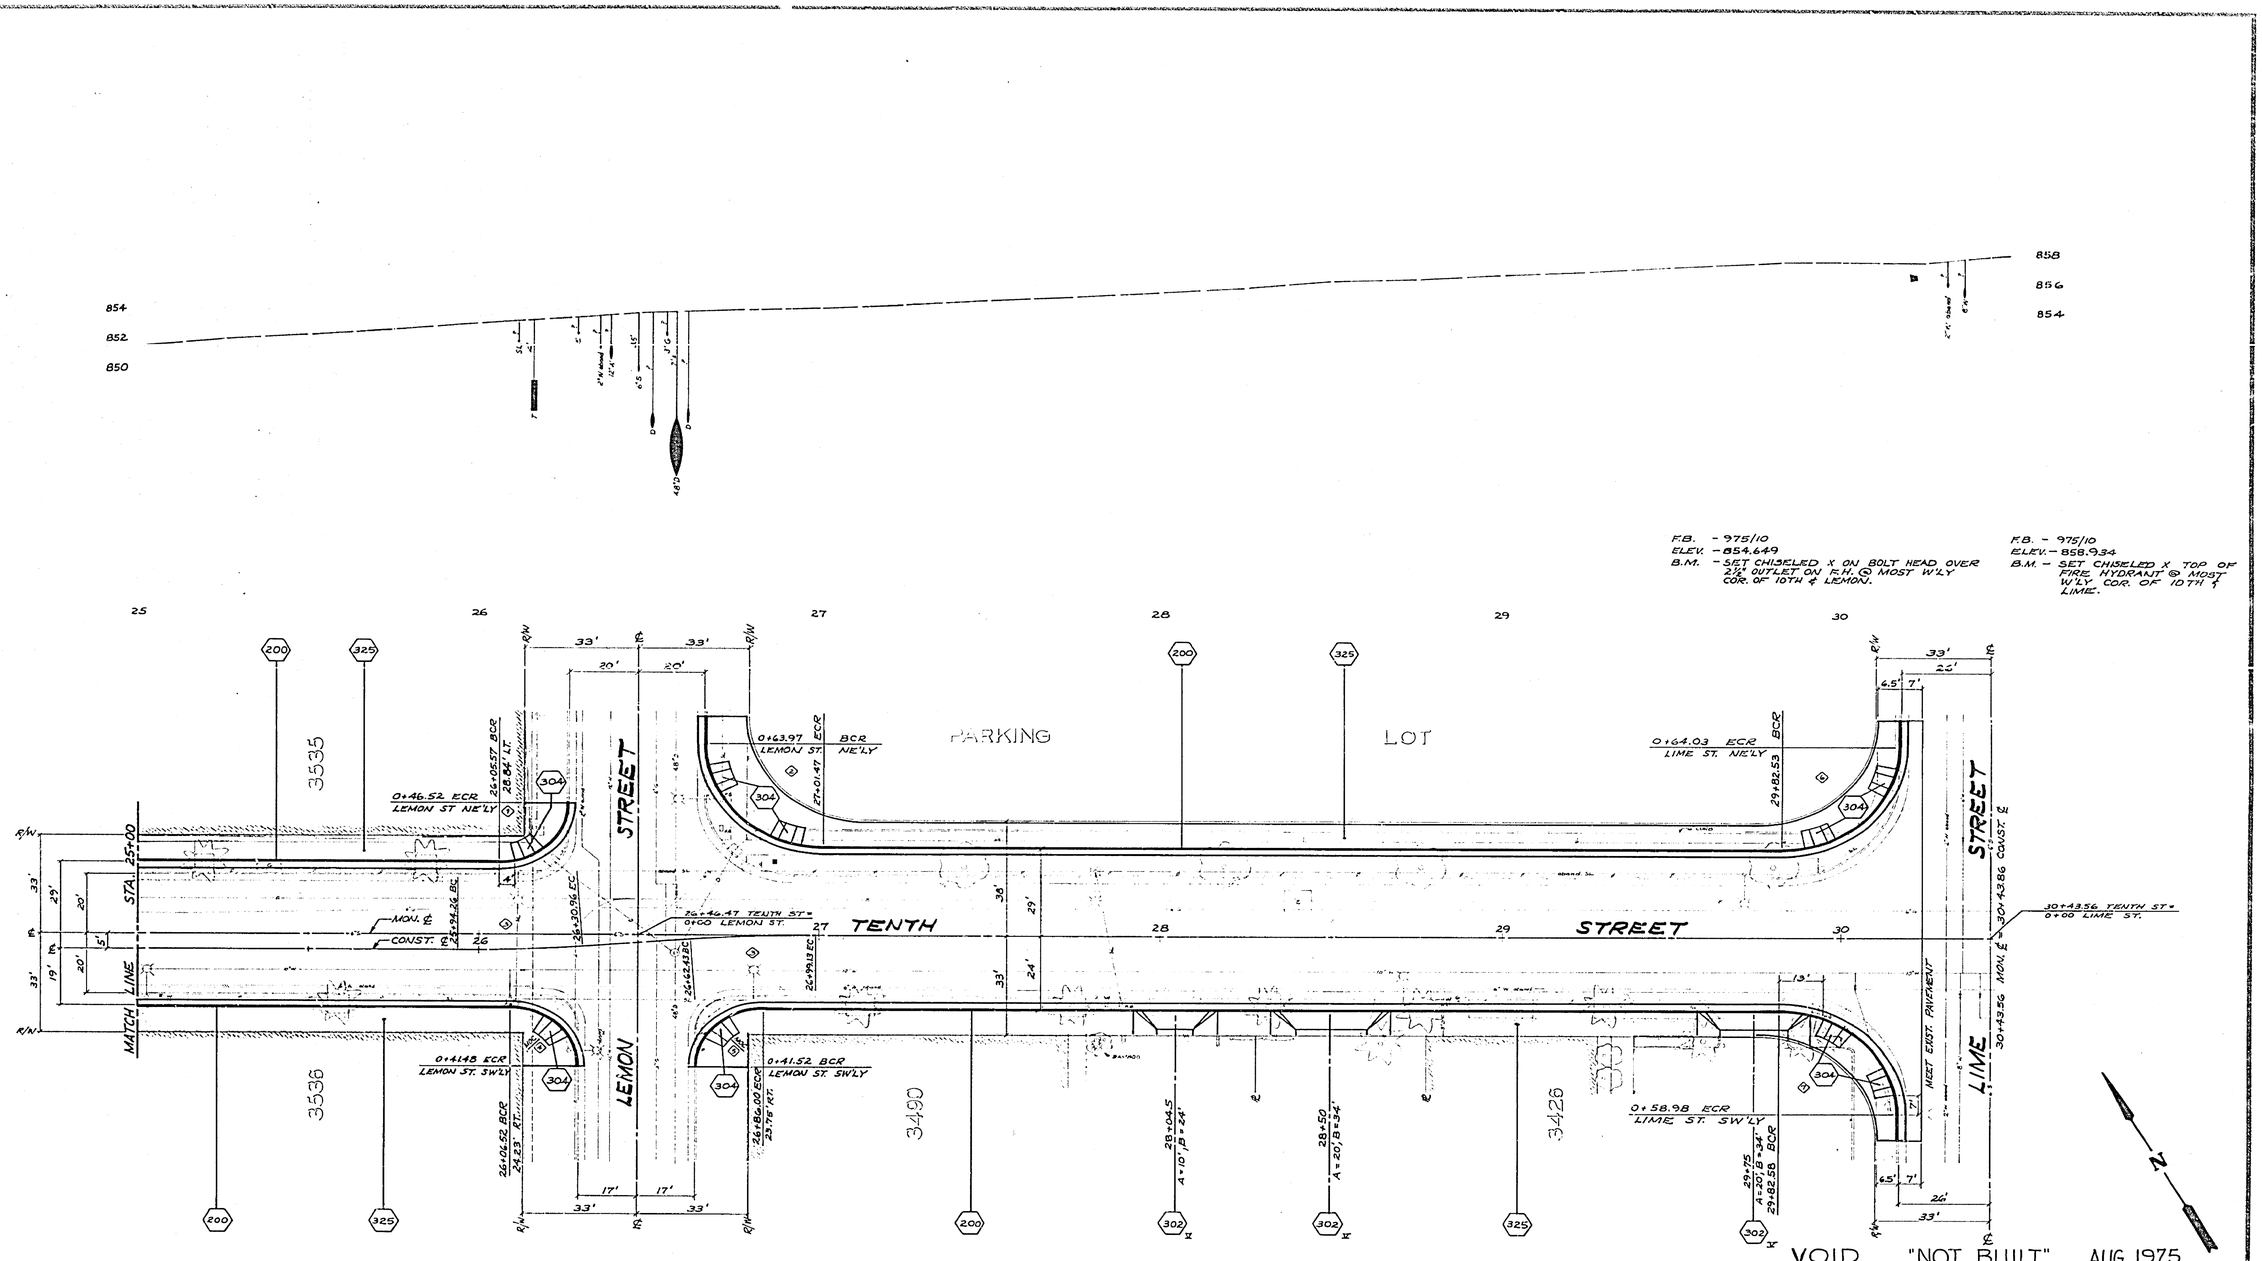


VOID "NOT BUILT" AUG. 1975

| CURVE DATA | | | | |
|---|---|---|---|---|
| INDEX | R | Δ | T | L |
| 1 | 20' | 90°02'6" | 20.01' | 31.43' |
| 2 | 35' | 89°58'15" | 34.98' | 54.72' |
| 3 | 500' | 4°12'19" | 18.36' | 36.70' |
| 4 | 20' | 89°58'15" | 20.00' | 31.41' |
| 5 | 20' | 90°01'28" | 20.00' | 31.42' |
| 6 | 35' | 90°01'46" | 35.06' | 54.99' |

| INDEX | R | Δ | T | L |
|---|---|---|---|---|
| 7 | 35' | 89°58'35" | 35.00' | 54.72' |

CITY OF RIVERSIDE
PUBLIC WORKS DEPARTMENT

APPROVED BY
PUBLIC WORKS DIRECTOR
DATE

# Tenth Street Widening

Market to Lime

HORIZ. SCALE 1" = 20' VERT. SCALE 1" = 4'

ACCOUNT NO. ~~39-373-270-9~~

~~R-1728~~

SHEET ____ OF ____

FILE NO.