
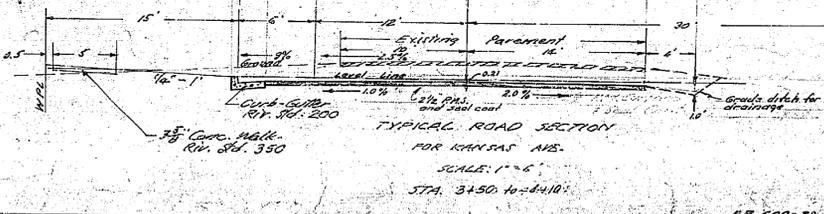
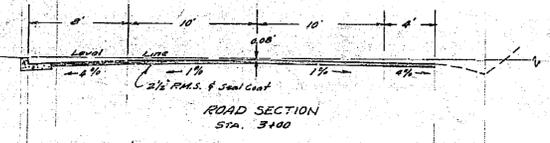


VICTORIA GROVES UNIT NO. 7

B.M. on top of flange of Fire Hyd. at S.W. Cor. of Kansas Ave. and Elsinore Road. Elev. = 990.00

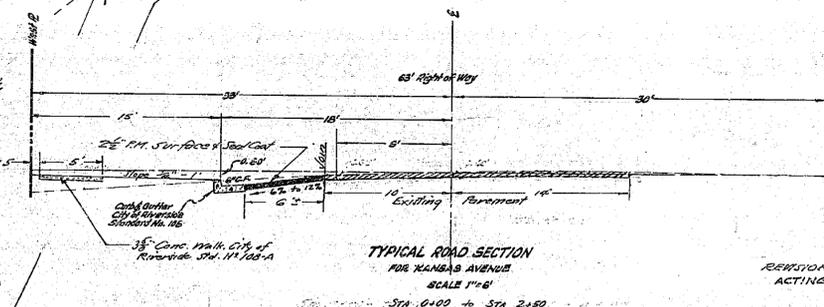

PARTIALLY REVISION SEPT. 1958 BY LOWERING KANSAS 2450 TO 4150. REVISION APPROVED BY *[Signature]* DATE 2/28/59 ACTING PUBLIC WORKS DIRECTOR

J.F. DAVIDSON-CIVIL ENGINEER
R.E. No 862
RIVERSIDE, CALIFORNIA
APPROVED BY *[Signature]* DATE 1/21/59





CITY OF RIVERSIDE, CALIFORNIA
DEPARTMENT OF PUBLIC WORKS
STREET PLAN & PROFILE
KANSAS AVENUE

VICTORIA GROVES UNIT NO. 7
HORIZ. SCALE 1 in. = 40 ft. VERT. SCALE 1 in. = 4 ft.
APPROVED BY *[Signature]* NO. R-178
Director of Public Works
DATE *1/25/59* SHEET 1 OF 1



PROPERTY OF
CITY OF RIVERSIDE
DEPT. OF PUBLIC WORKS
ENGINEERING DIVISION

PROPERTY OF
CITY OF RIVERSIDE
DEPT. OF PUBLIC WORKS
ENGINEERING DIVISION

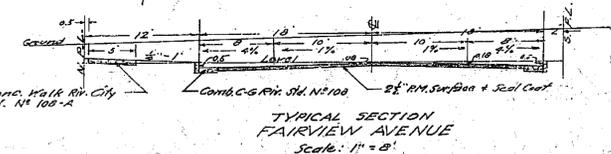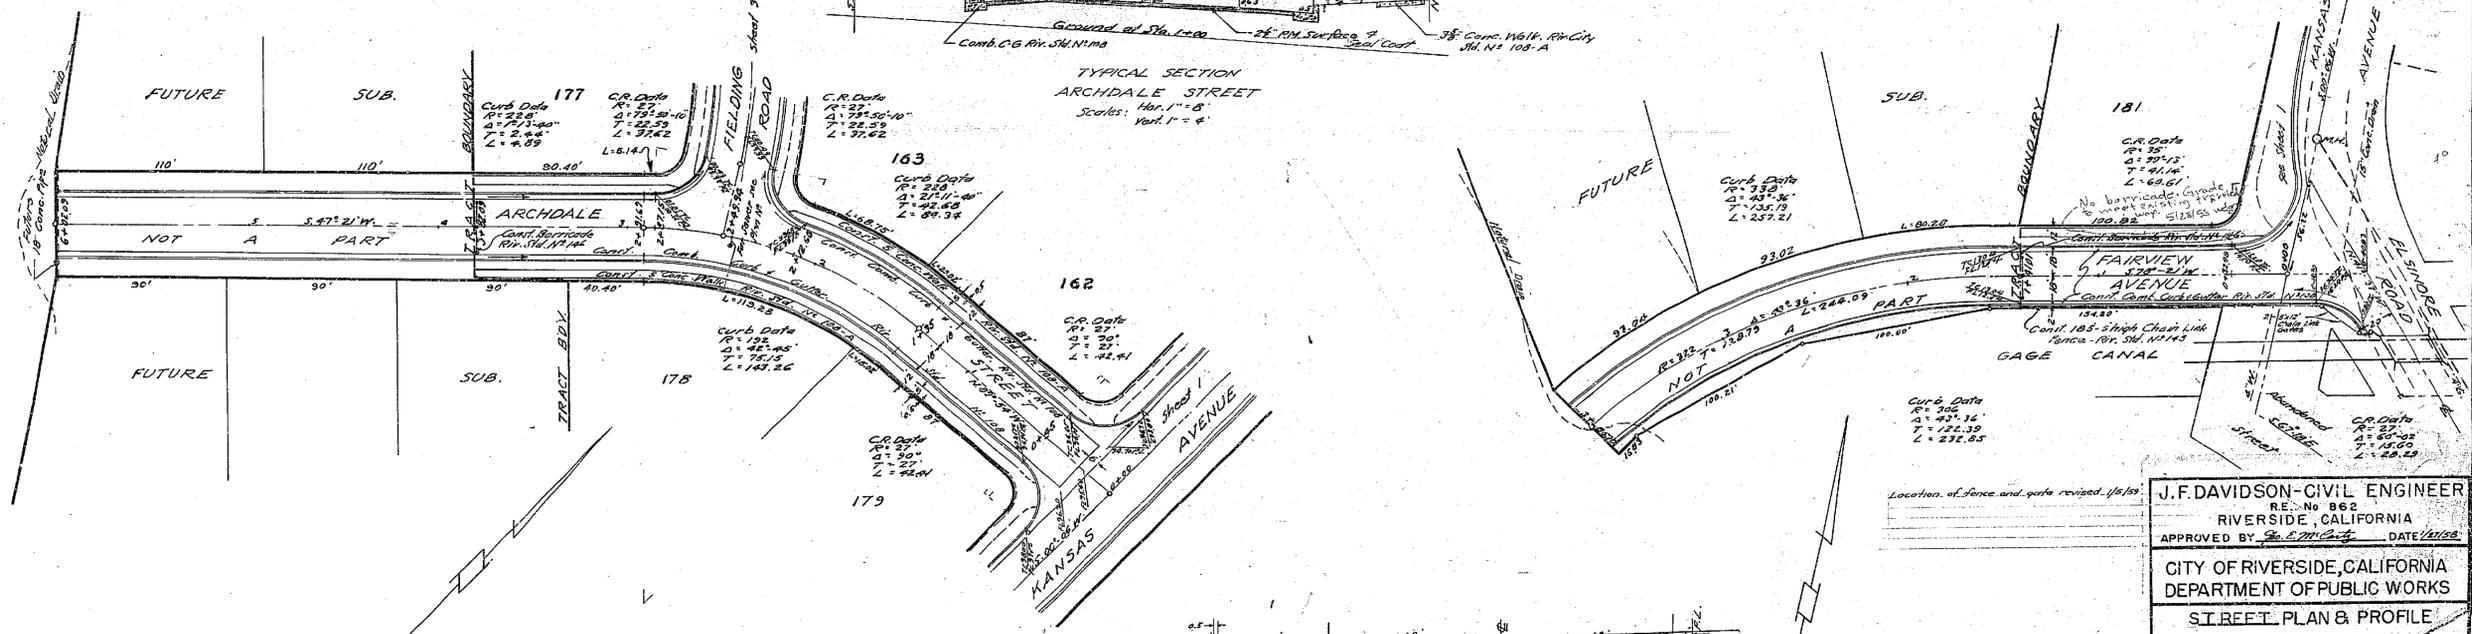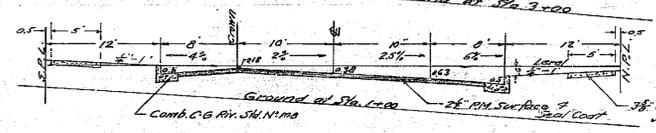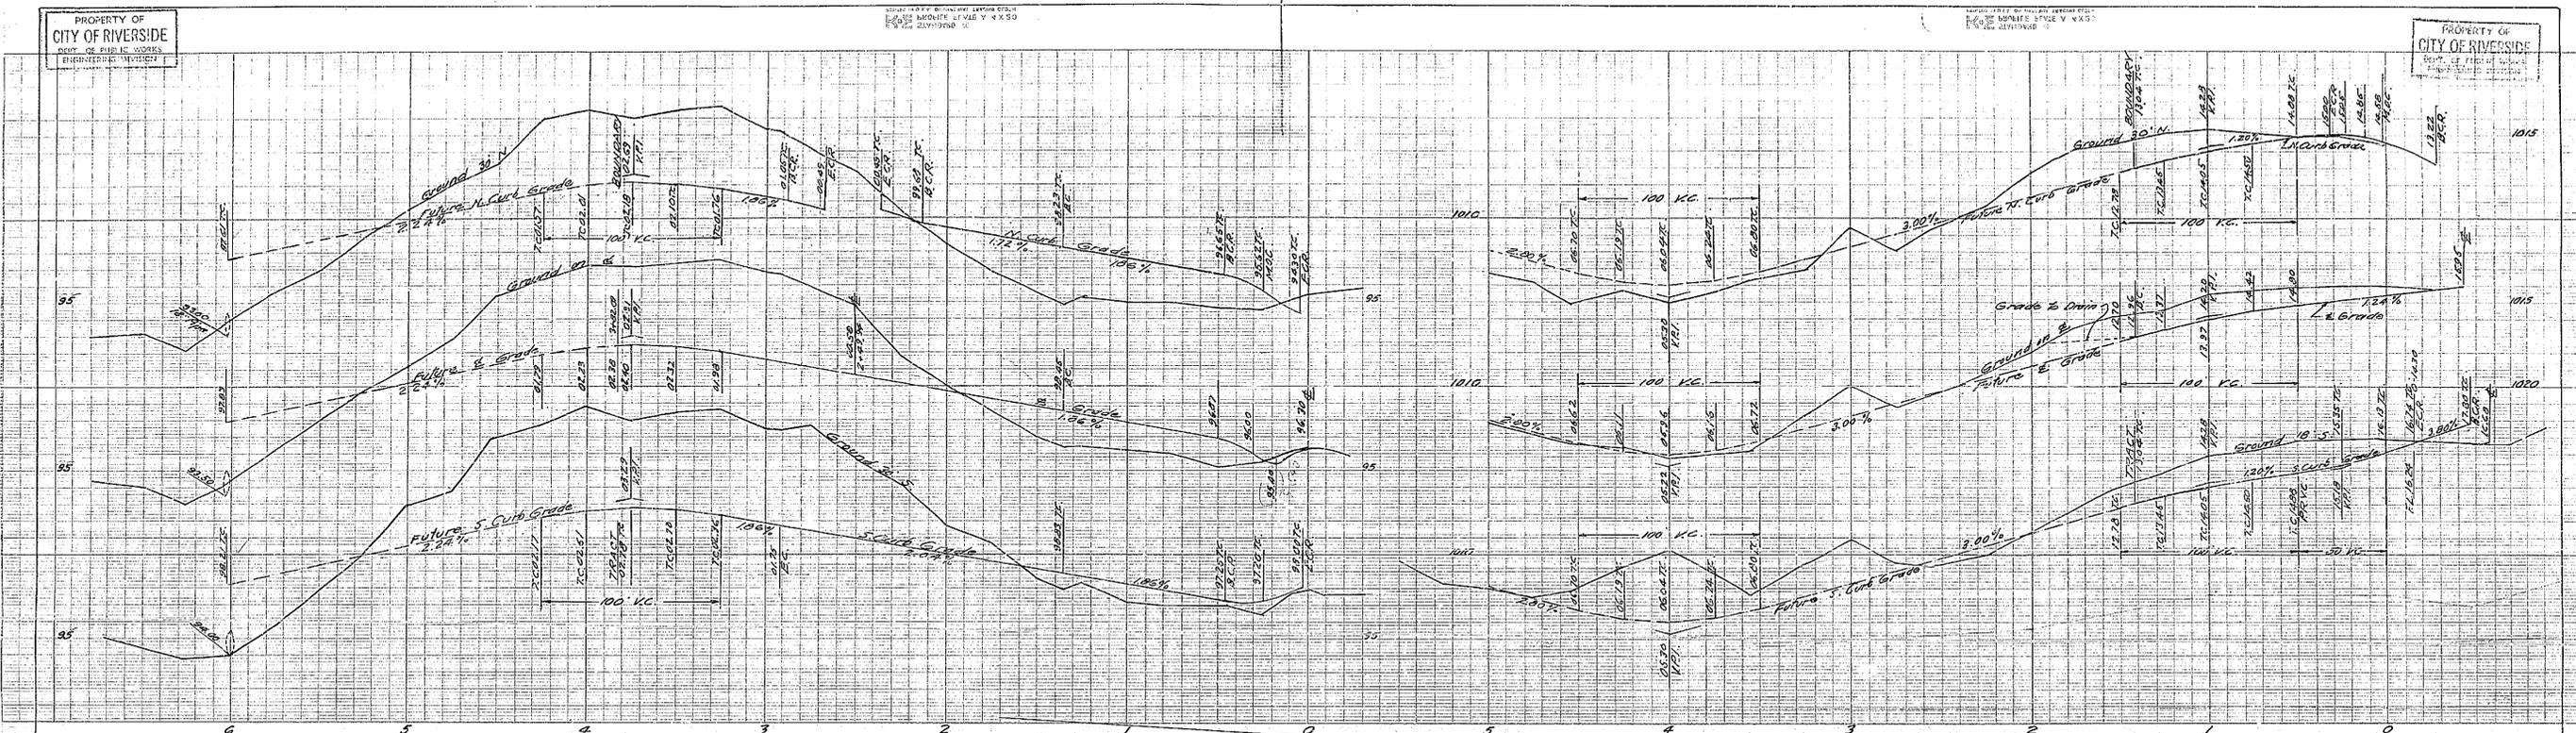



J. F. DAVIDSON - CIVIL ENGINEER
R.E. No. 862
RIVERSIDE, CALIFORNIA

CITY OF RIVERSIDE, CALIFORNIA
DEPARTMENT OF PUBLIC WORKS
STREET PLAN & PROFILE
FAIRVIEW AVE - ARCHDALE ST.

VICTORIA GROVES UNIT NO. B
HORIZ. SCALE 1" = 40' VERT. SCALE 1" = 4'

APPROVED BY: *[Signature]*
Director of Public Works




PROPERTY OF
CITY OF RIVERSIDE
DEPT. OF PUBLIC WORKS
ENGINEERING DIVISION

PROPERTY OF
CITY OF RIVERSIDE
DEPT. OF PUBLIC WORKS
ENGINEERING DIVISION



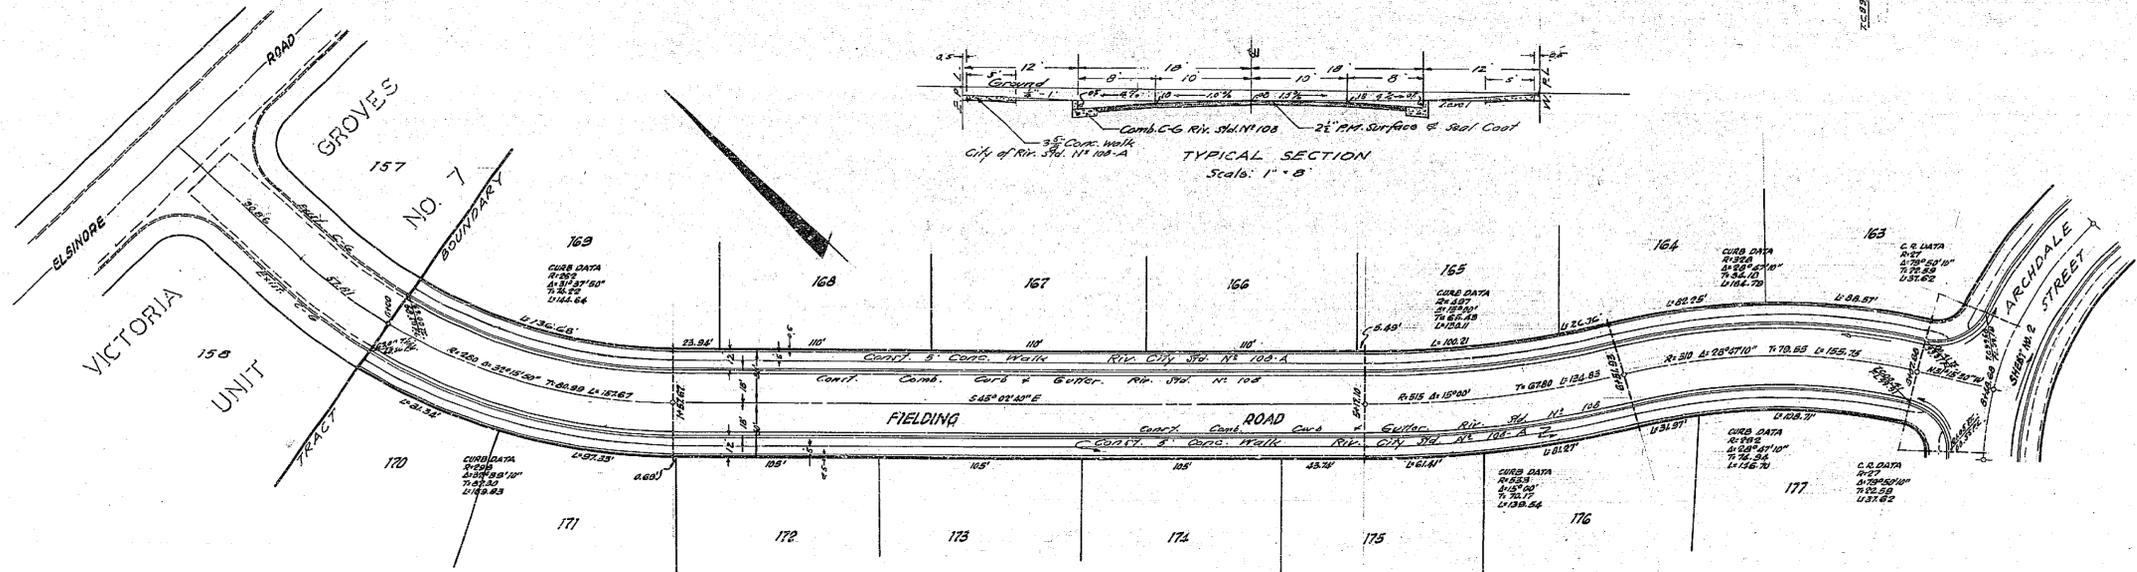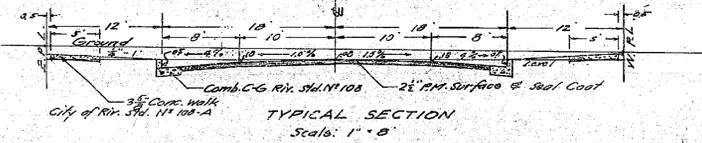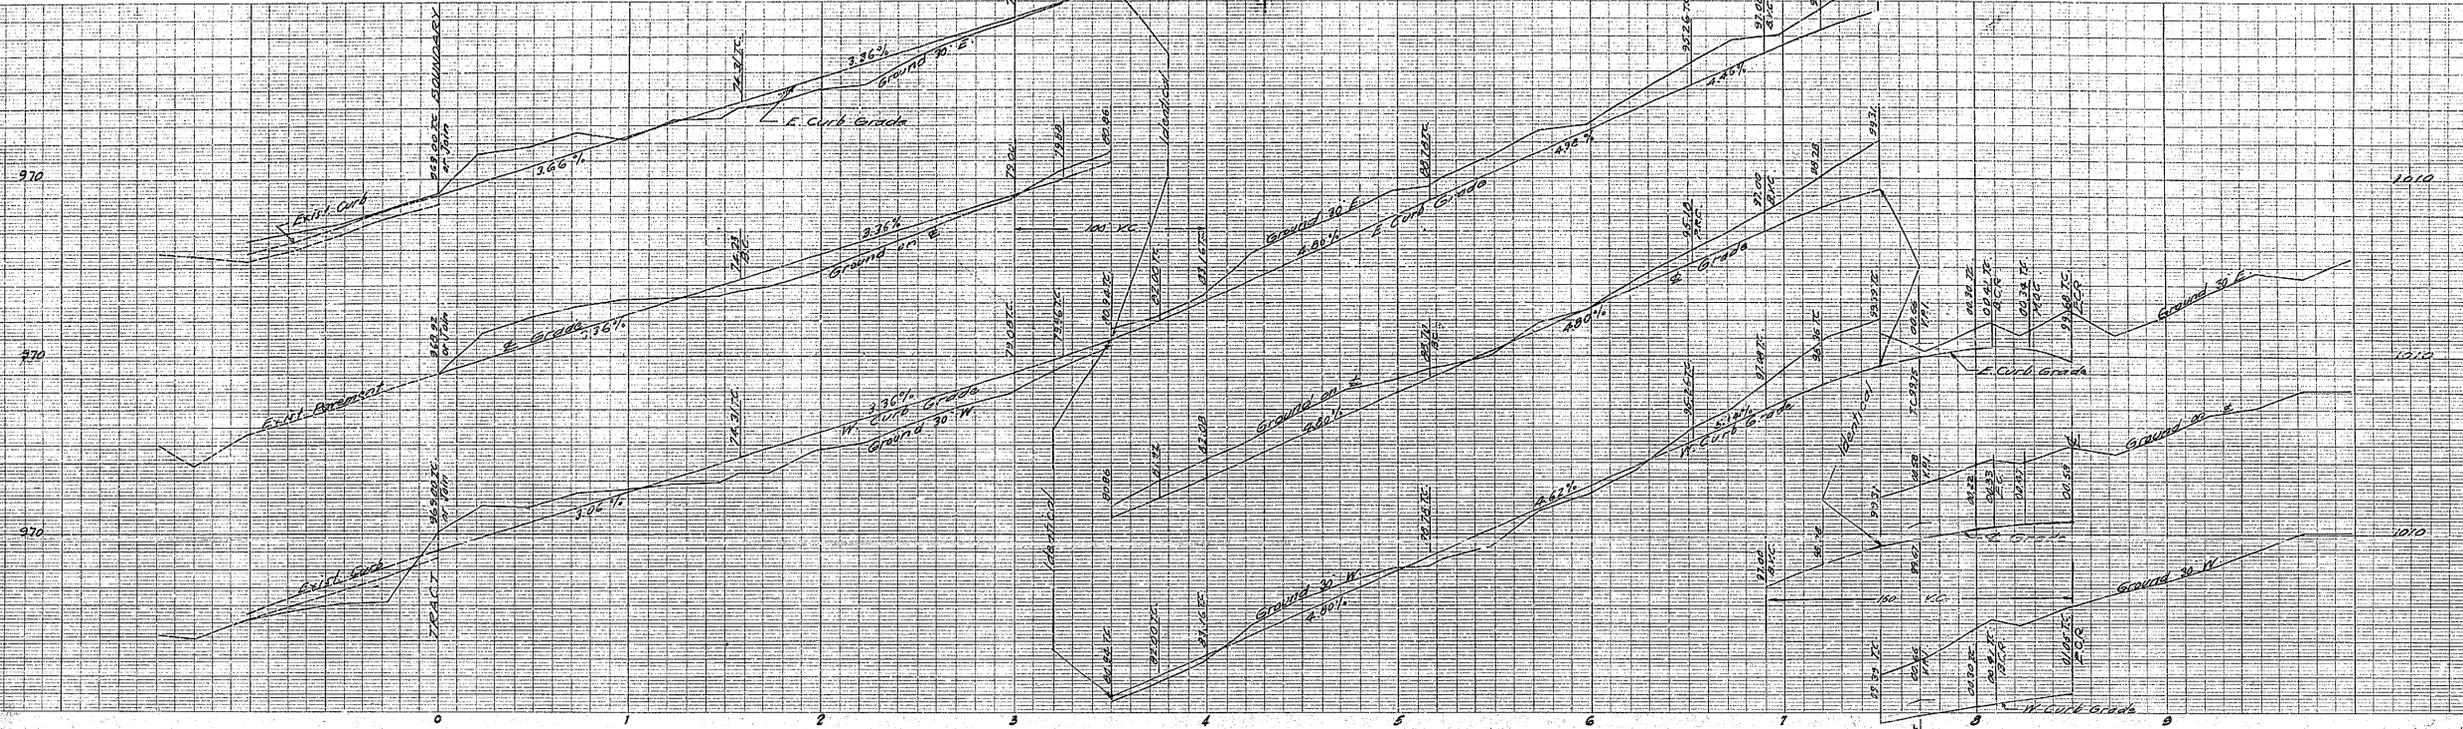


PROPERTY OF
CITY OF RIVERSIDE
DEPT. OF PUBLIC WORKS
ENGINEERING DIVISION

J. F. DAVIDSON - CIVIL ENGINEER
R.E. No. 862
RIVERSIDE, CALIFORNIA
APPROVED BY *[Signature]* DATE *1/25/58*
CITY OF RIVERSIDE, CALIFORNIA
DEPARTMENT OF PUBLIC WORKS
STREET PLAN & PROFILE
FIELDING ROAD
VICTORIA GROVES UNIT NO. 7
HORIZ. SCALE 1 in. = 40 ft. VERT. SCALE 1 in. = 4 ft.
APPROVED BY *[Signature]* NO. **A-178**
Director of Public Works
DATE *1/25/58* SHEET 3 OF 3

PROPERTY OF
CITY OF RIVERSIDE
DEPT. OF PUBLIC WORKS
ENGINEERING DIVISION

