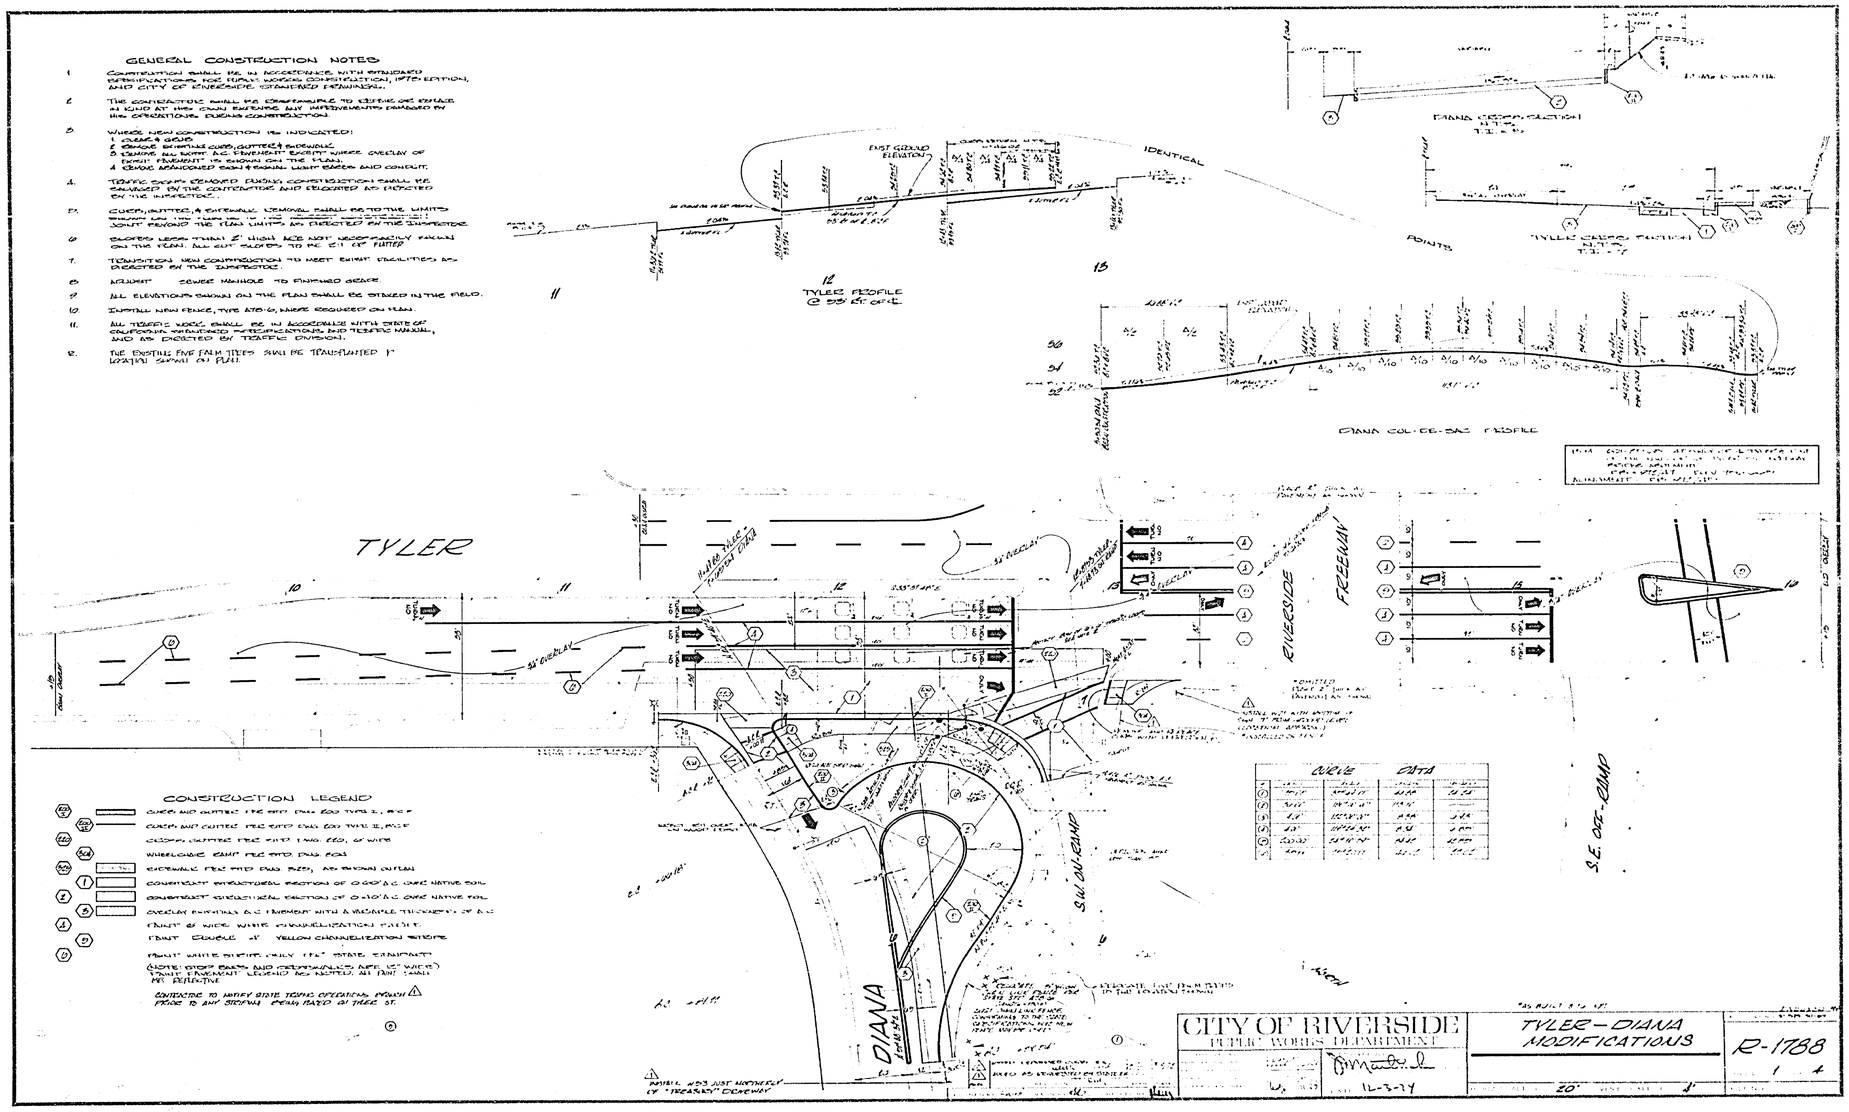
GENERAL CONSTRUCTION NOTES
1. CONSTRUCTION SHALL BE IN ACCORDANCE WITH STANDARD SPECIFICATIONS FOR PUBLIC WORKS CONSTRUCTION, 1975 EDITION, AND CITY OF RIVERSIDE STANDARD DRAWINGS.
2. THE CONTRACTOR SHALL BE RESPONSIBLE TO REPAIR OR REPLACE IN KIND AT HIS OWN EXPENSE ANY IMPROVEMENTS DAMAGED BY HIS OPERATIONS DURING CONSTRUCTION.
3. WHERE NEW CONSTRUCTION IS INDICATED:
1 CLEAR & GRUB
2 REMOVE EXISTING CURB, GUTTER & SIDEWALK
3 REMOVE ALL ROSE A.C. PAVEMENT EXCEPT WHERE OVERLAY OF EXIST. PAVEMENT IS SHOWN ON THE PLAN.
4 REMOVE ABANDONED SIGN & SIGNAL LIGHT BARES AND CONDUIT.
4. TRAFFIC SIGNS REMOVED DURING CONSTRUCTION SHALL BE SALVAGED BY THE CONTRACTOR AND RELOCATED AS DIRECTED BY THE INSPECTOR.
5. CURB, GUTTER, & SIDEWALK REMOVAL SHALL BE TO THE LIMITS SHOWN ON THE PLAN OR TO THE NEAREST CONSTRUCTION JOINT BEYOND THE PLAN LIMITS AS DIRECTED BY THE INSPECTOR.
6. SLOPES LESS THAN 2' HIGH ARE NOT NECESSARILY SHOWN ON THE PLAN. ALL CUT SLOPES TO BE 2:1 OR FLATTER
7. TRANSITION NEW CONSTRUCTION TO MEET EXIST. FACILITIES AS DIRECTED BY THE INSPECTOR.
8. ADJUST SEWER MANHOLE TO FINISHED GRADE.
9. ALL ELEVATIONS SHOWN ON THE PLAN SHALL BE STAKED IN THE FIELD.
10. INSTALL NEW FENCE, TYPE A78-6, WHERE REQUIRED ON PLAN.
11. ALL TRAFFIC WORK SHALL BE IN ACCORDANCE WITH STATE OF CALIFORNIA STANDARD SPECIFICATIONS AND TRAFFIC MANUAL, AND AS DIRECTED BY TRAFFIC DIVISION.
12. THE EXISTING FIVE PALM TREES SHALL BE TRANSPLANTED TO LOCATION SHOWN ON PLAN.
TYLER PROFILE @ 55' RT. OF ℄
DIANA COL-DE-SAC PROFILE
TYLER
RIVERSIDE
FREEWAY
S.W. ON-RAMP
S.E. OFF-RAMP
DIANA
CURVE DATA
CONSTRUCTION LEGEND
CITY OF RIVERSIDE
PUBLIC WORKS DEPARTMENT
TYLER-DIANA MODIFICATIONS
R-1788
12-3-74




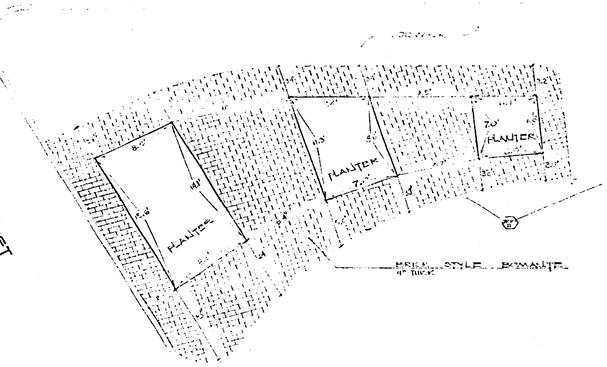

	CITY OF RIVERSIDE PUBLIC WORKS DEPARTMENT	TYLER - DIANA LANDSCAPING	R-1788
		LAYOUT PLAN	2

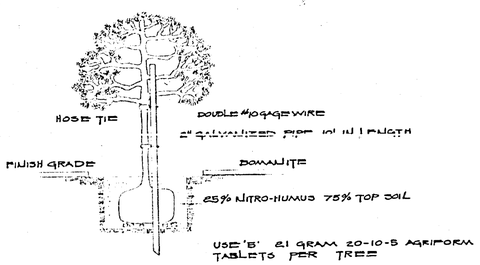

TYLER STREET

DIANA STREET

FREEWAY ON RAMP

CUPUNIA ANACARDIOIDES
24" BOX TREE

CROSSED HATCHED AREAS INDICATE WHERE "HEMEROCALLIS HYBRID ORANGE" SHALL BE PLANTED. THEY SHALL BE 1 GALLON IN SIZE AND BE PLANTED 18" ON CENTER. APPLY 1 5 GRAM 20-10-5 AGRIFORM TABLET PER PLANT.

THERE SHALL BE 60 PLANTS IN THE LARGEST PLANTER, 40 PLANTS IN THE MIDDLE PLANTER & 25 PLANTS IN THE SMALLEST PLANTER.

CITY OF RIVERSIDE
PUBLIC WORKS DEPARTMENT

TYLER-DIANA LANDSCAPING

R-1788

PLANTING PLAN

SHEET 3 OF 4

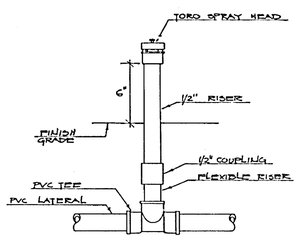

INSTALLATION DETAIL

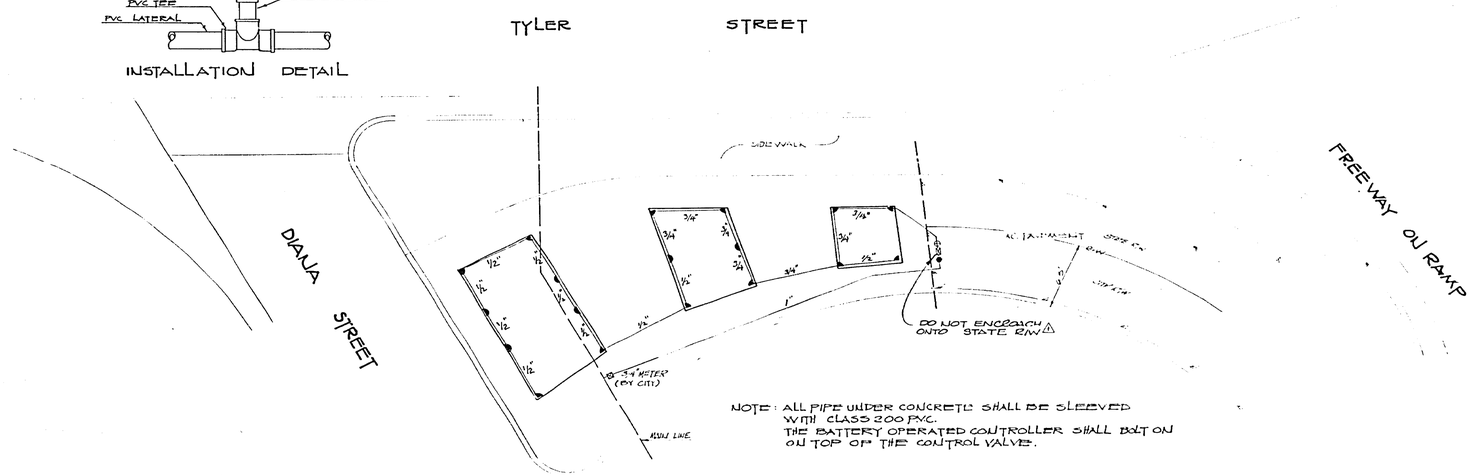

NOTE: ALL PIPE UNDER CONCRETE SHALL BE SLEEVED WITH CLASS 200 PVC.
THE BATTERY OPERATED CONTROLLER SHALL BOLT ON ON TOP OF THE CONTROL VALVE.

SPRINKLER LEGEND

SYMBOL	DESCRIPTION	MANUFACTURER	RAD.	GPM.	PSI.
◻	1/4 SPRAY HEAD	TORO # 500-10	12'	0.6	20
⌓	1/2 SPRAY HEAD	TORO # 500-10	12'	1.2	20
⊕	3/4" CONTROL VALVE	CHAPION #100			
▭	3/4" BACKFLOW PREVENTER	SMR 701			
	BATTERY OPERATED CONTROLLER	WATTER WATCHER #2000			
——	CLASS 200 PVC				
●	PRESSURE REDUCING VALVE 1"	GRISWOLD #2800			10-50

CITY OF RIVERSIDE
PUBLIC WORKS DEPARTMENT

TYLER - DIANA LANDSCAPING

SPRINKLER PLAN

R-1788